


Riser #11 not constructed per Addendum No. 1


SEWER SERVICE TABLE

NUMBER	TYPE	LOCATION			STATION \ DIRECTION	FOR INFORMATION ONLY	
		LOT NO.	BLOCK NO.	LINE NO.		APPROXIMATE LENGTH	4" PIPE
10	8" X 4" Tee Saddle	24	5	2C	1+55/Rt.	8.0'	10.0'
11	8" X 4" Tee Saddle	31	5	2C	1+60/Lt.	8.0'	78.0'
12	8" X 4" Tee Saddle	25	5	2C	2+30/Rt.	9.0'	10.0'

NOTE: Vertical Riser Pipe shall be extended to 2' minimum above ground water elevation and 4' maximum below proposed ground elevation.

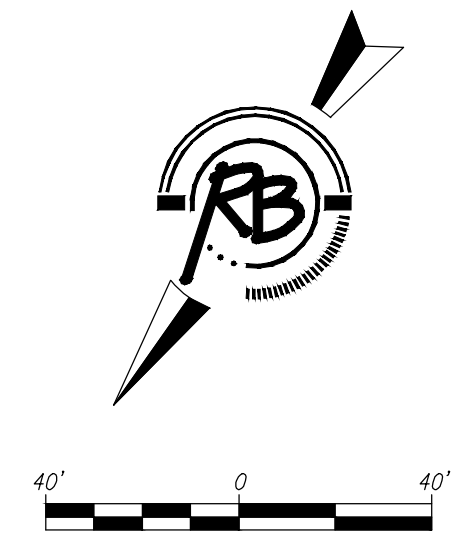

Ruggles & Bolin, P.A.
Engineering & Surveying, Land Planning
100 North Main Street, Suite 200
Wichita, Kansas 67202
www.ruggles.com
E-mail: info@ruggles.com

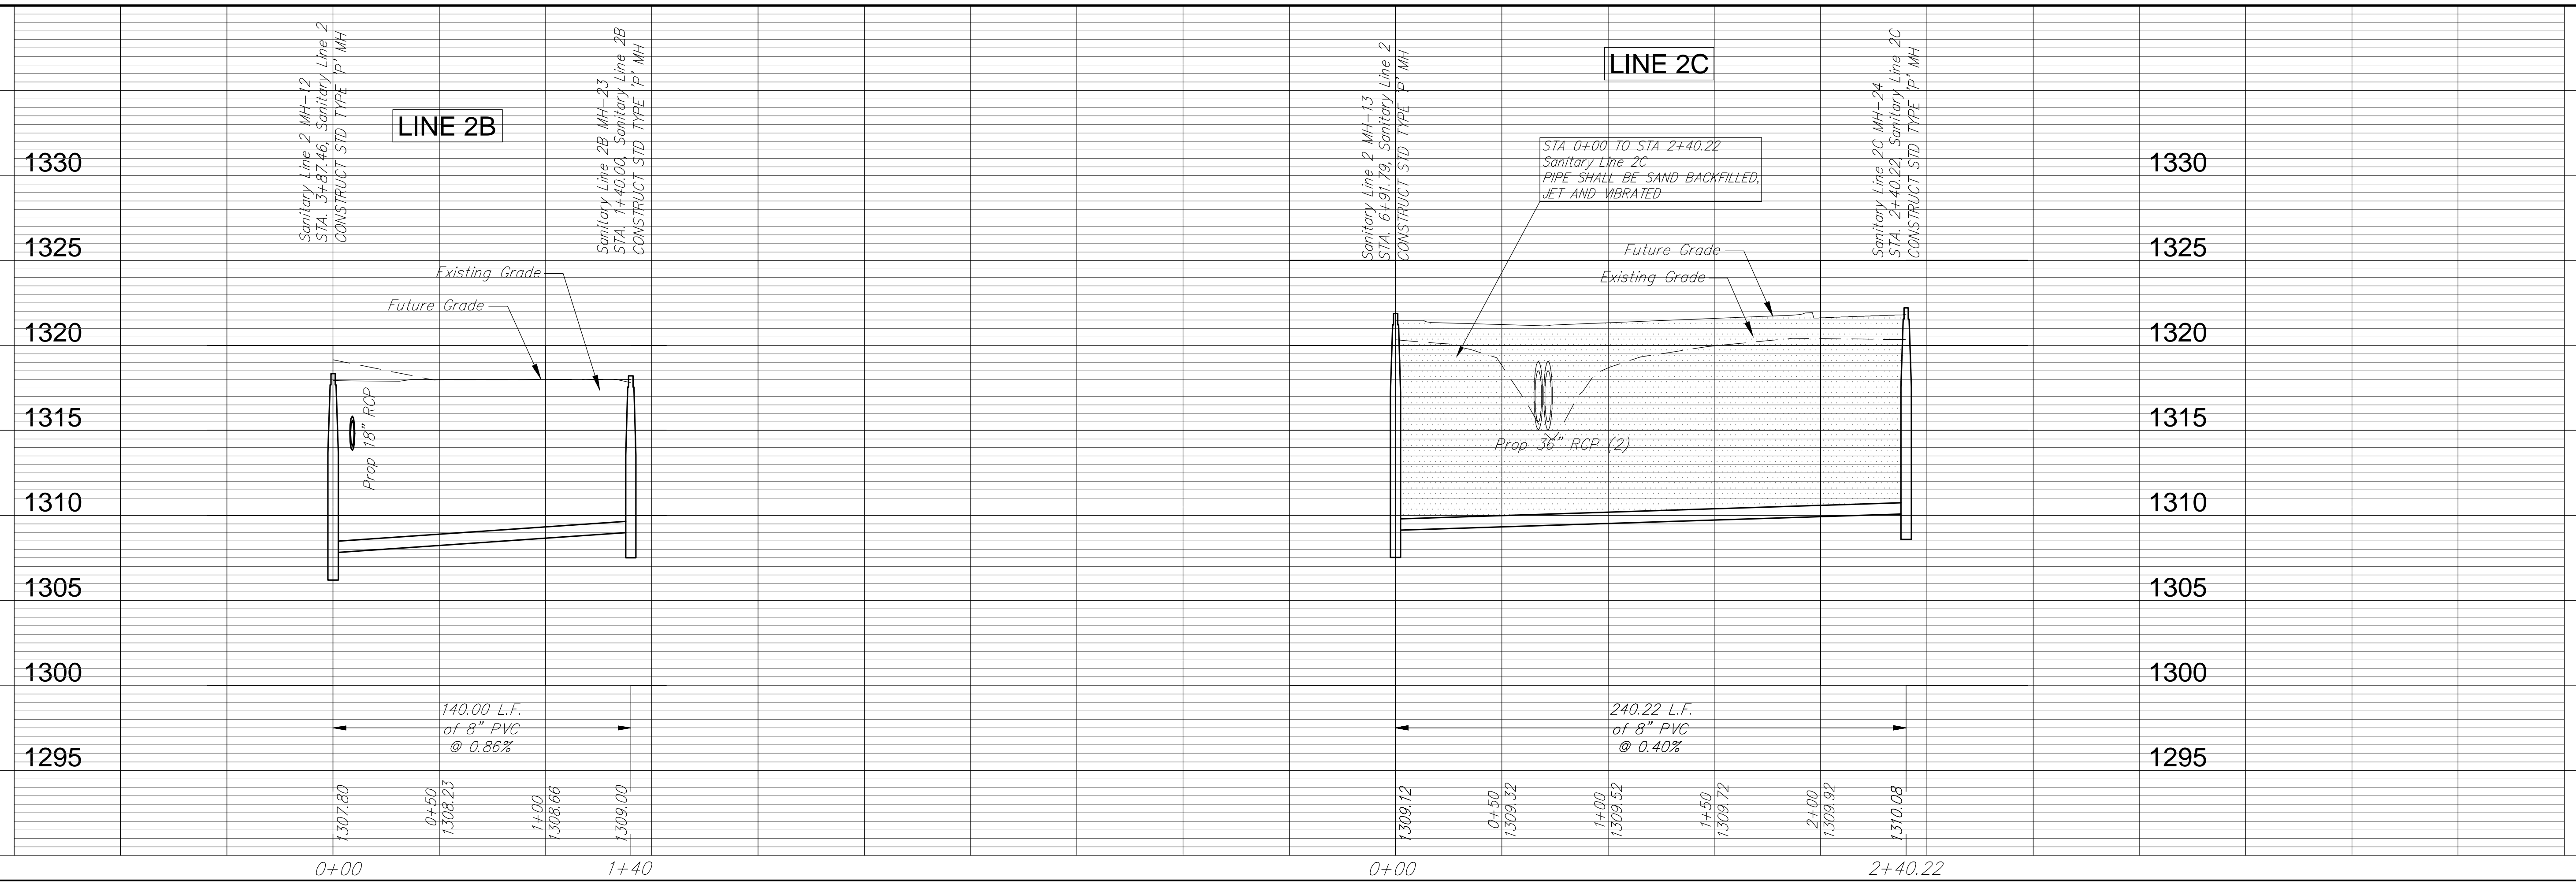

PROJECT NUMBER: 468-6674
DRAWING FILE: SS {SS Line 2B & 2C}

DESIGN E.U.G. DATE: April 24, 2012
REVIEW E.U.G. DATE: Feb. 21, 2012

Sanitary Sewer Line 2B & 2C WICHITA, KANSAS

RB JOB: 3929E
SHEET: 9 of 13