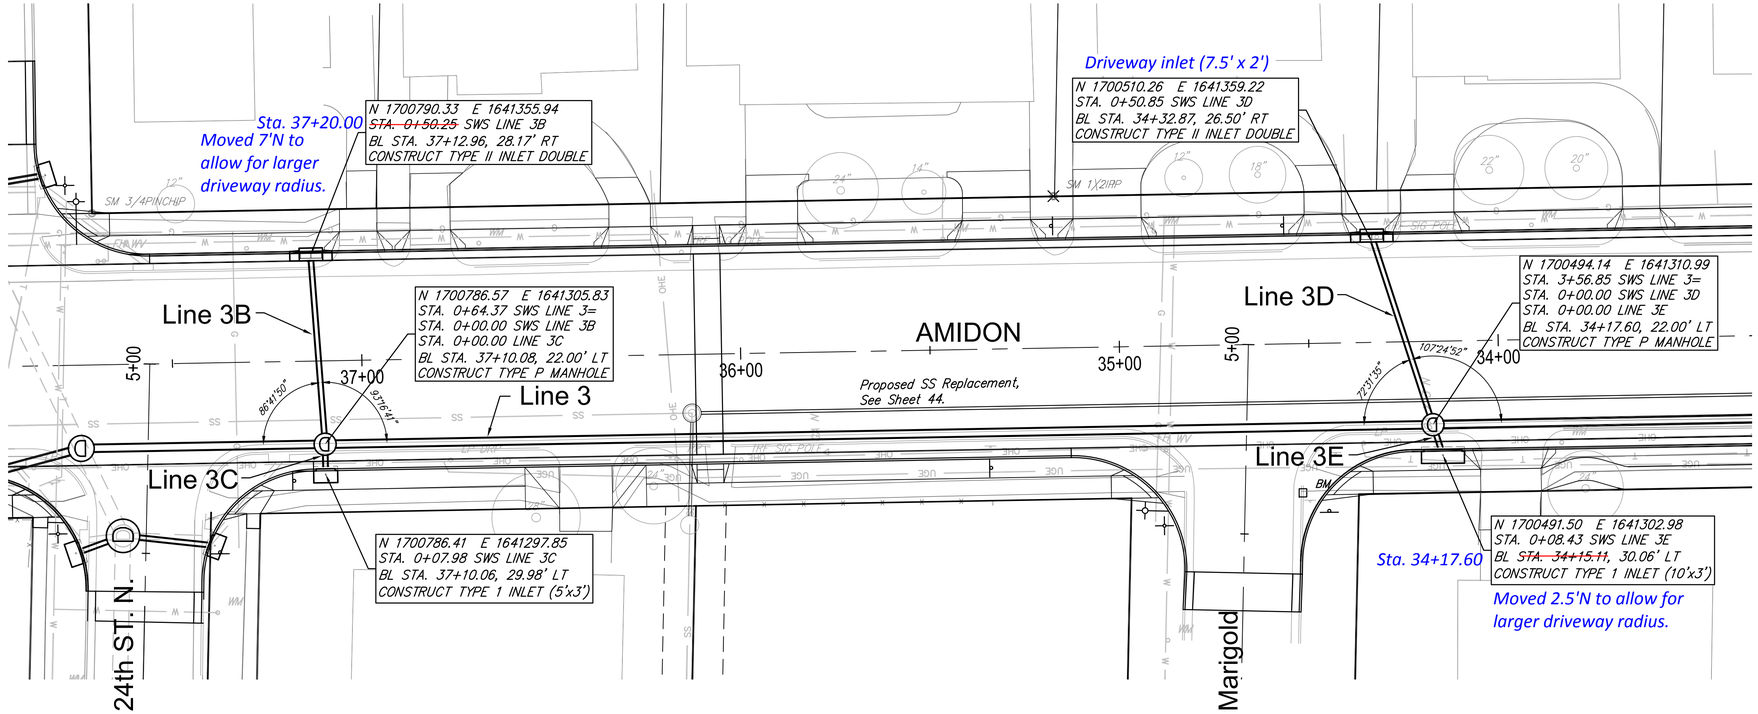

ALL STORM SEWER ON THIS PROJECT UNDER PAVEMENT OR CURB SHALL BE SAND BACKFILLED, JETTED AND VIBRATED.

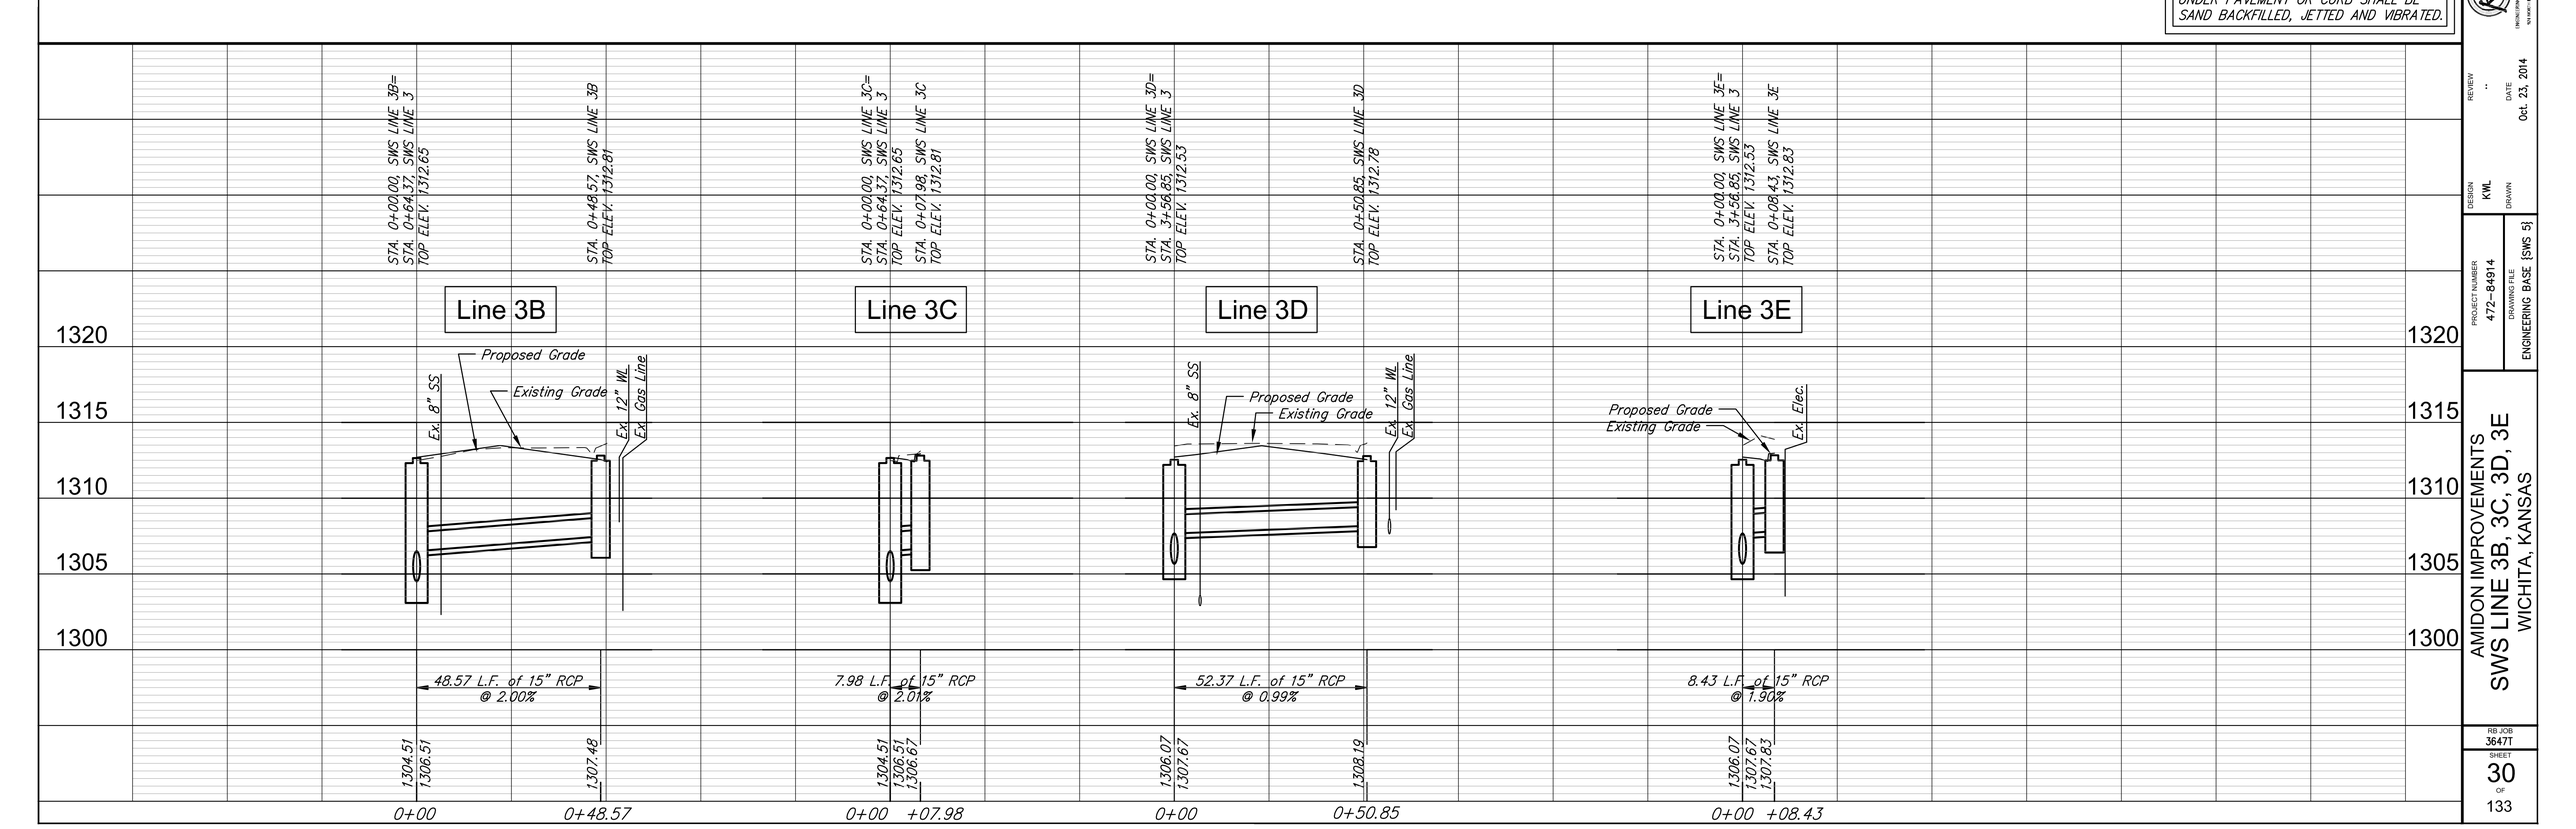

KENNETH W. LEIN
CERTIFICATE NUMBER
15373
10/23/14
KANSAS
PROFESSIONAL ENGINEER

RUGGLES BOHM

REVIEW --
DATE Oct. 23, 2014
DESIGN KWL
DRAWN
PROJECT NUMBER 472-84914
DRAWING FILE ENGINEERING BASE {SWS 5}

AMIDON IMPROVEMENTS
SWS LINE 3B, 3C, 3D, 3E
WICHITA, KANSAS

RB JOB 3647T
SHEET 30 OF 133