

N 1702377.31 E 1641311.76
 STA. 0+01.50 SWS LINE 9
 BL STA. 53+00.48, 11.02' RT
 REMOVE EXISTING MANHOLE
 CONSTRUCT R.C. MANHOLE (6'x6')

N 1702501.81 E 1641309.65
 STA. 1+26.02 SWS LINE 9=
 STA. 0+00.00 SWS LINE 9A
 STA. 0+00.00 SWS LINE 9B
 BL STA. 54+25.00, 10.92' RT
 CONSTRUCT STD. TYPE P MH (6' DIA.)
 Moved 2.5'N

N 1702656.79 E 1641307.15
 STA. 2+81.02 SWS LINE 9=
 STA. 0+00.00 SWS LINE 9C
 STA. 0+00.00 SWS LINE 9D
 BL STA. 55+80.00, 10.92' RT
 CONSTRUCT STD. TYPE P MH (6' DIA.)

N 1702826.65 E 1641304.41
 STA. 4+50.91 SWS LINE 9=
 STA. 0+00.00 SWS LINE 9E
 STA. 0+00.00 SWS LINE 9F
 BL STA. 57+49.89, 10.92' RT
 CONSTRUCT STD. TYPE P MH (6' DIA.)

△XX LF - REMOVE "X" LF STORM SEWER PIPE.



ALL STORM SEWER ON THIS PROJECT UNDER PAVEMENT OR CURB SHALL BE SAND BACKFILLED, JETTED AND VIBRATED.


STA. 0+01.50, SWS LINE 9
 TOP ELEV. 1313.22

STA. 1+26.02, SWS LINE 9
 TOP ELEV. 1313.20

STA. 2+81.02, SWS LINE 9
 TOP ELEV. 1313.58

STA. 4+50.91, SWS LINE 9
 TOP ELEV. 1313.97

Line 9

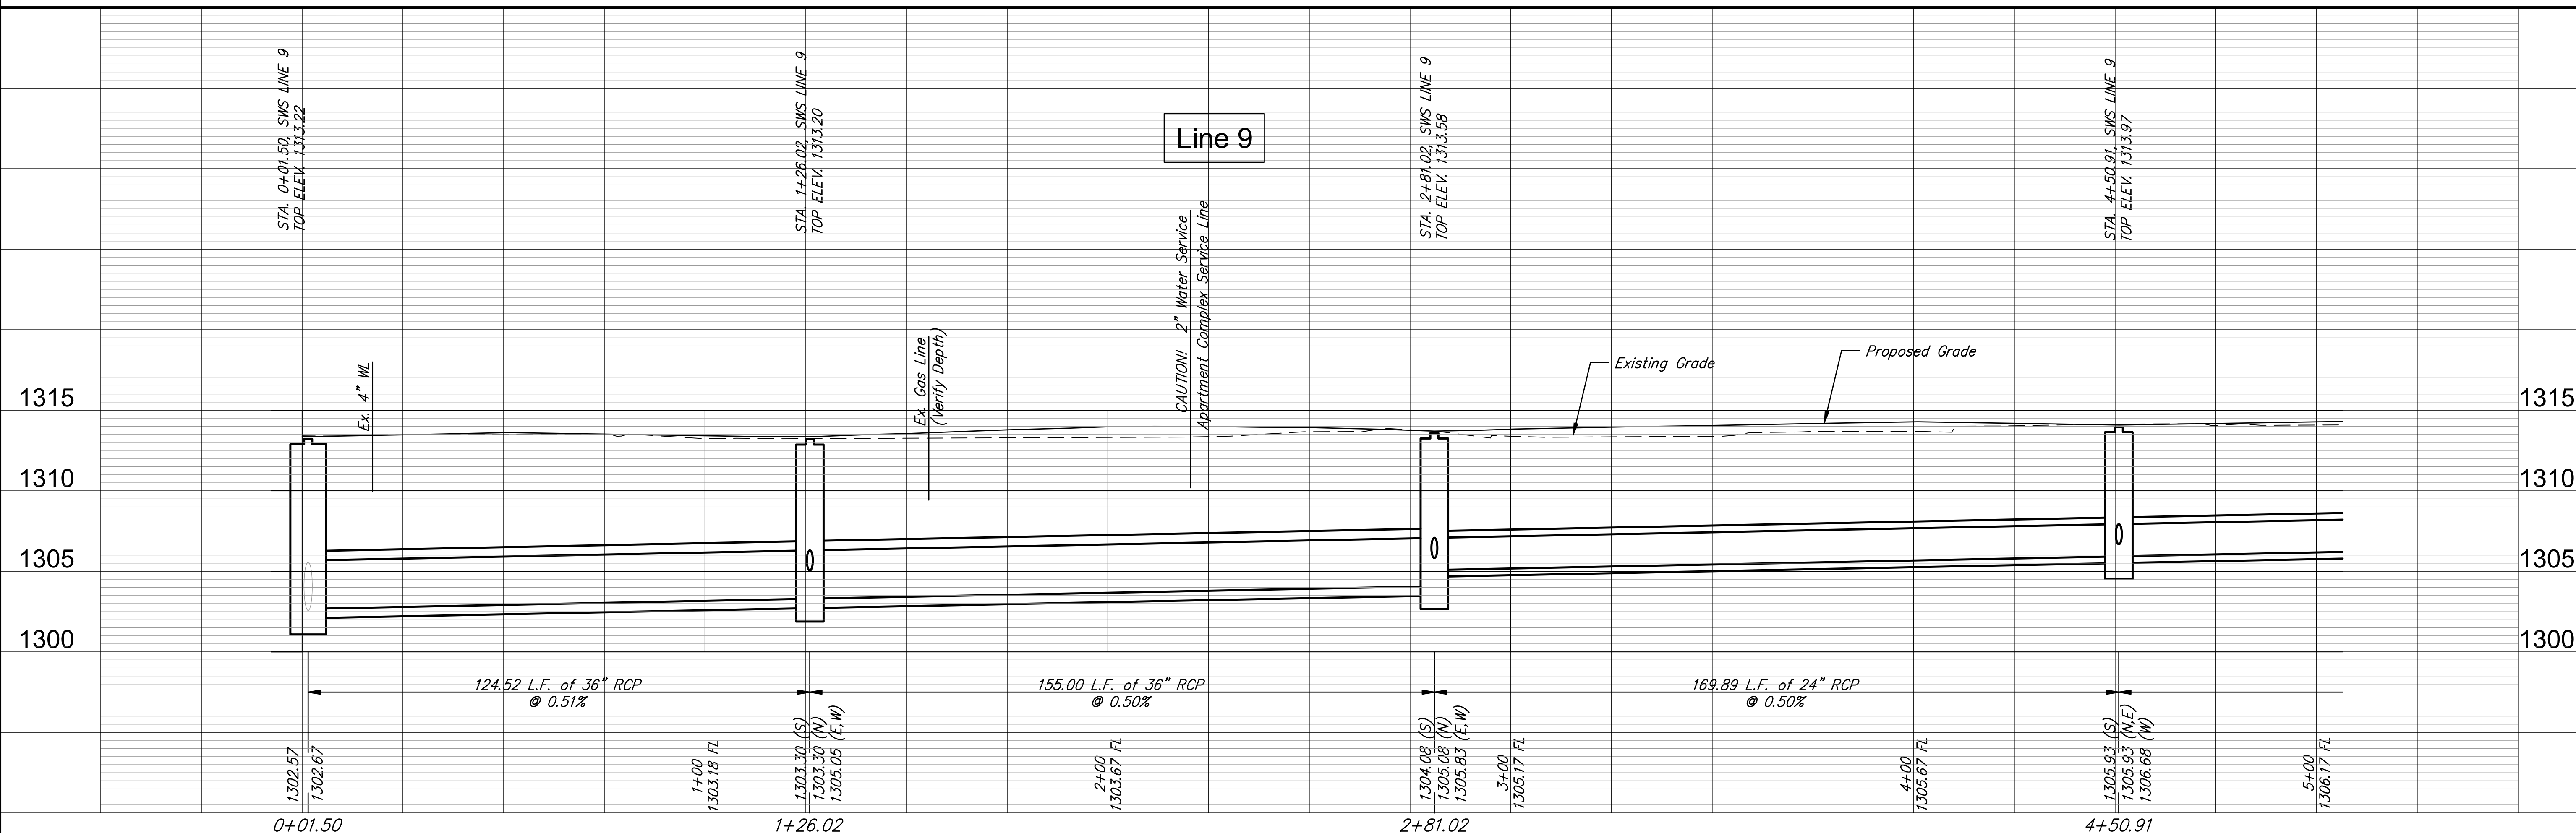

REVIEW: ..
 DATE: Oct. 23, 2014
 DESIGN: KWL
 DRAWN: RA
 PROJECT NUMBER: 472-84914
 DRAWING FILE: ..
 ENGINEERING BASE: {SWS ?}

AMIDON IMPROVEMENTS
 SWS LINE 9
 WICHITA, KANSAS

RB JOB: 3647T
 SHEET: 32 OF 133