


ALL STORM SEWER ON THIS PROJECT UNDER PAVEMENT OR CURB SHALL BE SAND BACKFILLED, JETTED AND VIBRATED.

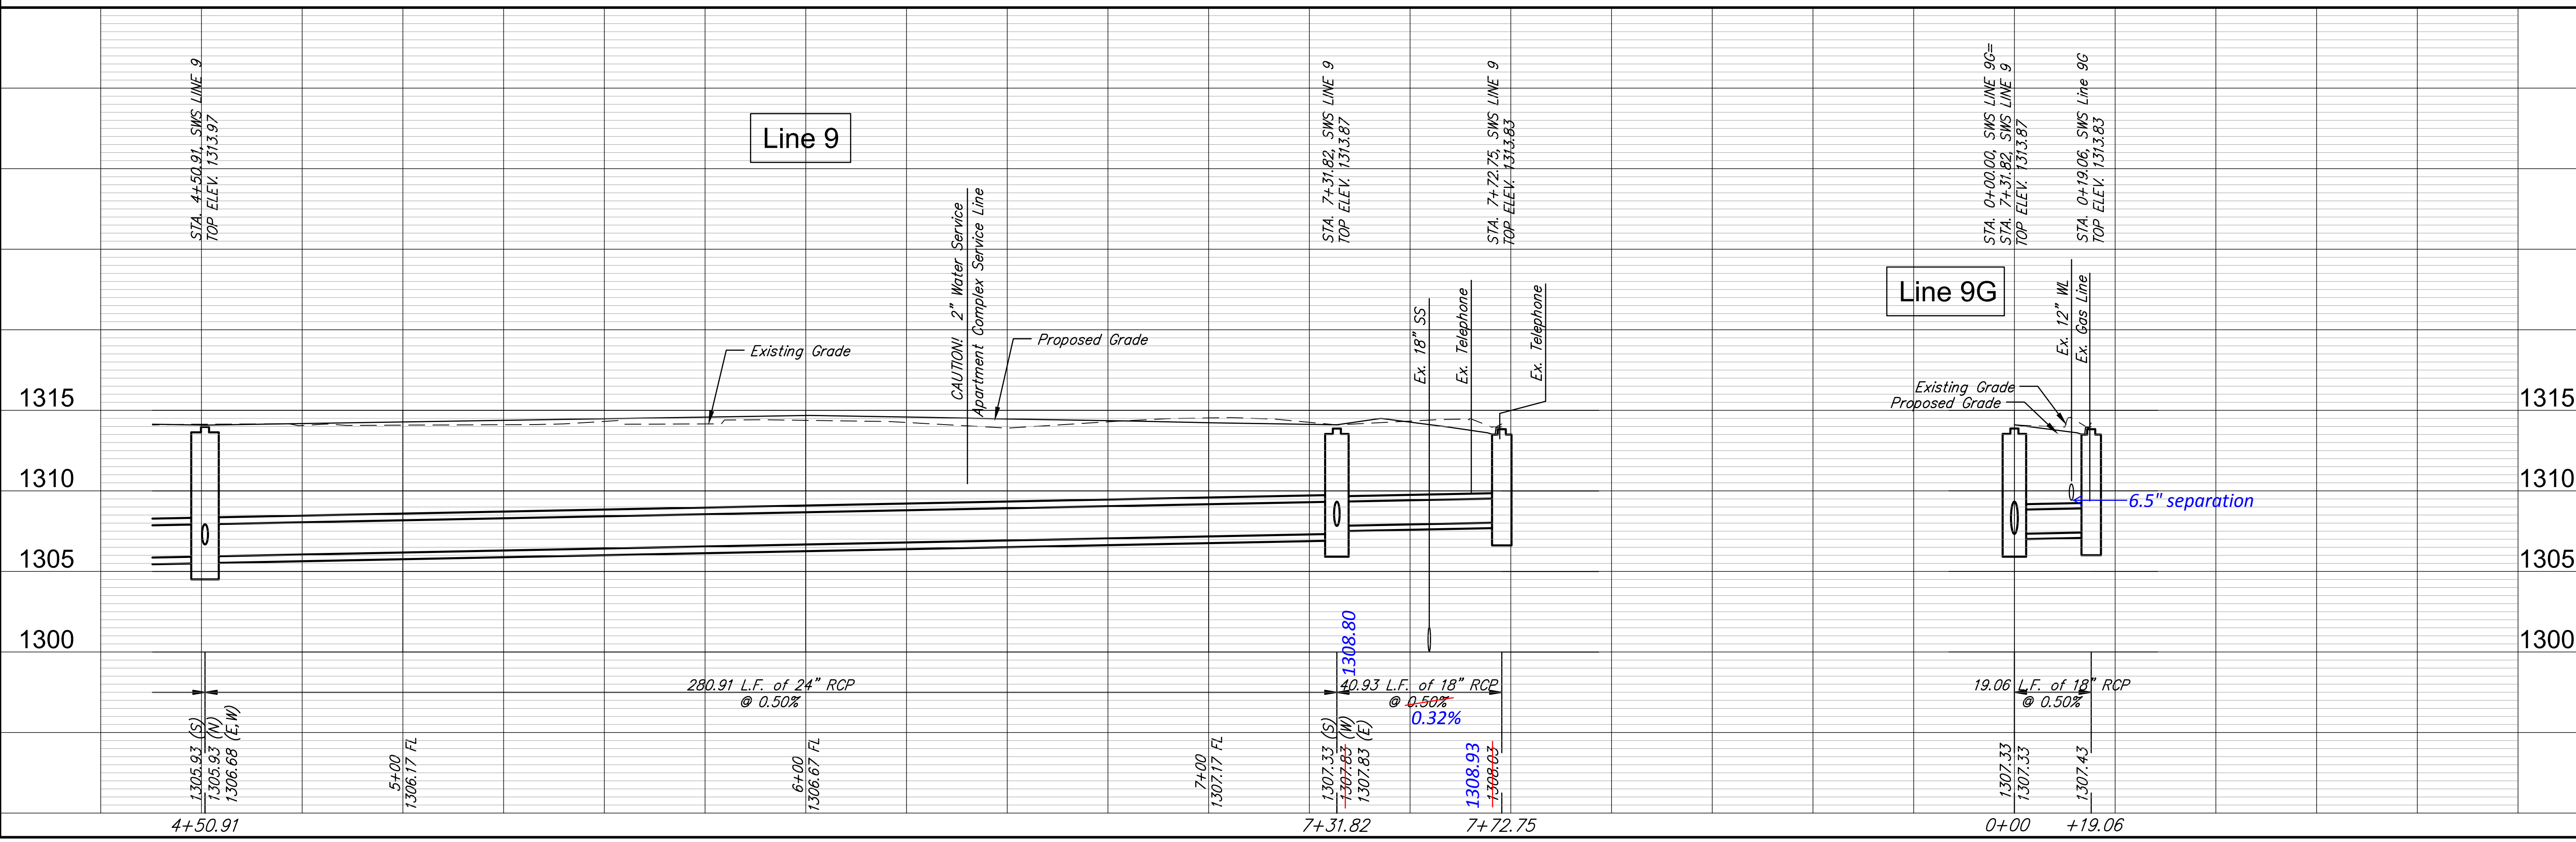

PROJECT NUMBER	472-84914	DESIGN	KWL	REVIEW	
DRAWING FILE		DRAWN	RA	DATE	Oct. 23, 2014
ENGINEERING BASE {SWS 8}					
AMIDON IMPROVEMENTS					
SWS LINE 9					
WICHITA, KANSAS					
RB JOB	3647T				
SHEET	33				
OF	133				