



NOTE: EXISTING PIPE REMOVAL CALLED OUT ON SHEET 32

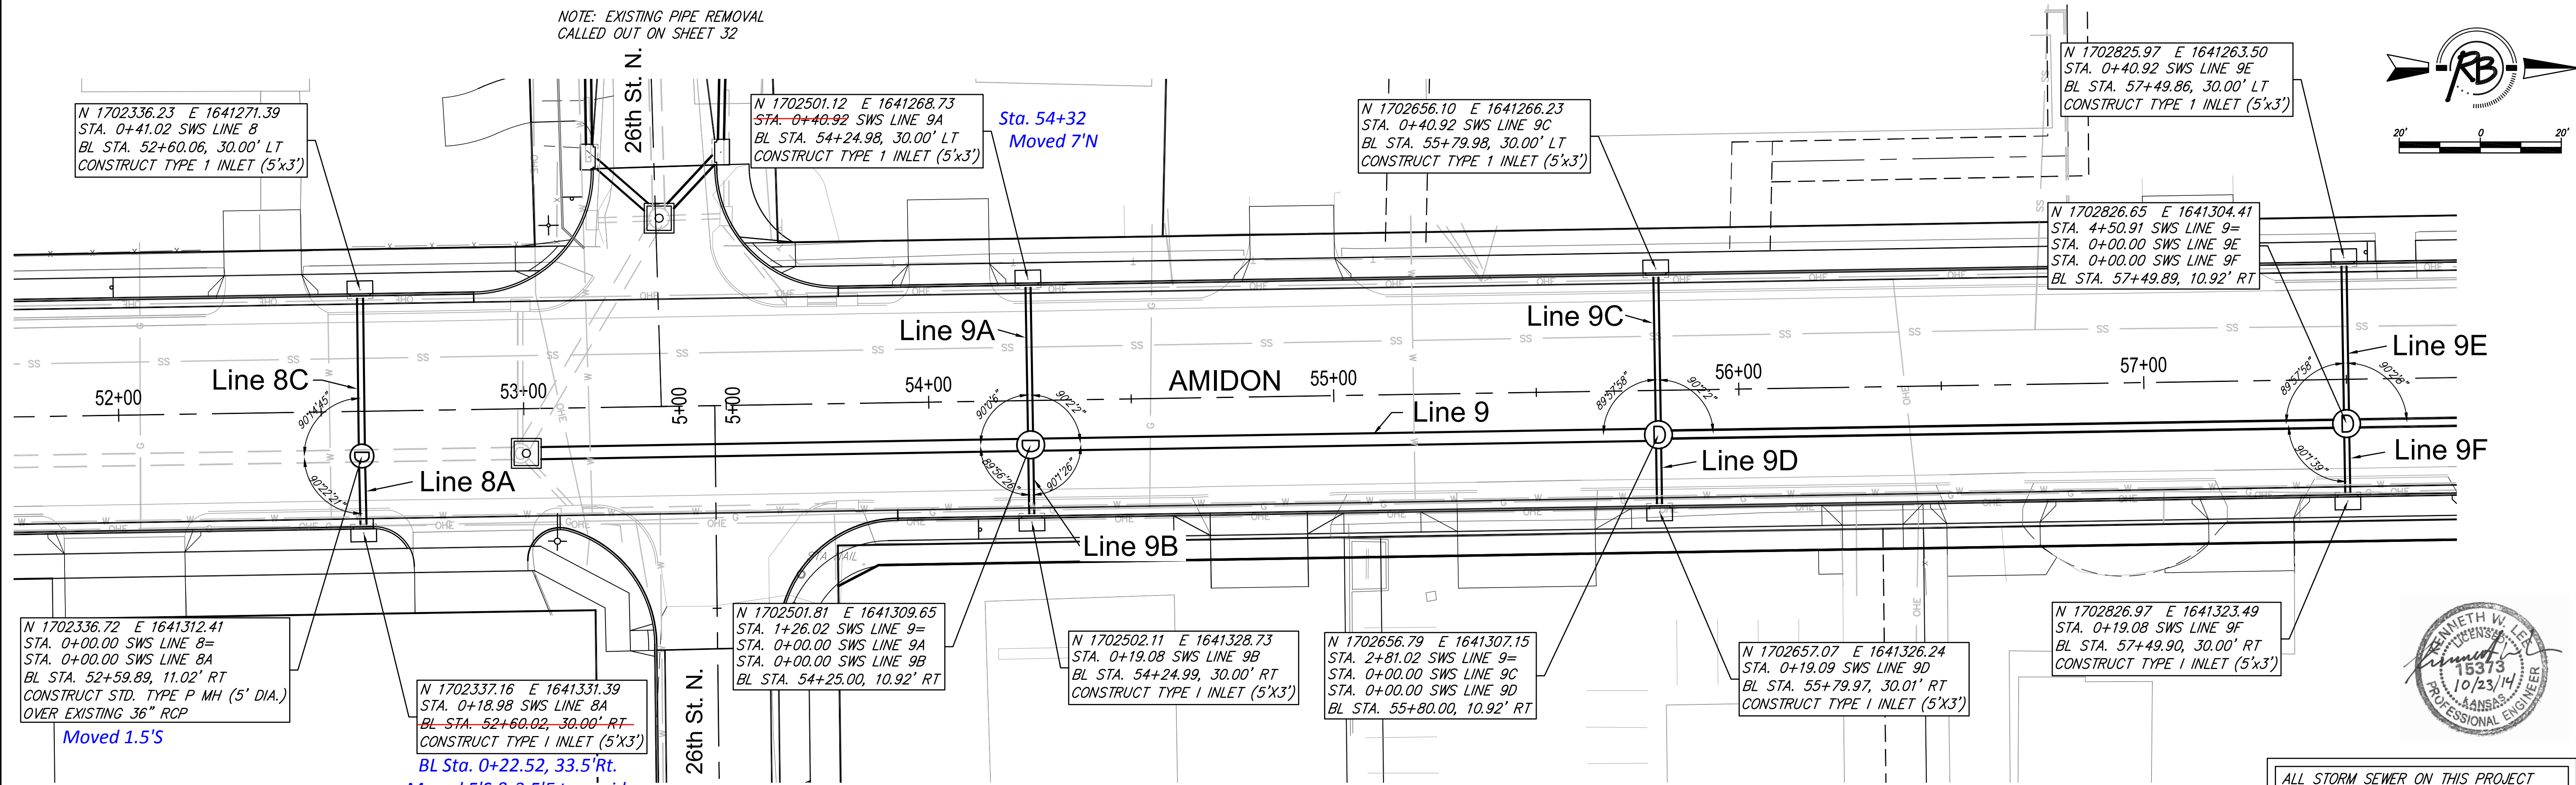

Moved 1.5'S
 Moved 5'S & 3.5'E to avoid wl and driveway radius.


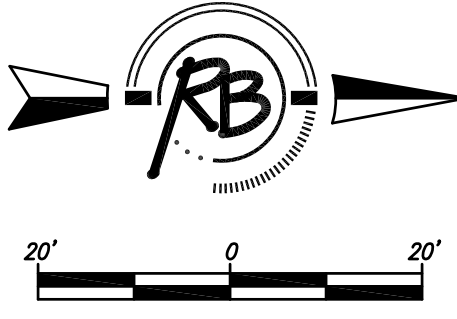

PROJECT NUMBER: 472-84914
 PERSON: KWL
 DATE: Oct. 23, 2014
 DRAWN: RA
 REVIEW: [Blank]
 AMIDON IMPROVEMENTS
 SWS LINE 8, 9A, 9B, 9C, 9D, 9E, 9F
 WICHITA, KANSAS
 SHEET: 34 OF 133