
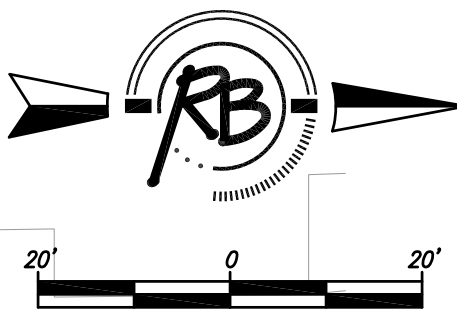
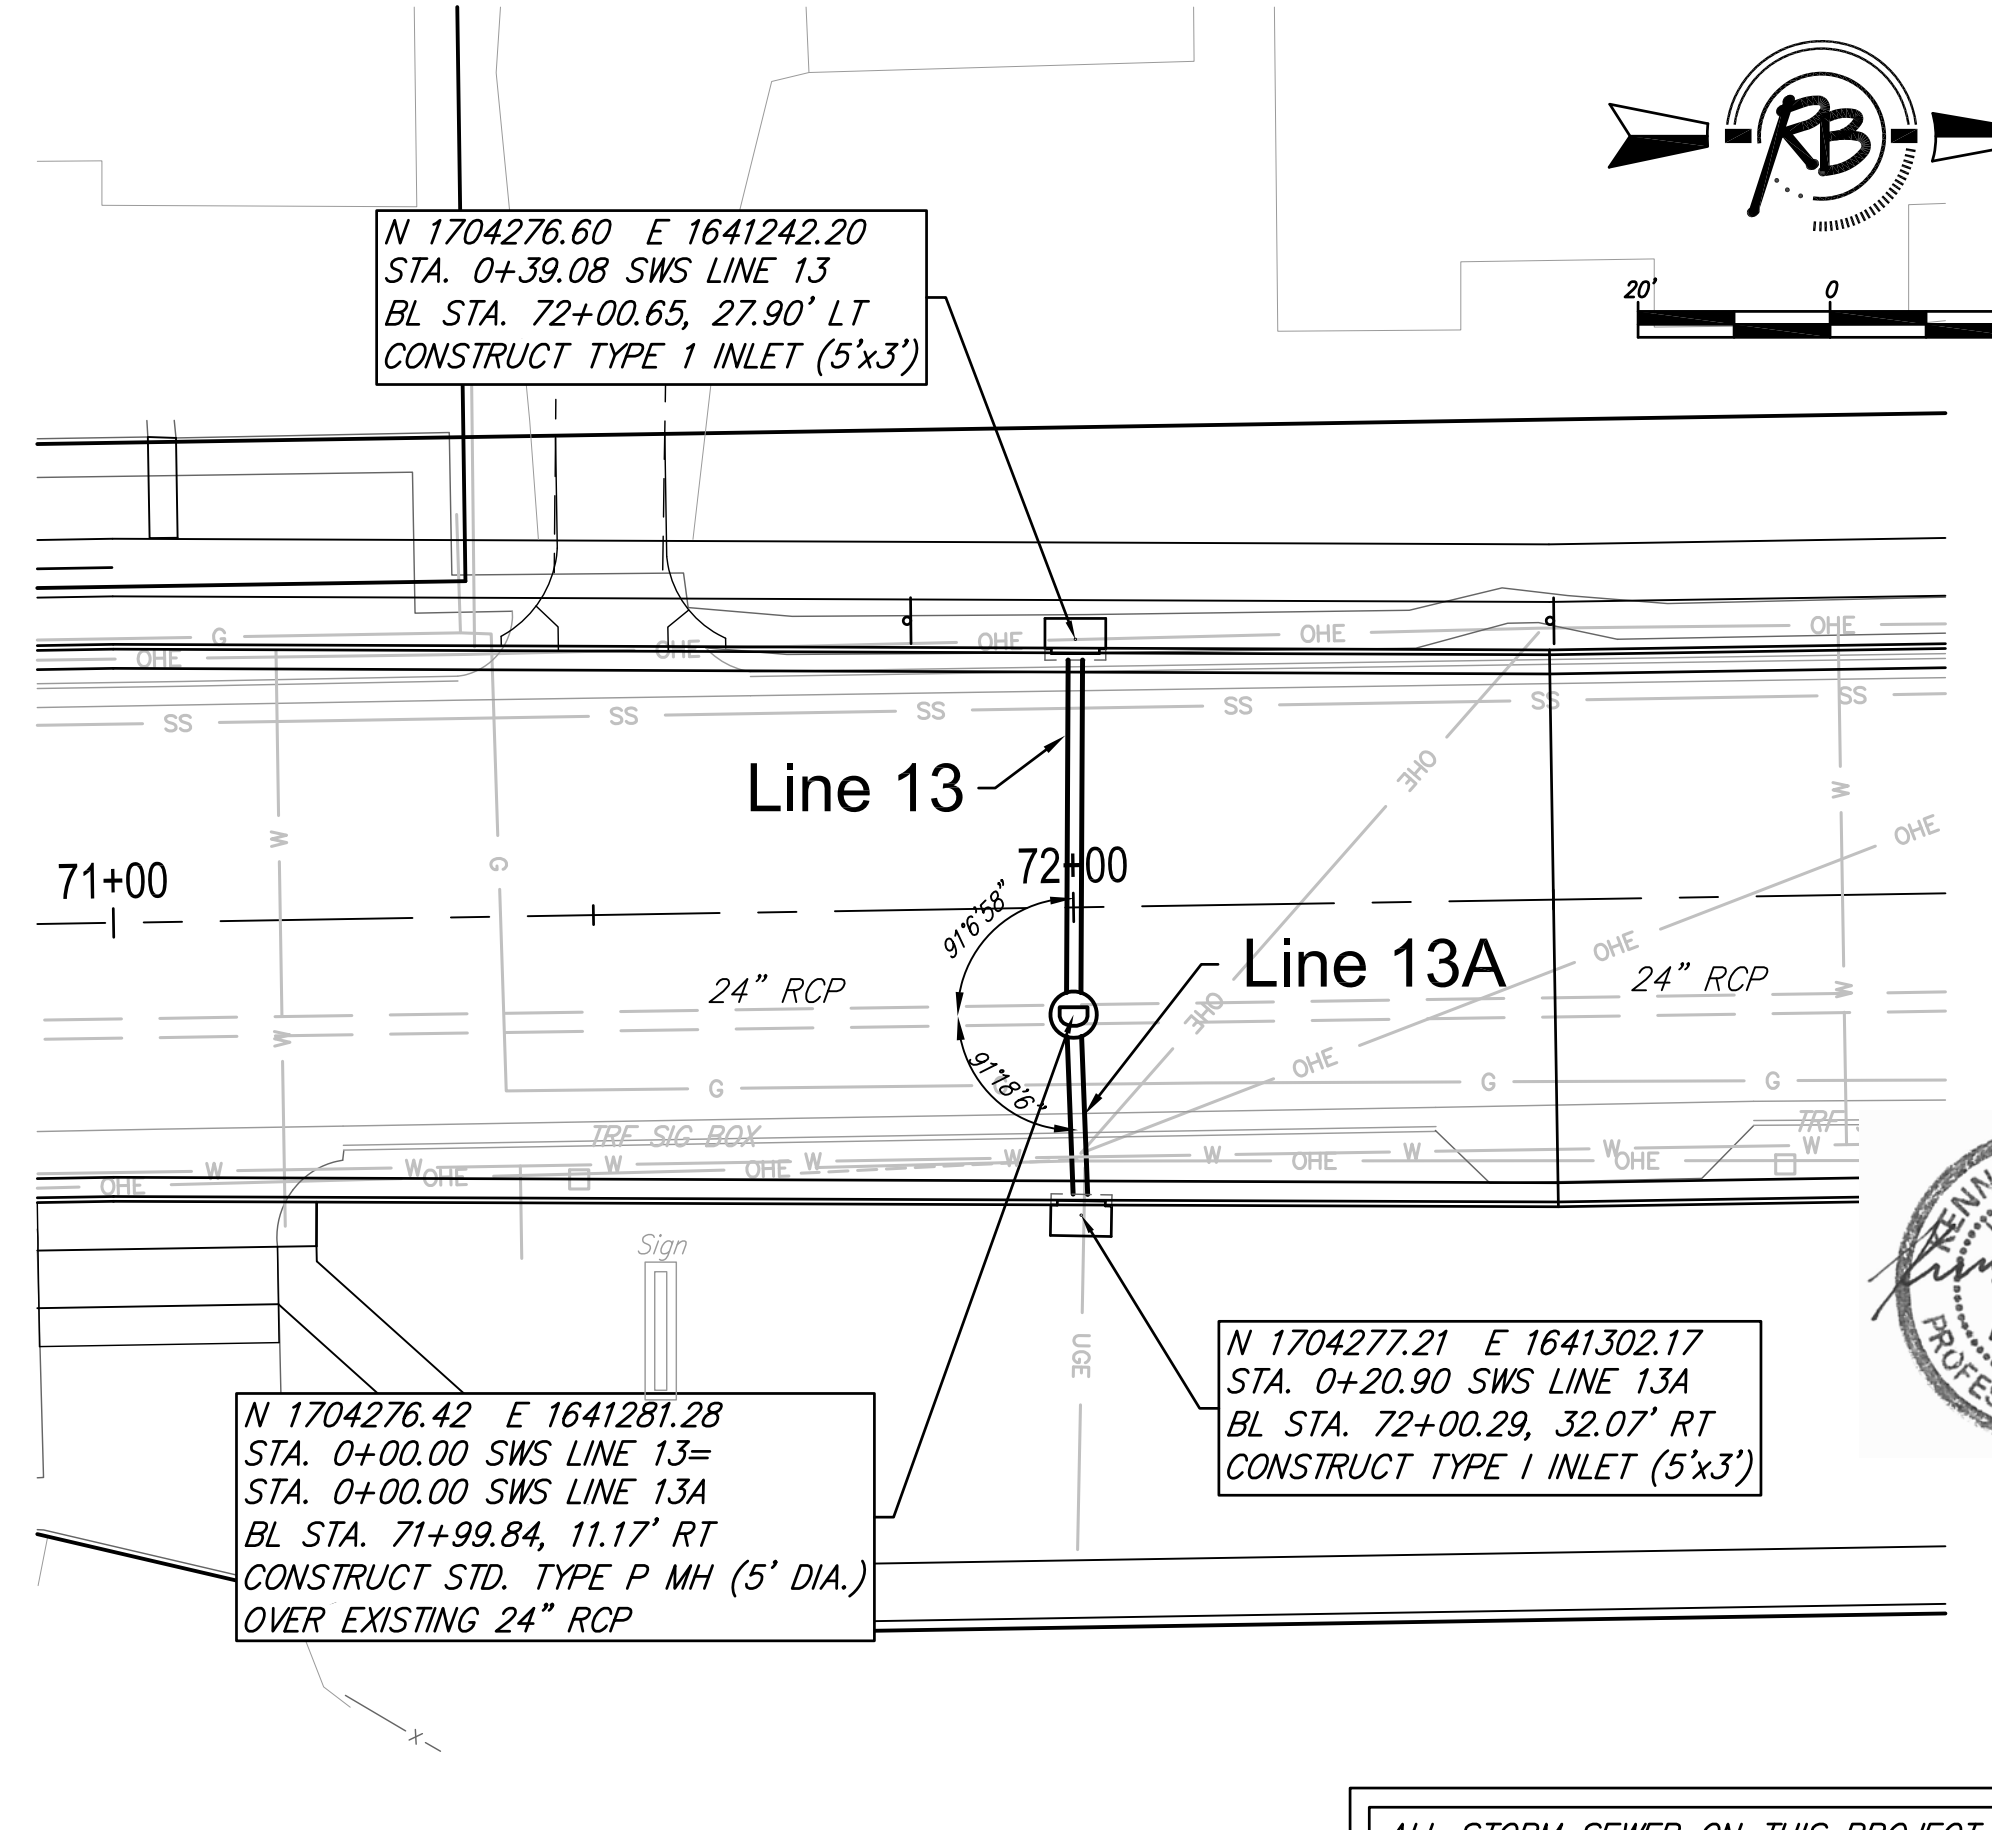
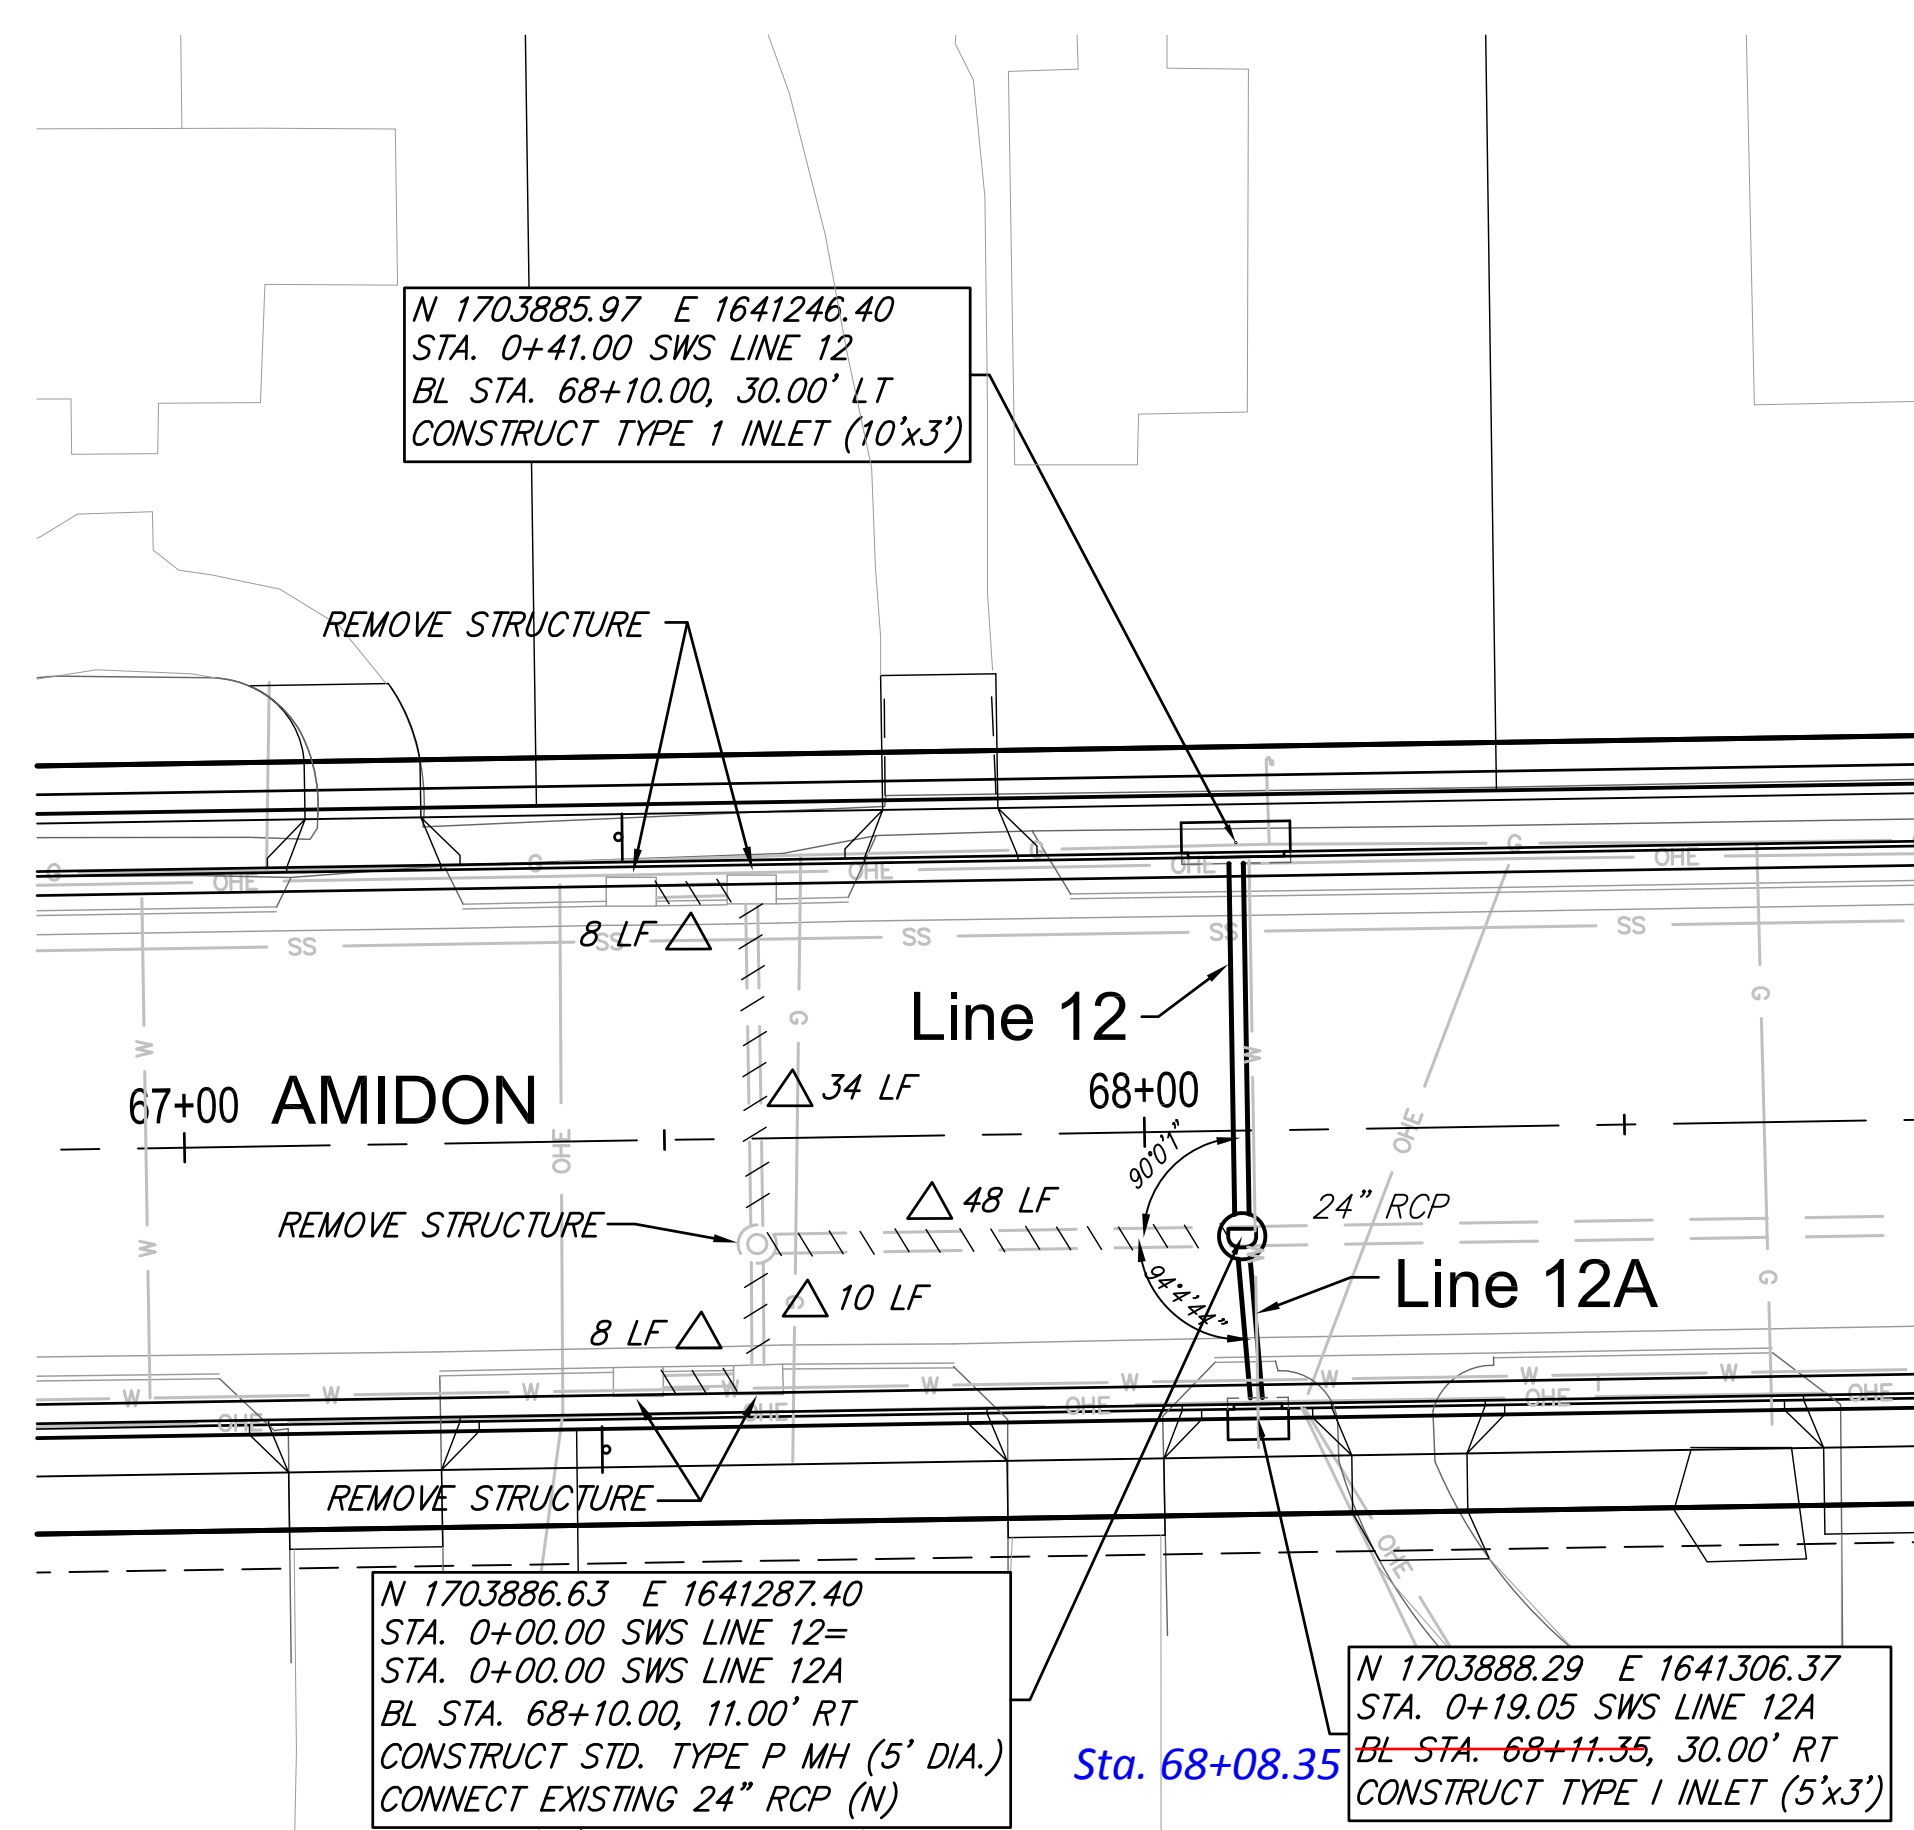


Moved 5'E to avoid wl.

NOTE: EXISTING PIPE REMOVAL CALLED OUT ON SHEET 32

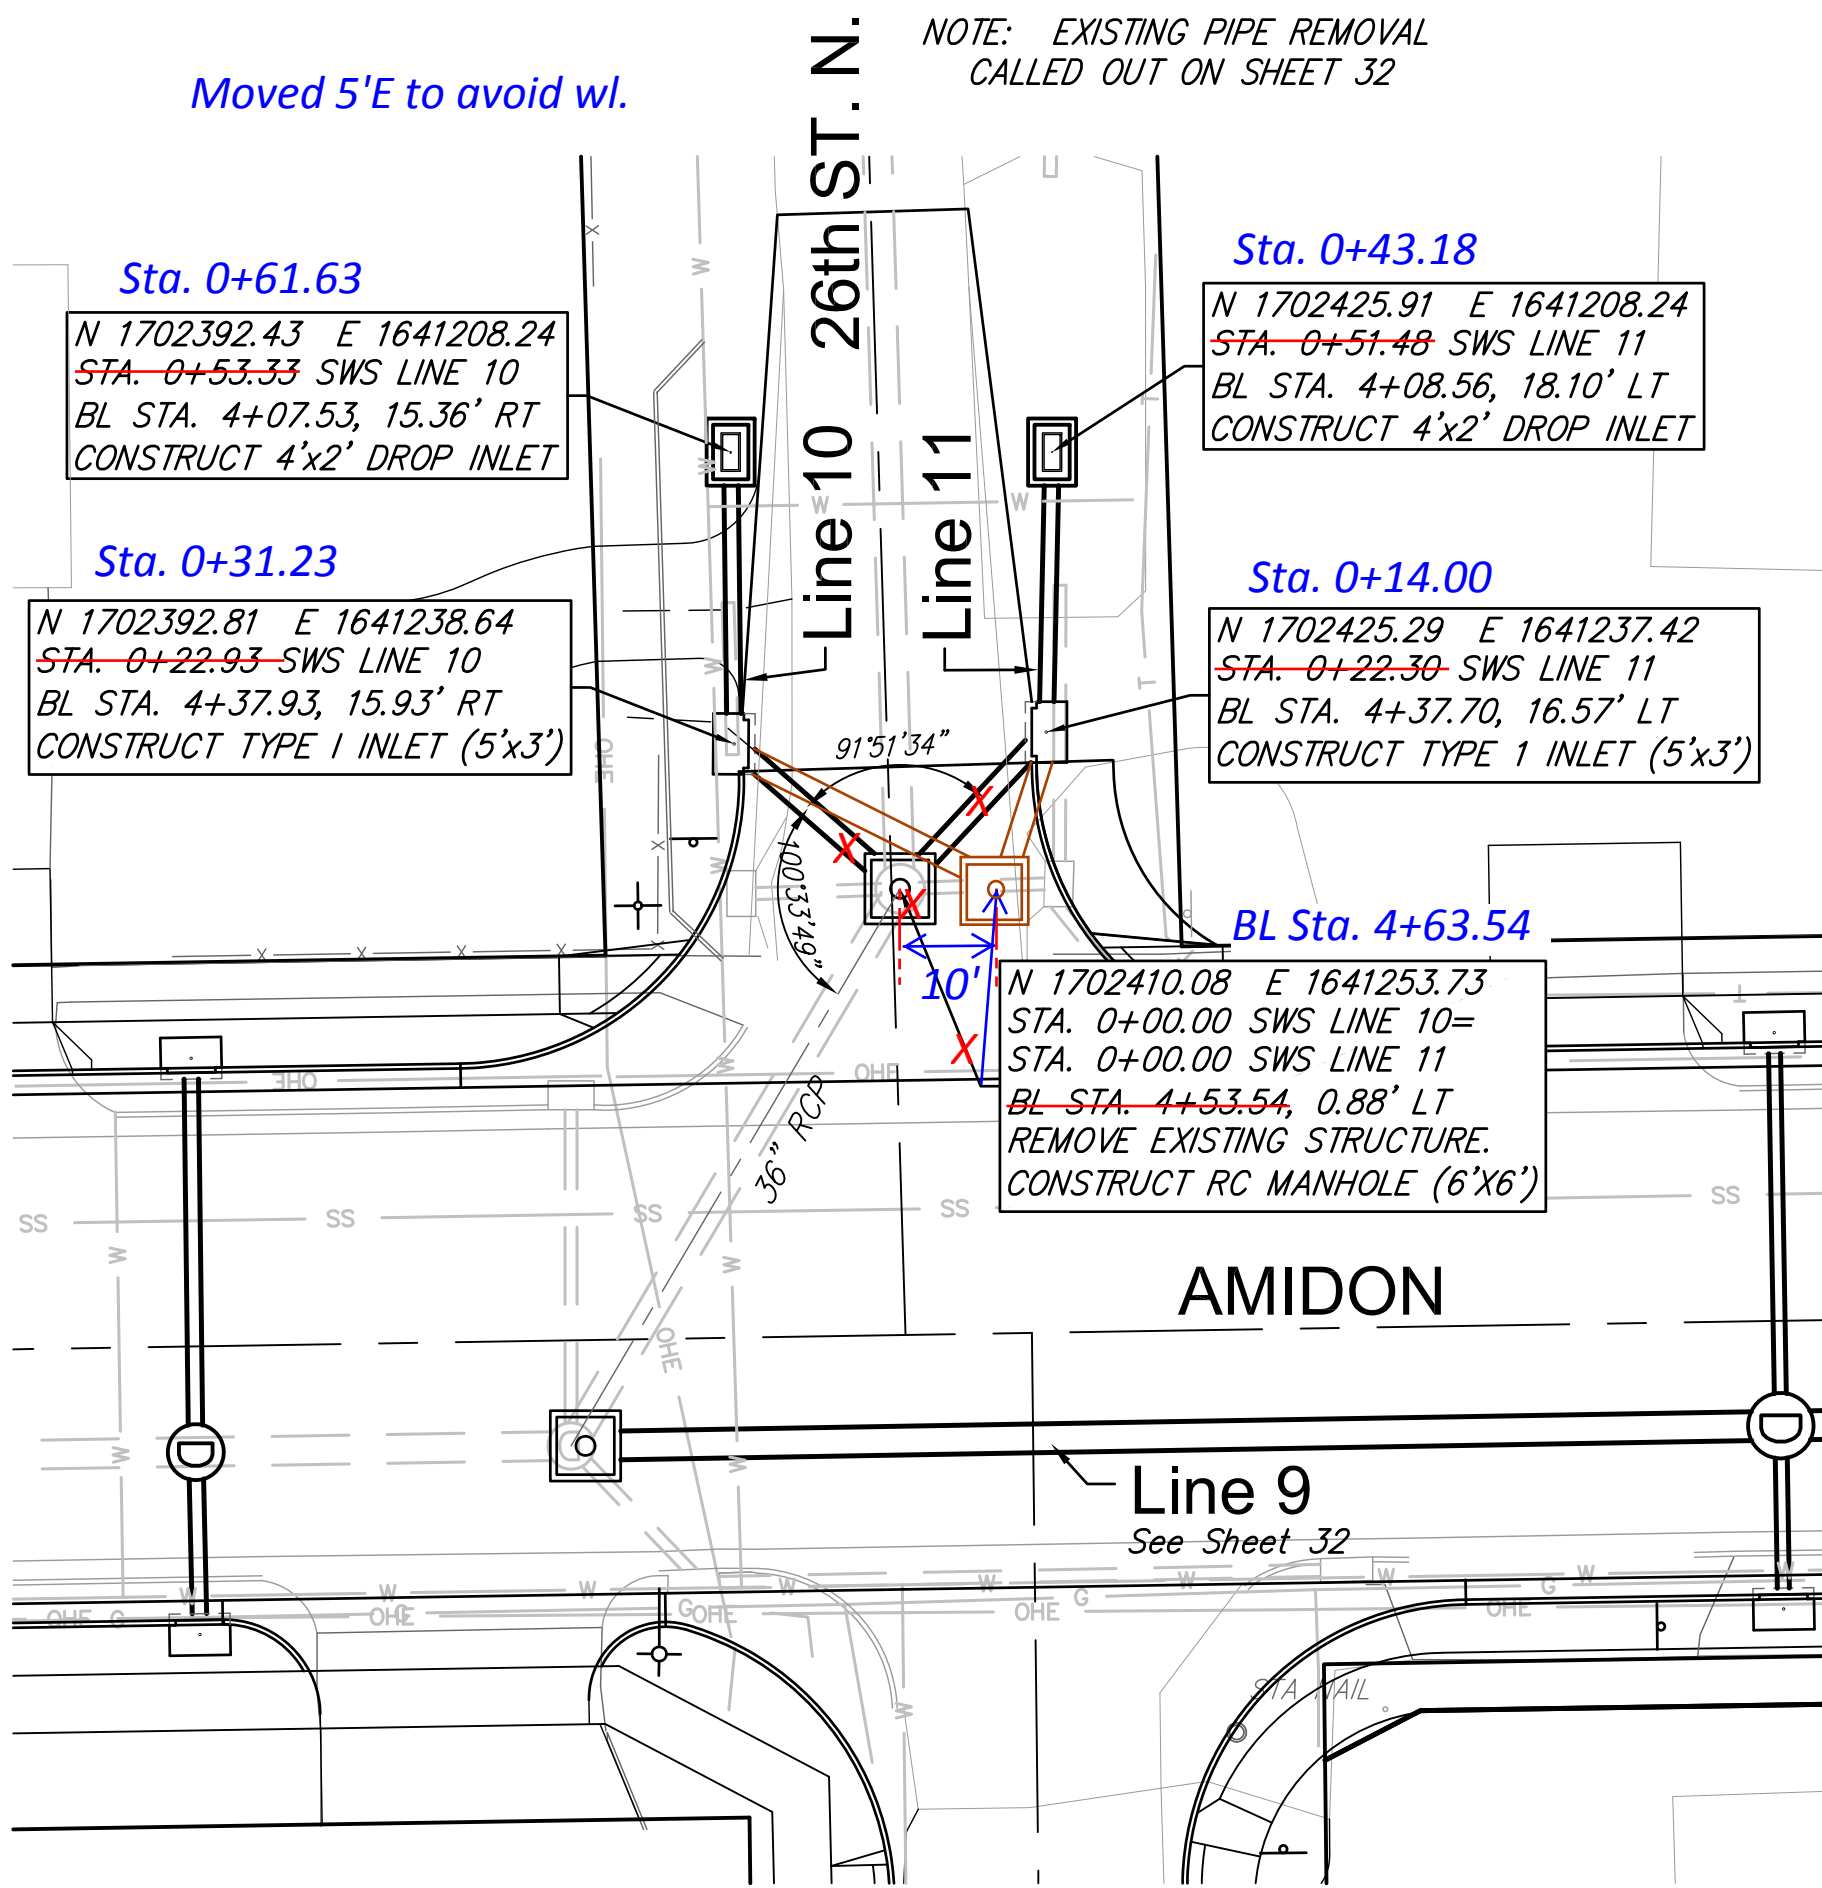

ALL STORM SEWER ON THIS PROJECT UNDER PAVEMENT OR CURB SHALL BE SAND BACKFILLED, JETTED AND VIBRATED.

△XX LF - REMOVE "X" LF STORM SEWER PIPE.


RUGGLES & BOHM  
ENGINEERING

AMIDON IMPROVEMENTS  
SWS LINE 10, 11, 12, 12A, 13, 13A  
WICHITA, KANSAS

PROJECT NUMBER: 472-84914  
DESIGNER: KWL  
DRAWN: RA  
ENGINEERING BASE: [SWS 10]

REVIEW: ...  
DATE: Oct. 23, 2014

35 OF 133