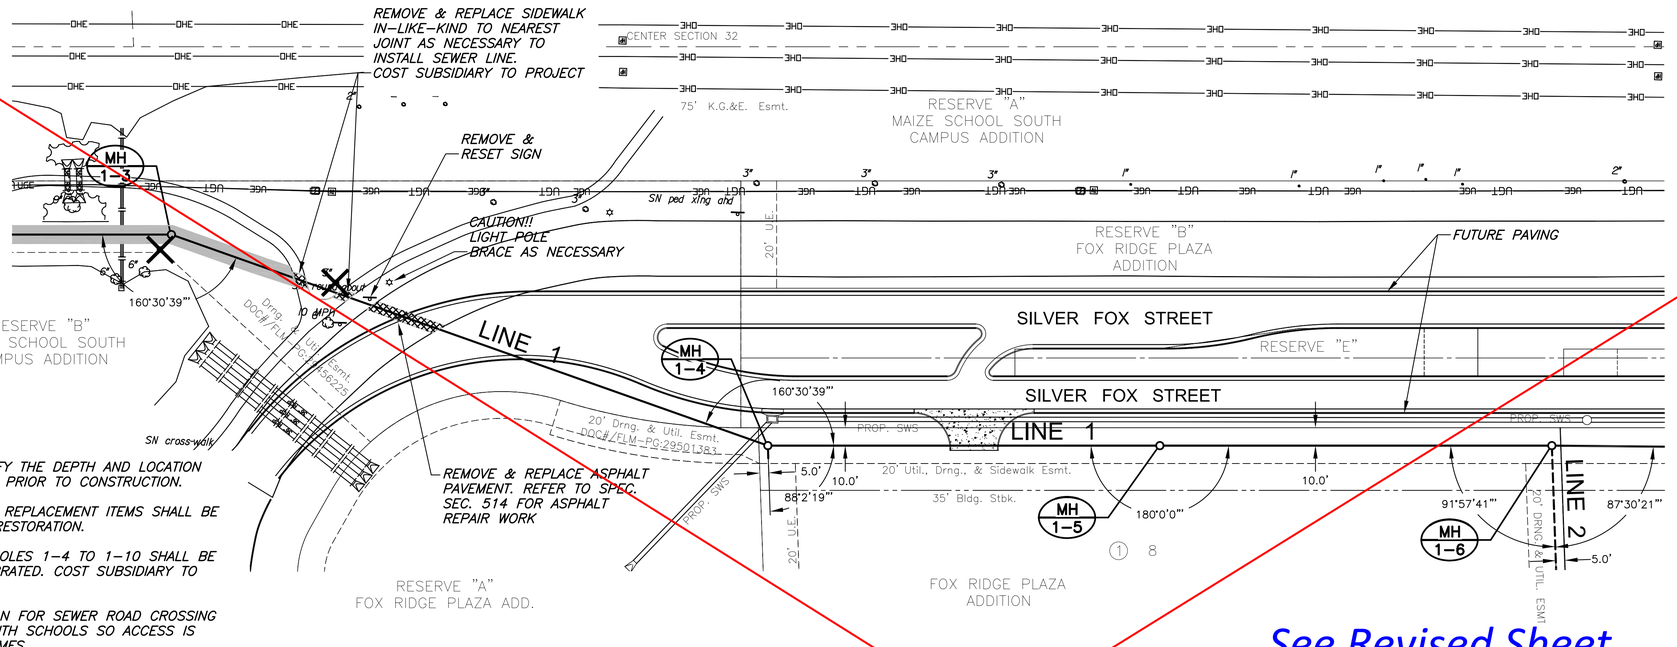

NOTE:

1. CONTRACTOR TO VERIFY THE DEPTH AND LOCATION OF EXISTING UTILITIES PRIOR TO CONSTRUCTION.
2. COST OF REMOVAL & REPLACEMENT ITEMS SHALL BE SUBSIDIARY TO SITE RESTORATION.
3. LINES BETWEEN MANHOLES 1-4 TO 1-10 SHALL BE SAND FLUSHED & VIBRATED. COST SUBSIDIARY TO PROJECT.
4. TRAFFIC CONTROL PLAN FOR SEWER ROAD CROSSING SHALL COORDINATE WITH SCHOOLS SO ACCESS IS MAINTAINED AT ALL TIMES.

PLAN LINE 1

See Revised Sheet
MH-1-5 moved 35.8' E

PROFILE LINE 1

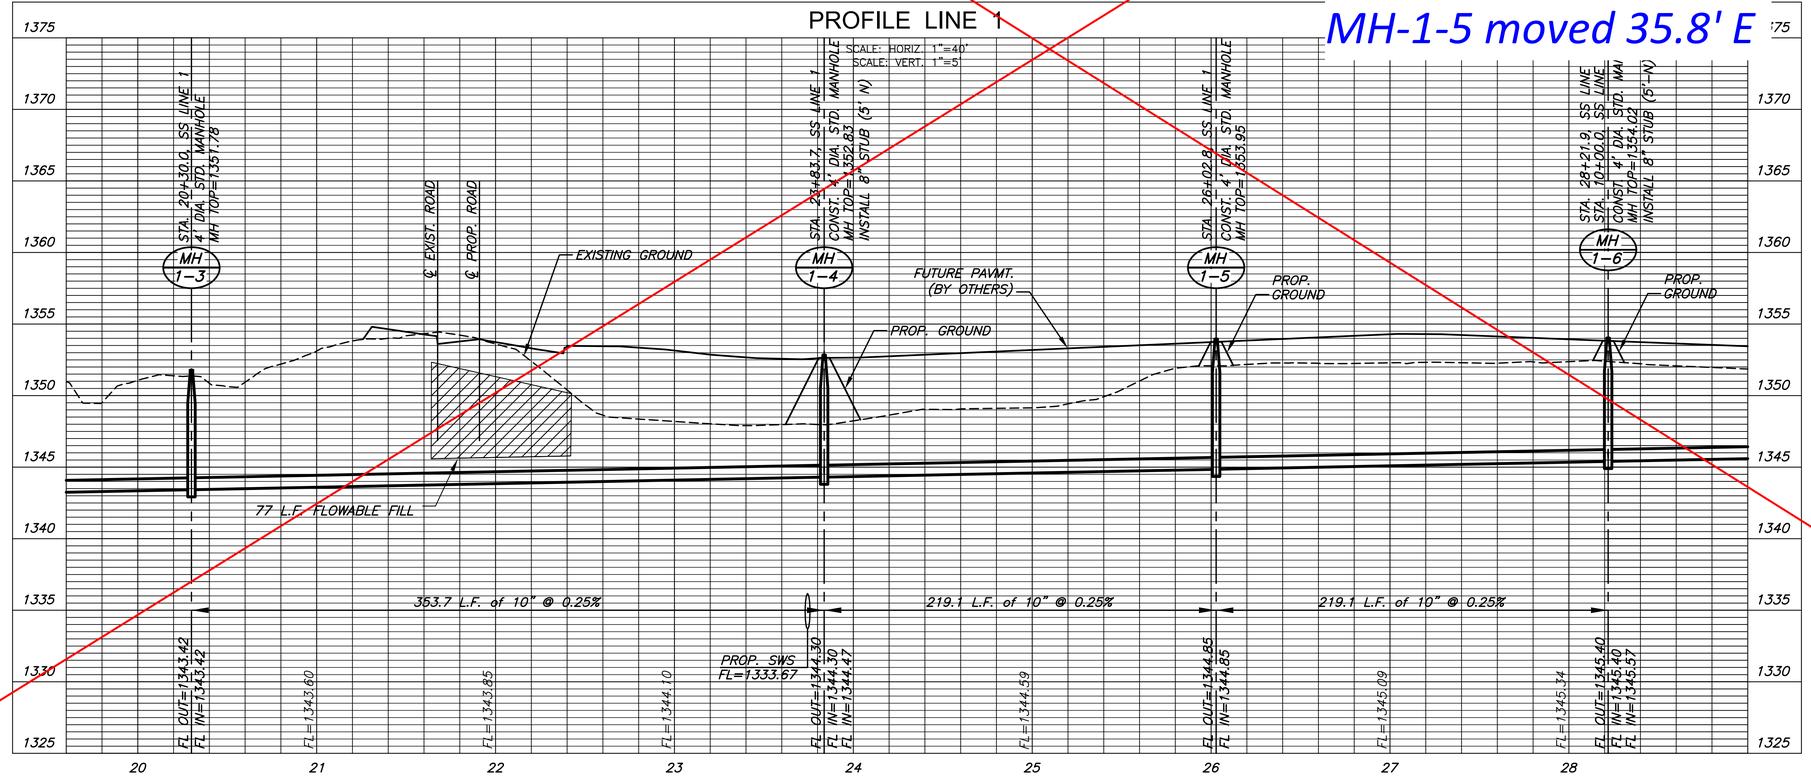

GREGORY J. ALLISON
LICENSED
11159
KANSAS
PROFESSIONAL ENGINEER
2/17/15

MKEC
Wichita, KS • 316-684-9600

SANITARY SEWER PLANS FOR

FOX RIDGE PLAZA ADDITION

©2015
MKEC Engineering
All Rights Reserved
www.mkec.com
These drawings and their contents, including, but not limited to, all concepts, designs, & ideas are the exclusive property of MKEC Engineering (MKEC), and may not be used or reproduced in any way without the express consent of MKEC.

LINE 1

PROJECT NO.	468-84951
DATE	DEC. 2014
SCALE	AS SHOWN

DESIGNED	DRAWN	CHECKED
DFL	KKL	GJA

NO.	REVISION	DATE

SHEET NO.
6 OF 16

PLOTTED: Wednesday, February 18, 2015 @ 09:24AM

J:\PROJECTS\2011\11\0\10577 PREMIER FOX RIDGE PLAZA\AS-CIVIL\CAD\SAN\11577_B2.DWG