



SEWER SERVICE TABLE						
NO.	TYPE	LOCATION			FOR INFORMATION ONLY	
		LOT NO.	BLOCK	LINE NO. / STATION / DIRECTION	APPROX. LENGTH 4" PIPE	
					VERTICAL	HORIZONTAL
1	TEE SERVICE CONNECTION	8	1	2 11+30/LT.	7'	15'
2	TEE SERVICE CONNECTION	8	1	2 12+60/LT.	6'	15'

NOTE:  
CONTRACTOR TO VERIFY THE  
DEPTH AND LOCATION OF EXISTING  
UTILITIES PRIOR TO CONSTRUCTION.

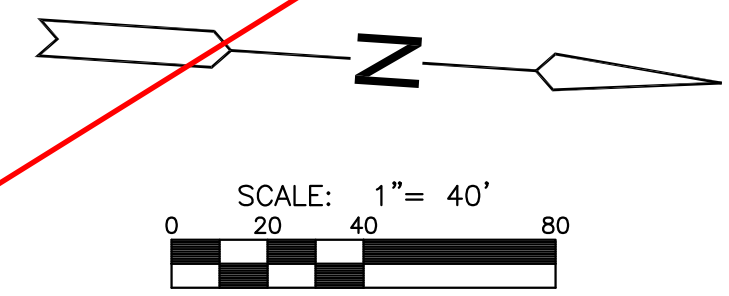

PLAN LINE 2  
PROFILE LINE 2

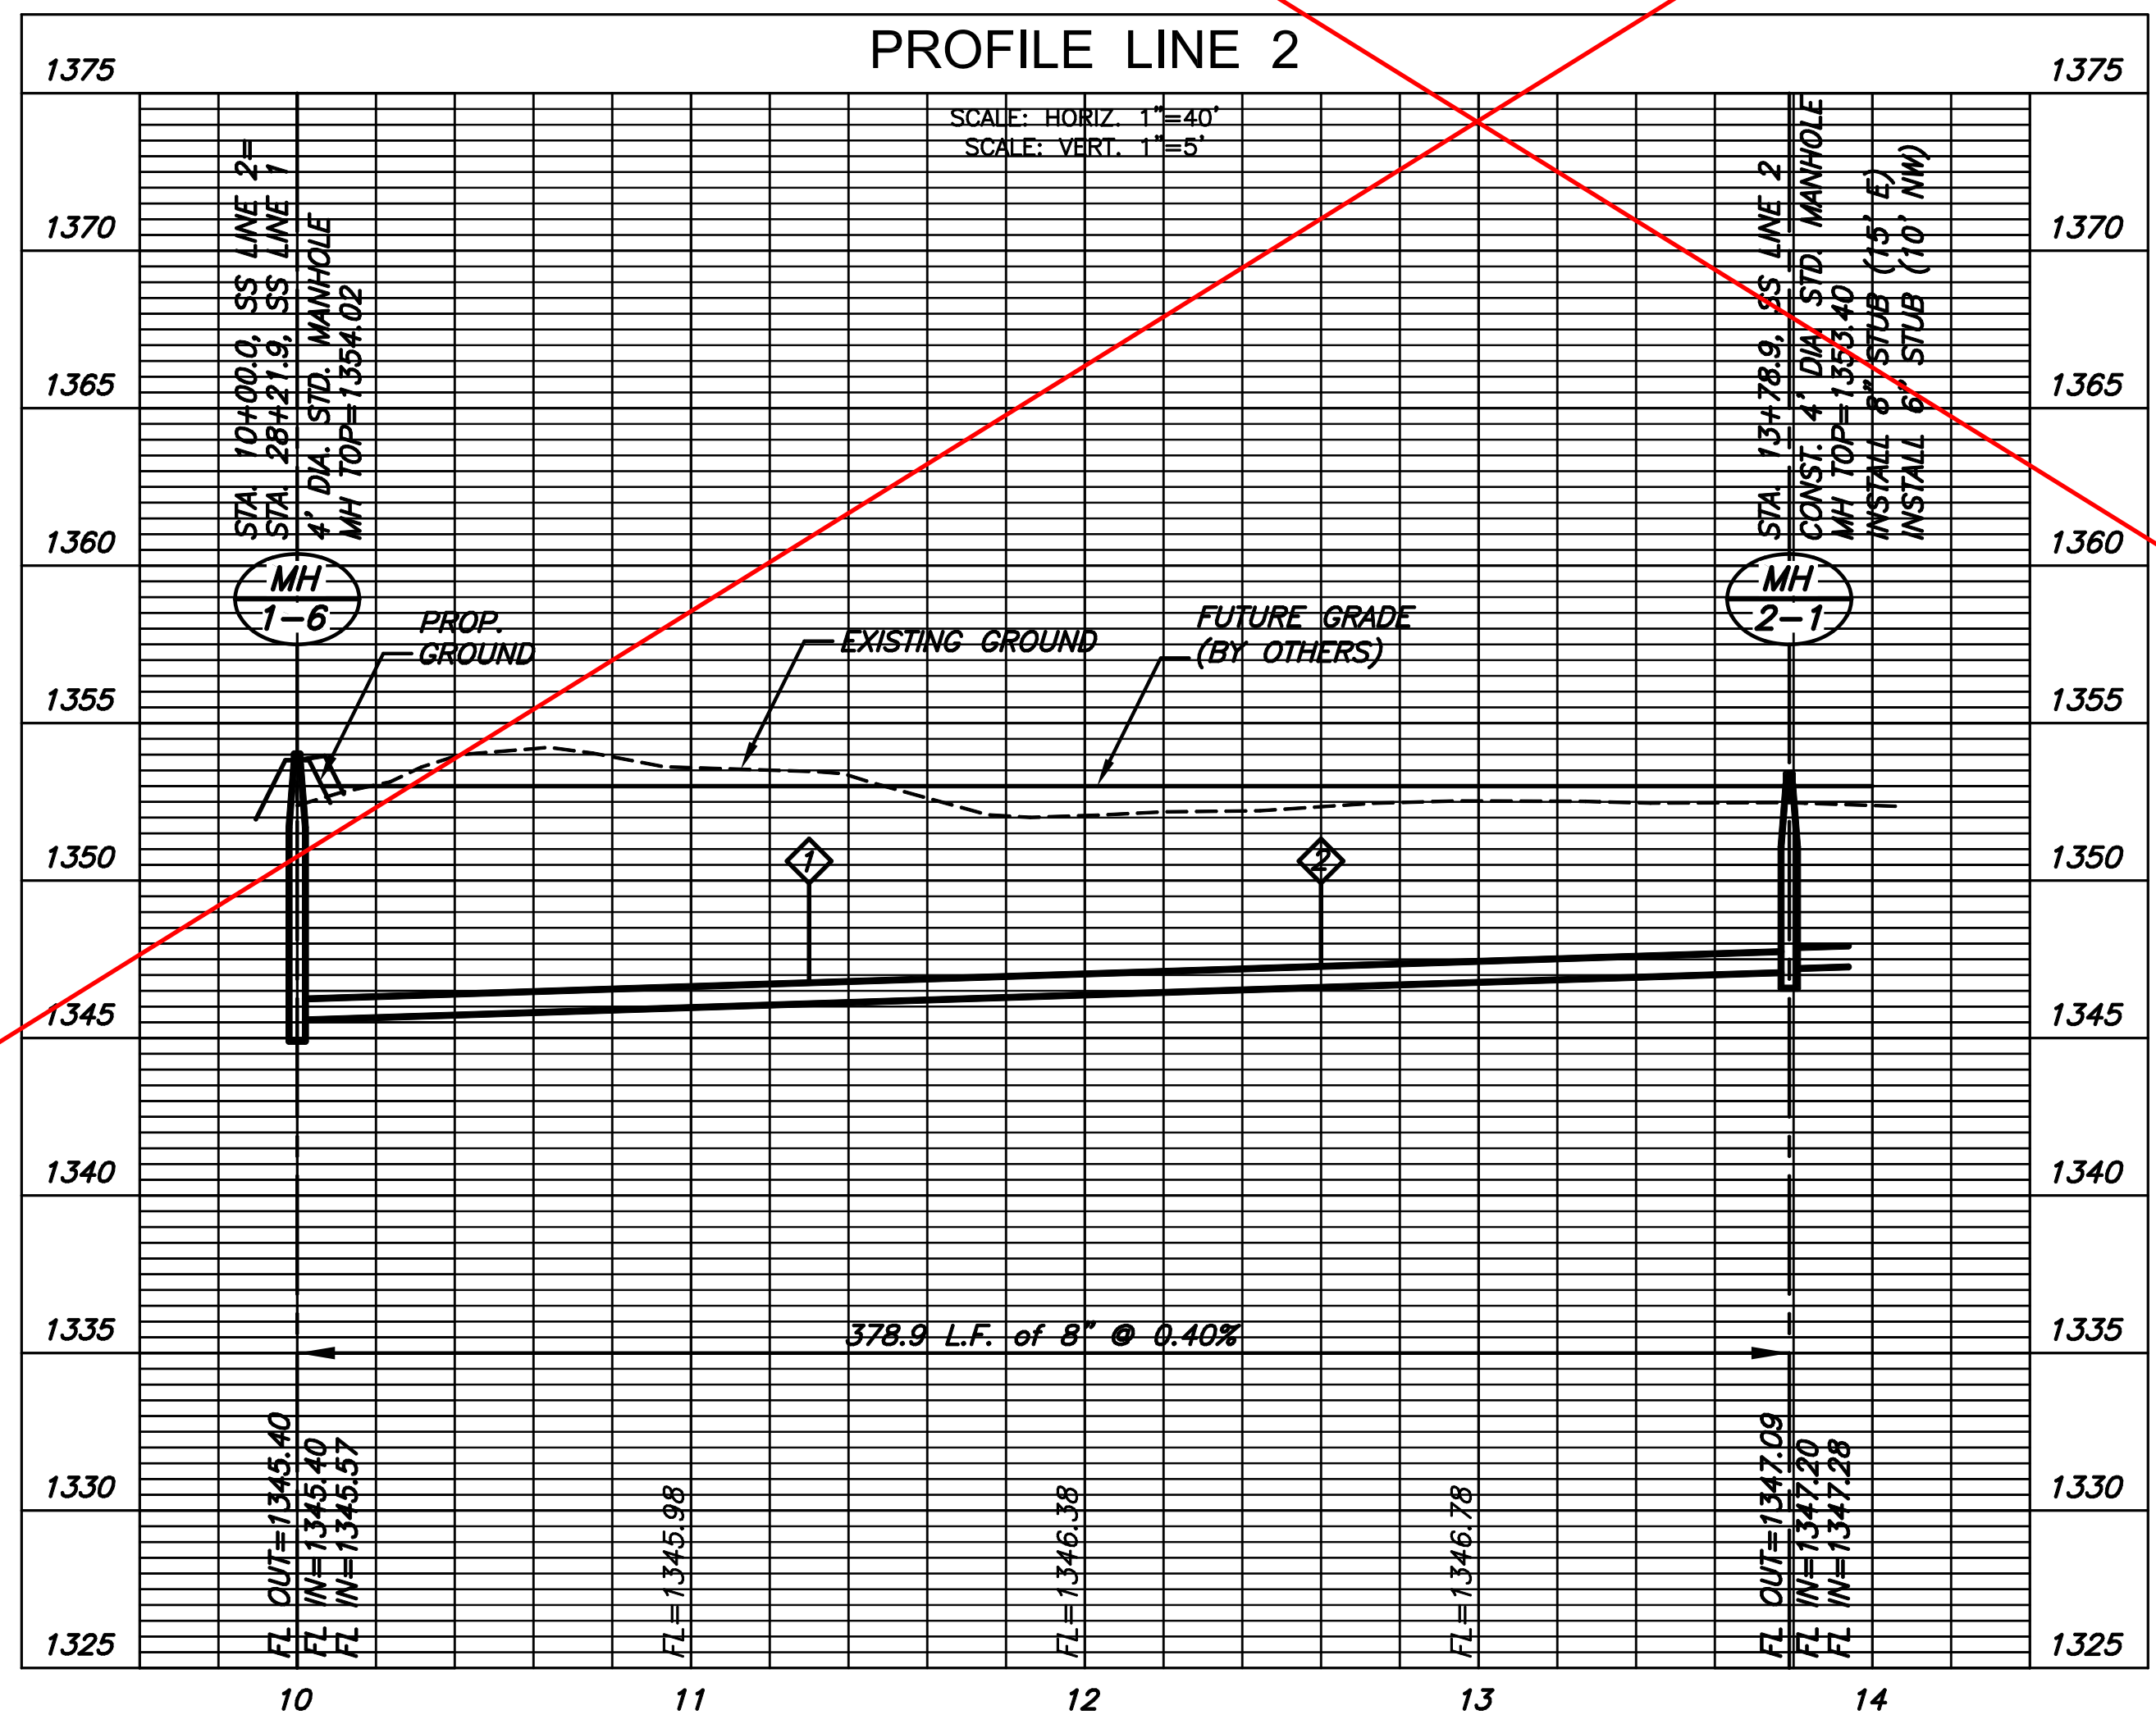

Line 2 built with PPS

SANITARY SEWER PLANS FOR  
**FOX RIDGE PLAZA ADDITION**

©2015  
MKEC Engineering  
All Rights Reserved  
www.mkec.com

These drawings and their contents, including, but not limited to, all concepts, designs, & ideas are the exclusive property of MKEC Engineering (MKEC), and may not be used or reproduced in any way without the express consent of MKEC.

LINE 2	
PROJECT NO.	468-84951
DATE	DEC. 2014
SCALE	AS SHOWN
DESIGNED	DRAWN
DFL	BKS
CHECKED	GJA
NO.	REVISION
	DATE
SHEET NO.	
9 OF 16	

