
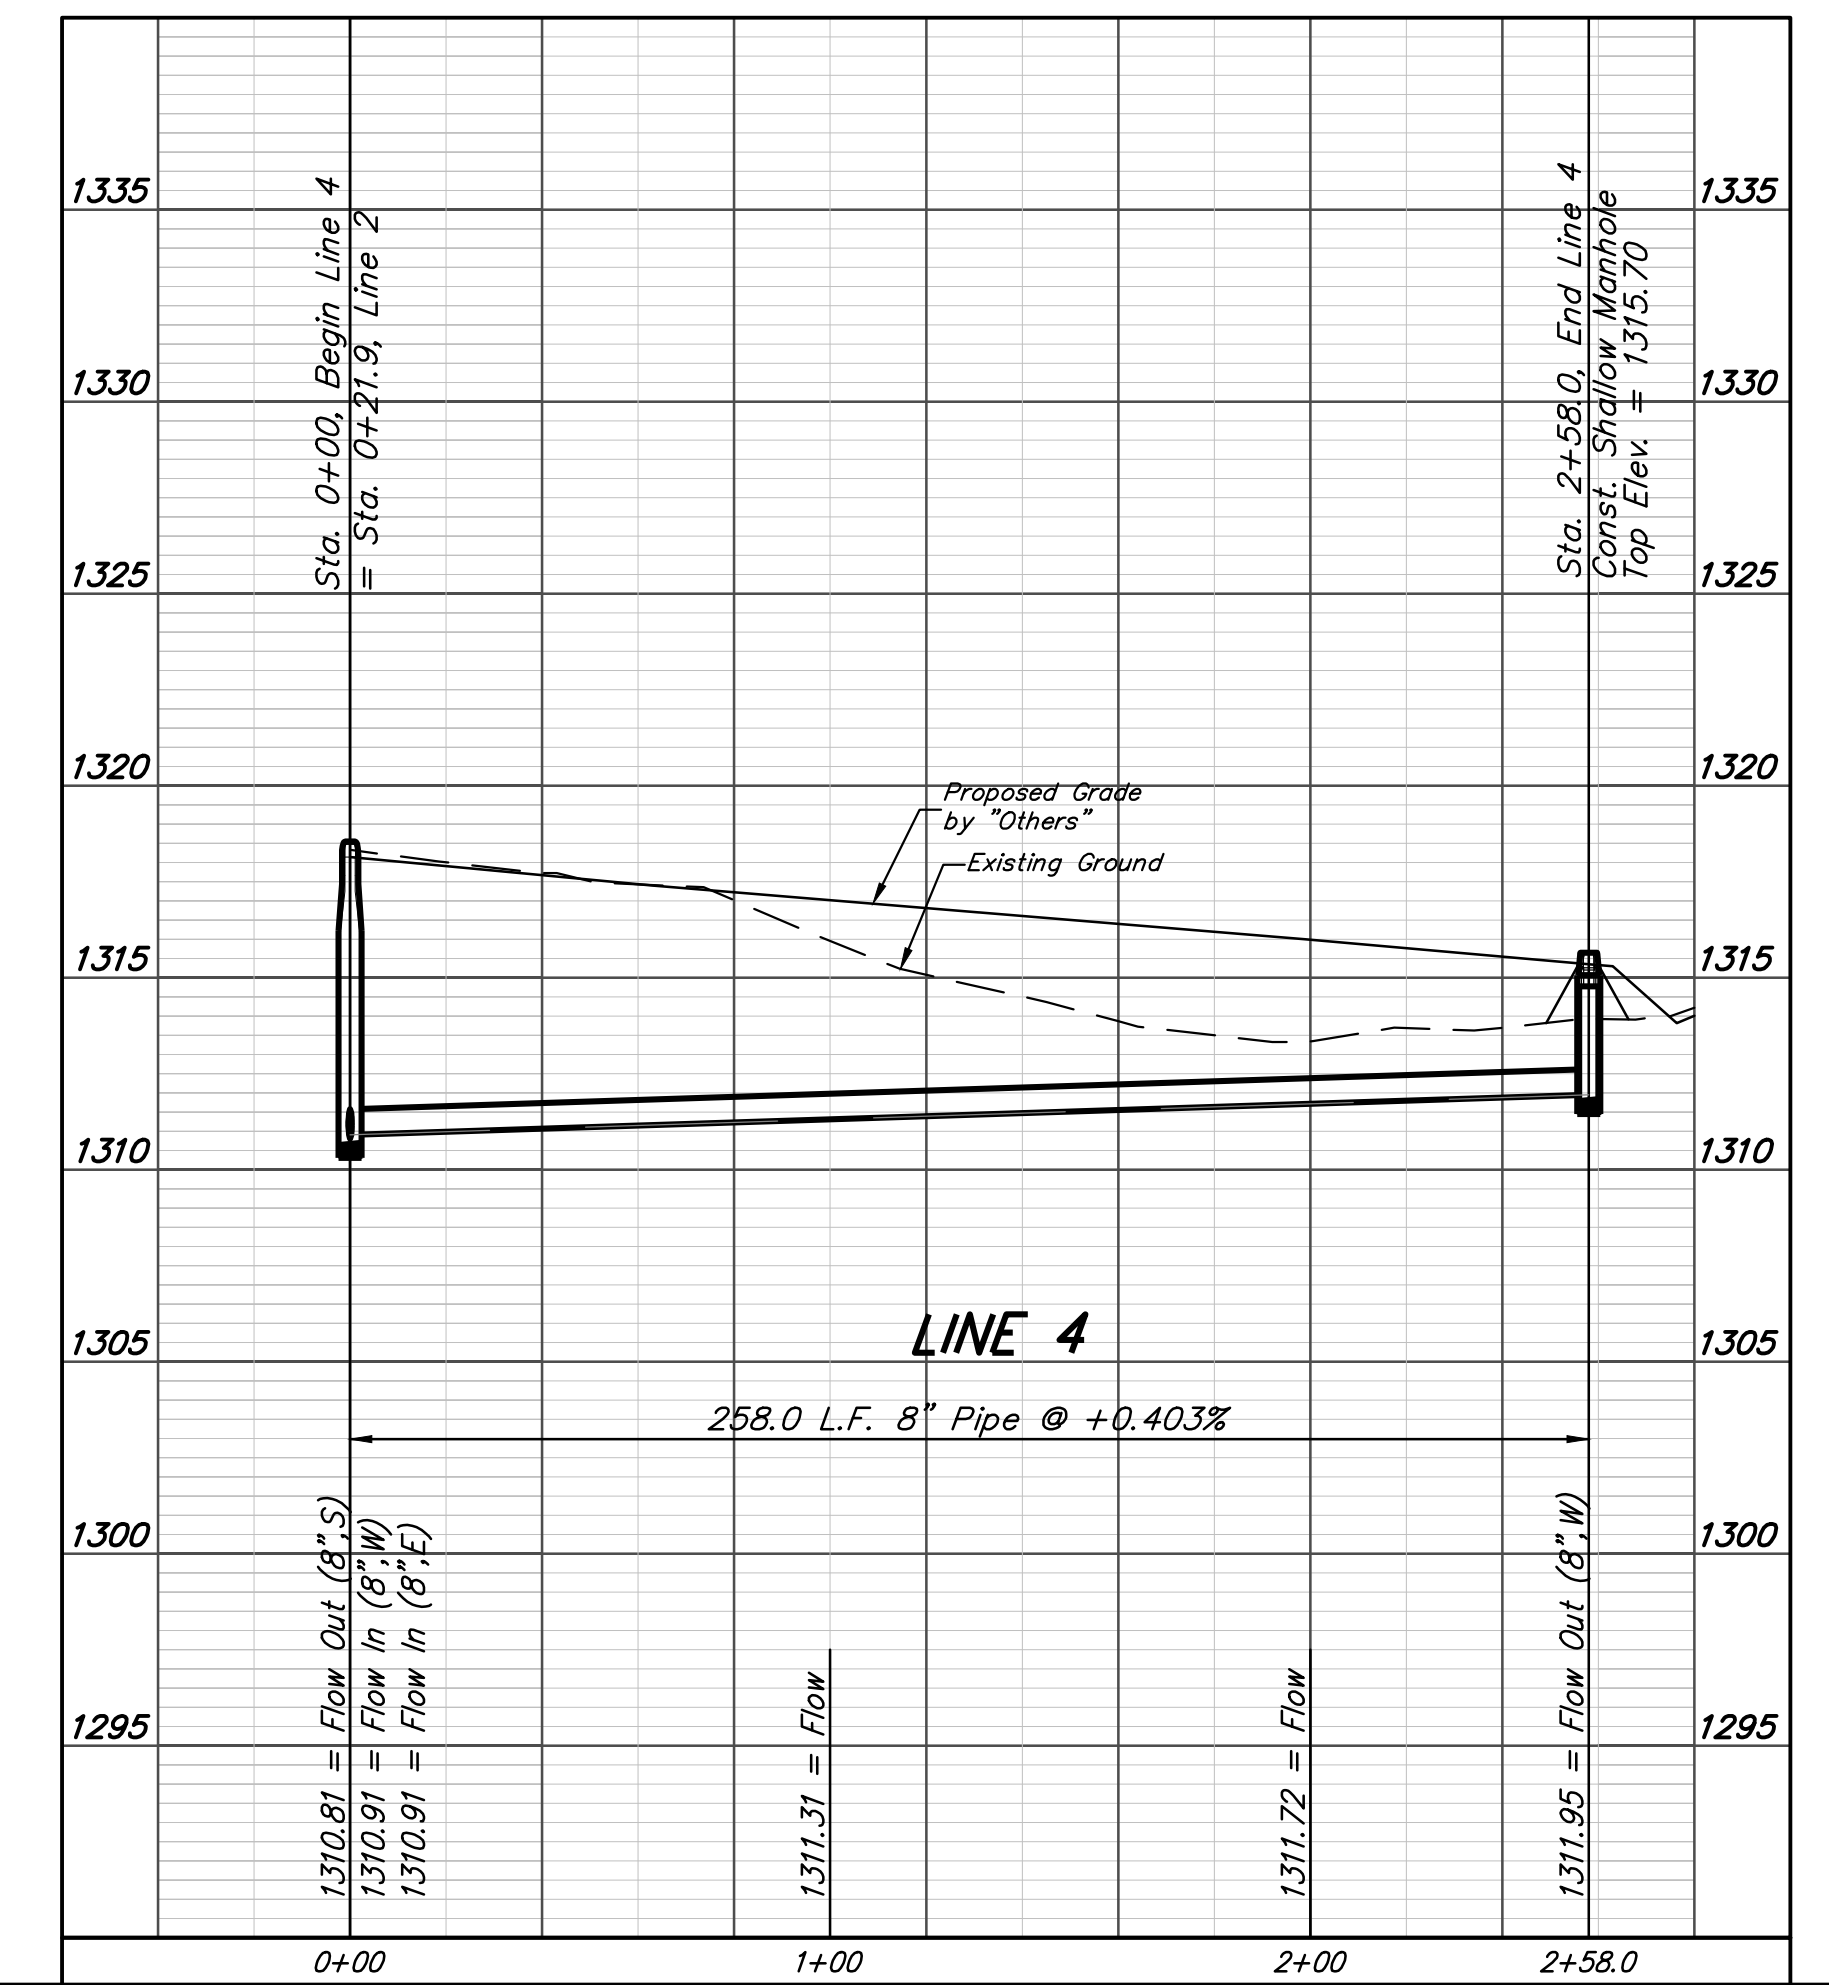
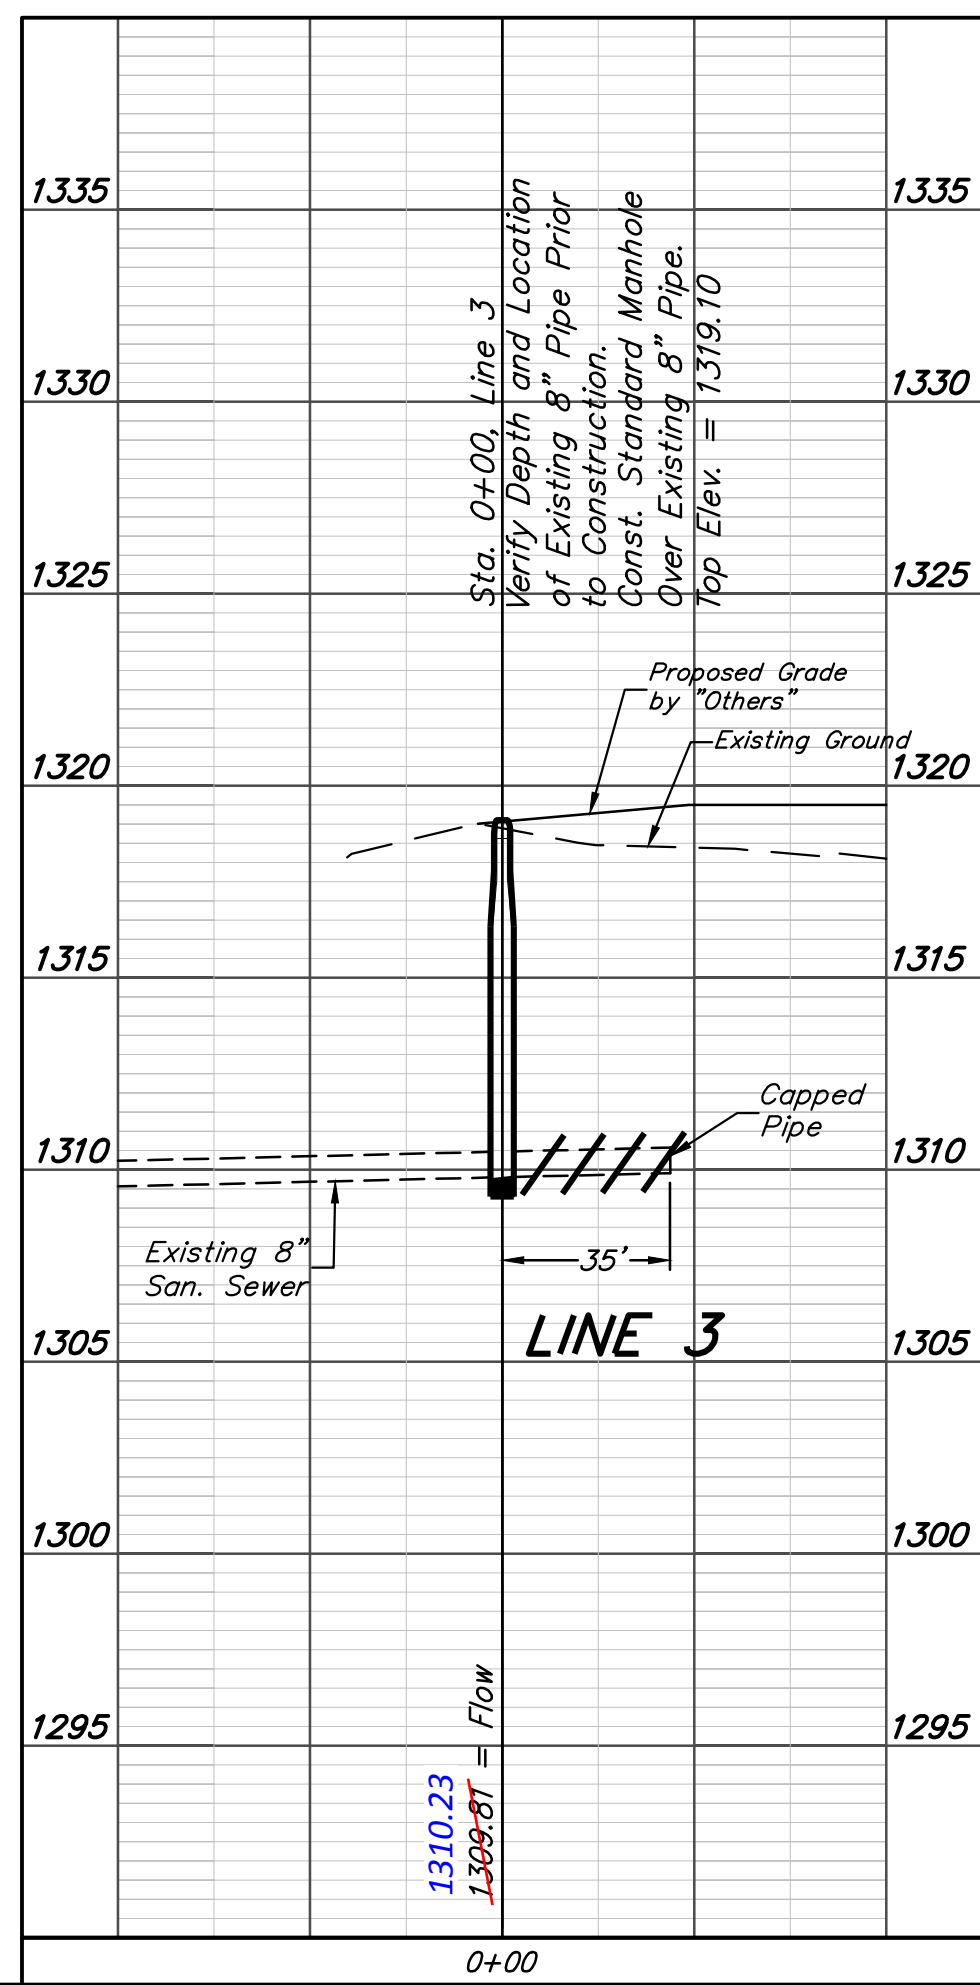
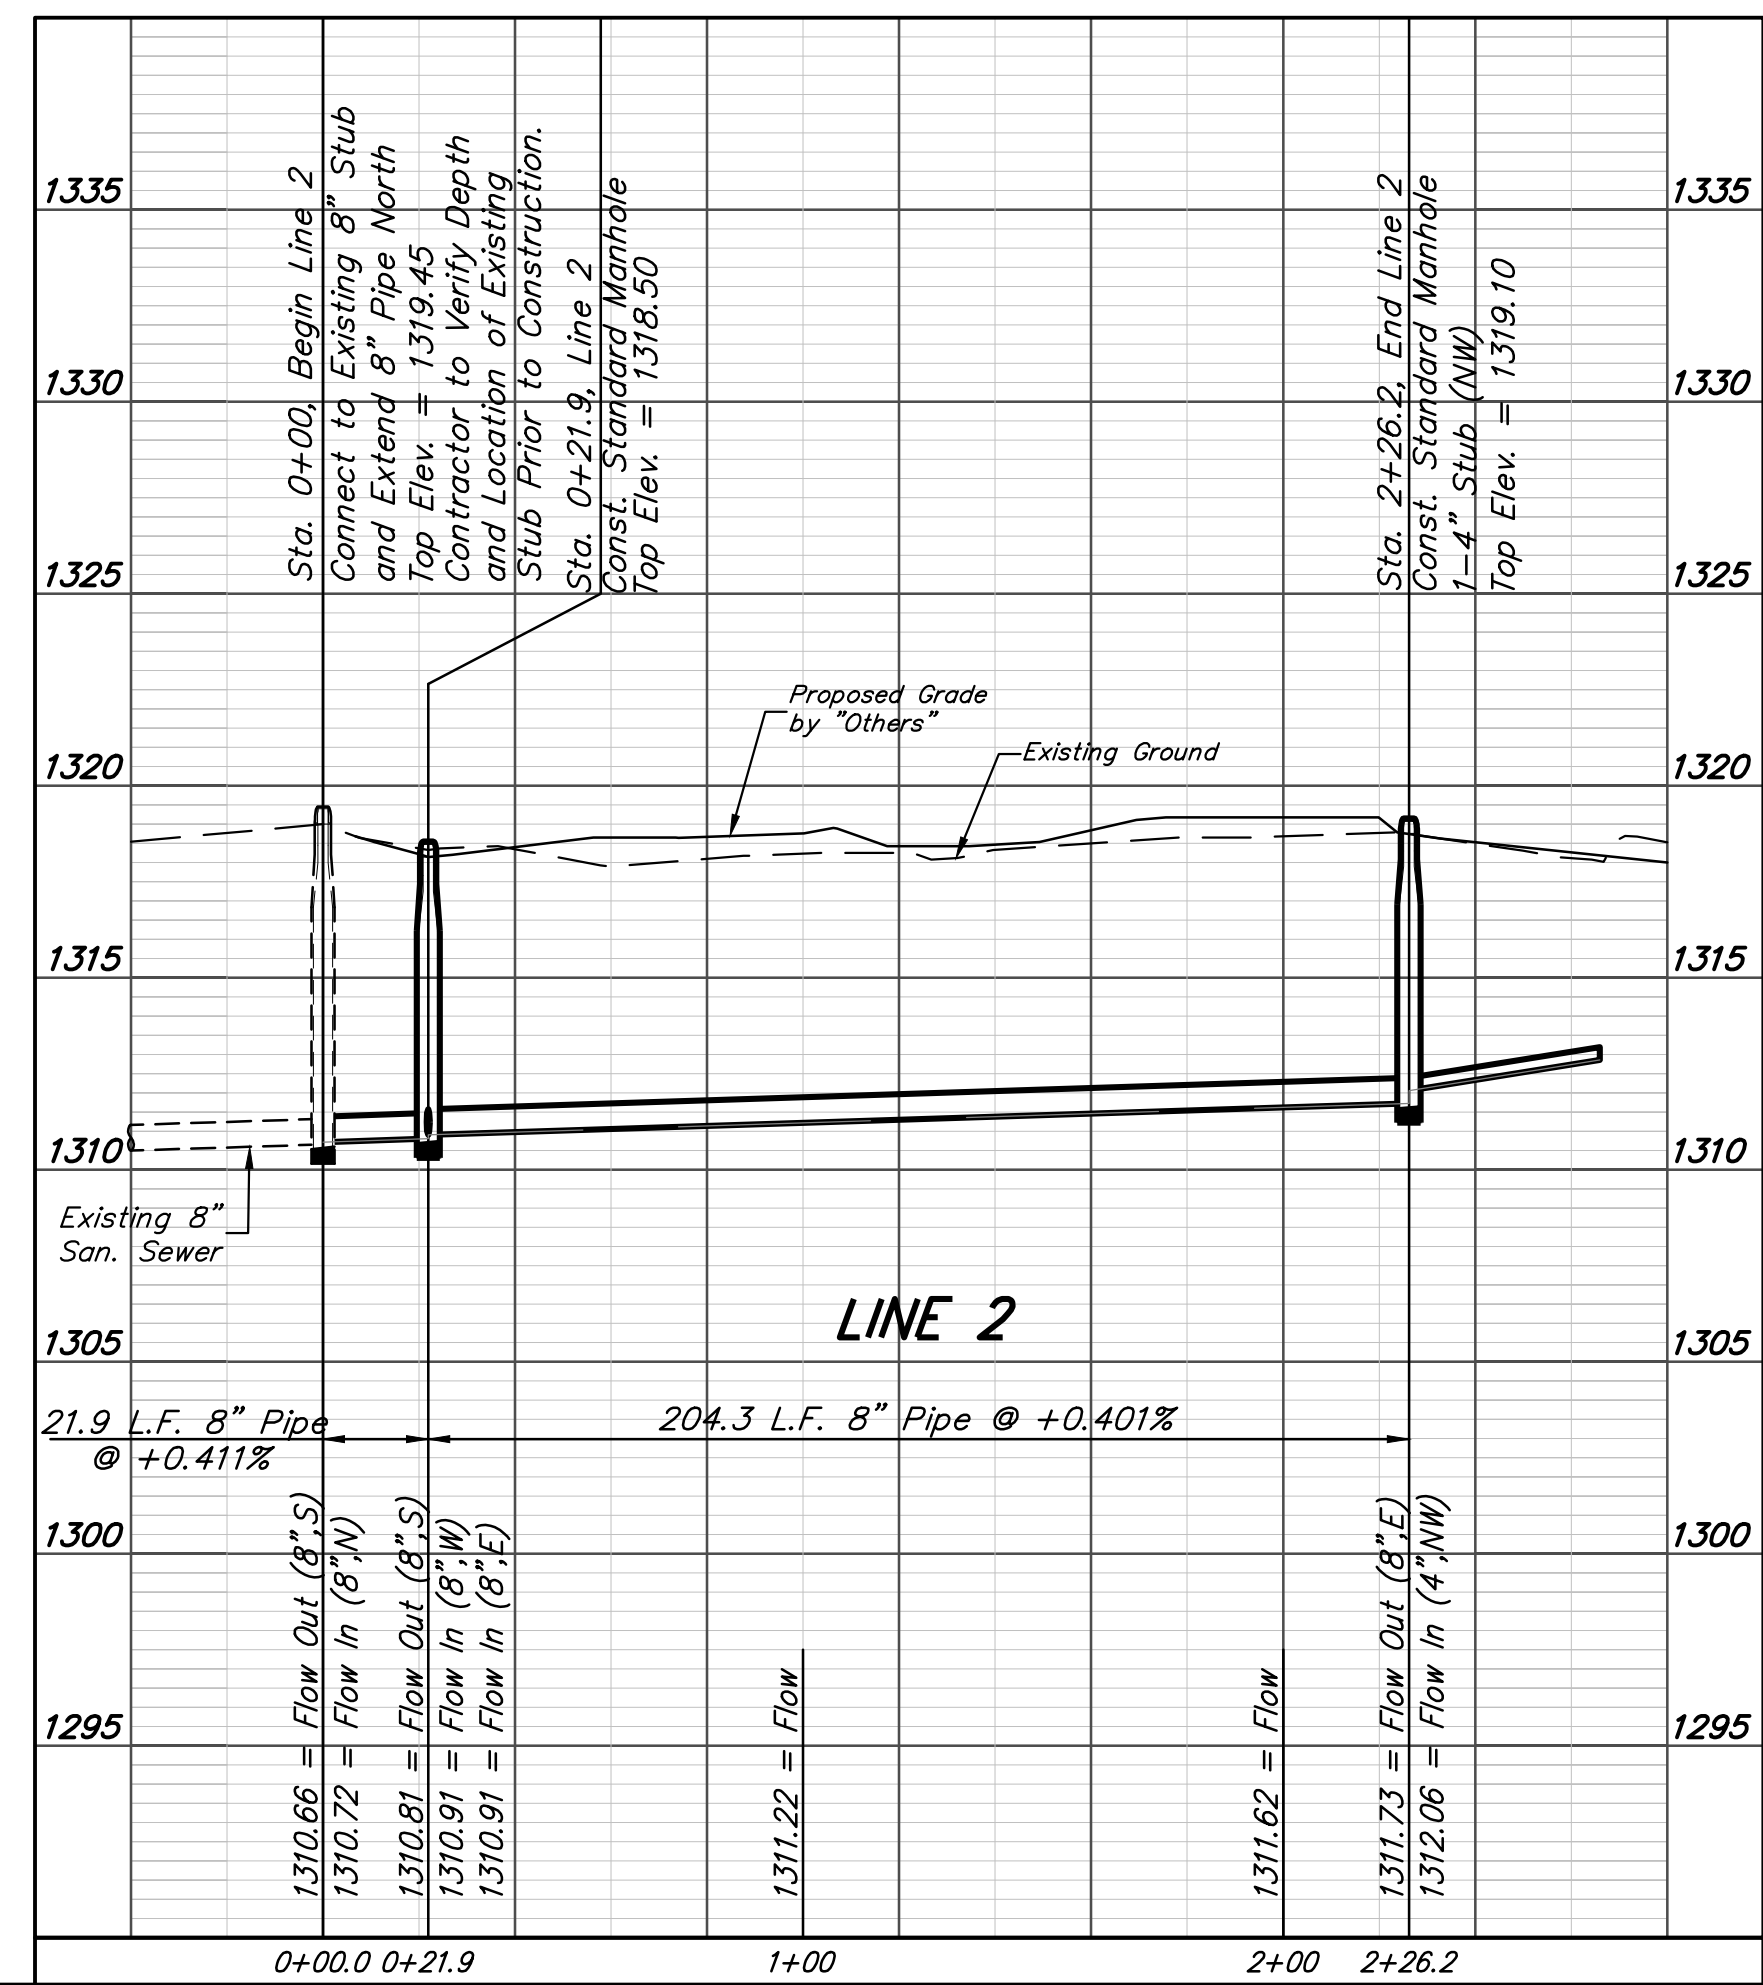
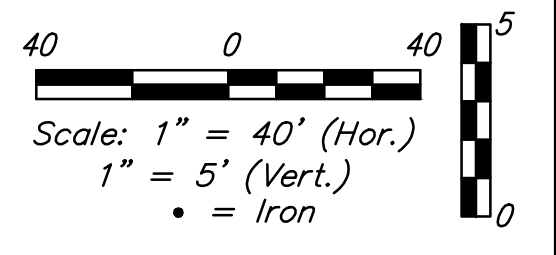
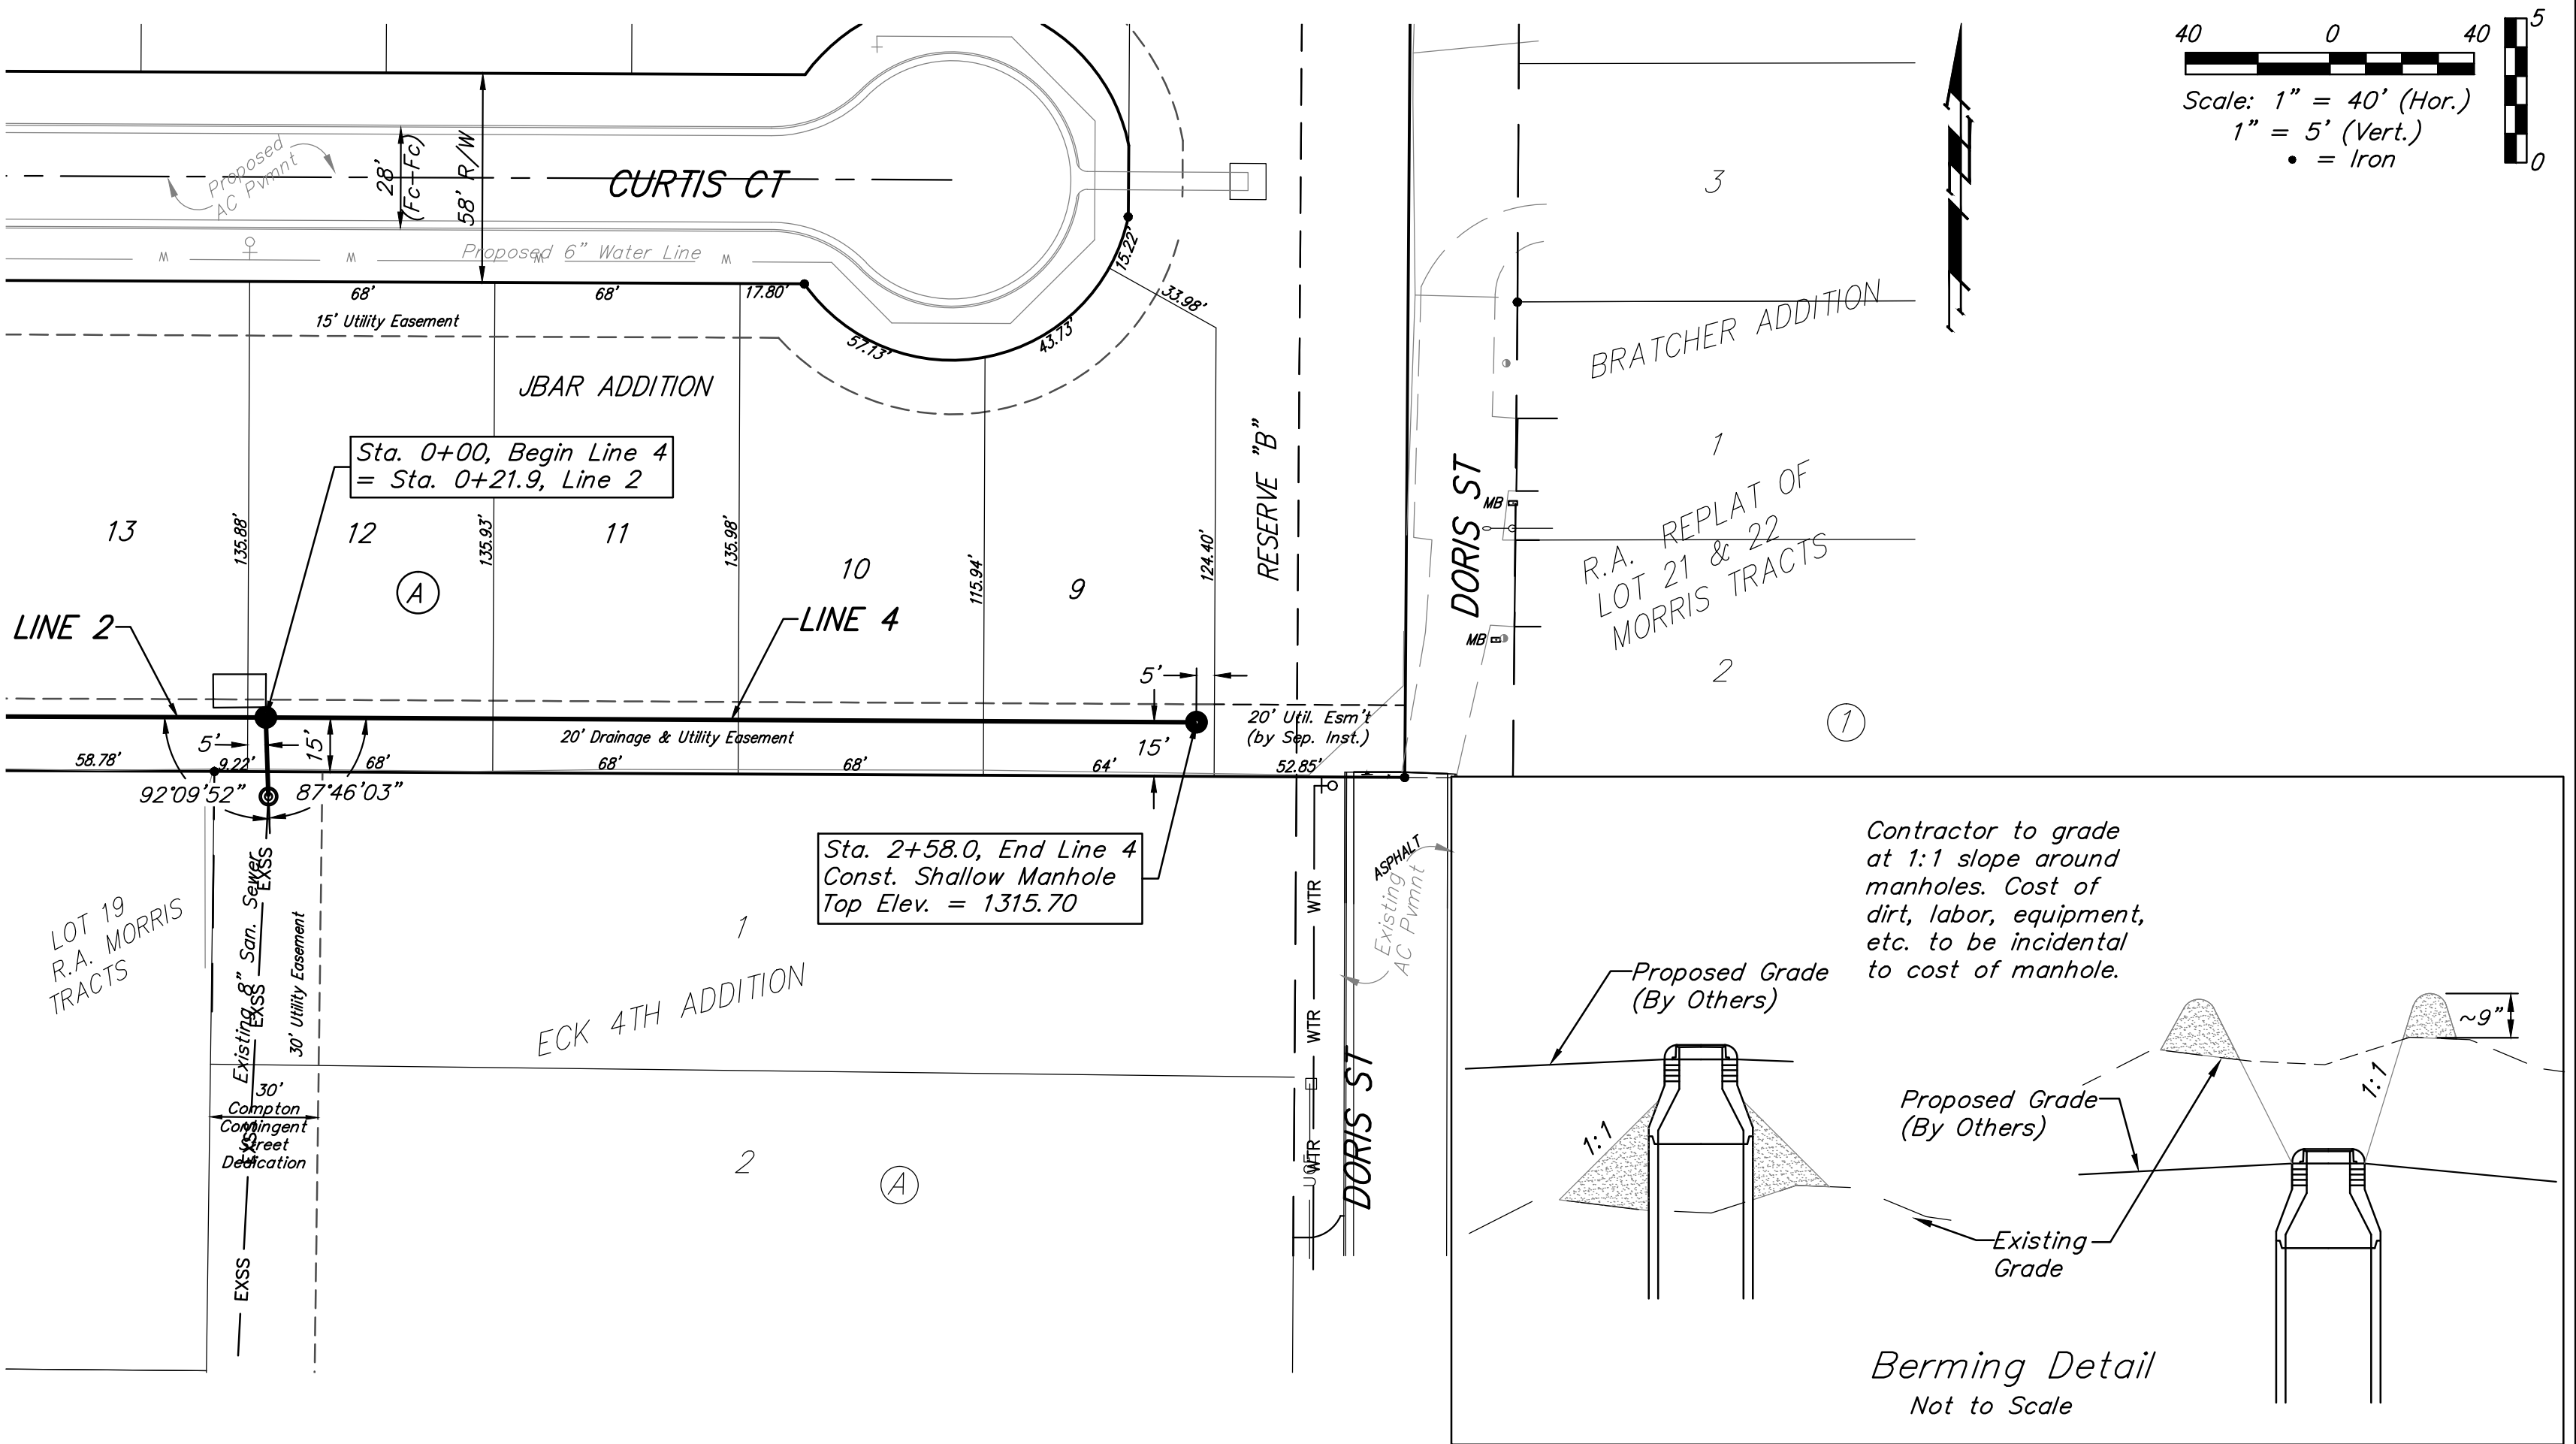


BENCHMARK:
 Square cut top of curb 16± south
 of SE corner of Reserve "B".
 Elev. = 1315.95 (NAVD88)

SEWER SERVICE TABLE						FOR INFORMATION ONLY	
NUMBER	TYPE	LOCATION			APPROXIMATE LENGTH 4" PIPE		
		LOT NO.	BLOCK NO.	LINE NO.	STATION/DIRECTION	VERTICAL	HORIZONTAL
1	4" Stub	Exception	2	2+26.2/Rt	-	40'	

NOTE: Vertical Riser Pipe shall be extended to 2' minimum above ground water elevation and 4' maximum below proposed ground elevation.

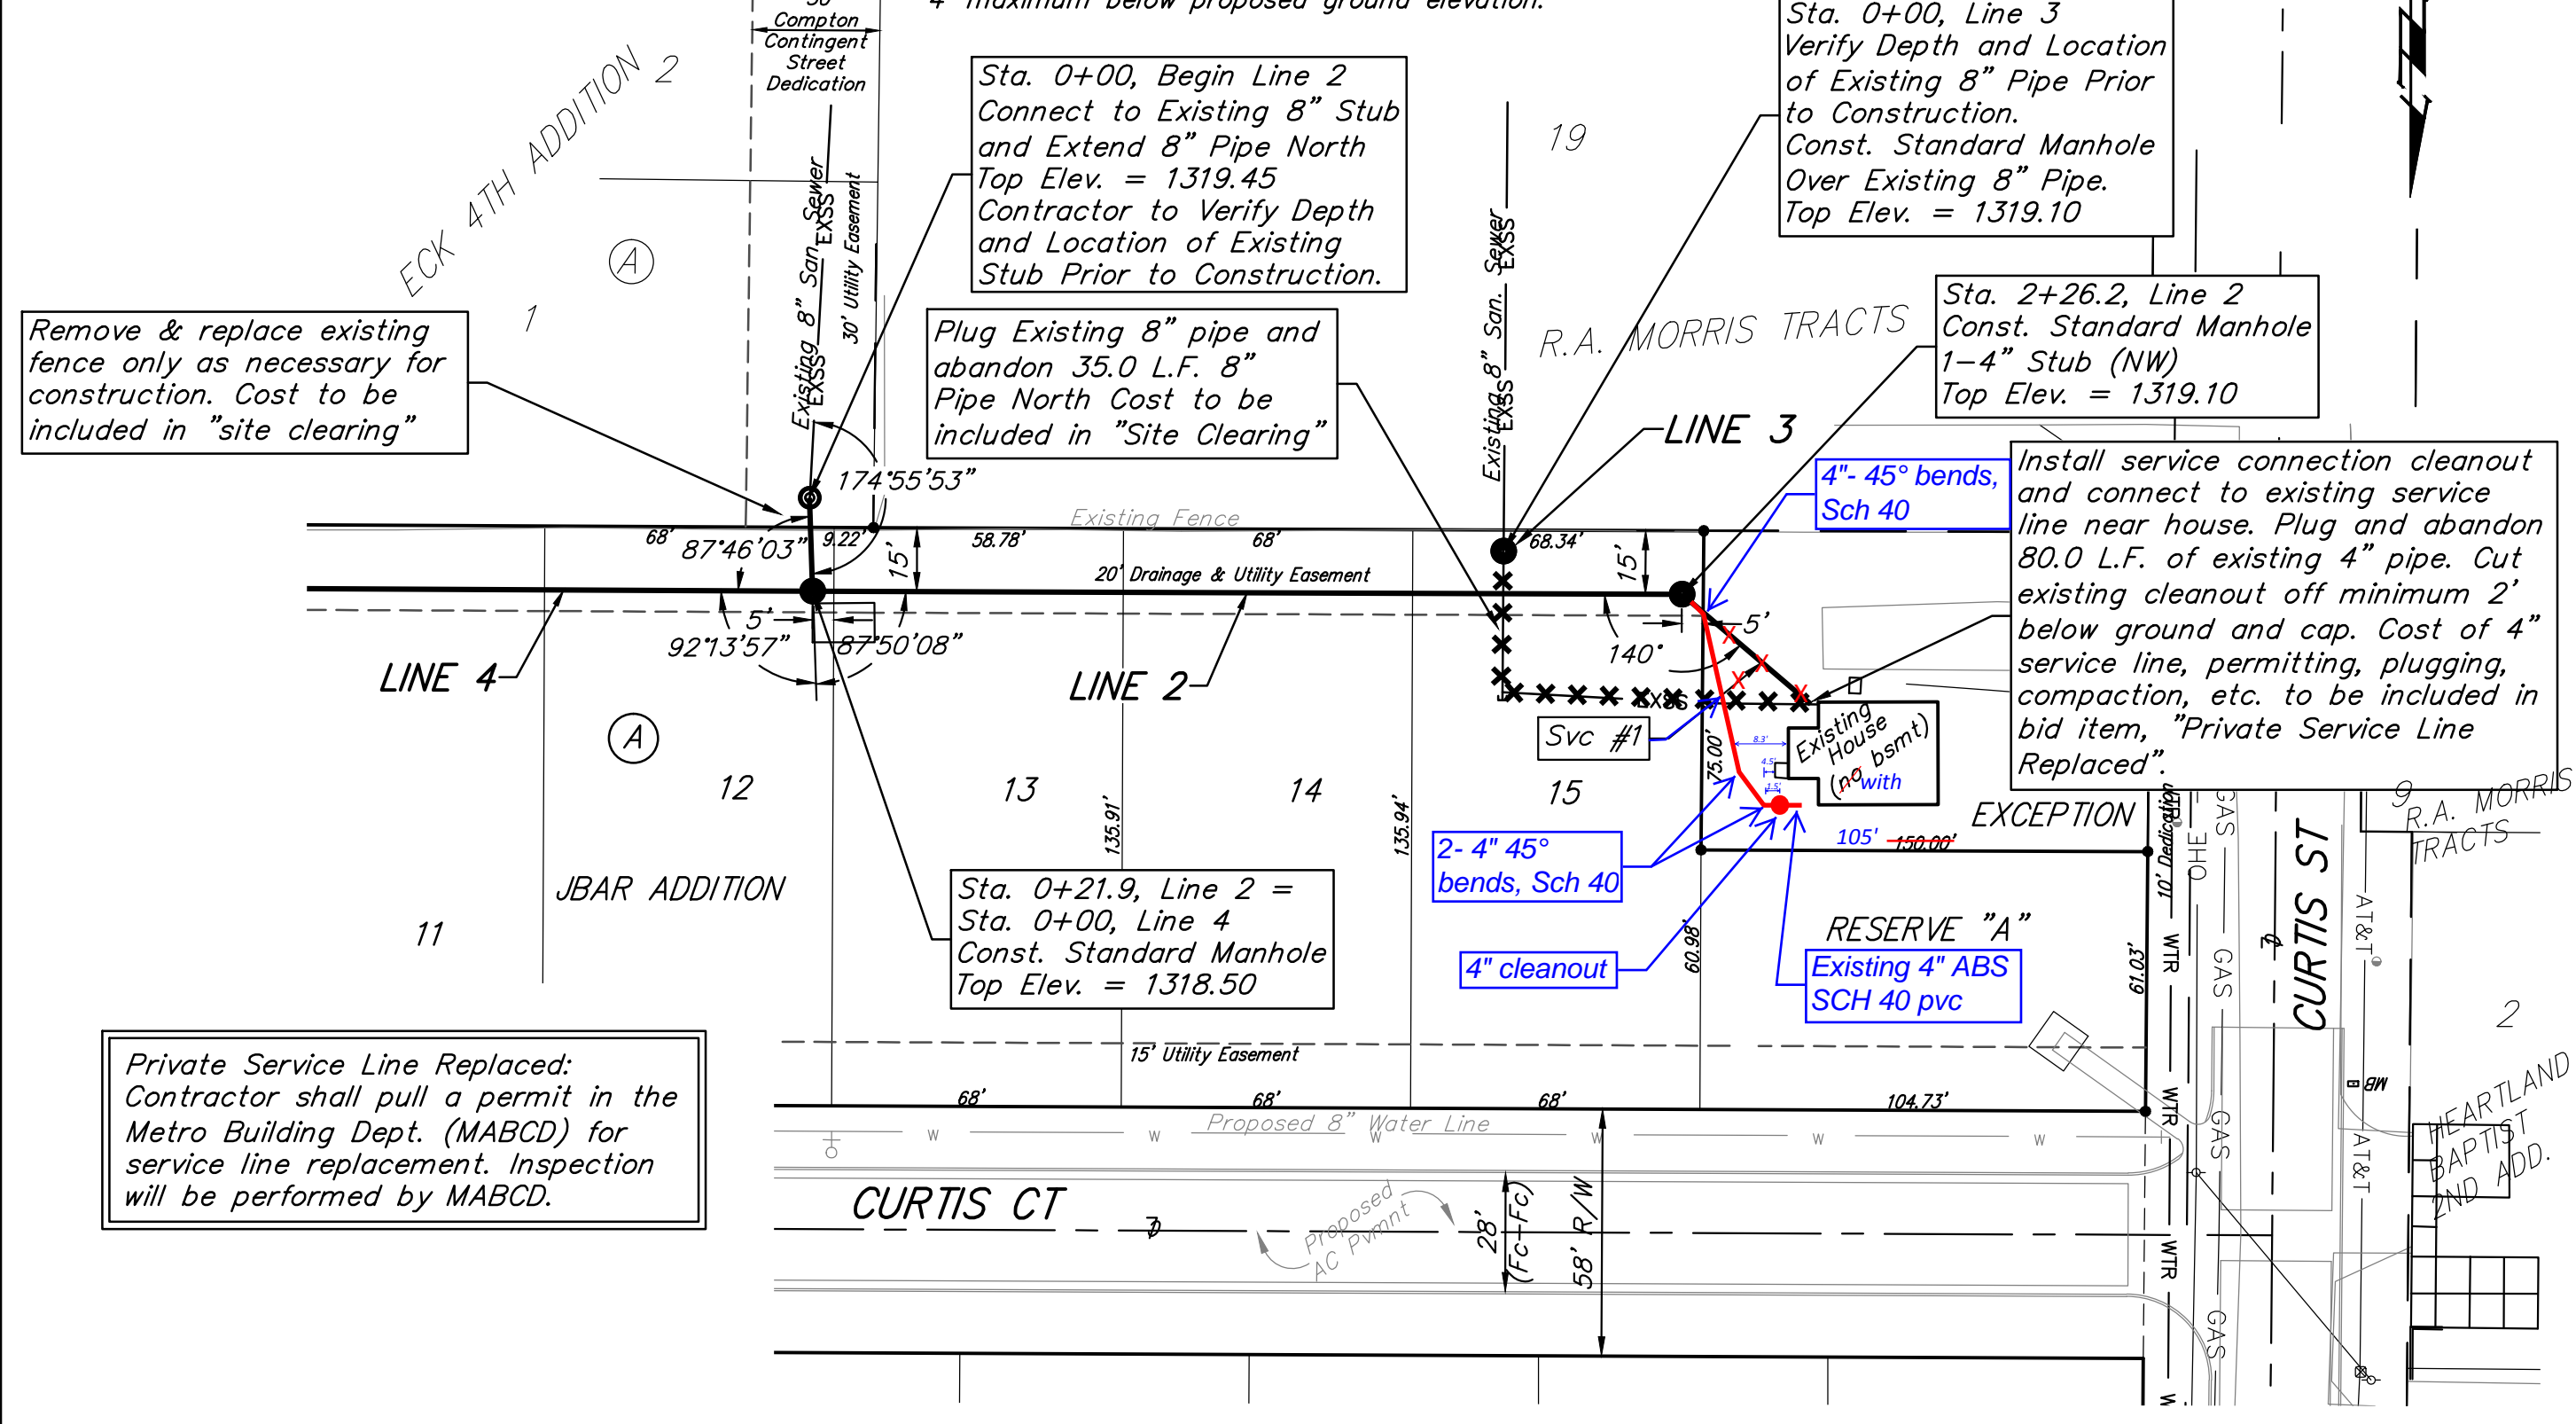

Baughman JBAR ADDITION
Lines 2, 3, & 4
 Sanitary Sewer Improvements

Baughman Company, P.A. 315 Ellis St. Wichita, KS 67211 P 316-262-7271 F 316-262-0149
 ENGINEERING | SURVEYING | PLANNING | LANDSCAPE ARCHITECTURE

PROJECT NUMBER 468-85024	DESIGN AEG	DRAWN JAK
REVISIONS:	APPROVED	DATE 4/21/15
SCALE Noted		SHEET 3 OF 13

E:\Projects\JBAR Addition_14-06-P052\Engineering\Phase 1\SS_1412-1819-SS PLANS.dwg

