


PLOTTED: Wednesday, November 19, 2014 @ 04:47PM

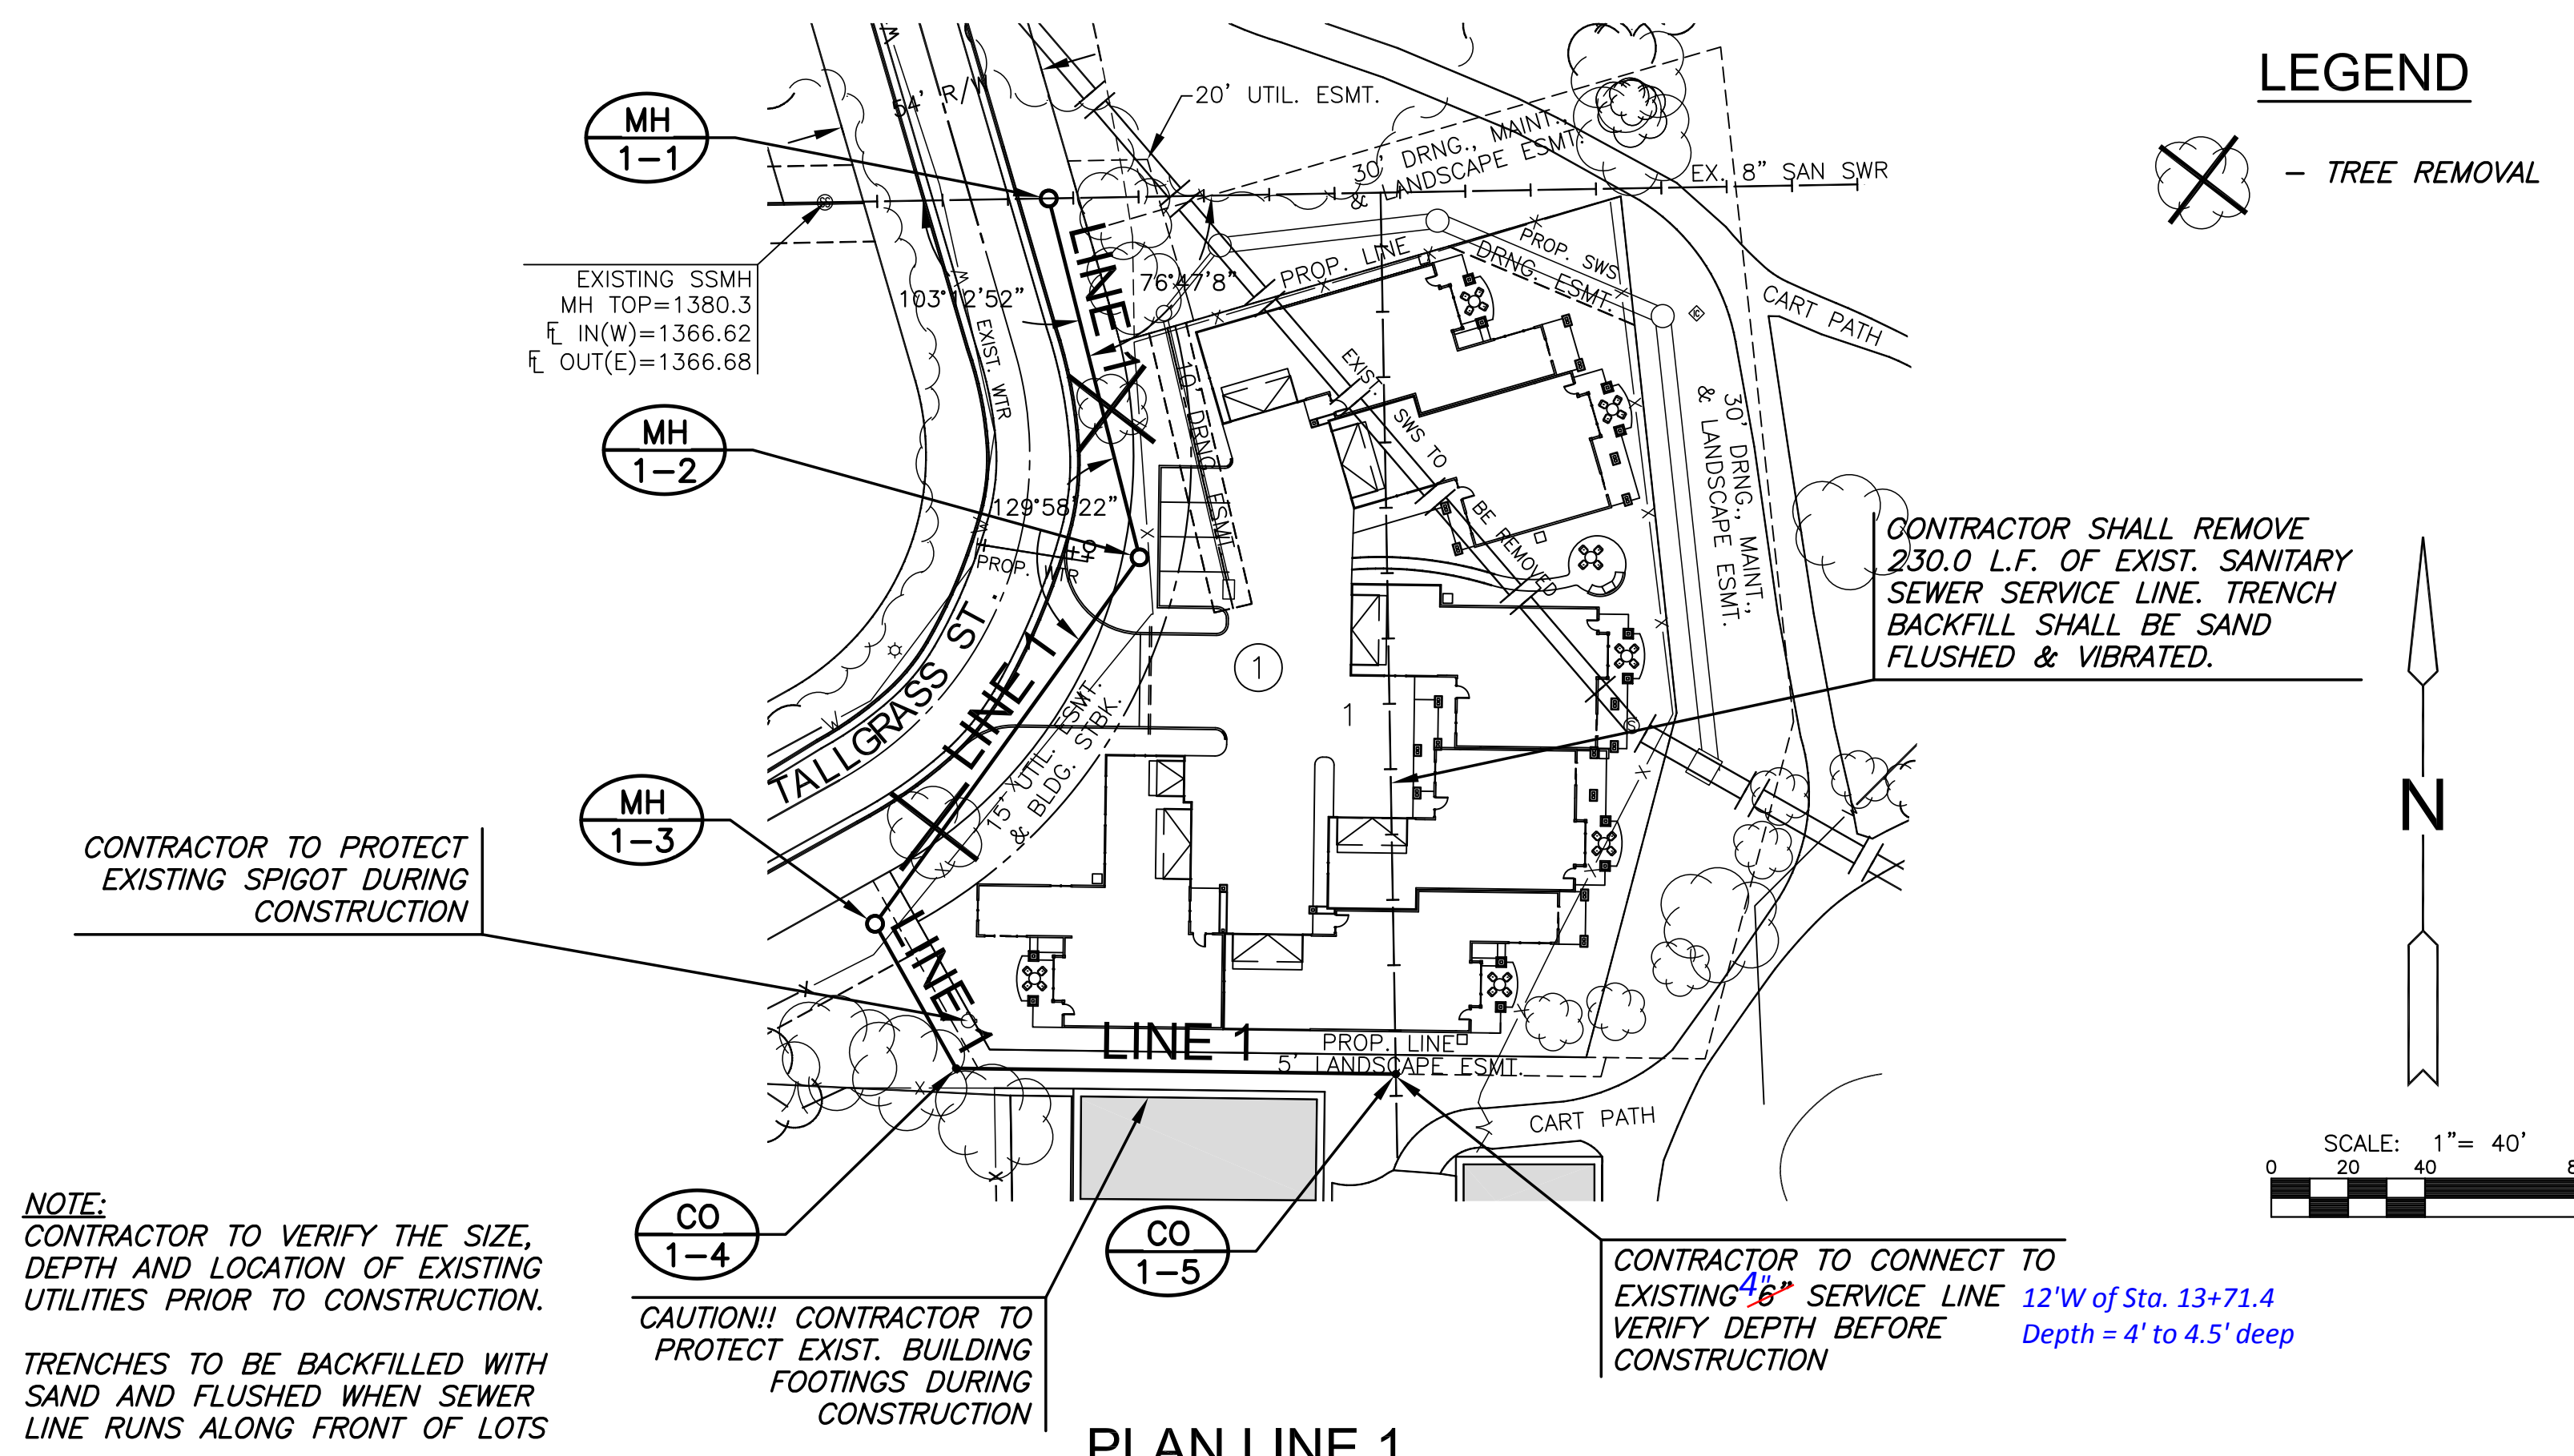


NOTE:
CONTRACTOR TO VERIFY THE SIZE, DEPTH AND LOCATION OF EXISTING UTILITIES PRIOR TO CONSTRUCTION.
TRENCHES TO BE BACKFILLED WITH SAND AND FLUSHED WHEN SEWER LINE RUNS ALONG FRONT OF LOTS


CAUTION!! CONTRACTOR TO PROTECT EXIST. BUILDING FOOTINGS DURING CONSTRUCTION

CONTRACTOR TO CONNECT TO EXISTING 4" SERVICE LINE 12'W of Sta. 13+71.4
VERIFY DEPTH BEFORE CONSTRUCTION
Depth = 4' to 4.5' deep


PLAN LINE 1

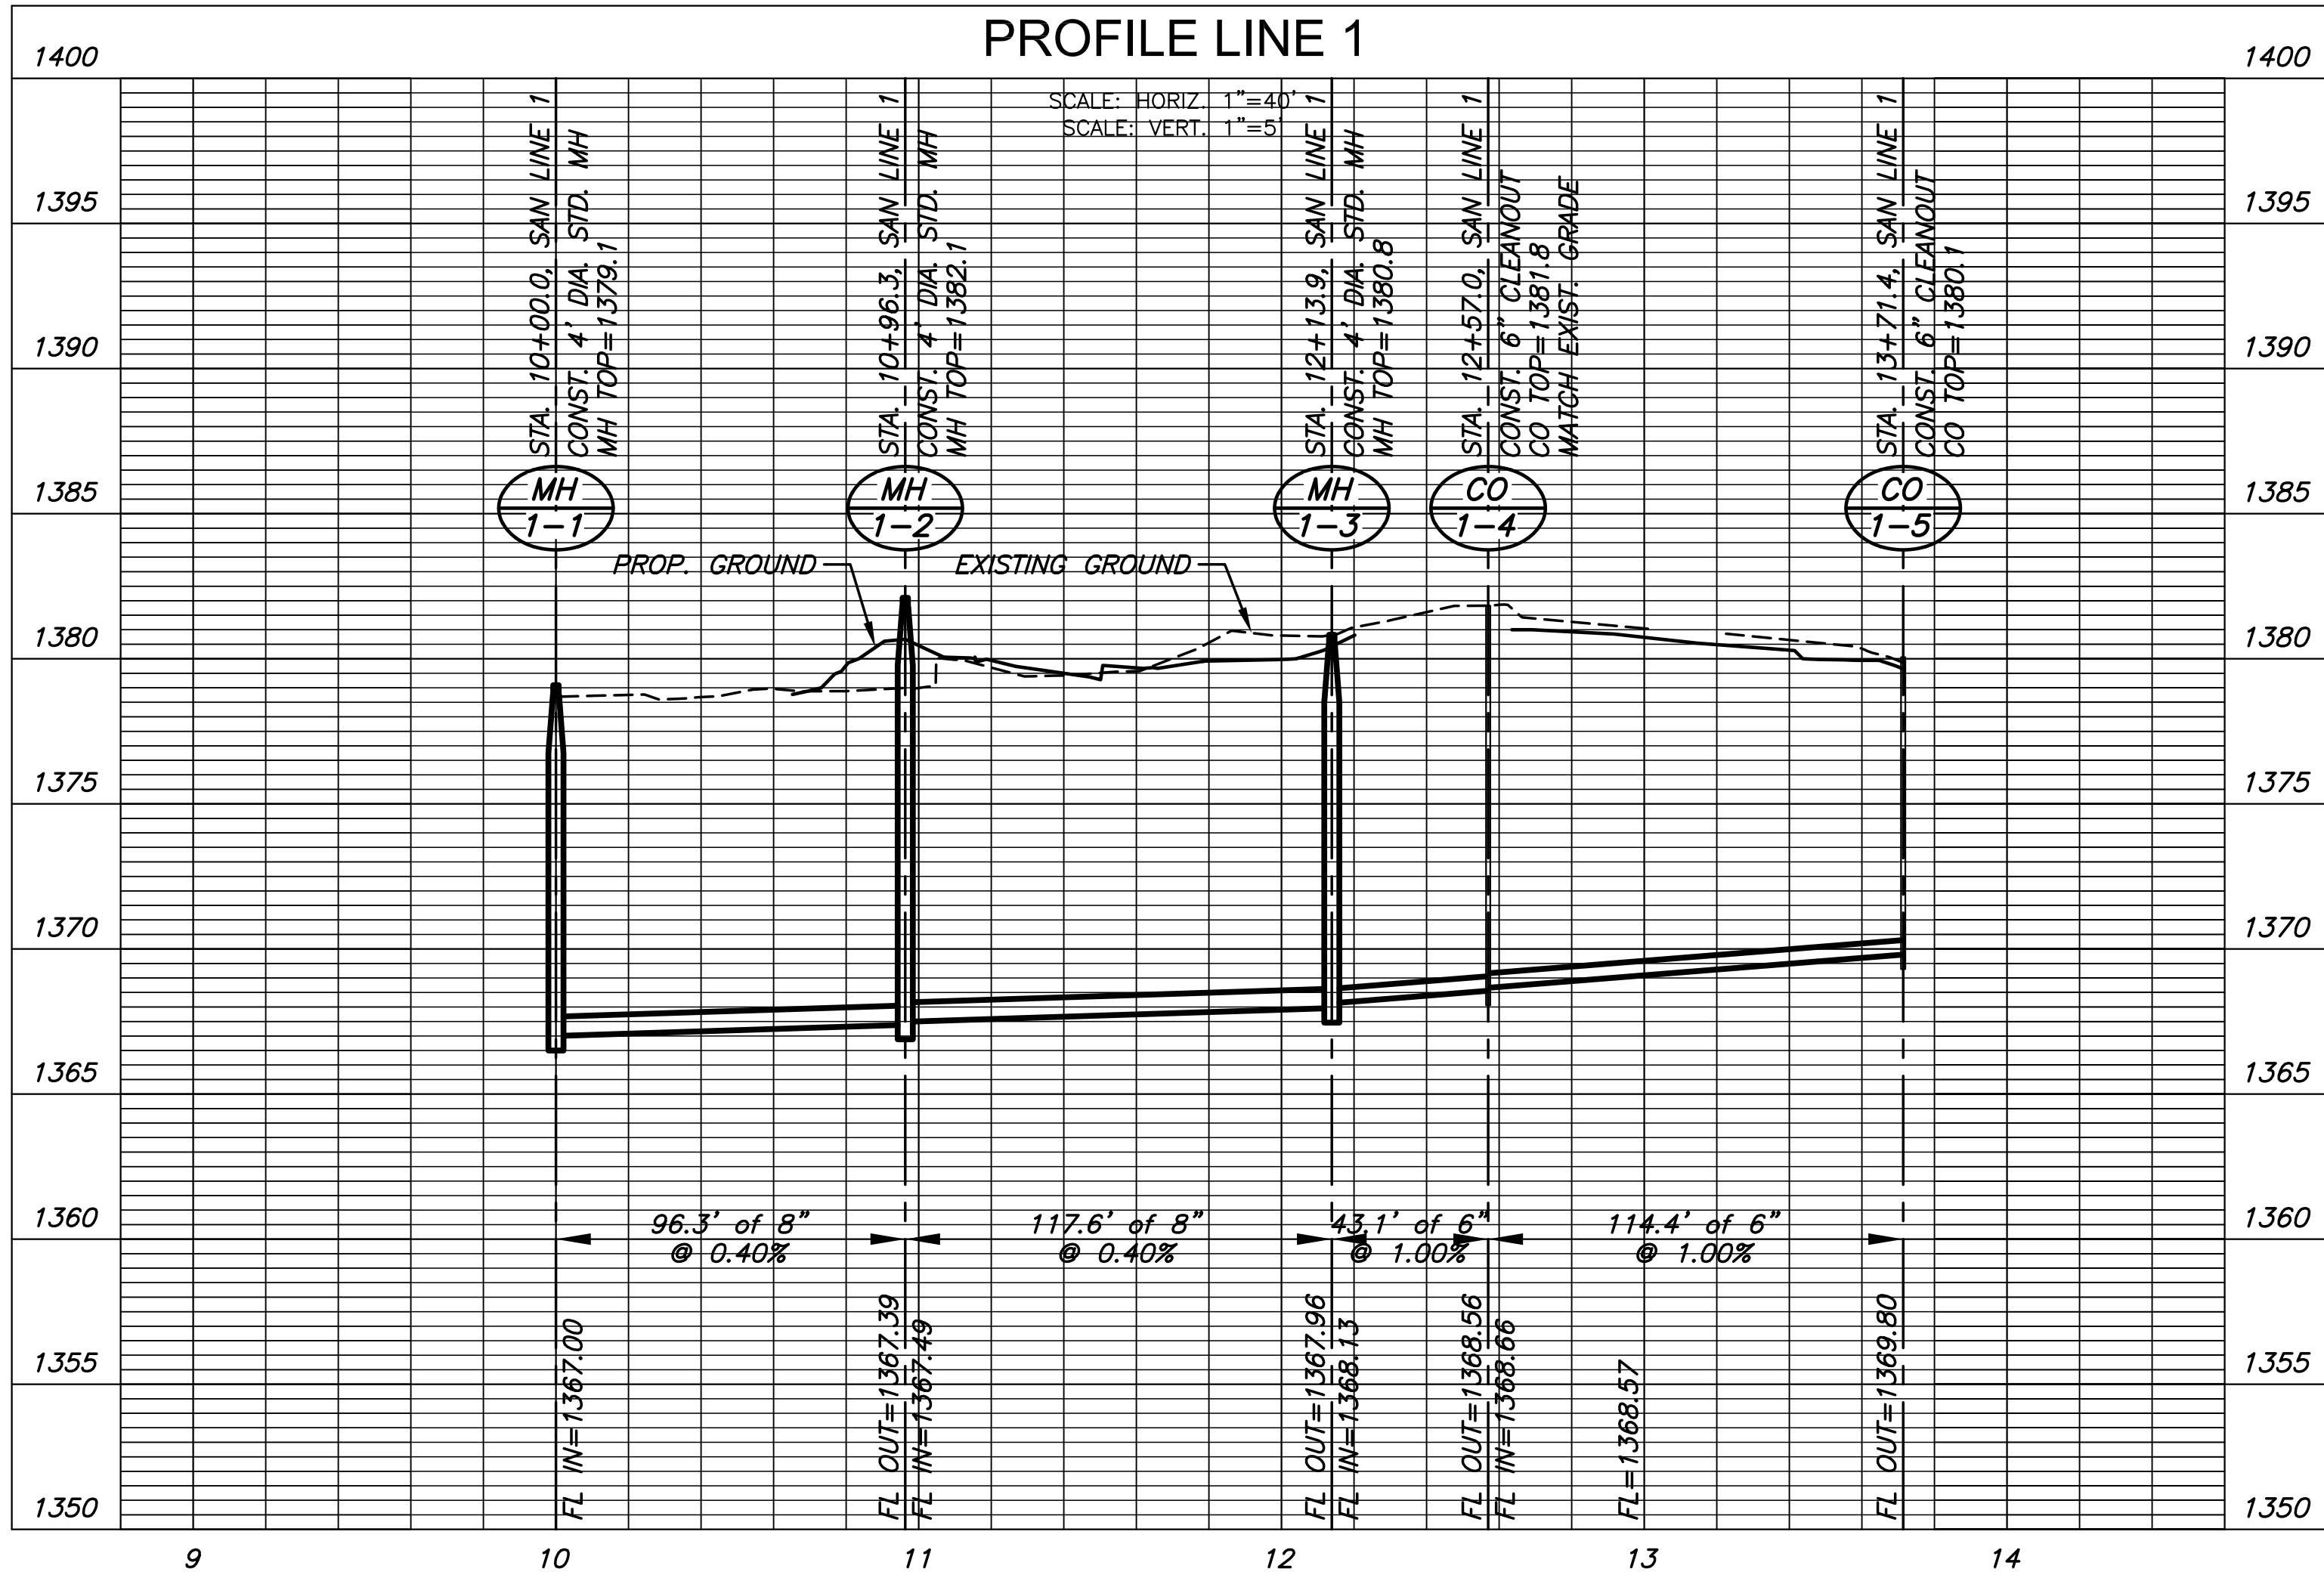

SANITARY POINTS			
Point #	Northing	Easting	Desc.
1	1700324.03	1677746.87	MH 1-1
2	1700230.69	1677770.50	MH 1-2
3	1700135.34	1677701.68	MH 1-3
4	1700097.74	1677722.77	CO 1-4
5	1700096.26	1677837.15	CO 1-5

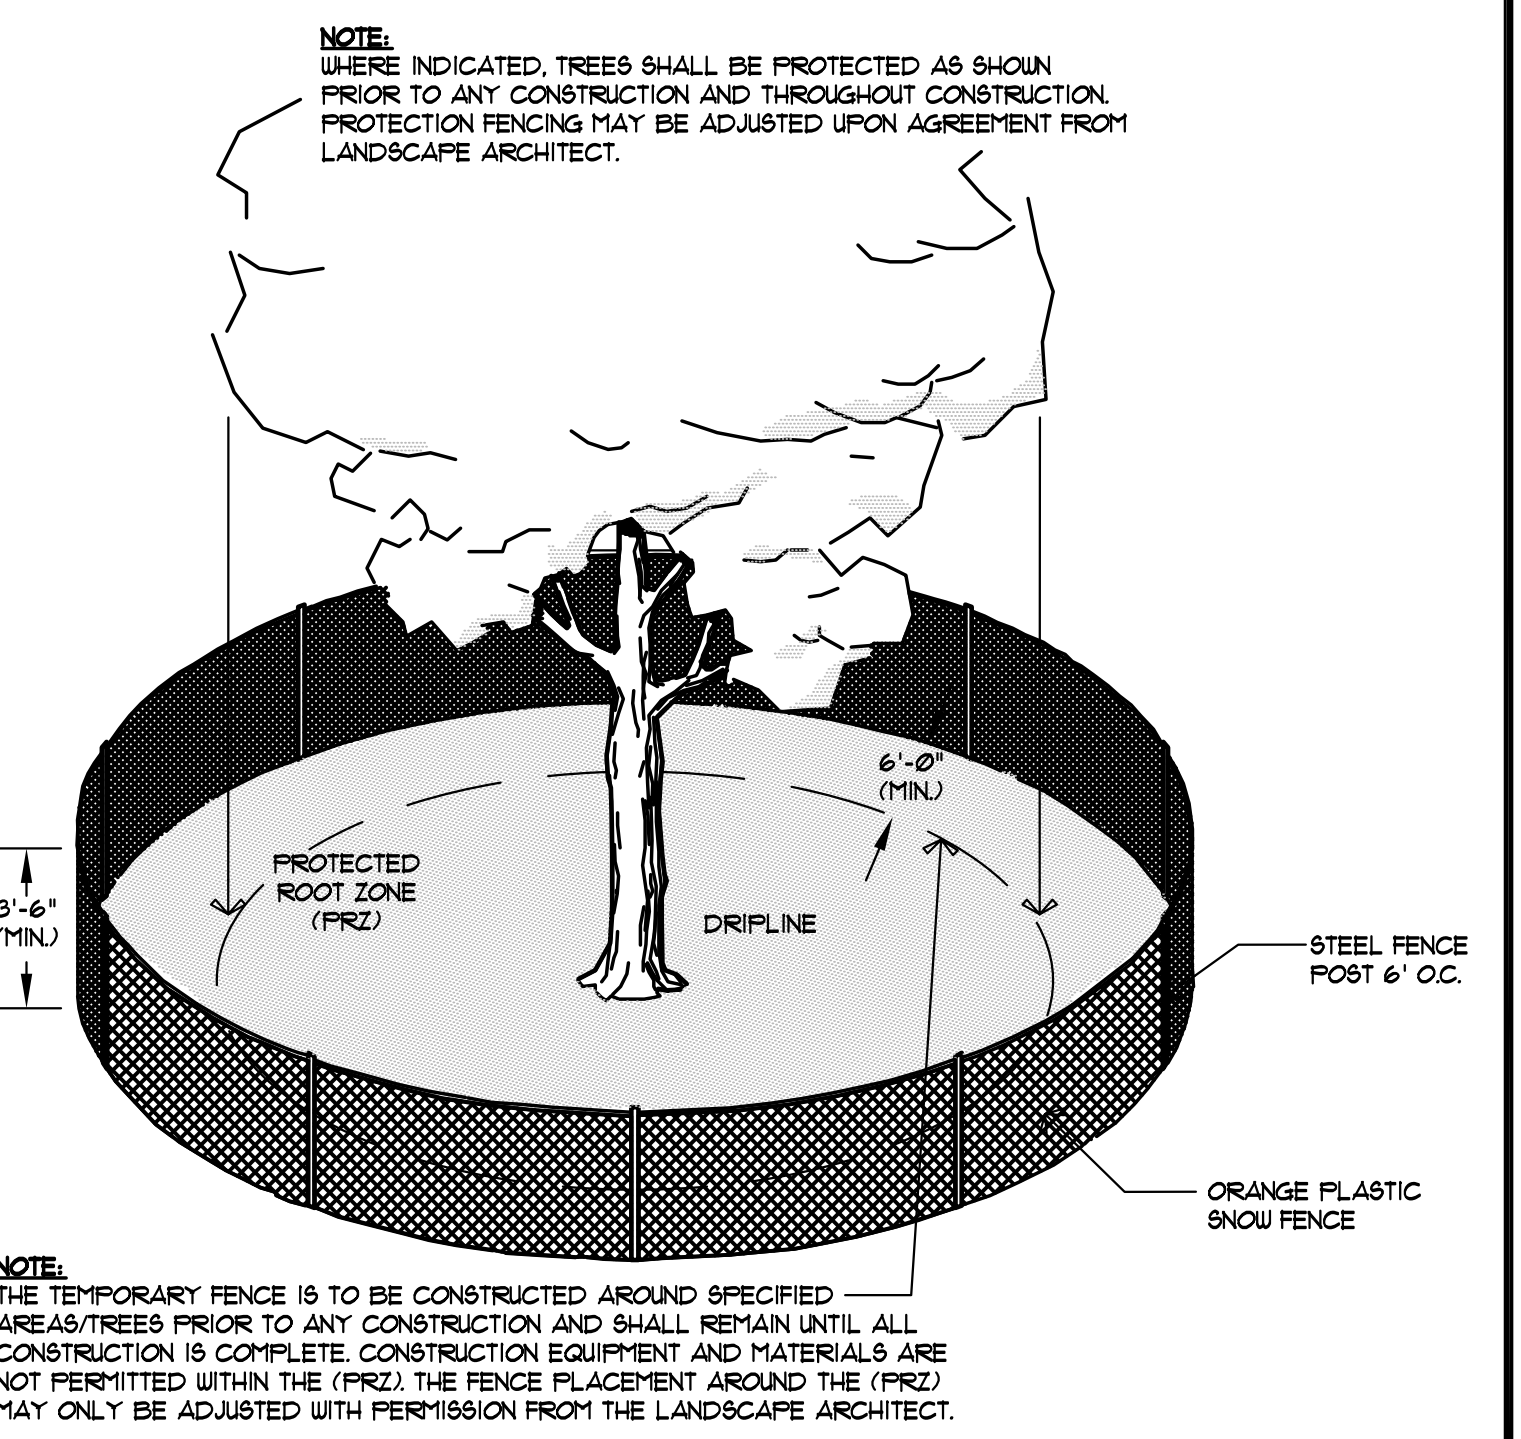

TREE PROTECTION DETAIL
SCALE: NTS

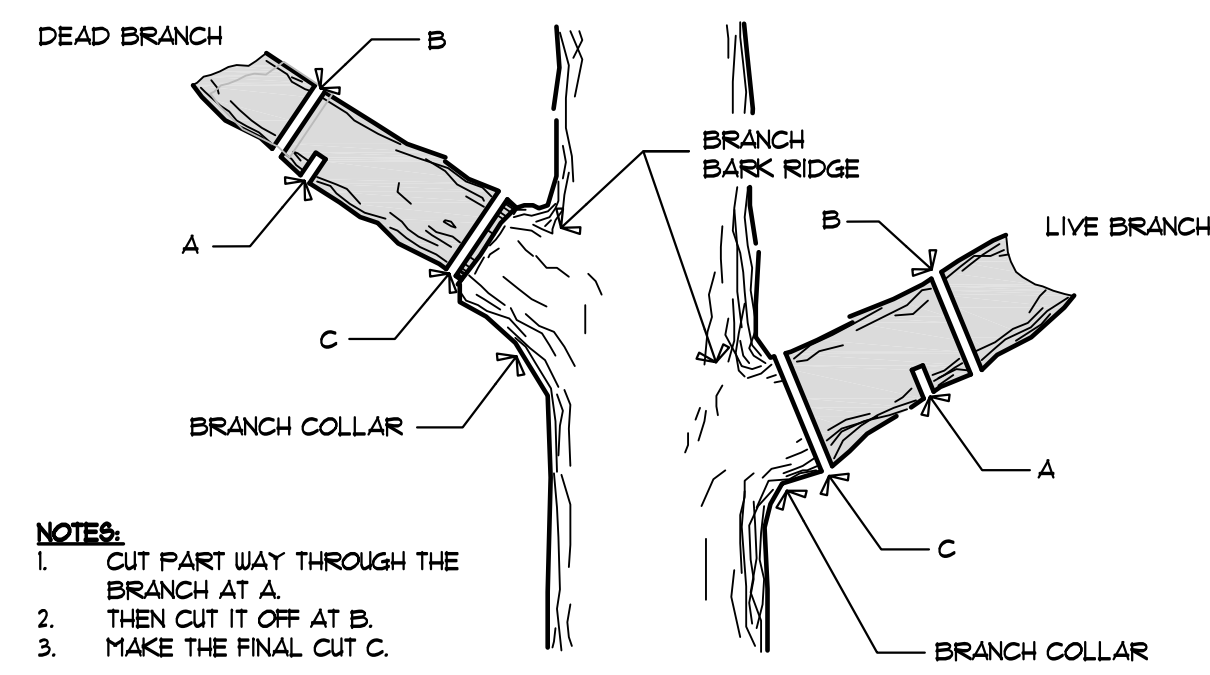

TREE TRIMMING DETAIL
SCALE: NTS



SANITARY SEWER PLANS FOR
TALLGRASS VILLAS ADDITION
WICHITA, KS

©2014 MKEC Engineering All Rights Reserved
www.mkec.com
These drawings and their contents, including, but not limited to, all concepts, designs, & ideas are the exclusive property of MKEC Engineering (MKEC), and may not be used or reproduced in any way without the express consent of MKEC.

SANITARY SEWER LINE 1	
PROJECT NO.	468-84986
DATE	NOV. 2014
SCALE	1"=40'
DESIGNED	DRAWN
AJK	JWC
CHECKED	AJK
NO.	REVISION
SHEET NO.	
3 OF 9	

J:\PROJECTS\2013\130107077_PERFECTION - TALLGRASS55-CIVIL\CAD\SSAN13787_SS_LINE 1.DWG