



PLOTED: Tuesday, July 07, 2015 @ 04:53PM

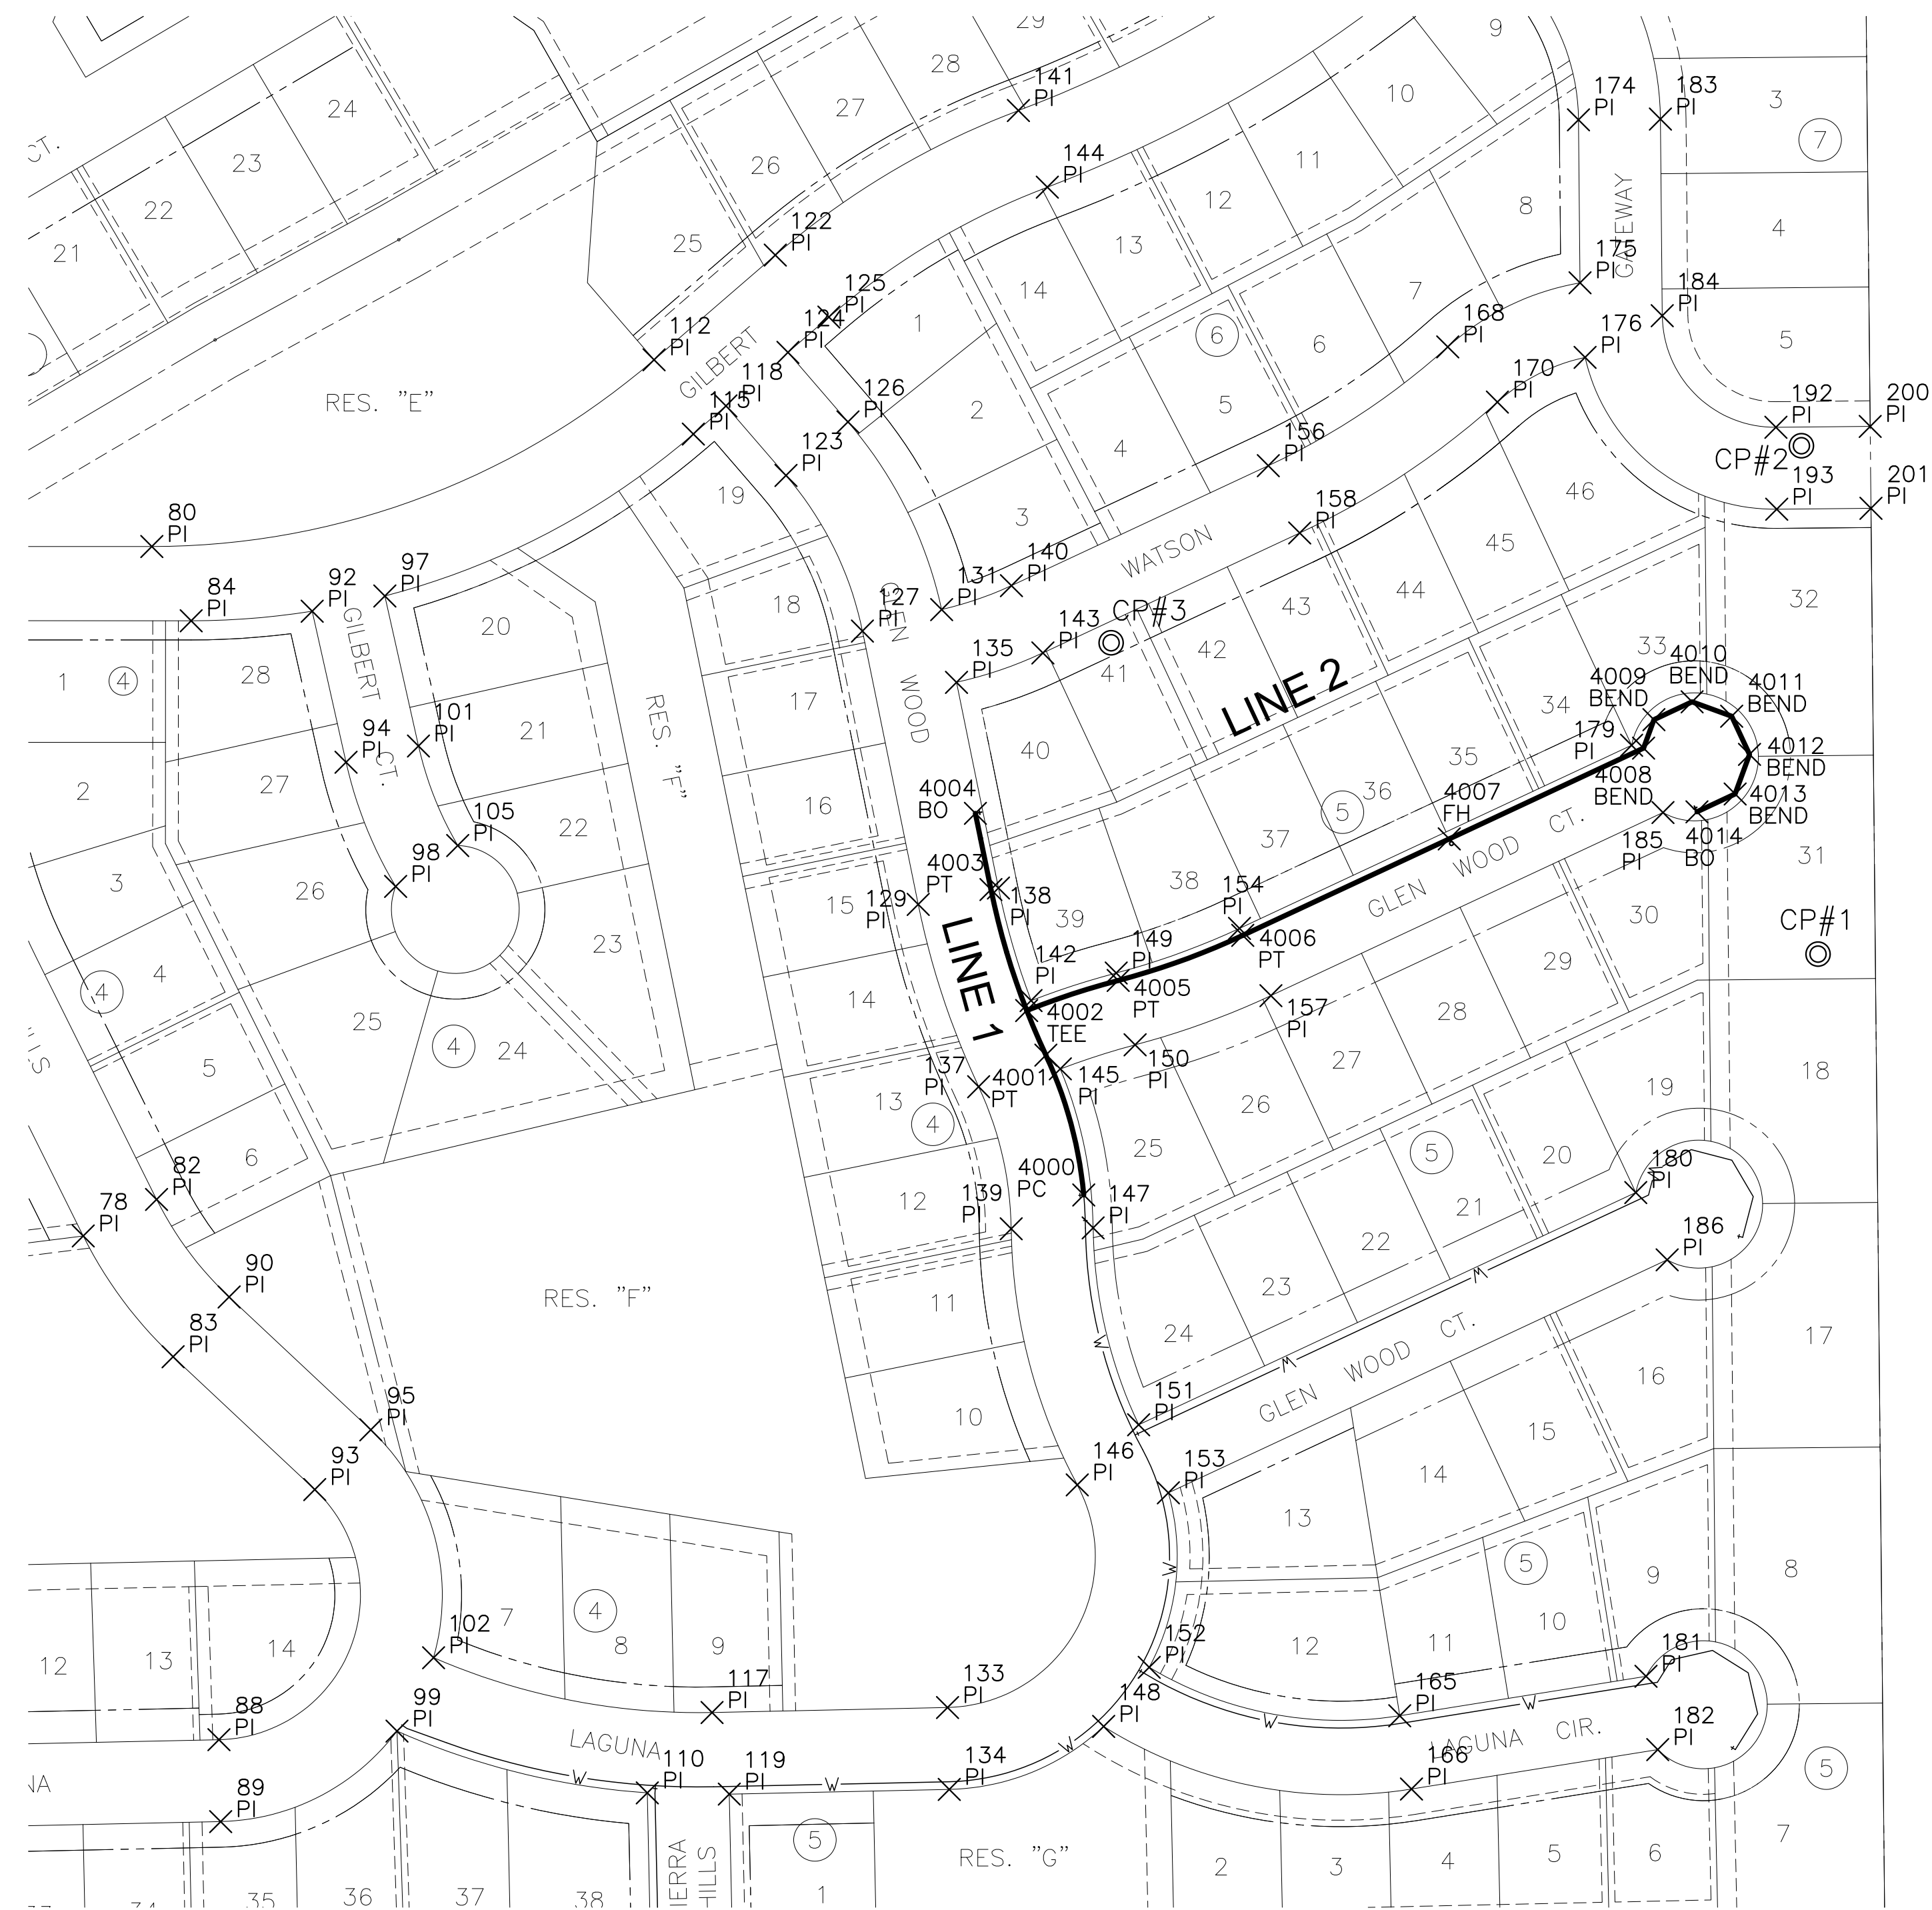

**CONTROL POINTS**

PT. NO.	NORTH	EAST	ELEV.	DESCRIPTION
1	1682116.738	1694393.137	1339.32	5/8" BAR W/ MKEC ALUM ID CAP
2	1682513.937	1694380.129	1338.21	5/8" BAR W/ MKEC ALUM ID CAP
3	1682359.995	1693840.825	1335.40	5/8" BAR W/ MKEC ALUM ID CAP

1" = 100'

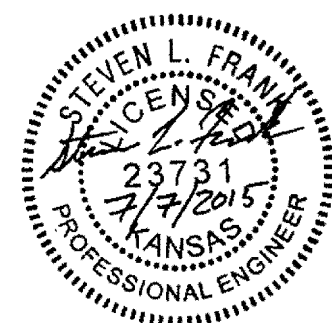

PLAT POINTS			
Point #	Northing	Easting	Desc.
78	1681896.57	1693037.81	PI
80	1682435.20	1693091.39	PI
82	1681925.07	1693095.11	PI
83	1681802.19	1693108.02	PI
84	1682377.18	1693122.13	PI
88	1681503.01	1693143.83	PI
89	1681439.03	1693145.19	PI
90	1681848.88	1693151.79	PI
92	1682384.64	1693216.66	PI
93	1681698.43	1693218.70	PI
94	1682266.64	1693243.12	PI
95	1681745.12	1693262.47	PI
97	1682396.51	1693273.44	PI
98	1682169.63	1693281.87	PI
99	1681509.70	1693282.95	PI
101	1682279.33	1693299.71	PI
102	1681567.06	1693311.52	PI
105	1682201.58	1693330.35	PI
110	1681461.46	1693478.49	PI
112	1682581.06	1693483.74	PI
115	1682523.04	1693514.48	PI
117	1681524.23	1693529.07	PI
118	1682545.02	1693539.94	PI
119	1681460.51	1693542.52	PI
122	1682662.87	1693578.50	PI
123	1682490.72	1693586.82	PI
124	1682586.85	1693588.38	PI
125	1682614.43	1693620.33	PI
126	1682532.55	1693635.26	PI
127	1682369.13	1693646.57	PI
129	1682155.61	1693690.11	PI
131	1682385.90	1693708.44	PI
133	1681528.16	1693713.03	PI
134	1681464.17	1693714.39	PI
135	1682329.07	1693720.05	PI
137	1682013.15	1693737.35	PI
138	1682168.40	1693752.82	PI
139	1681902.15	1693762.78	PI

WATER POINTS			
Point #	Northing	Easting	Desc.
4000	1681928.59	1693819.46	PC
4001	1682037.82	1693789.85	PT
4002	1682072.67	1693774.86	TEE
4003	1682167.20	1693746.94	PT
4004	1682226.73	1693734.80	BO
4005	1682096.19	1693846.36	PT
4006	1682131.40	1693943.66	PT
4007	1682206.77	1694105.01	FH

PLAT POINTS			
Point #	Northing	Easting	Desc.
140	1682404.61	1693762.97	PI
141	1682775.82	1693768.41	PI
142	1682080.46	1693778.29	PI
143	1682352.06	1693787.52	PI
144	1682715.94	1693791.01	PI
145	1682027.11	1693801.16	PI
146	1681702.08	1693814.40	PI
147	1681902.86	1693826.77	PI
148	1681513.36	1693834.99	PI
149	1682102.00	1693844.83	PI
150	1682045.91	1693859.60	PI
151	1681749.05	1693862.33	PI
152	1681559.56	1693870.60	PI
153	1681695.90	1693885.57	PI
154	1682136.84	1693941.12	PI
156	1682498.34	1693963.63	PI
157	1682084.29	1693965.67	PI
158	1682445.79	1693988.18	PI
165	1681521.74	1694066.32	PI
166	1681464.47	1694075.49	PI
168	1682591.14	1694103.82	PI
170	1682548.01	1694142.61	PI
174	1682768.56	1694205.97	PI
175	1682641.23	1694207.16	PI
176	1682582.94	1694211.11	PI
179	1682279.92	1694247.44	PI
180	1681930.46	1694250.70	PI
181	1681552.54	1694258.72	PI
182	1681495.27	1694267.89	PI
183	1682769.15	1694269.97	PI
184	1682615.51	1694271.40	PI
185	1682227.37	1694271.99	PI
186	1681877.91	1694275.25	PI
192	1682528.33	1694360.22	PI
193	1682464.34	1694360.81	PI
200	1682529.02	1694433.85	PI
201	1682465.02	1694434.47	PI

WATER POINTS			
Point #	Northing	Easting	Desc.
4008	1682277.68	1694256.82	BEND
4009	1682299.92	1694264.89	BEND
4010	1682313.84	1694294.71	BEND
4011	1682302.61	1694325.65	BEND
4012	1682272.79	1694339.57	BEND
4013	1682241.86	1694328.34	BEND
4014	1682227.93	1694298.52	BO



WATER DISTRIBUTION PLANS FOR  
**COUNTRY HOLLOW ADDITION**  
 PHASE 3A

©2015 MKEC Engineering All Rights Reserved www.mkec.com  
 These drawings and their contents, including, but not limited to, all concepts, designs, & ideas are the exclusive property of MKEC Engineering (MKEC), and may not be used or reproduced in any way without the express consent of MKEC.

**BUBBLE MAP**

PROJECT NO.	448-90677
DATE	JUNE 2015
SCALE	1"=100'
DESIGNED	DFL
DRAWN	BKS
CHECKED	GJA

NO.	REVISION	DATE

SHEET NO.

EVERY ATTEMPT HAS BEEN MADE TO INSURE ALL COORDINATE VALUES SHOWN ARE AN ACCURATE AND TRUE REPRESENTATION OF THE CURRENT PLANS. ALL VALUES ARE TO BE CONFIRMED WITH THE FINAL SIGNED PLAN SET BEFORE USE.

J:\CIVIL\48906448\CADD\SHS05\CIVIL\WTR04429\WTR\_BUBBLE.DWG