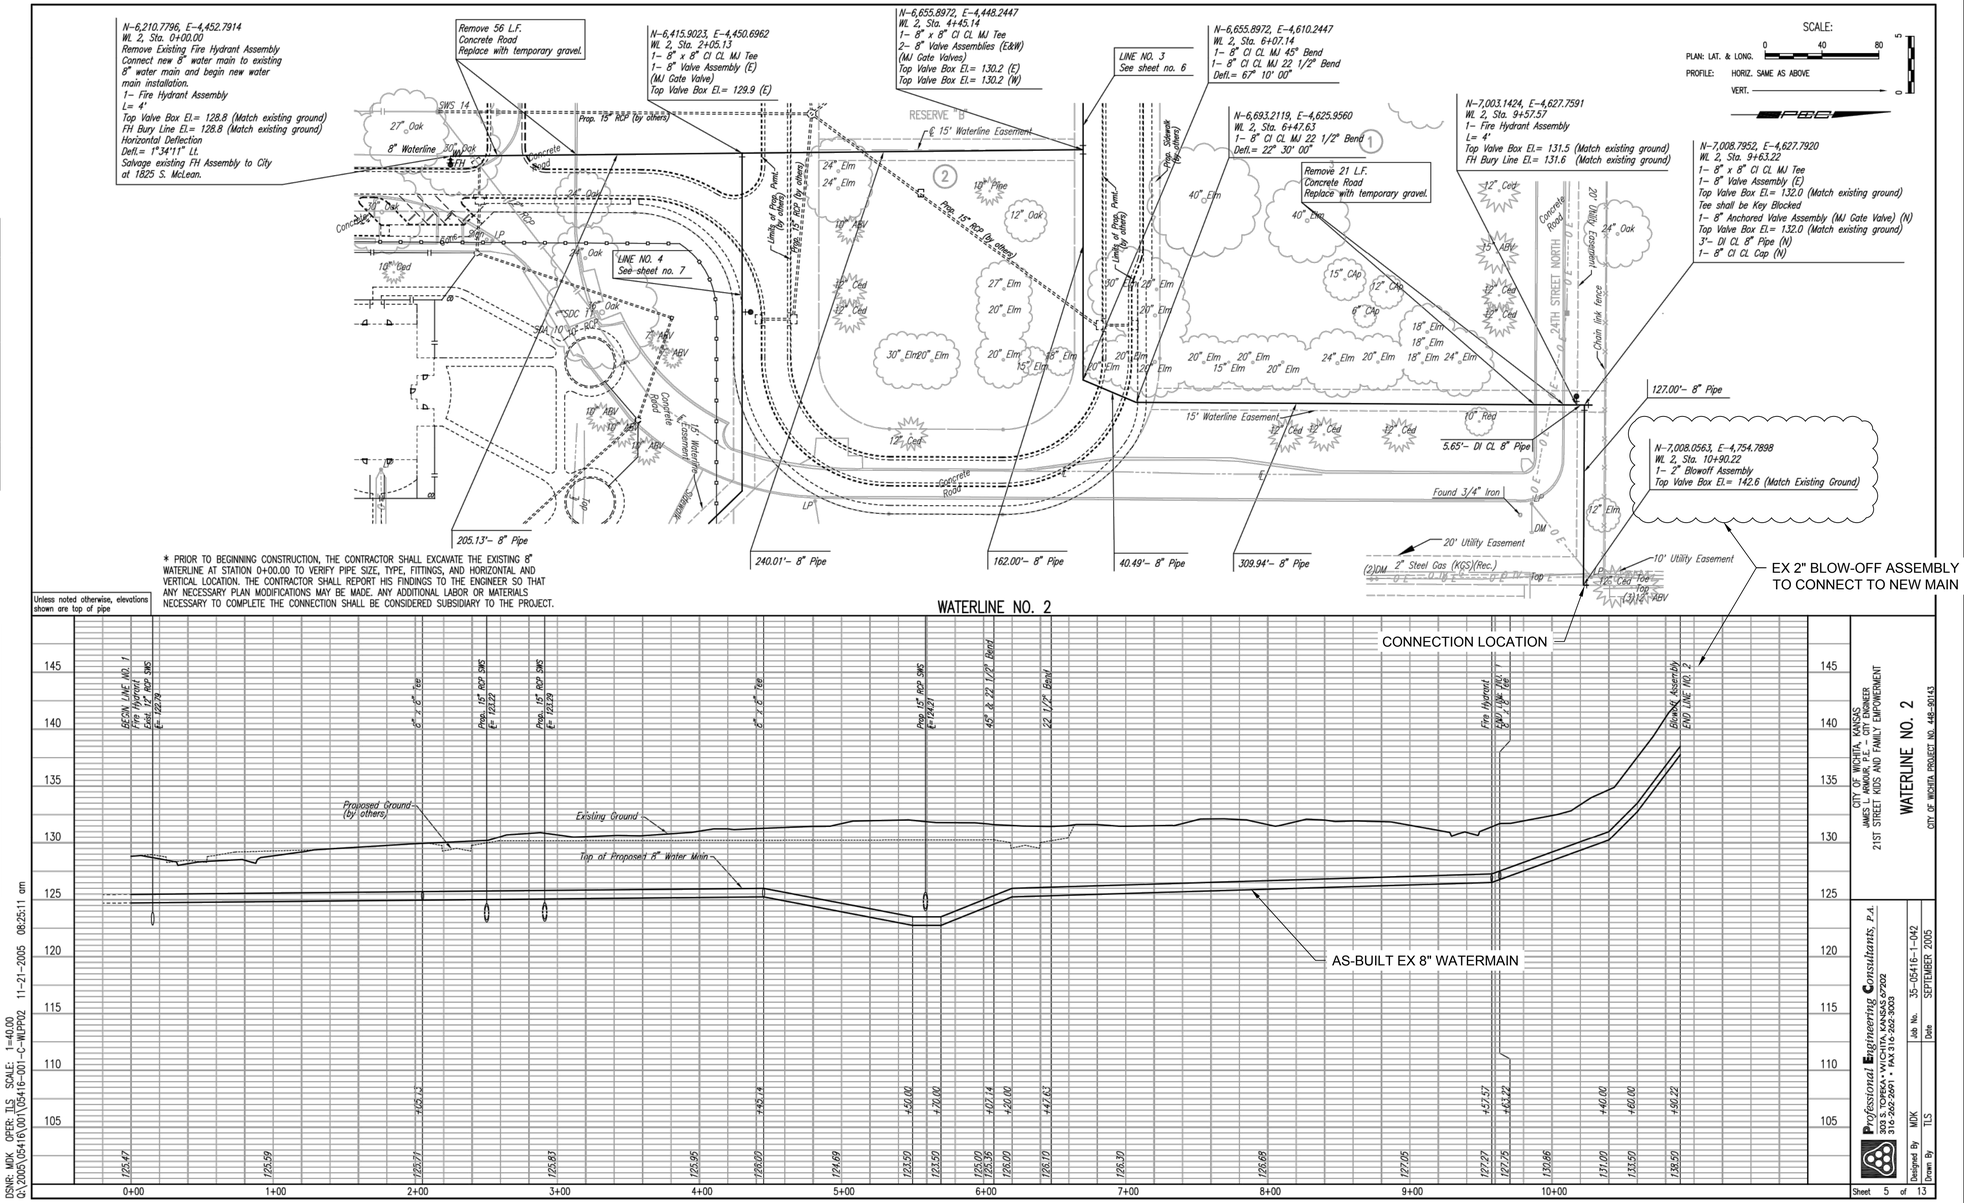

* PRIOR TO BEGINNING CONSTRUCTION, THE CONTRACTOR SHALL EXCAVATE THE EXISTING 8" WATERLINE AT STATION 0+00.00 TO VERIFY PIPE SIZE, TYPE, FITTINGS, AND HORIZONTAL AND VERTICAL LOCATION. THE CONTRACTOR SHALL REPORT HIS FINDINGS TO THE ENGINEER SO THAT ANY NECESSARY PLAN MODIFICATIONS MAY BE MADE. ANY ADDITIONAL LABOR OR MATERIALS NECESSARY TO COMPLETE THE CONNECTION SHALL BE CONSIDERED SUBSIDIARY TO THE PROJECT.

Unless noted otherwise, elevations shown are top of pipe

* DRAWING PROVIDED BY CITY OF WICHITA.
AREA WAS NOT SURVEYED FOR CONNECTION.
SEE NOTE 4 DWG C024.

CITY OF WICHITA, KANSAS
21ST STREET KIDS AND FAMILY EMPOWERMENT
WATERLINE NO. 2
CITY OF WICHITA PROJECT NO. 448-90143

Professional Engineering Consultants, P.A.

Designed By MDK | Job No. 35-05416-1-042
Drawn By TLS | Date SEPTEMBER 2005

Sheet 5 of 13

DSNR: MDK OPER: TLS SCALE: 1=40.00
Q:\2005\05416\001\05416-001-C-WLPP02 11-21-2005 08:25:11 am

PLAN CHECKED CHECKED BY DATE

PROFILE CHECKED CHECKED BY DATE

Scale For Microfilming Millimeters Inches

J:\WICHITA\77025 - Ethel WMR\CADD\06_Civil\WL-009_DETAILSHEET5.dwg May 07, 2015 - 4:42pm mcharrette

COPYRIGHT © 2015 BURNS & McDONNELL ENGINEERING COMPANY, INC.

no.	date	by	ckd	description

Burns & McDonnell
SINCE 1898
9400 WARD PARKWAY
KANSAS CITY, MO 64114
816-333-9400
LICENSEE NO. 000165

date	detailed
NOVEMBER 04, 2014	M. CHARRETTE
designed	checked
J. MCNIFF	S. WILSON

City of Wichita, Kansas

ETHEL NEIGHBORHOOD WATER MAIN REPLACEMENT
DETAIL SHEET 5

project	contract
77025	448-90612

drawing **C094** — rev. **0**

sheet 101 of 101 sheets
file WL-009_DETAILSHEET5.dwg

JULIE ANN MCNIFF LICENSED 21158 KANSAS PROFESSIONAL ENGINEER

This document has been digitally signed.
05/08/15 9:56 AM

Name
Discipline
License No.