

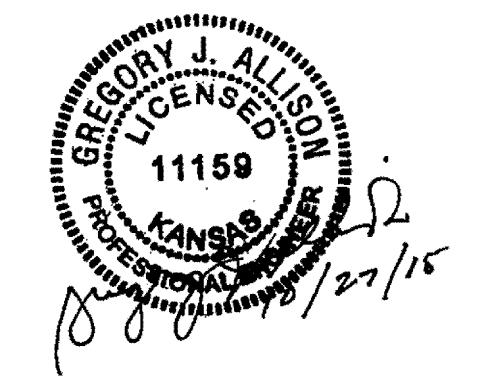
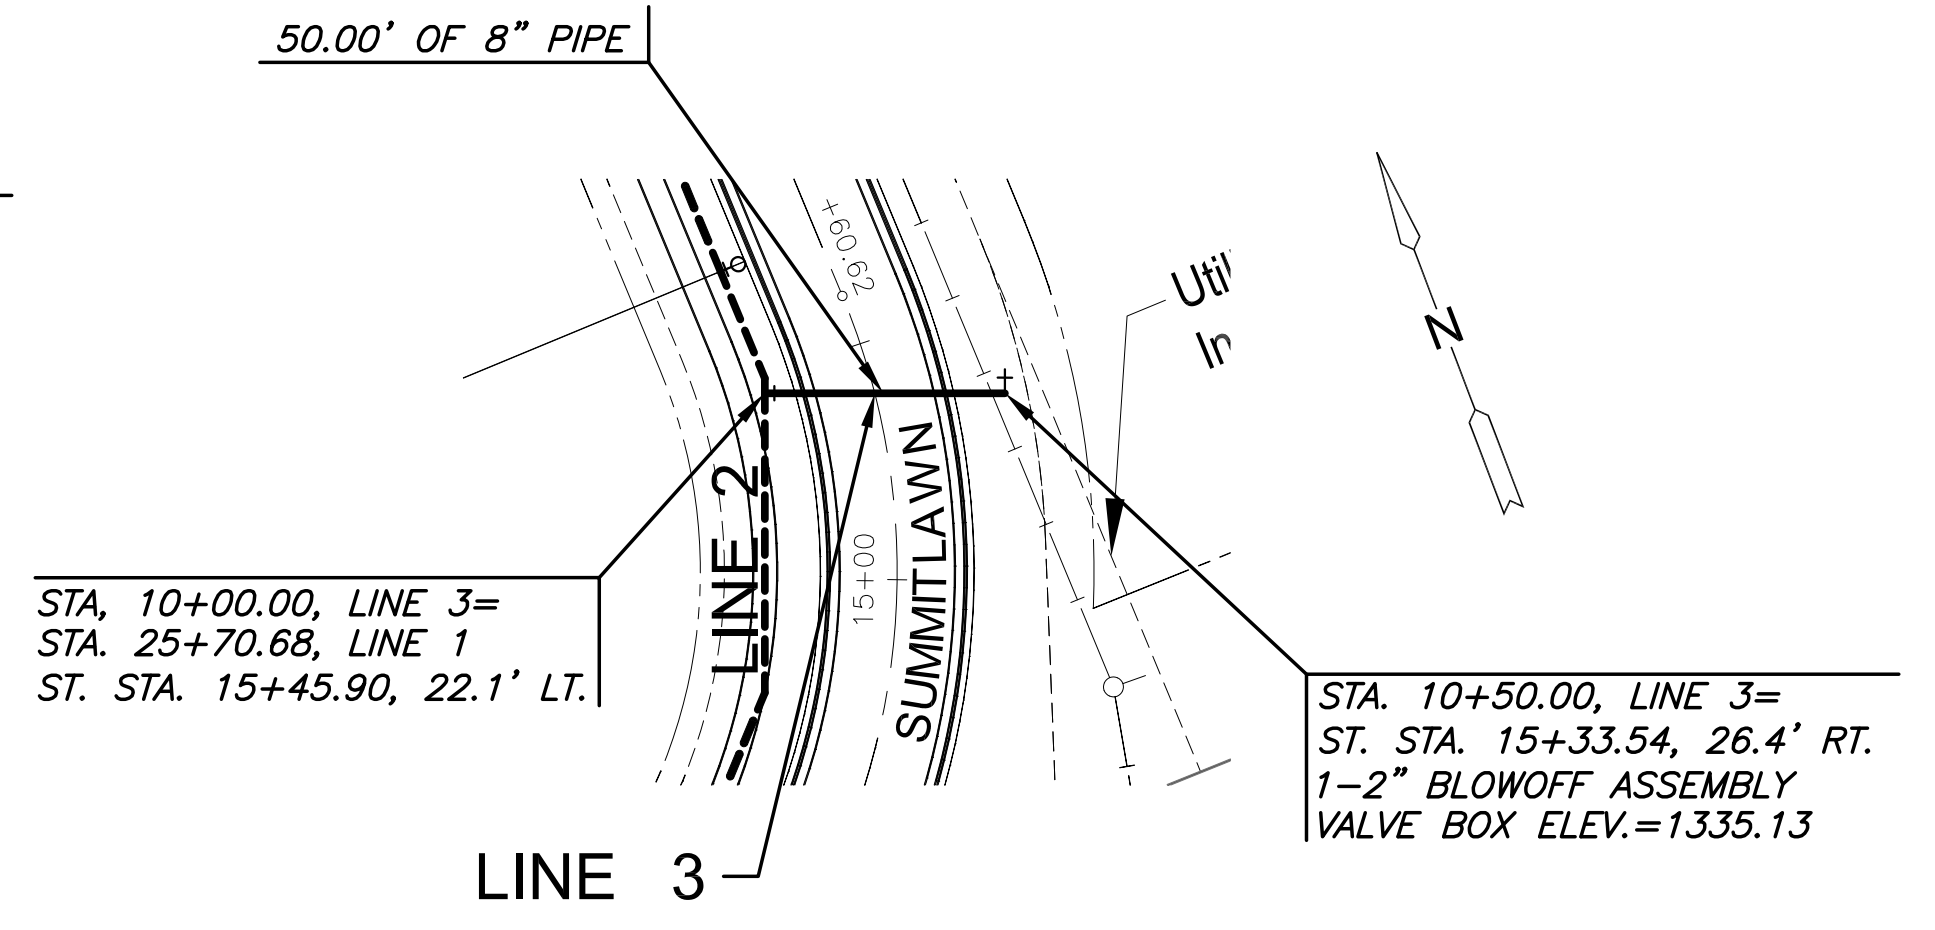


J:\PROJECTS\2014\1401010482_PREMIER_ESTANCIA\GIS\CIVIL\DWG\COMMERCIAL\1402_C01.dwg
 PLOTTED: Tuesday, October 27, 2015 @ 03:32PM


NOTE:
CONTRACTOR TO VERIFY LOCATION AND ELEVATION OF EXISTING WATER LINE PRIOR TO CONSTRUCTION.

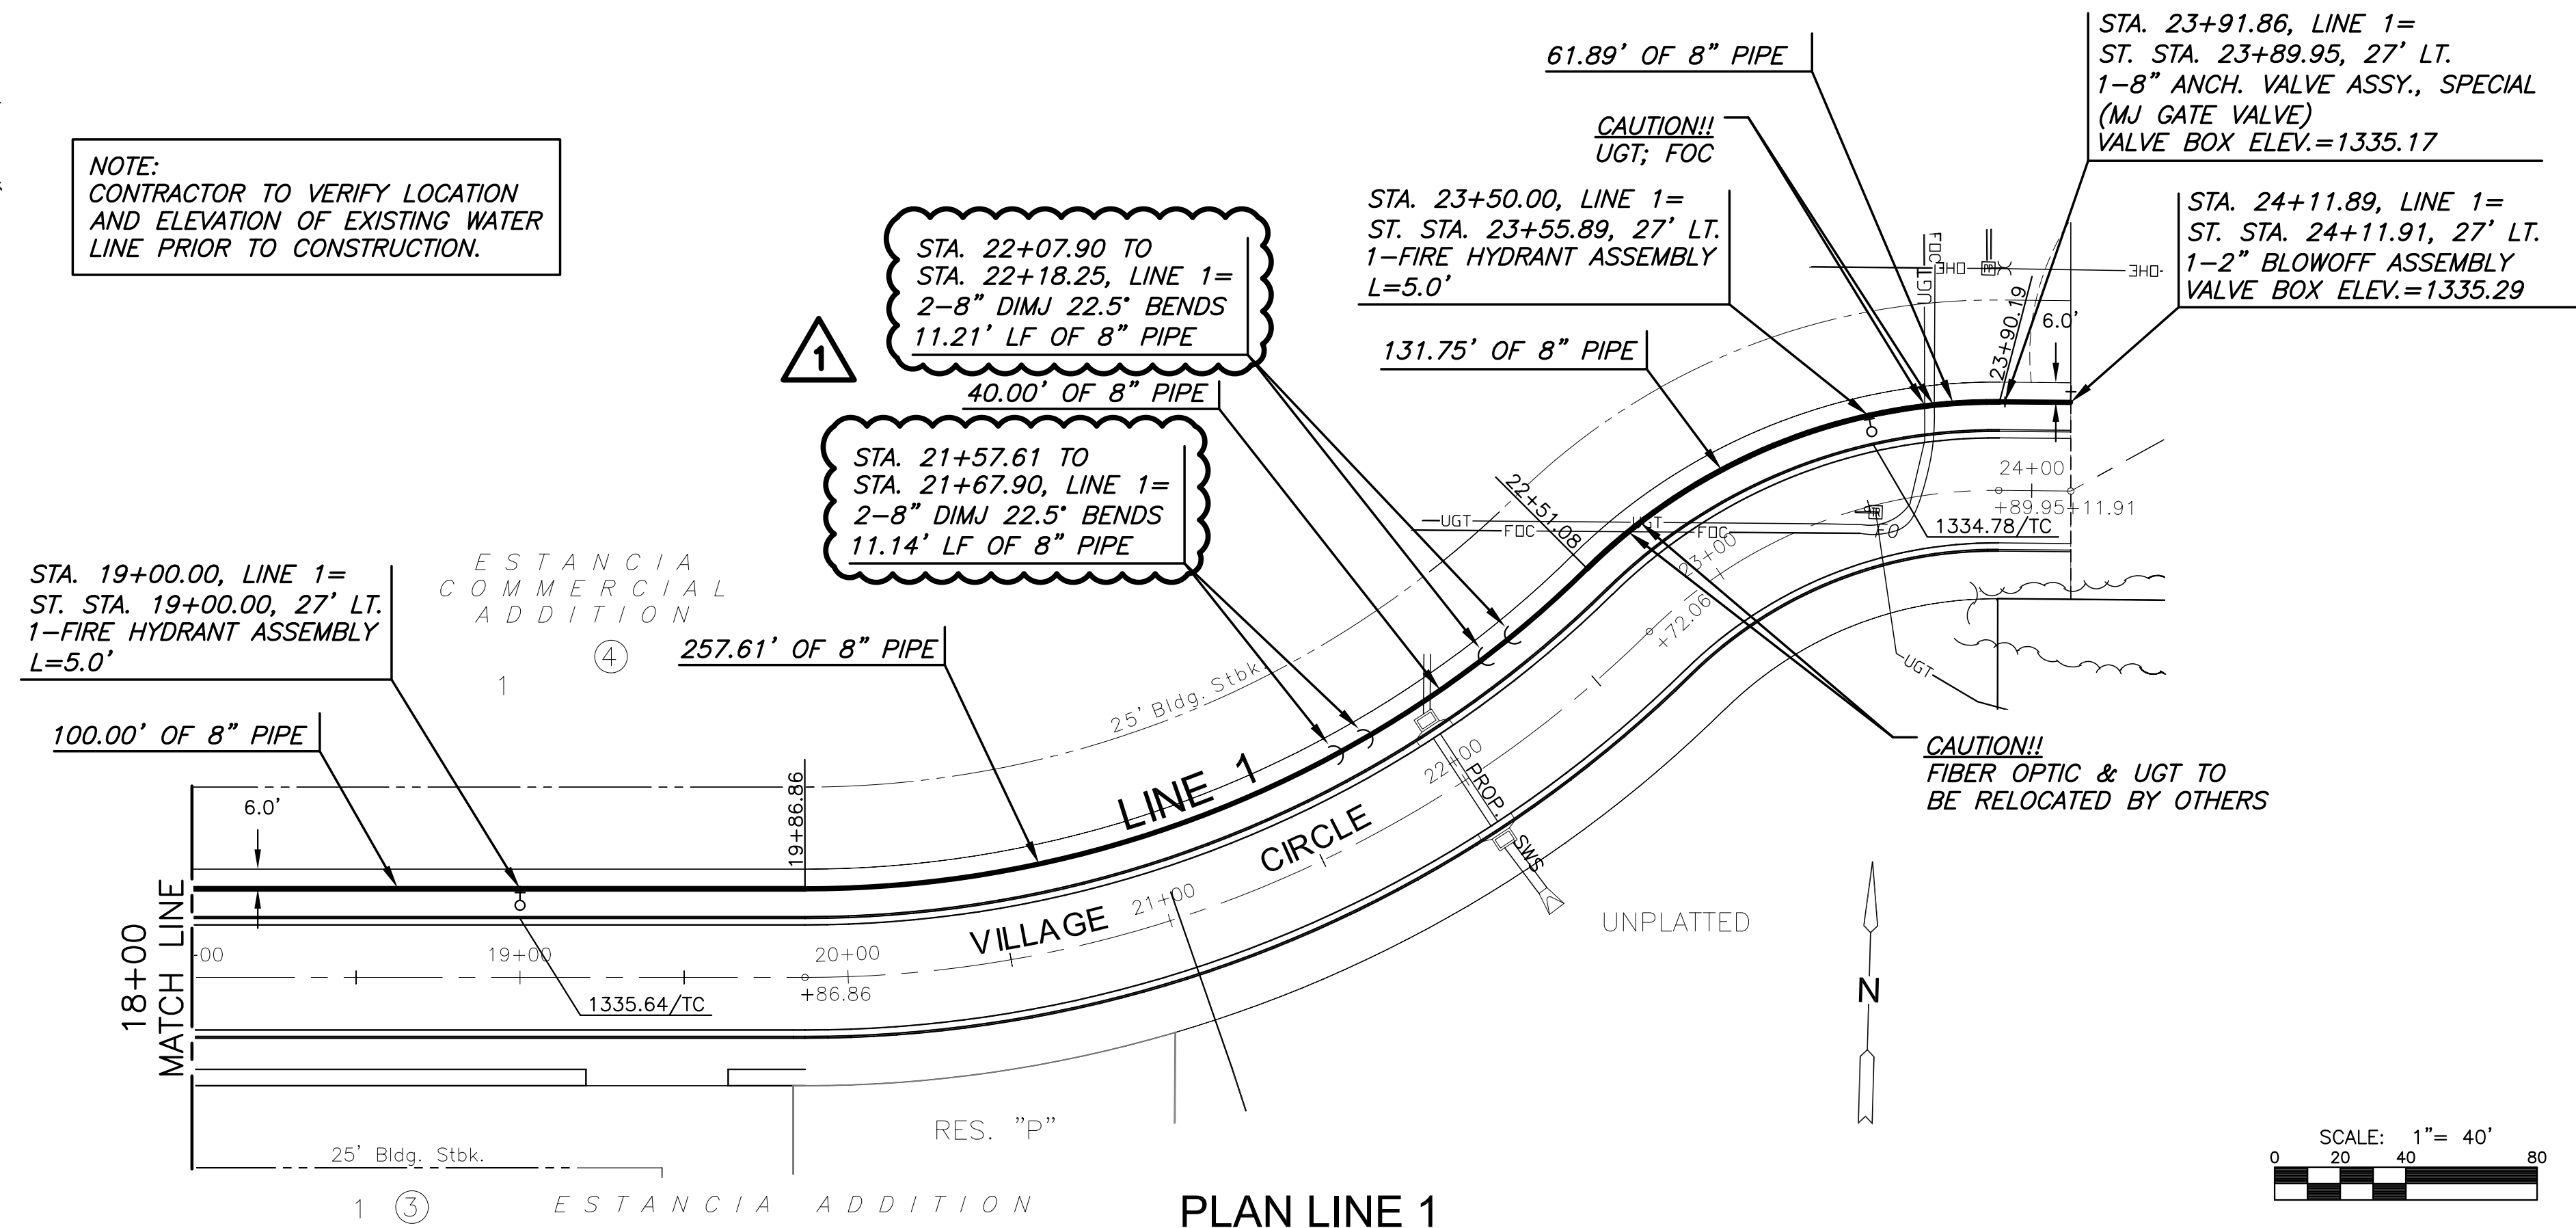

PLAN LINE 1
PROFILE LINE 1

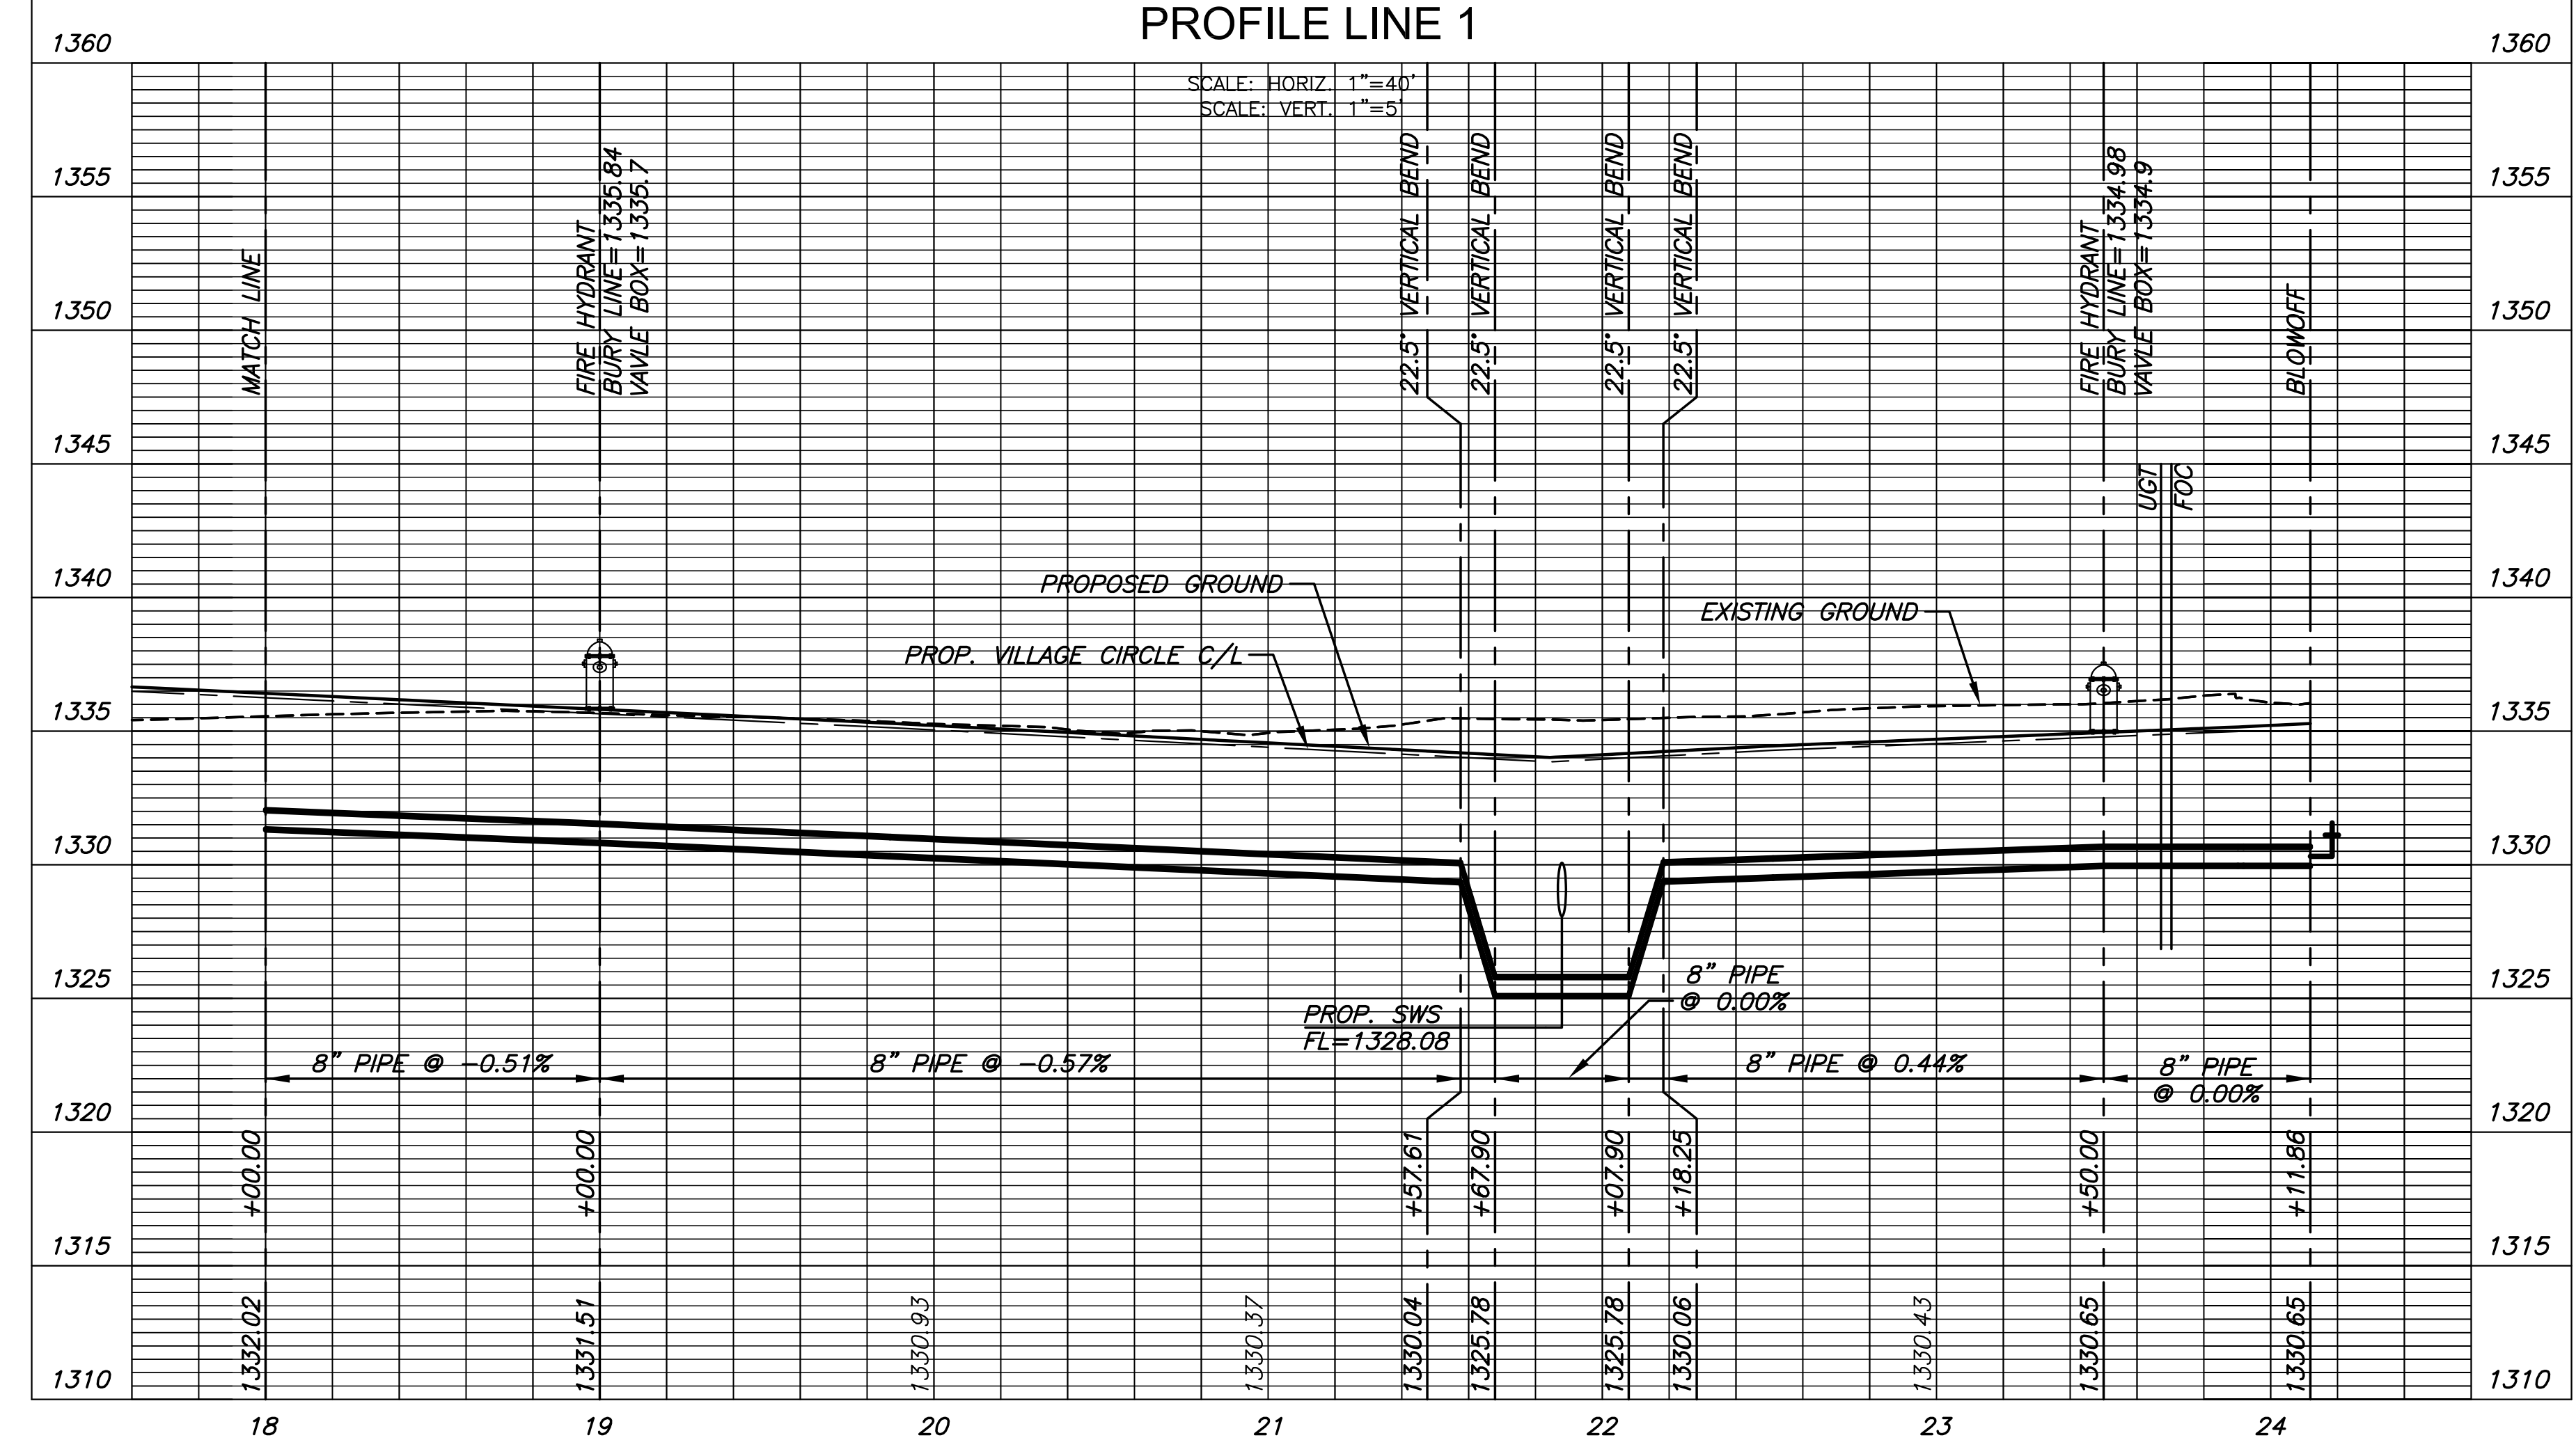

PLAN LINE 3
PROFILE LINE 3

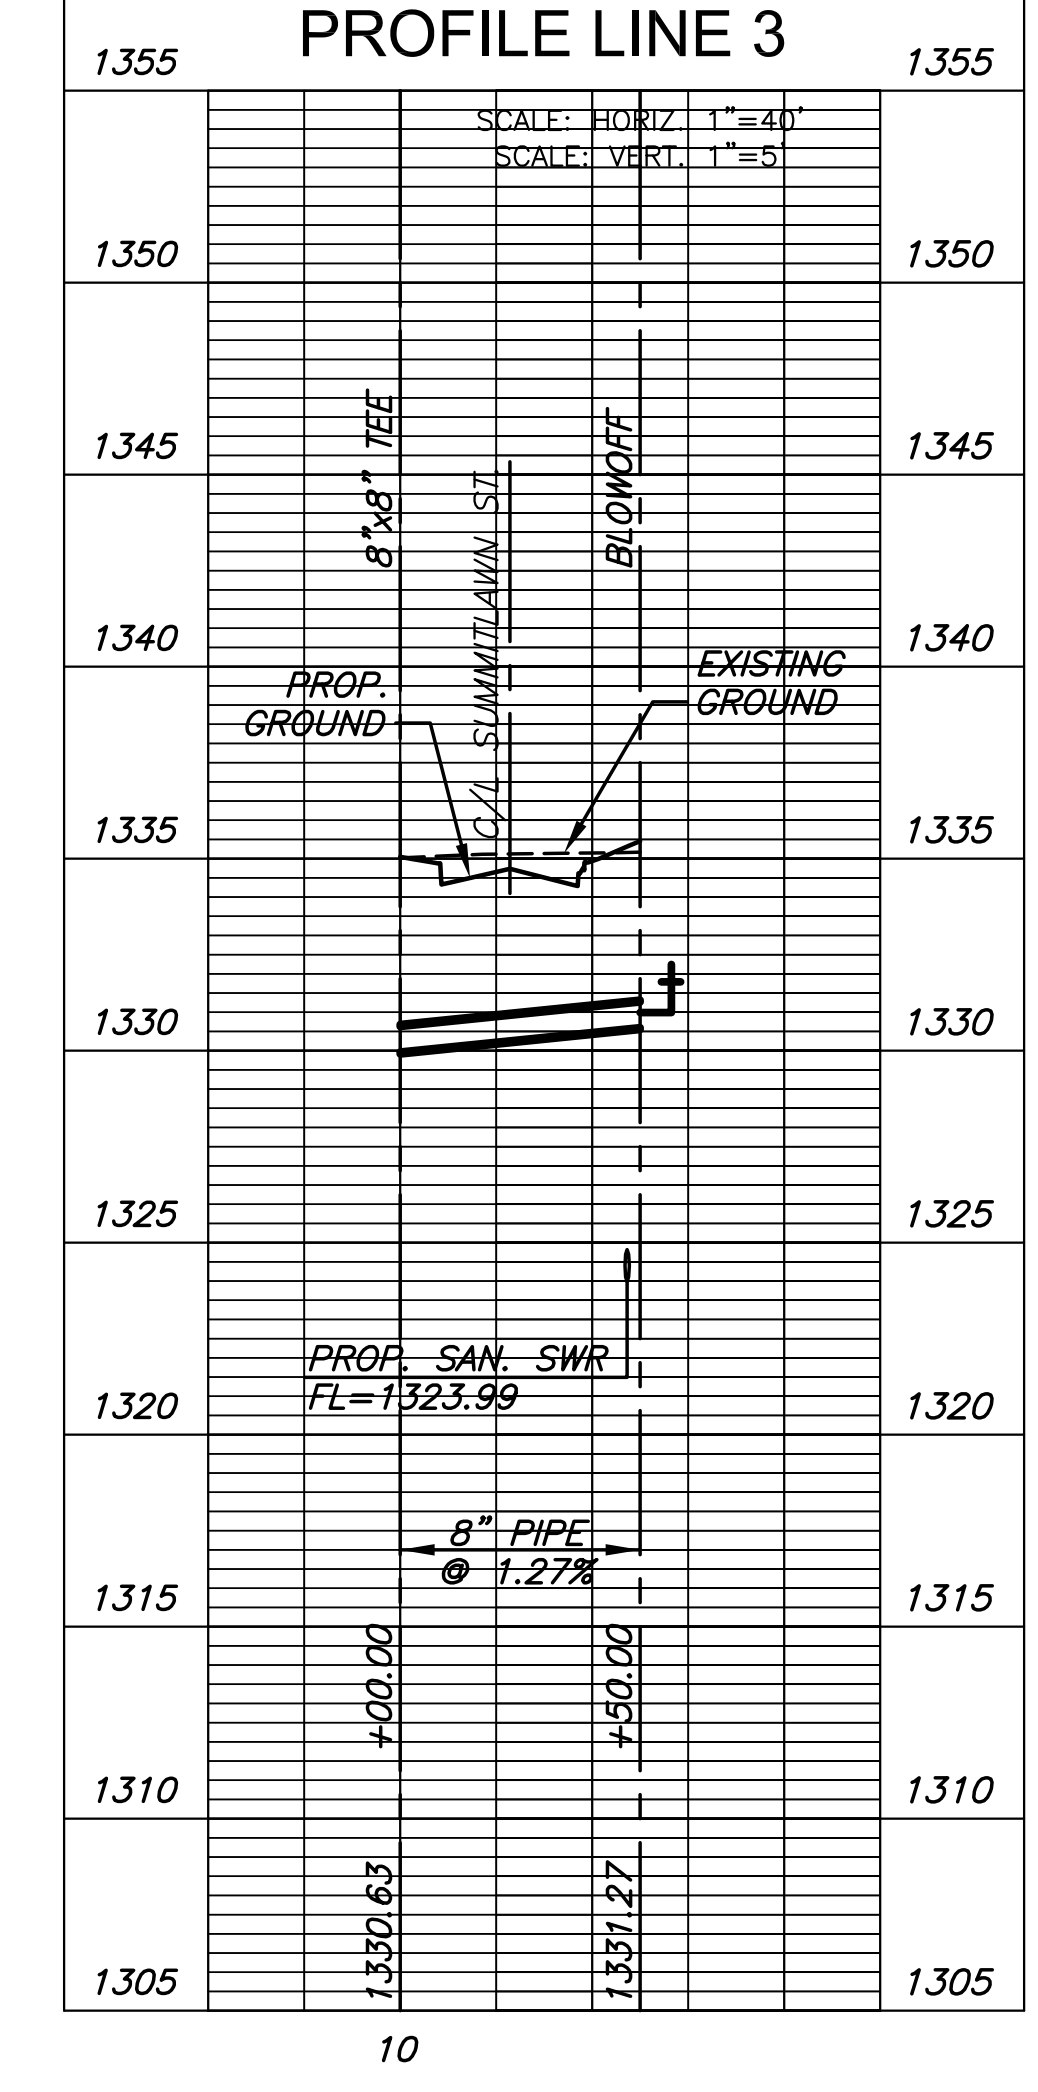

©2015 MKEC Engineering All Rights Reserved
 These drawings and their contents, including, but not limited to, all concepts, designs, & ideas are the exclusive property of MKEC Engineering (MKEC), and may not be used or reproduced in any way without the express consent of MKEC.

LINES 1 & 3	
PROJECT NO.	448-90692
DATE	OCT. 2015
SCALE	1" = 40'
DESIGNED	DRAWN
DFL	JWC
CHECKED	GJA
NO.	REVISION
1	ADJUSTED CALLOUTS
	DATE
	10/27/15
SHEET NO.	
4 OF 13	