
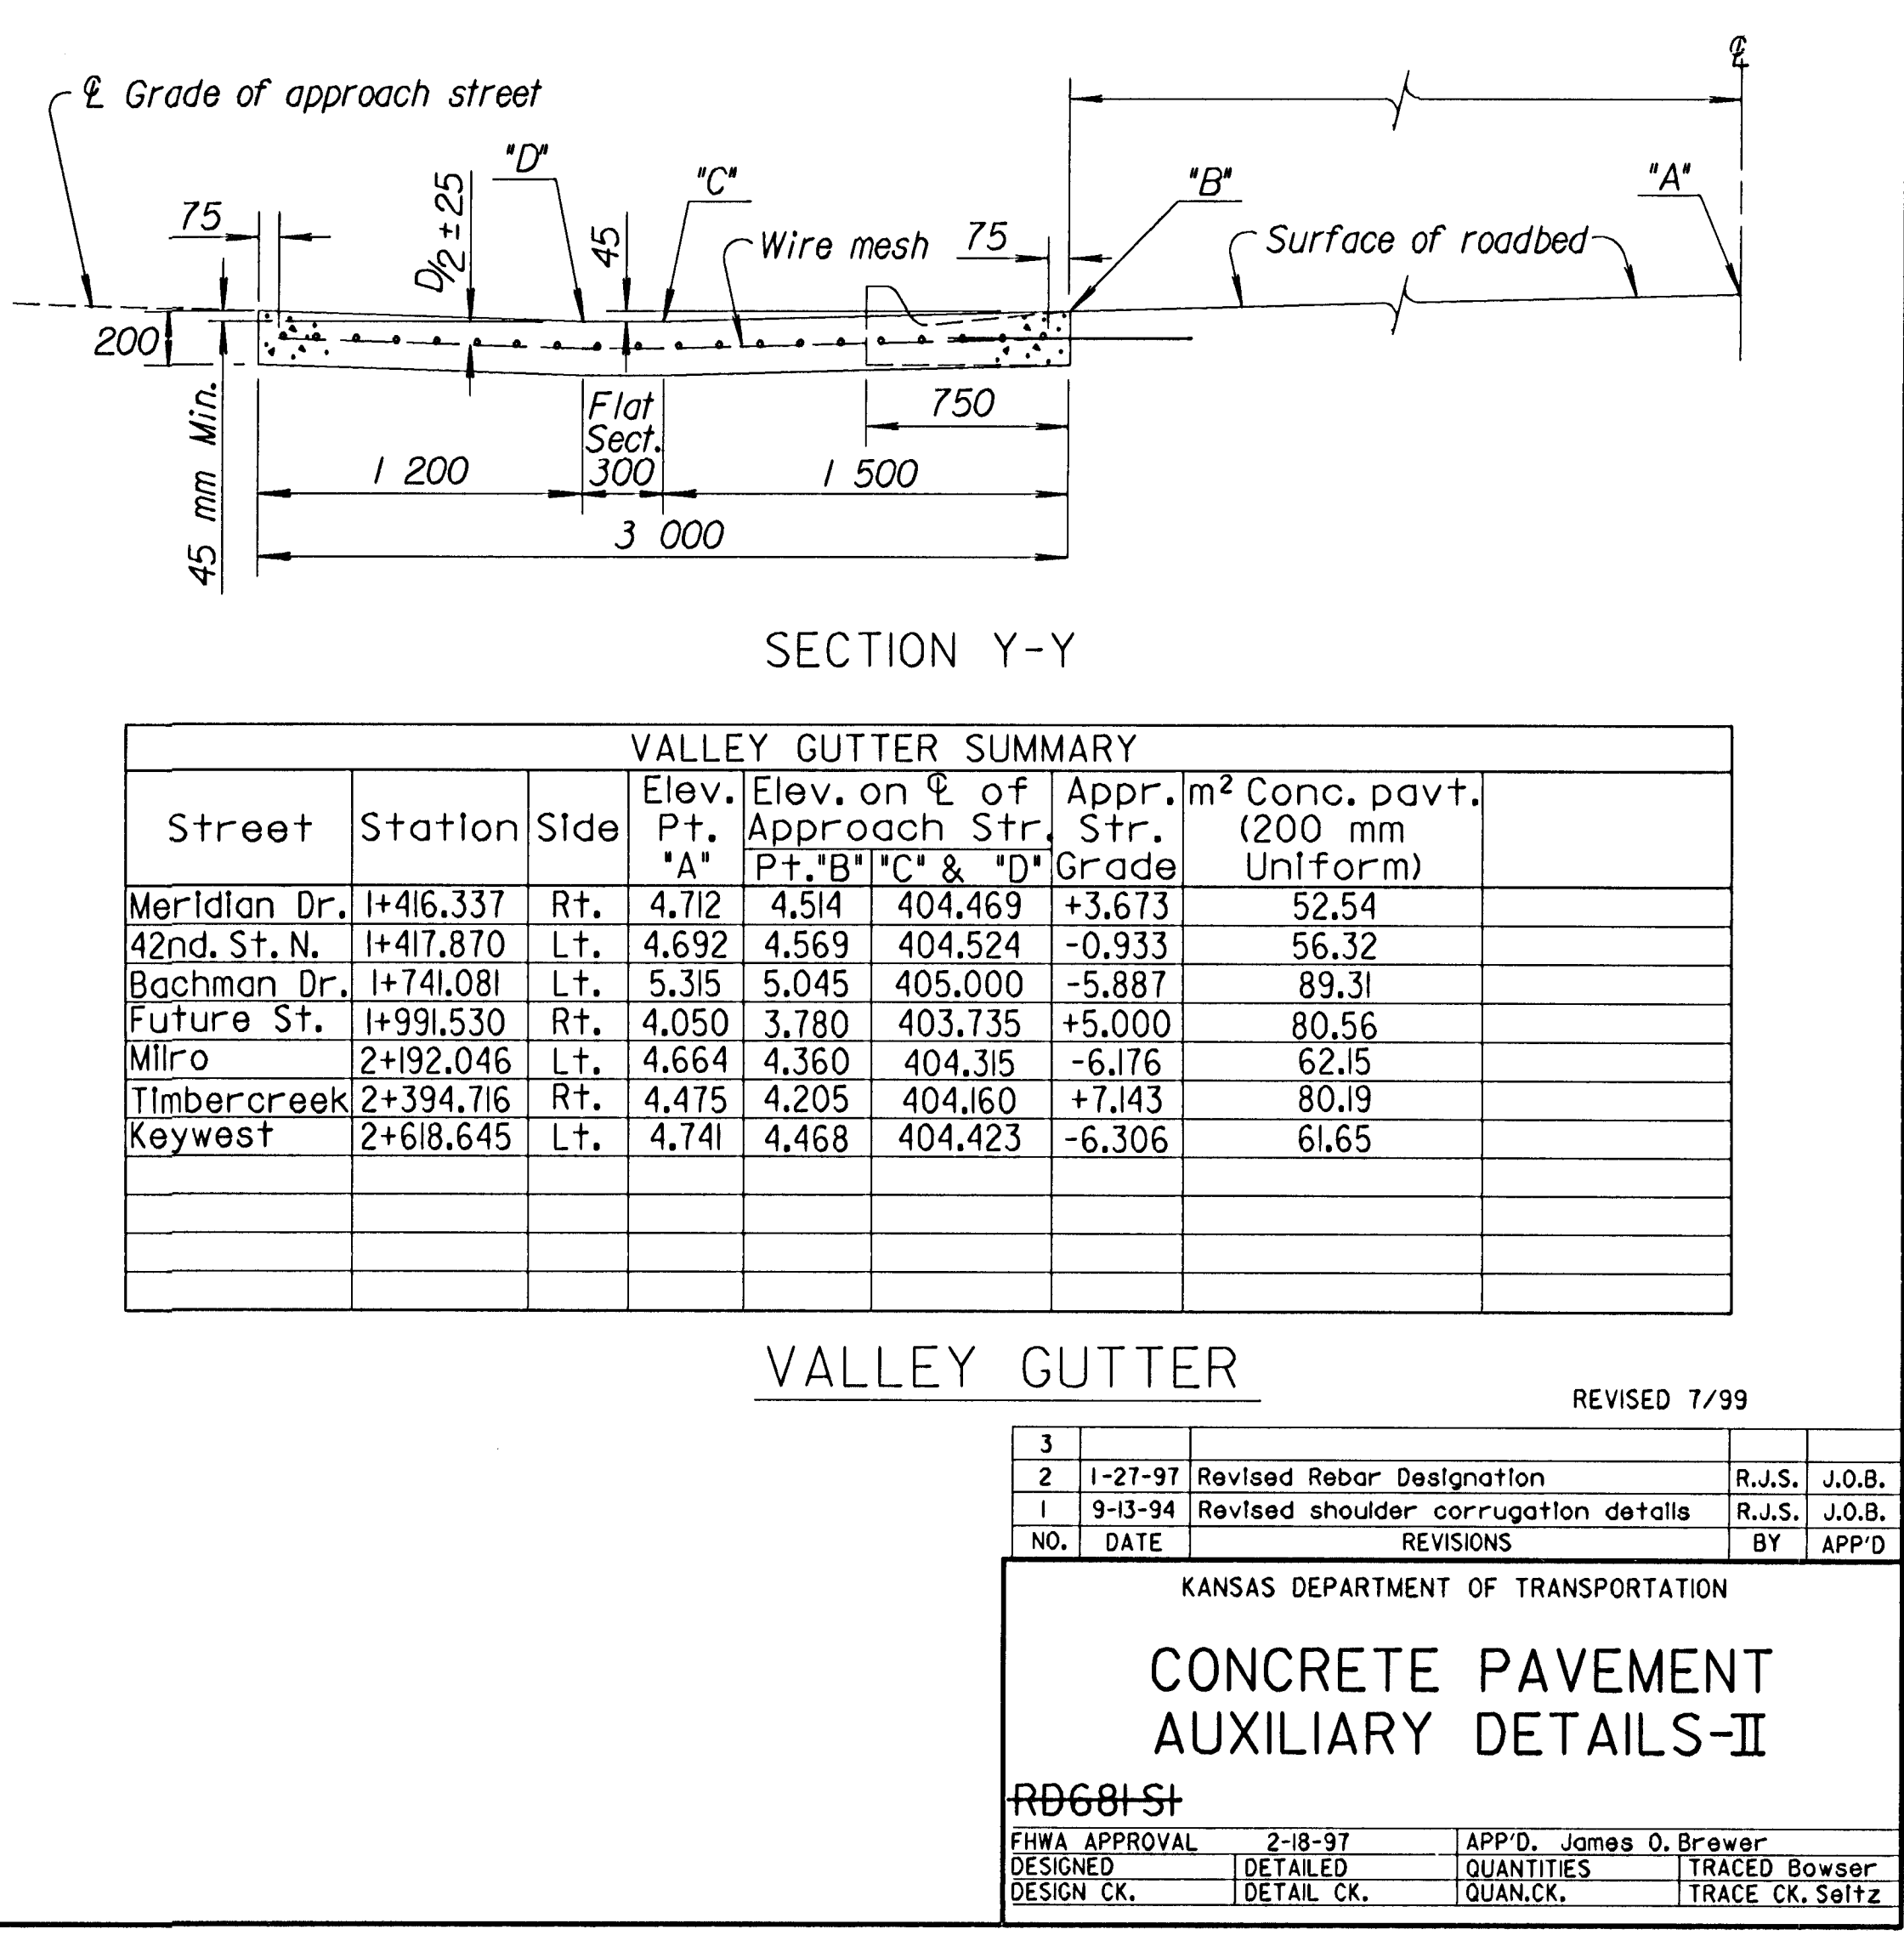
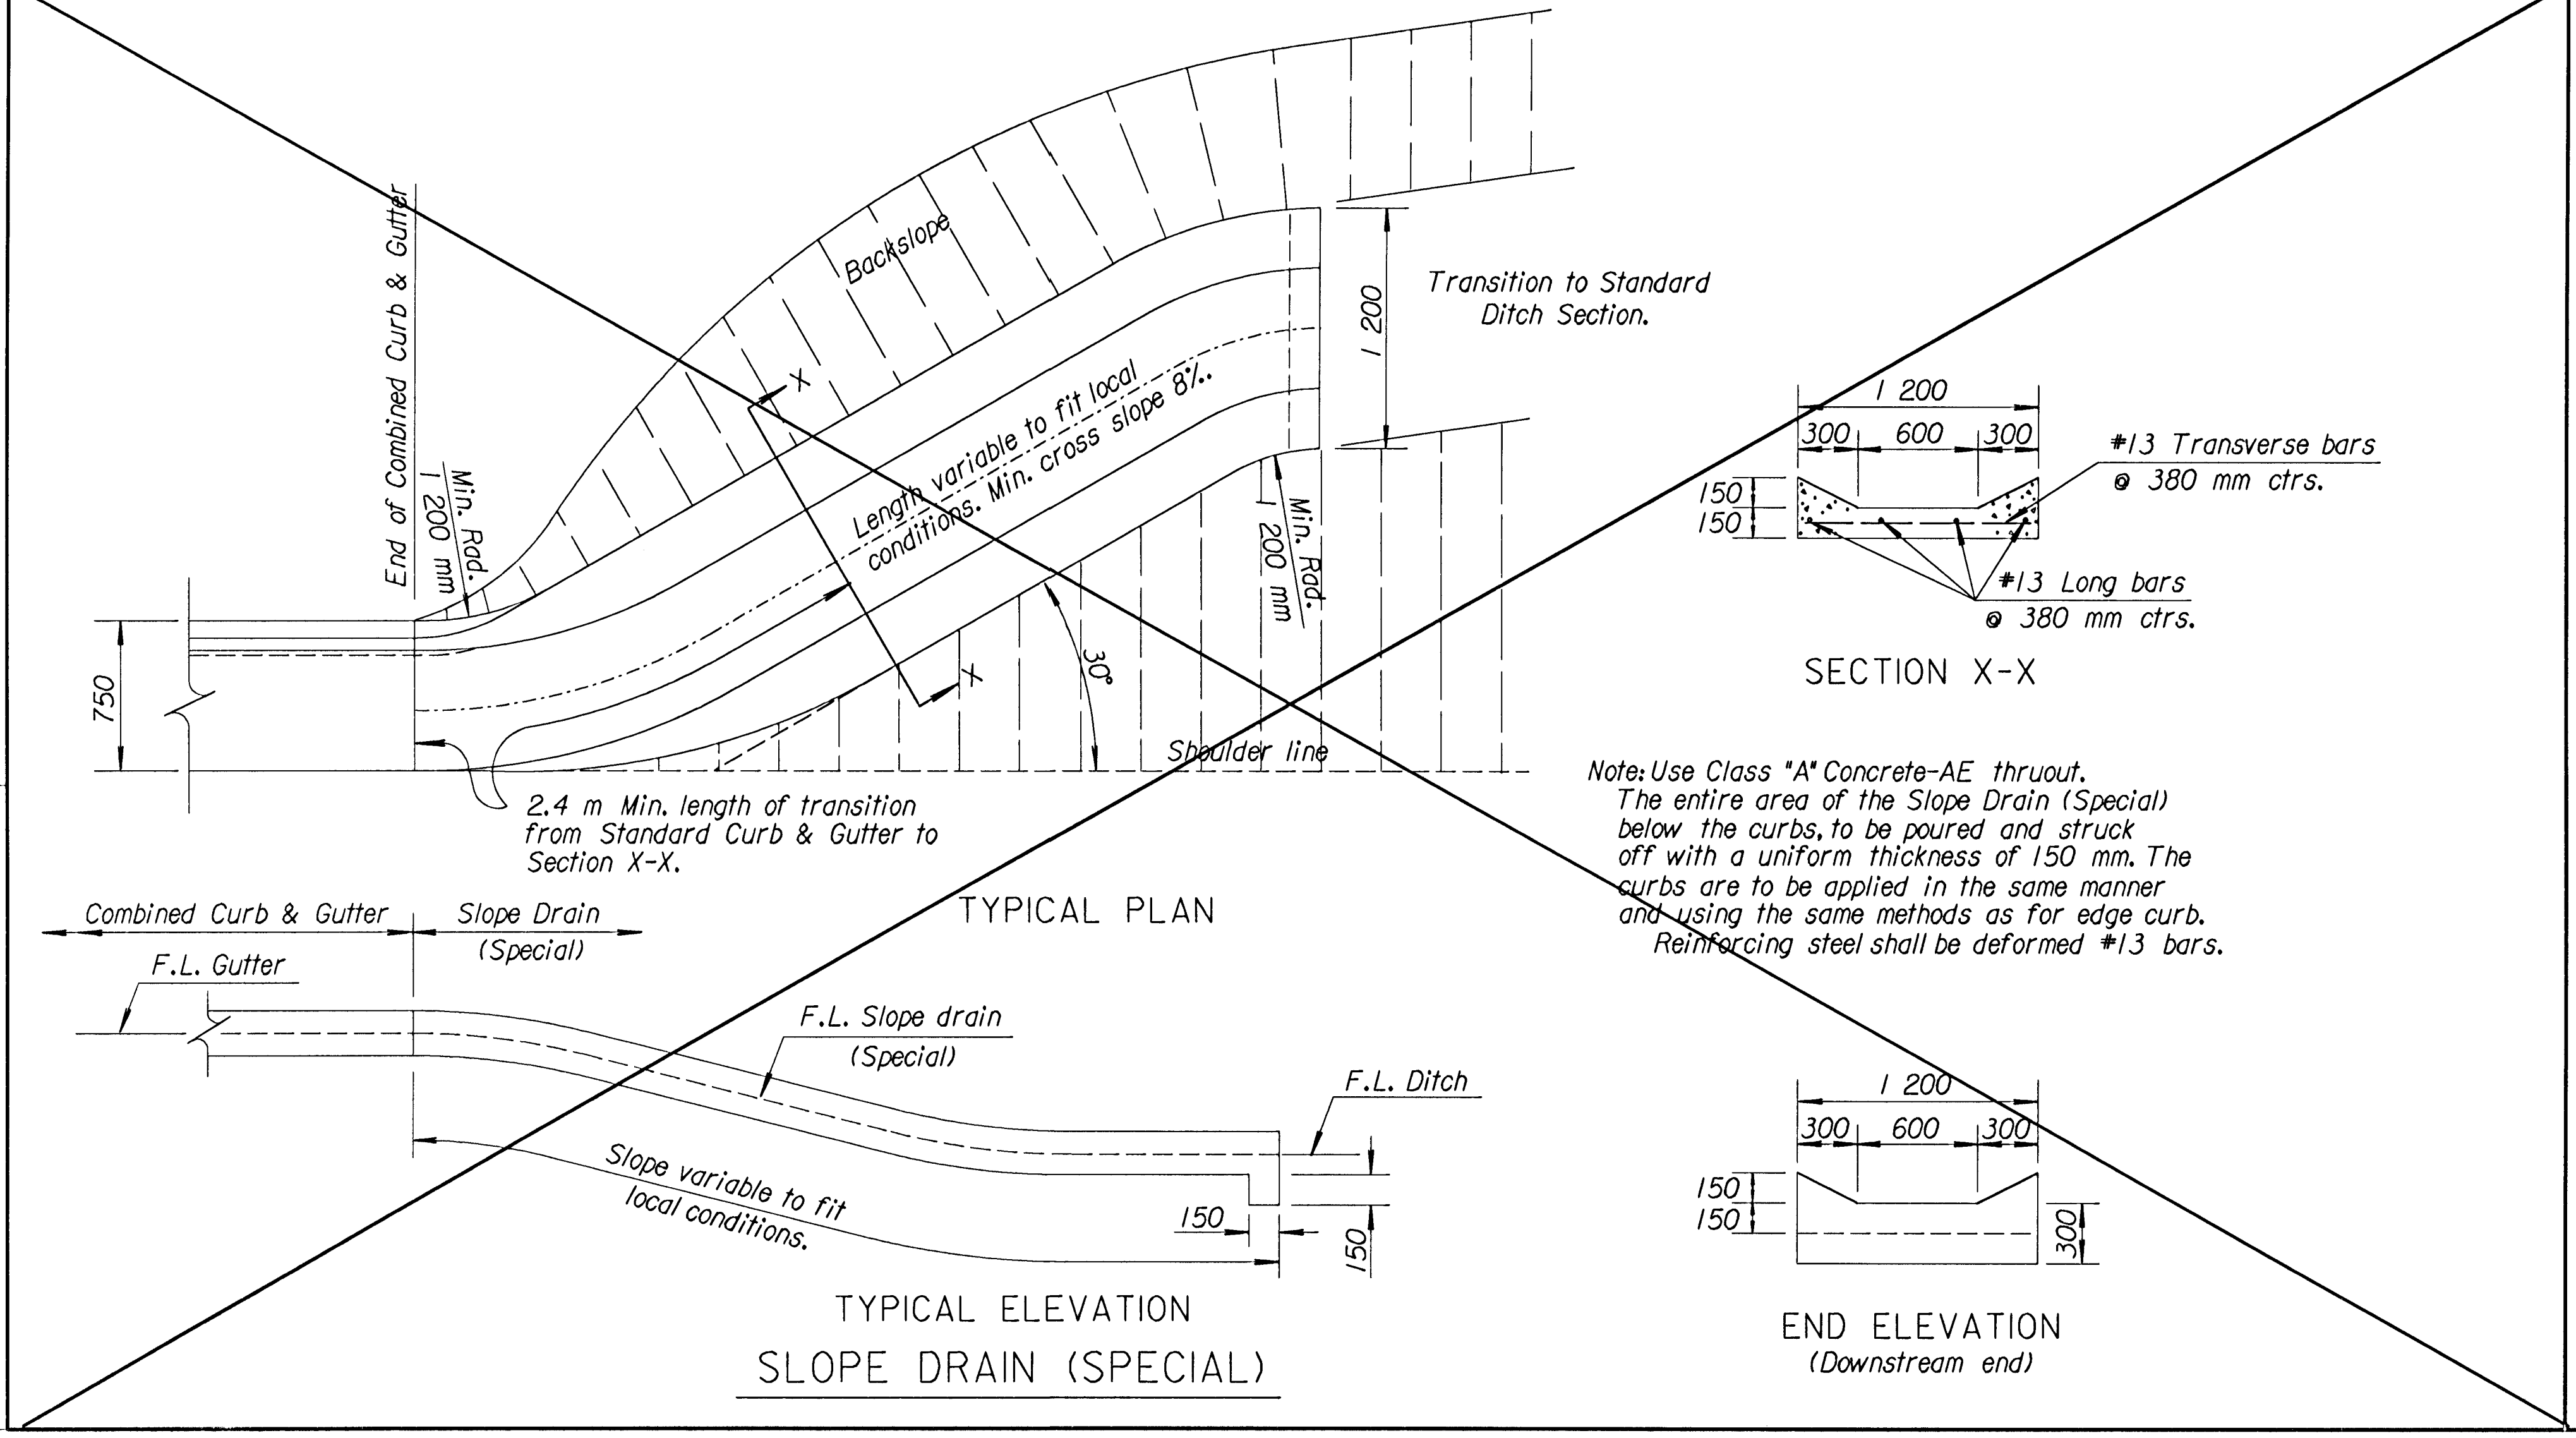
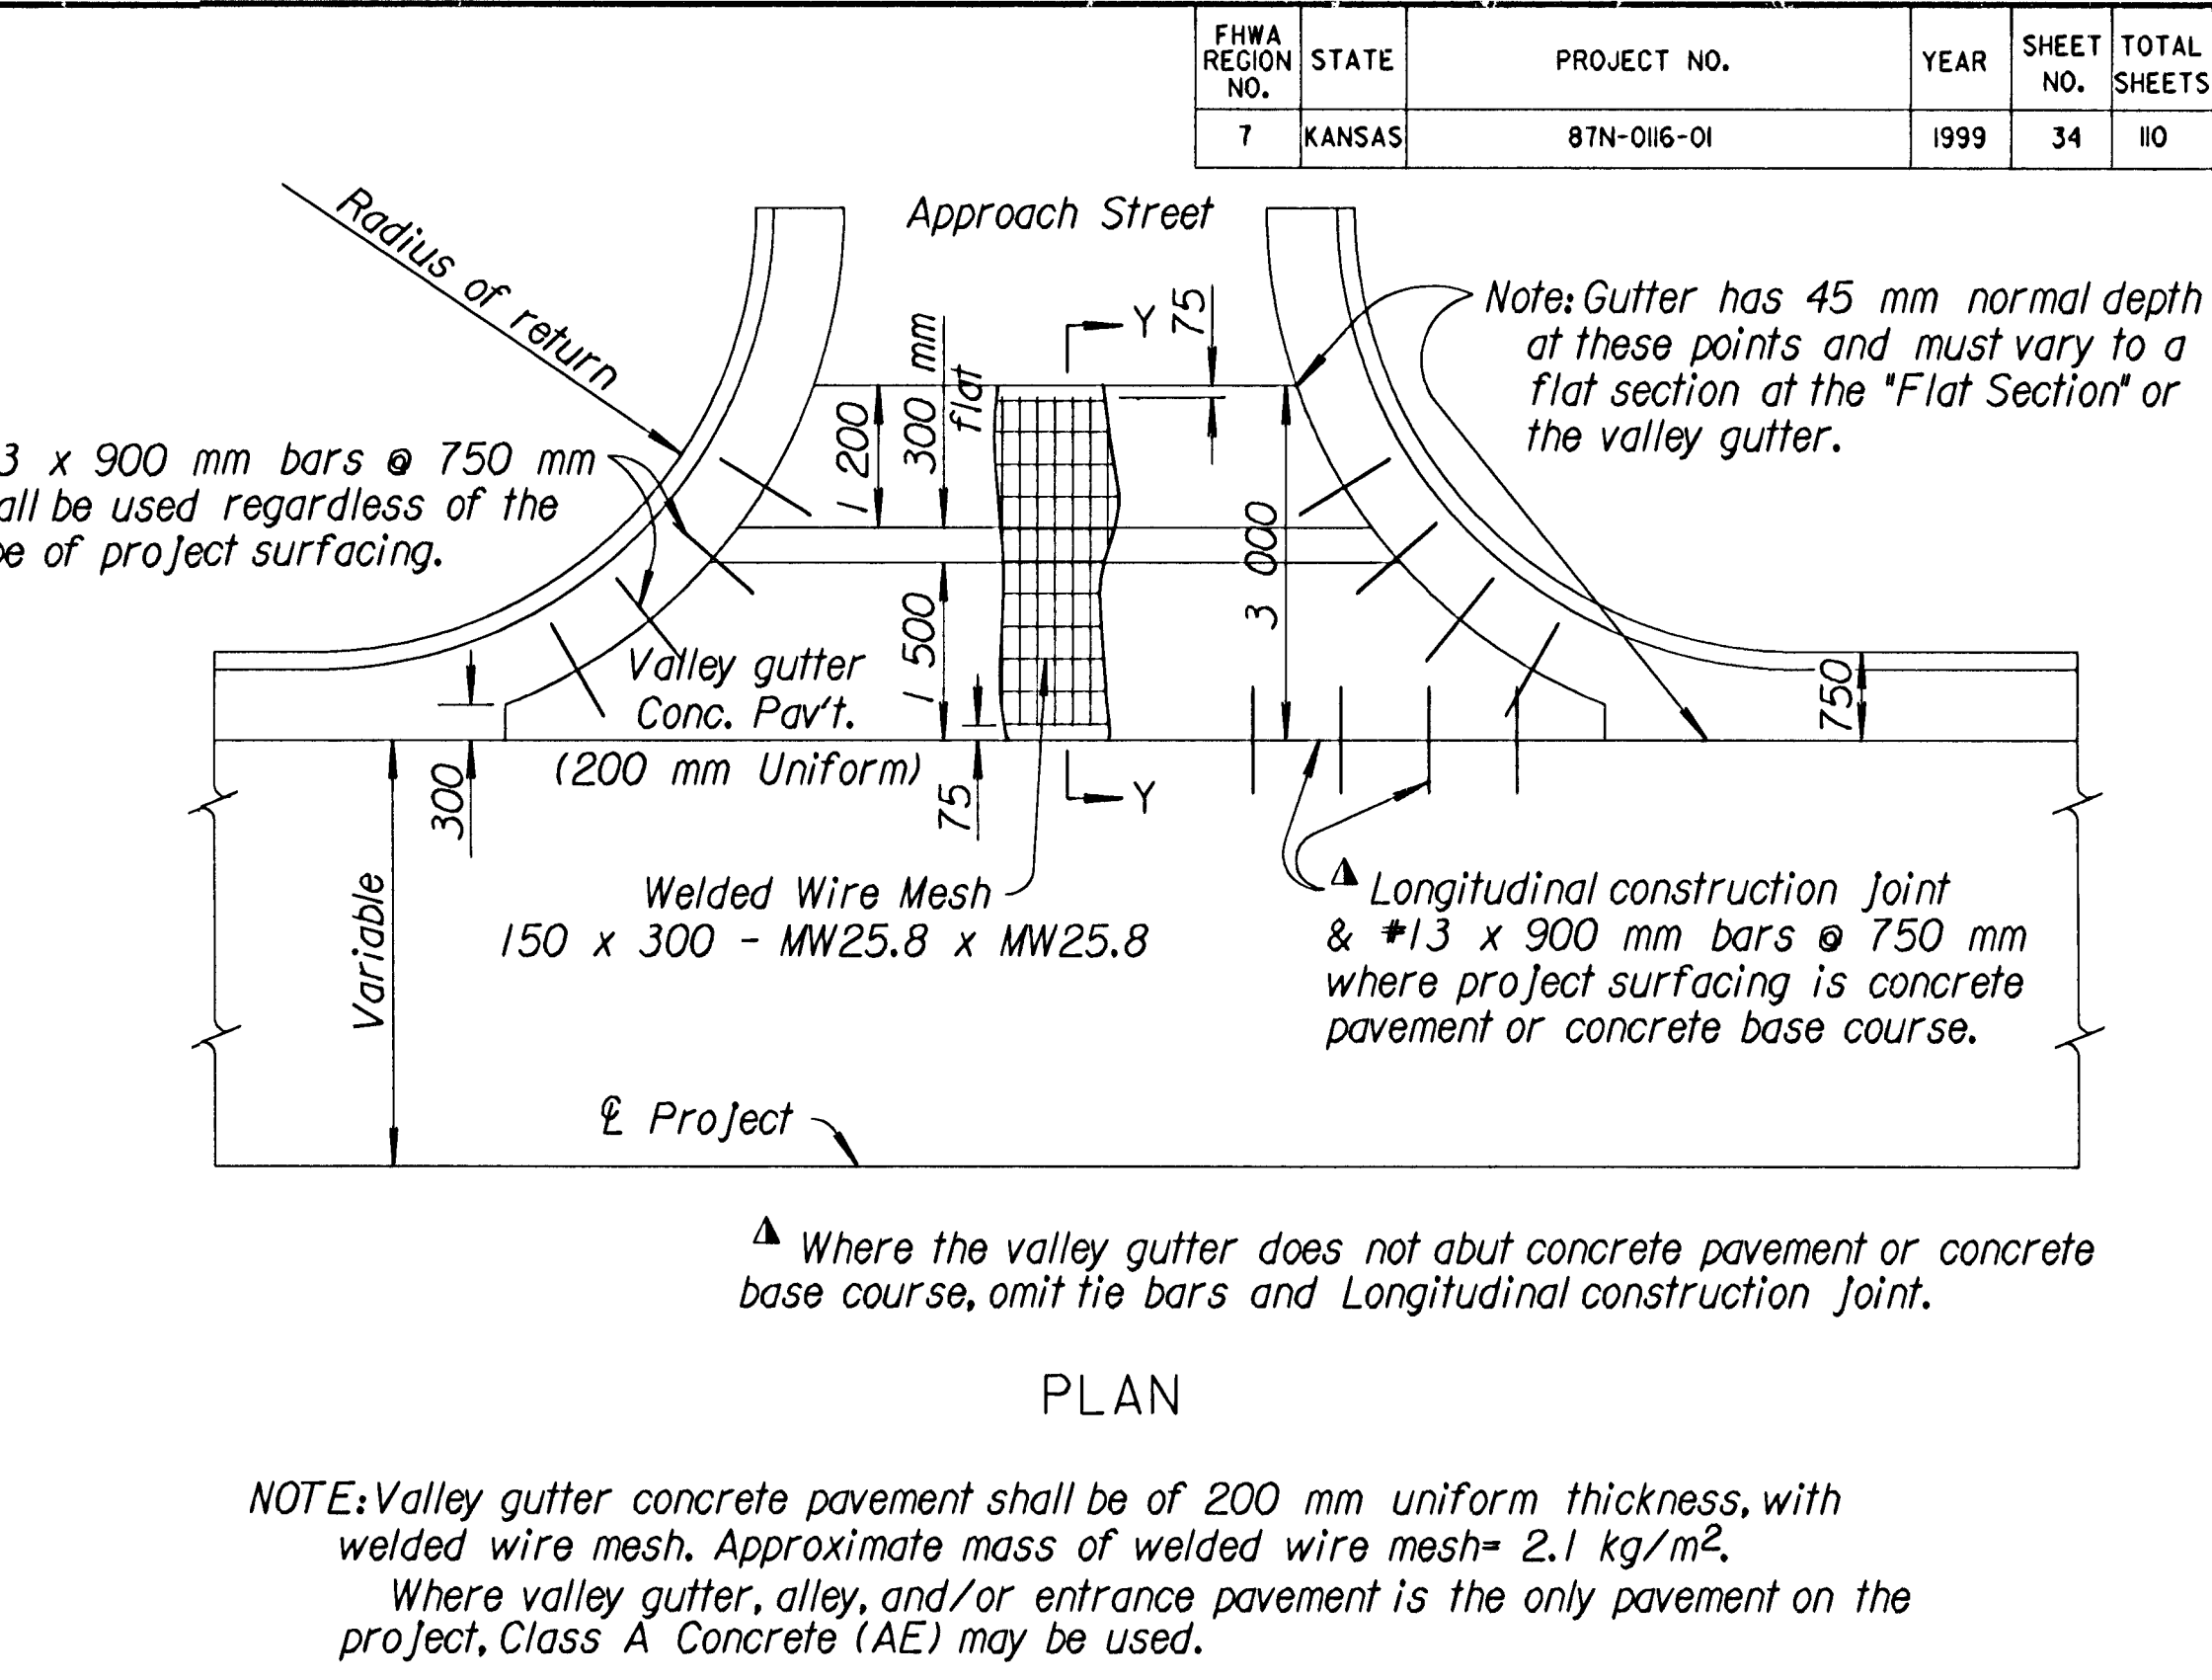
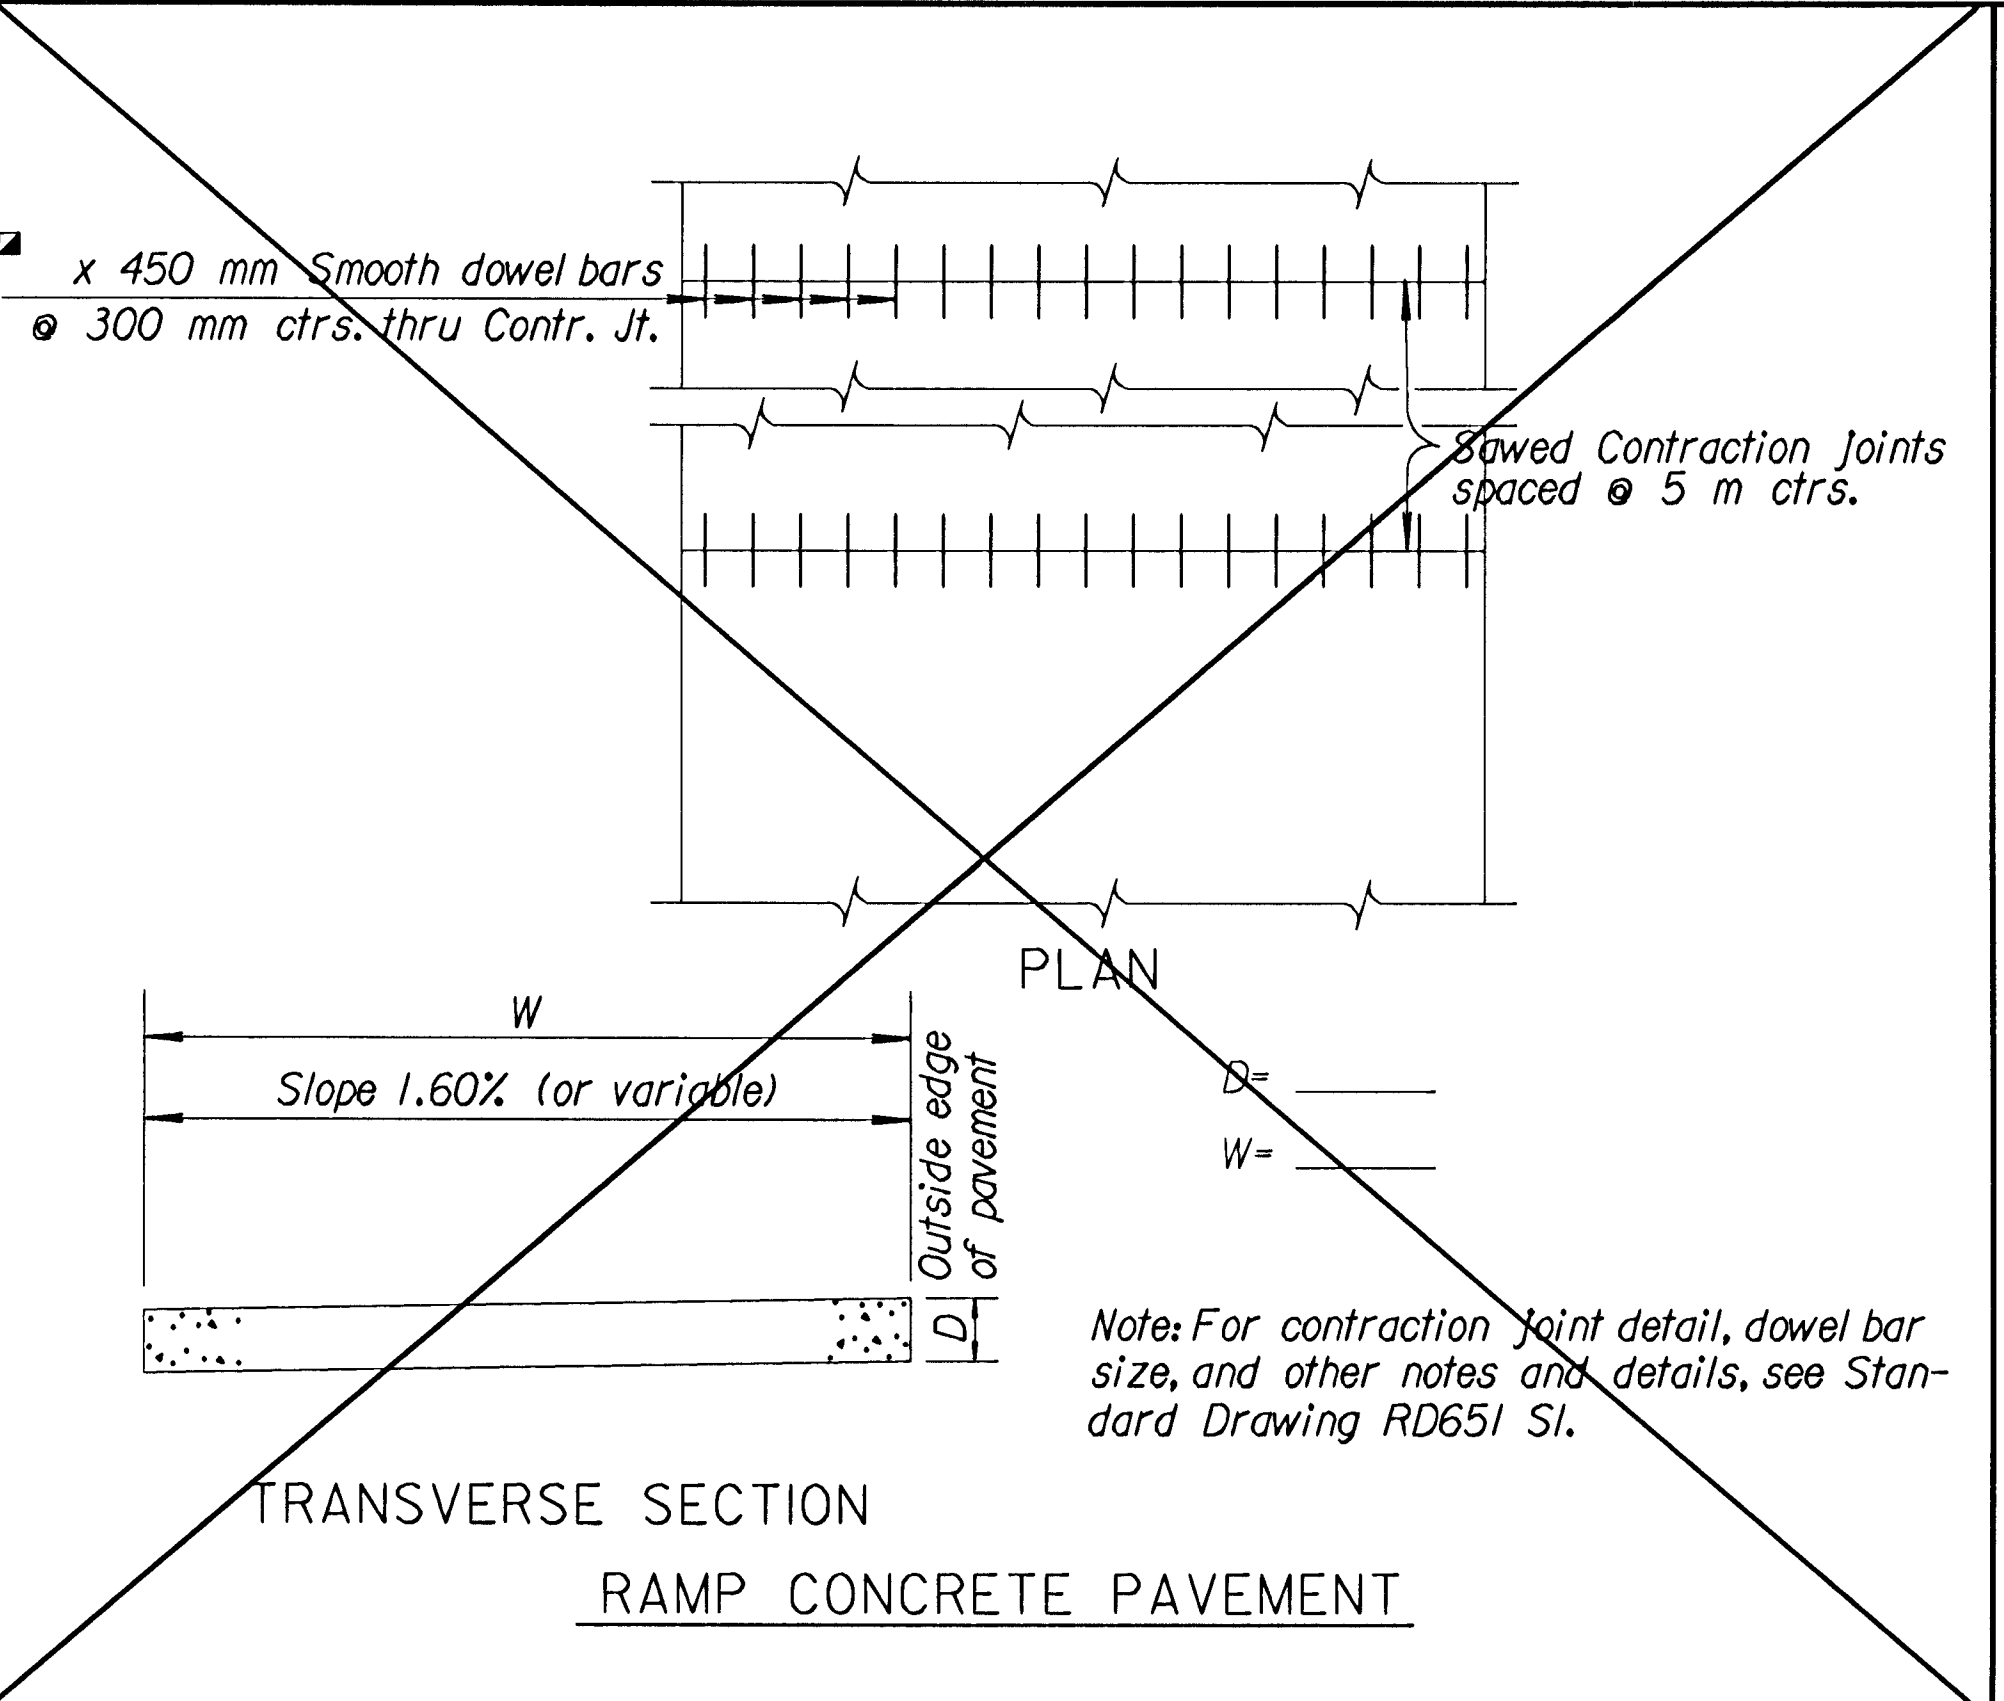


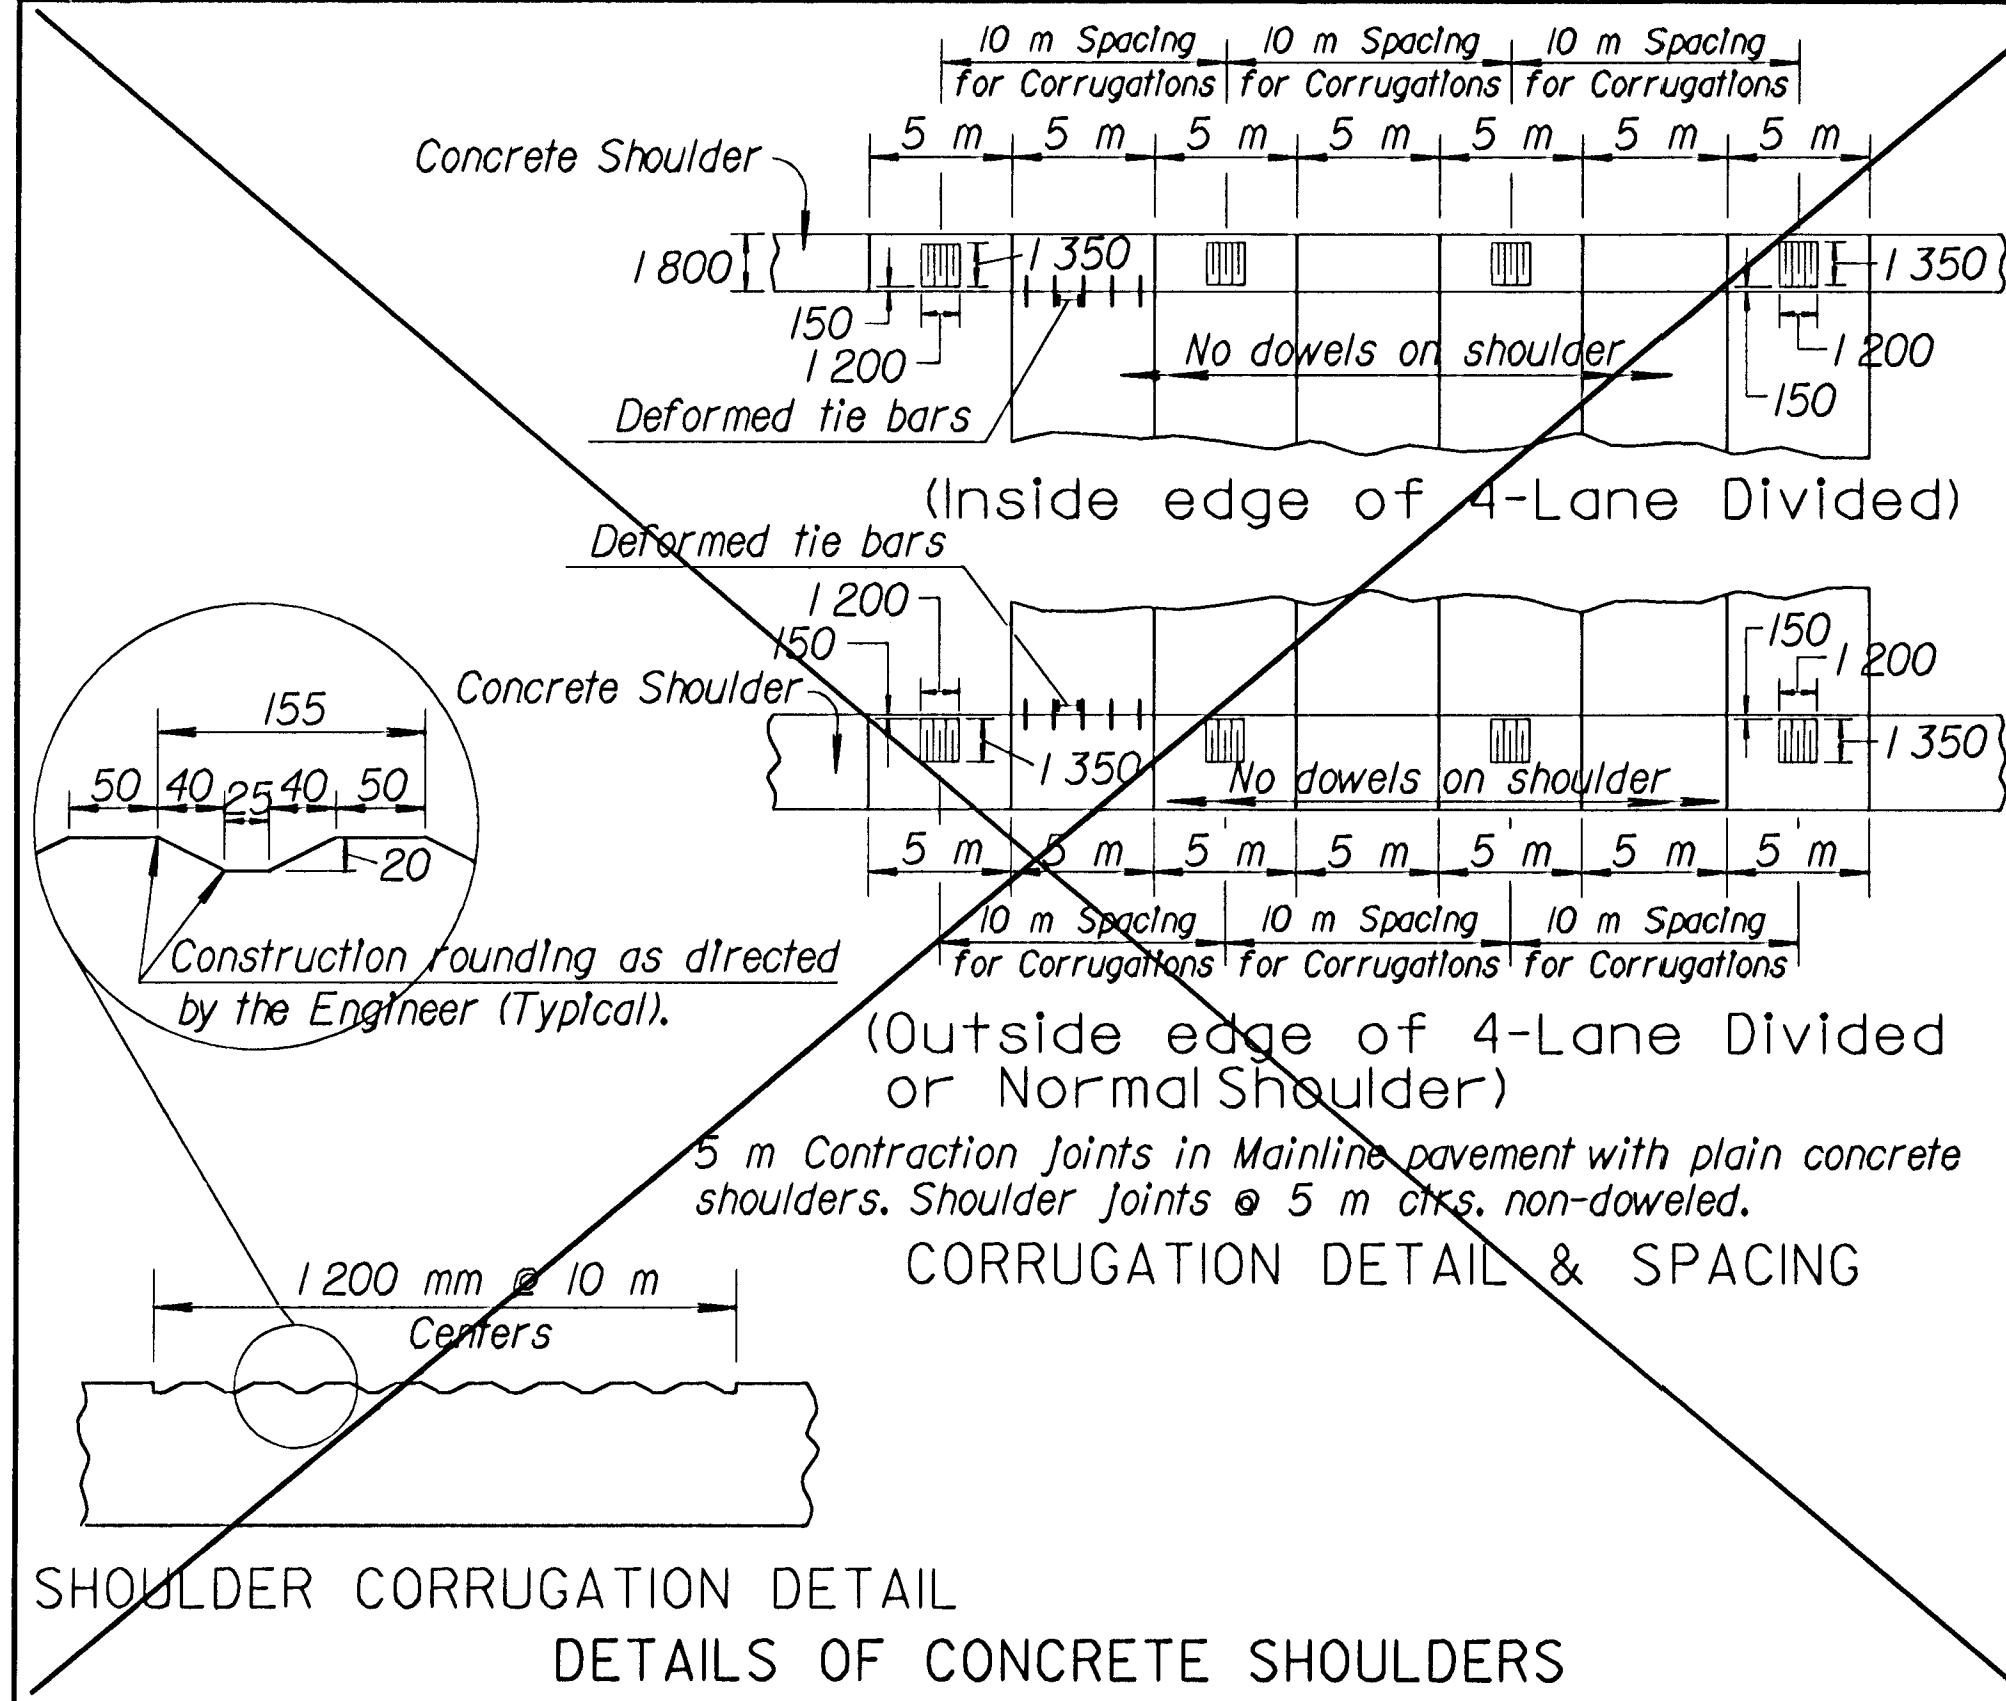

Drawn By: \$\$\$\$ USERNAME \$\$\$ Plotted: \$\$\$\$ SYTIME \$\$\$\$
 File: \$\$\$\$ DGN\$SPEC\$ \$\$\$\$