
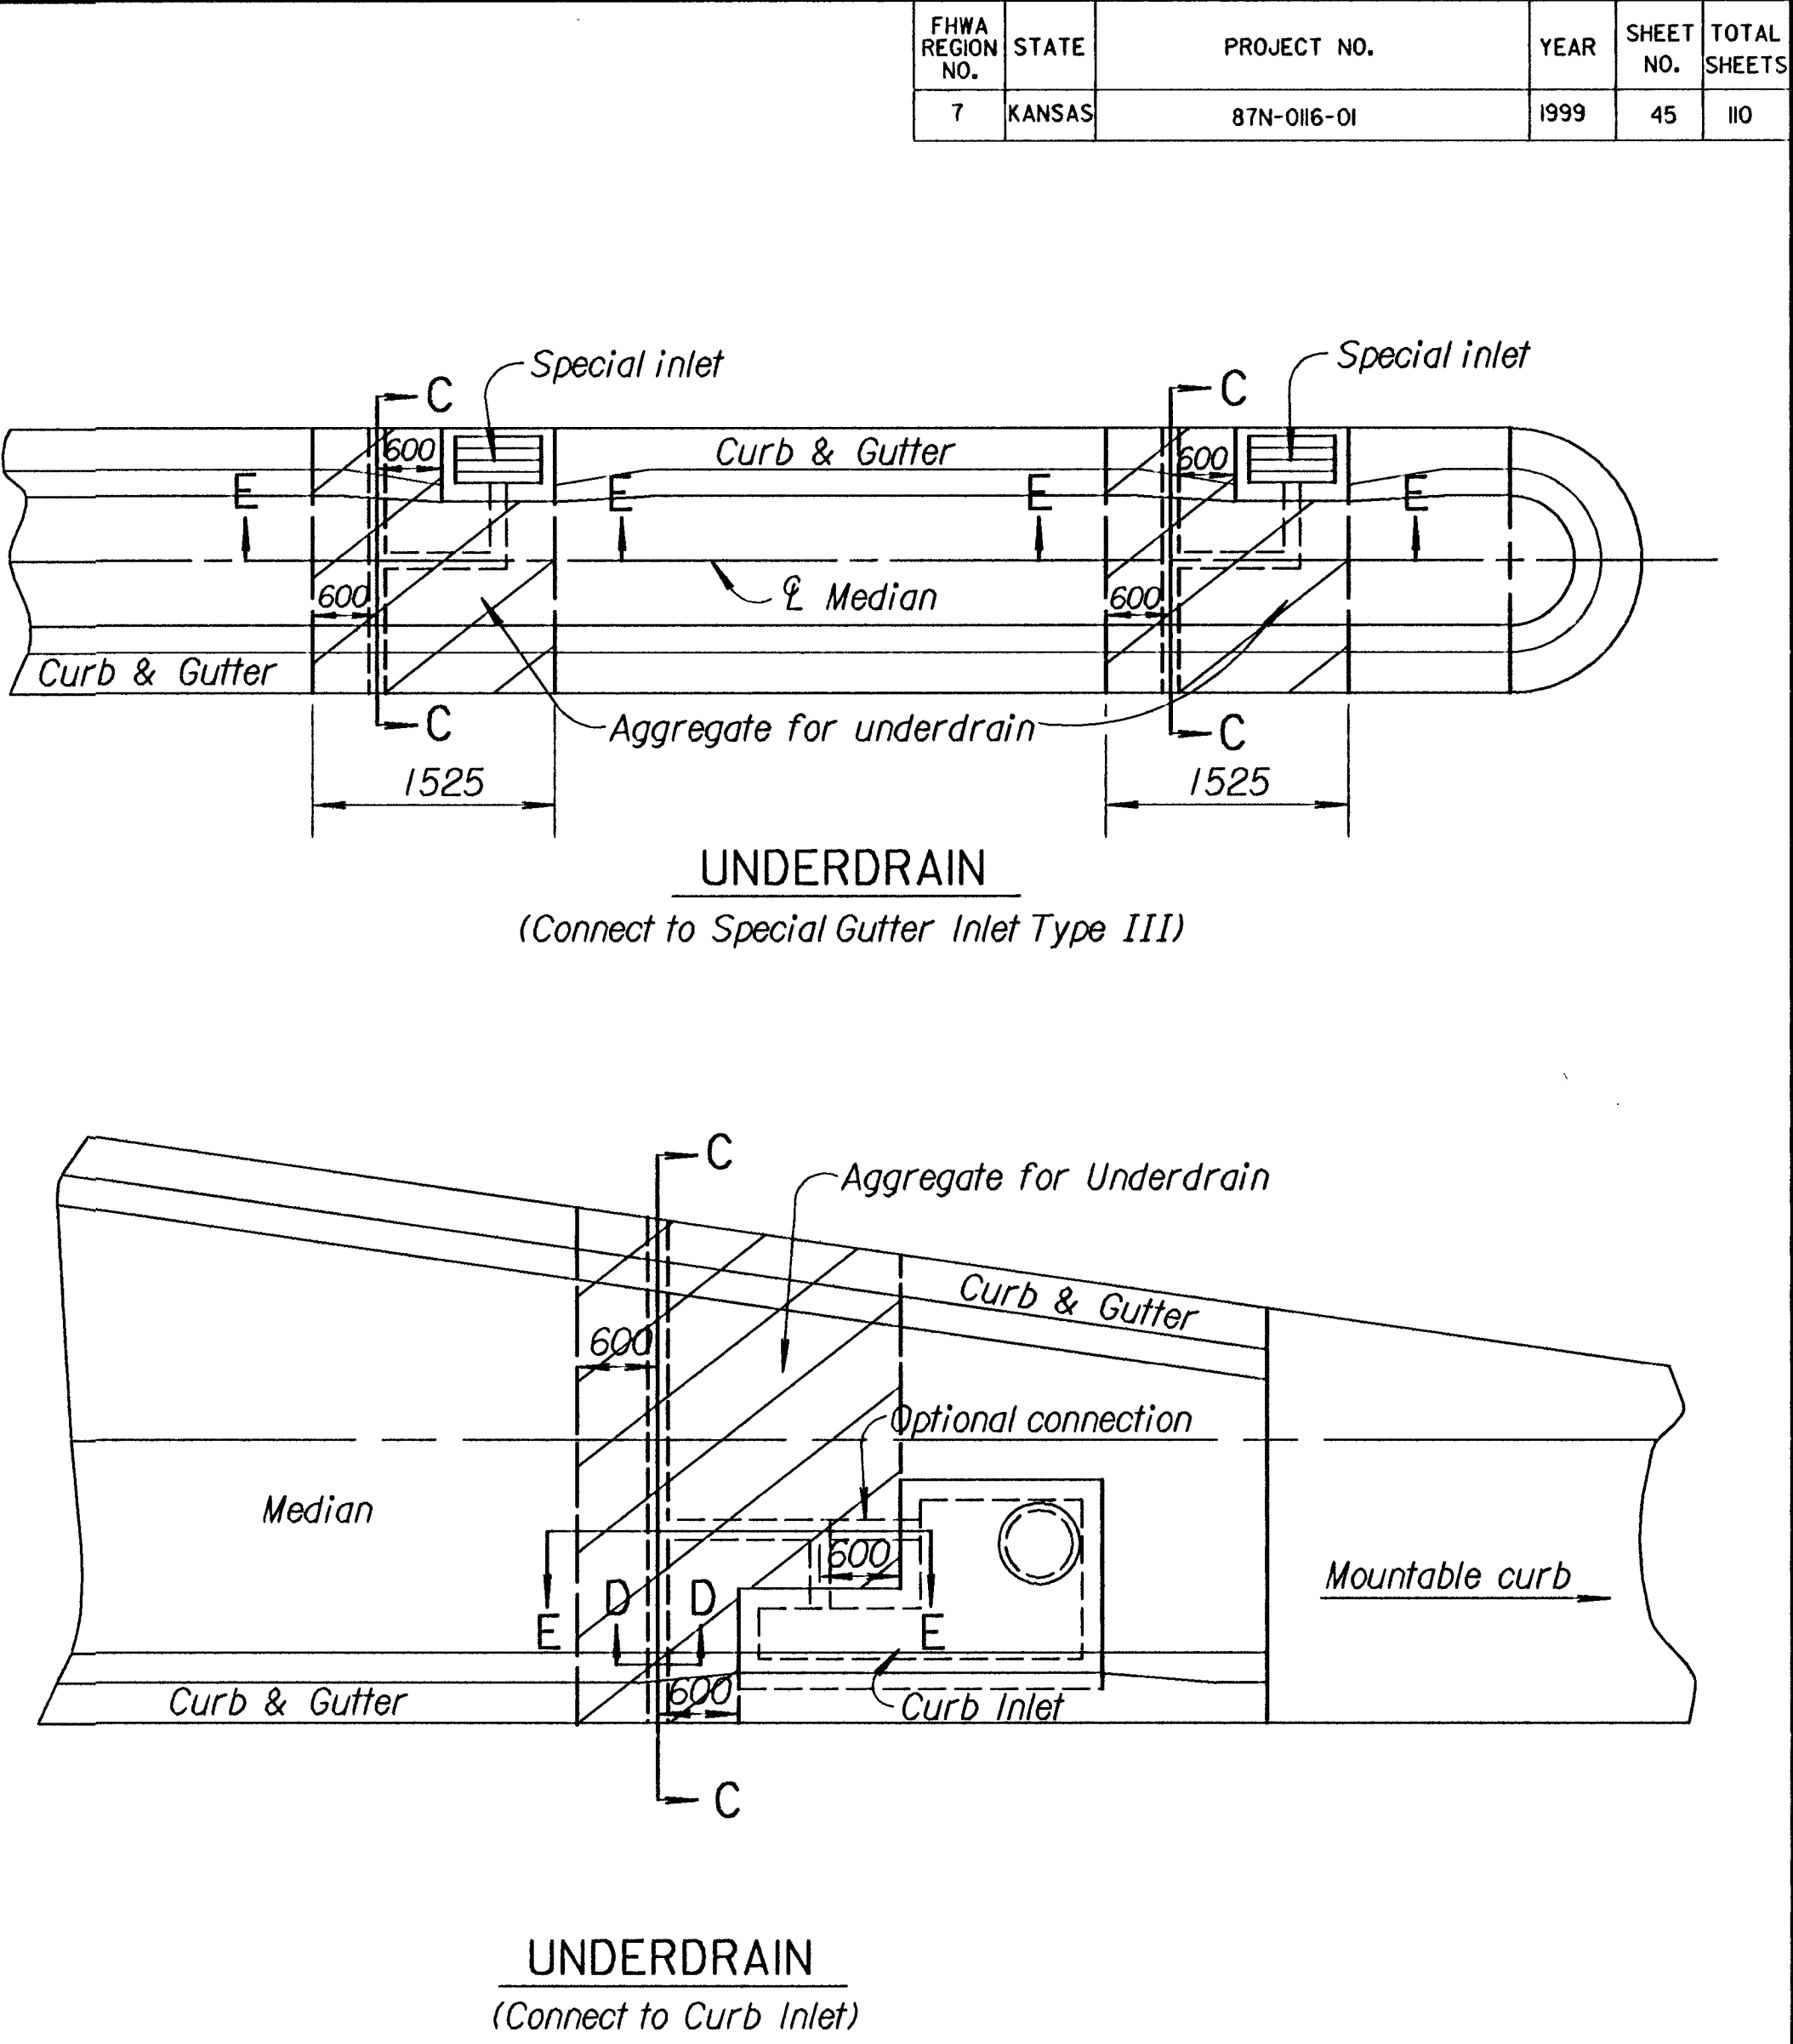
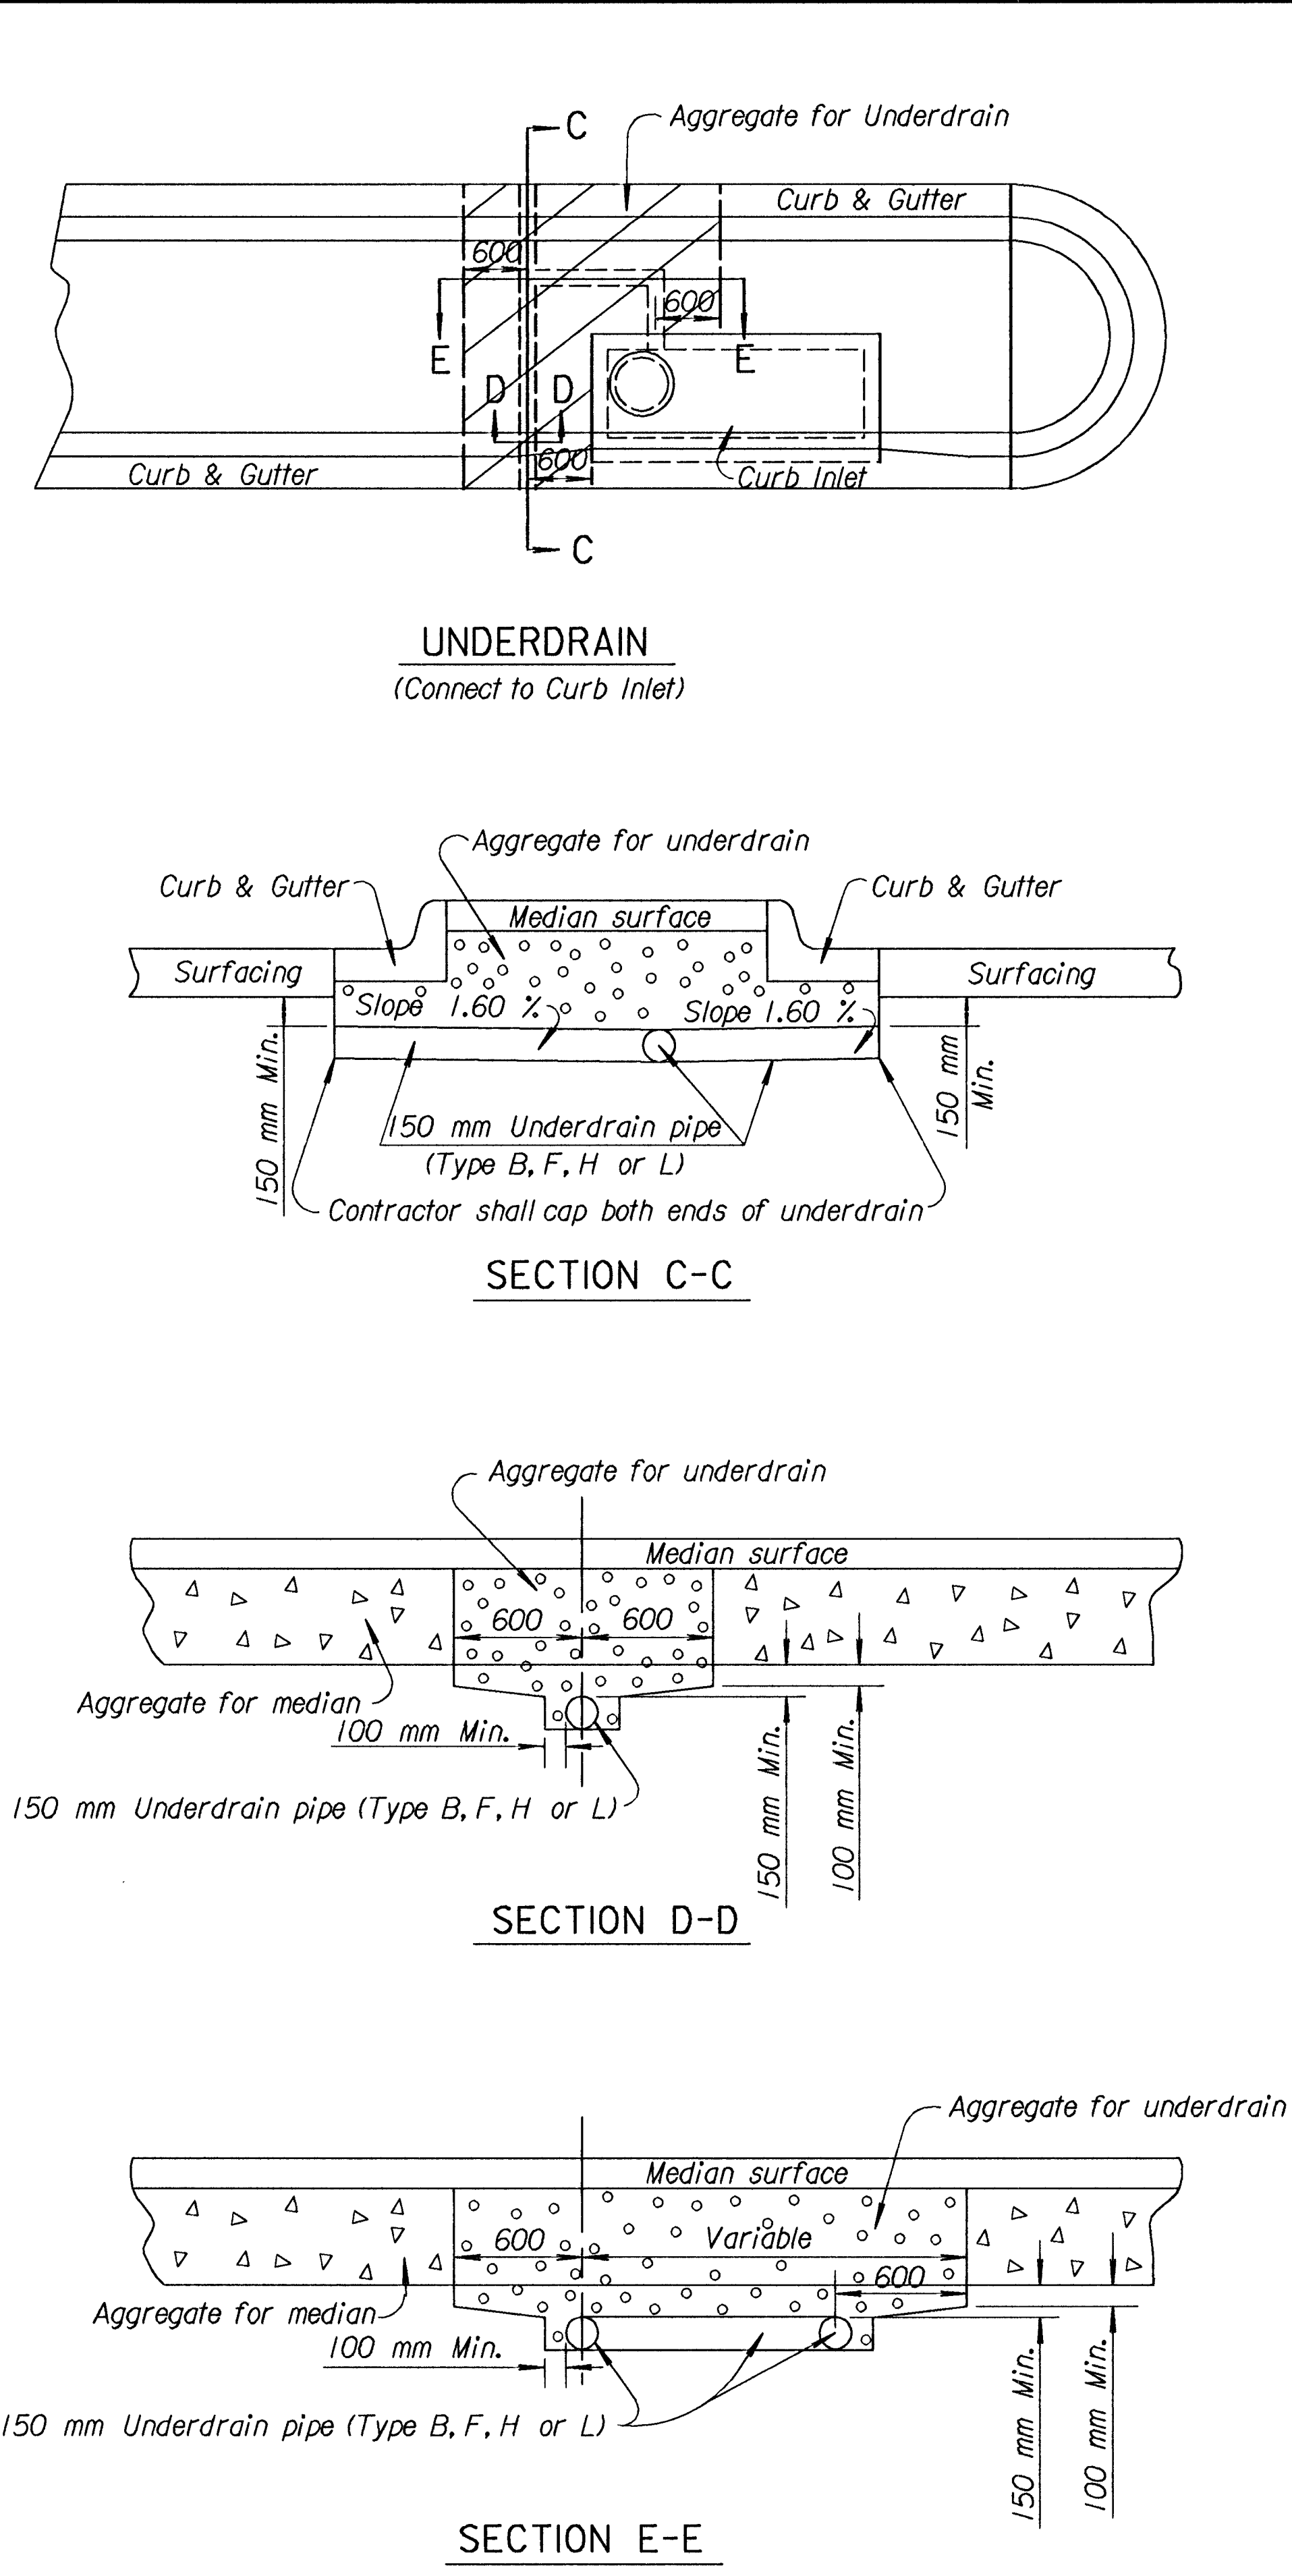
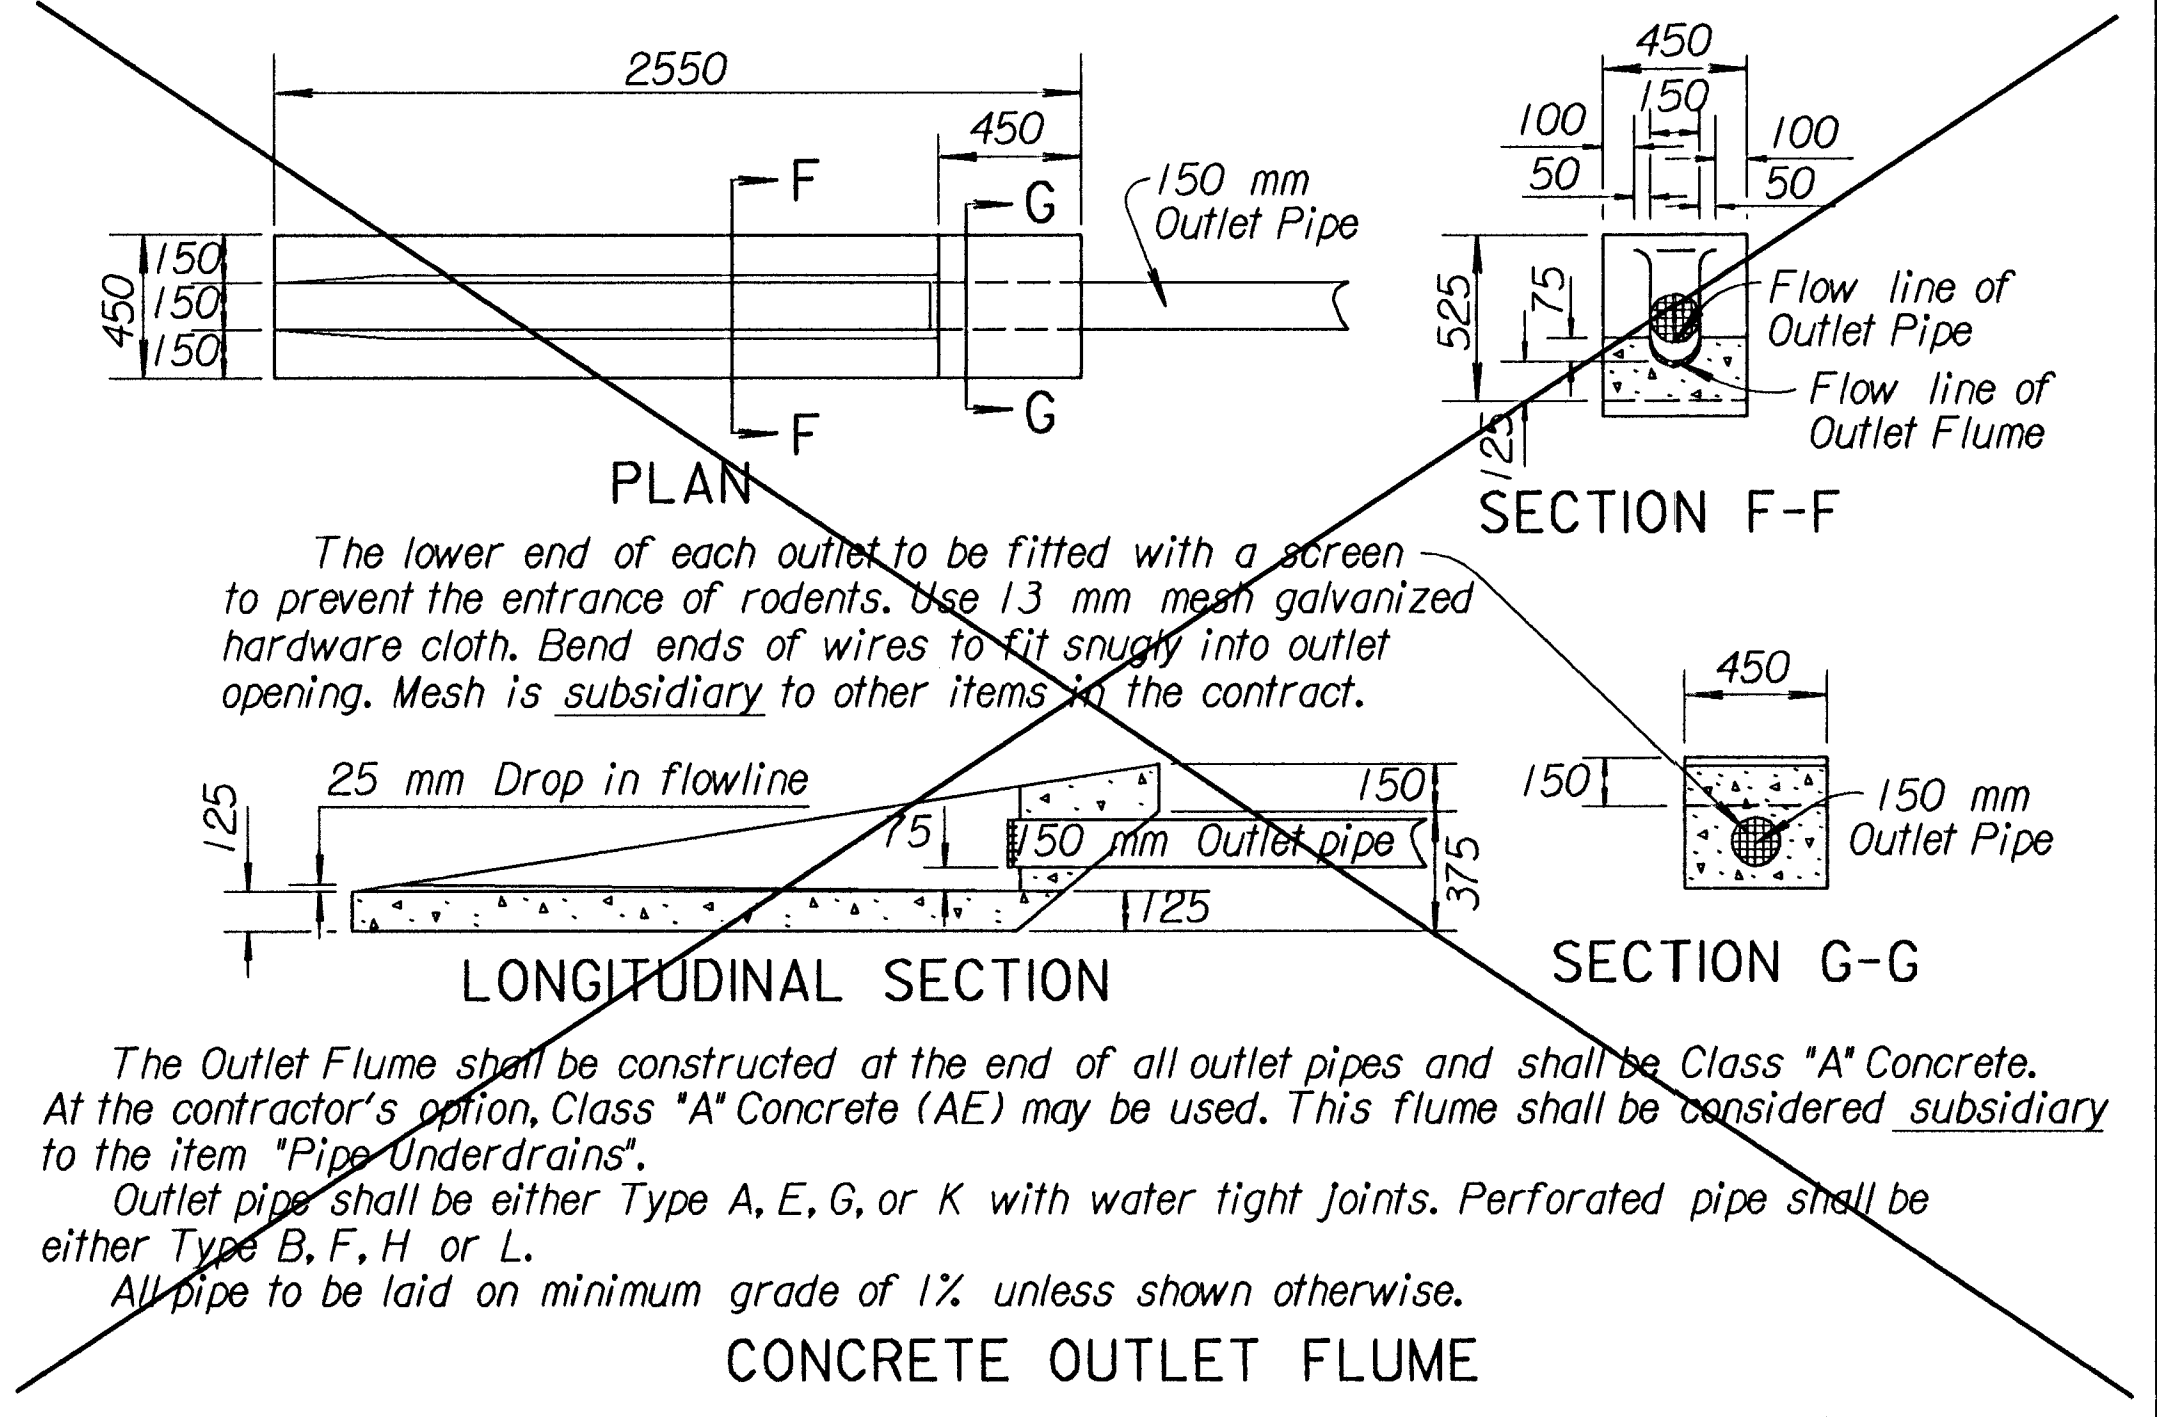


FHWA REGION NO.	STATE	PROJECT NO.	YEAR	SHEET NO.	TOTAL SHEETS
7	KANSAS	87N-0116-01	1999	45	110

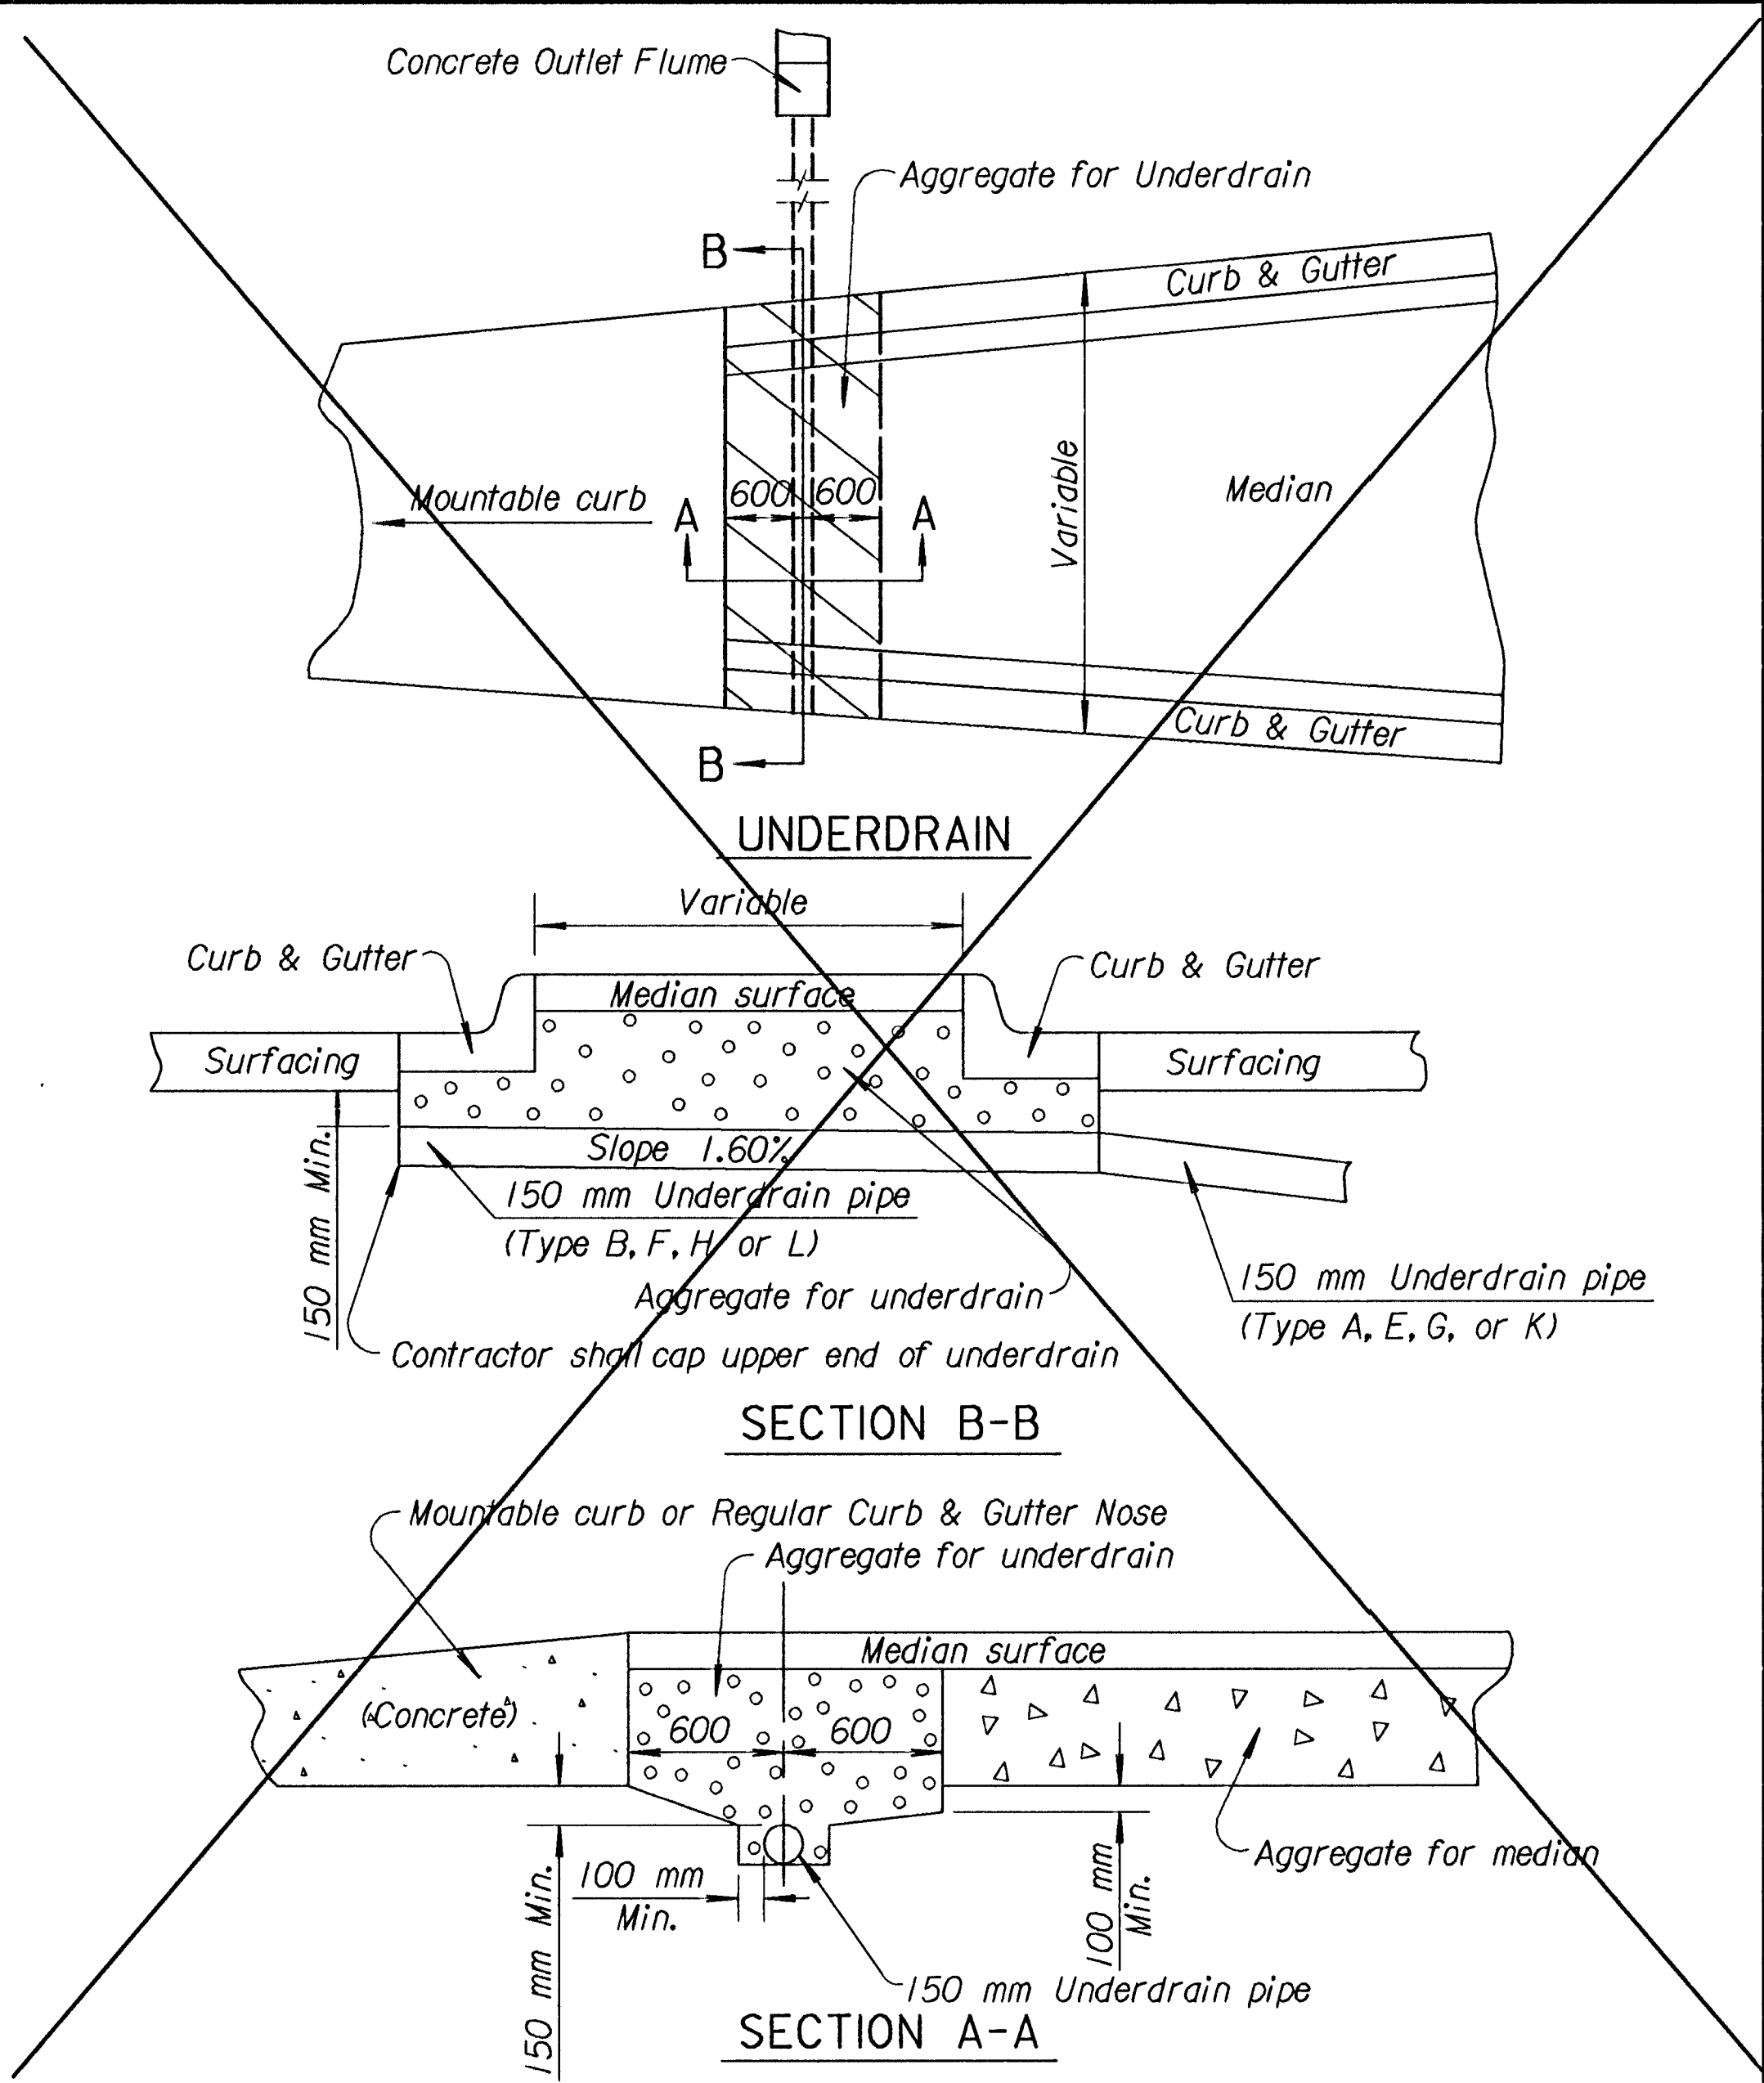

GENERAL NOTE:

The aggregate for underdrains shall be subsidiary to the bid item "Pipe Underdrains".

The bid item "Pipe Underdrains" shall be paid for by the linear foot.

Any excavation necessary for installation of pipe and aggregate is subsidiary to the bid item "Pipe Underdrains".

All pipe to be laid on minimum grade of 1% unless shown otherwise.

3					
2					
1					
NO.	DATE	REVISIONS	BY	APP'D	
KANSAS DEPARTMENT OF TRANSPORTATION					
TYPICAL MEDIAN UNDERDRAINS					
RD 701-SI					
DESIGNED	9-20-94	APP'D	James O. Brewer		
DESIGN CK.	DETAIL CK.	QUANTITIES	TRACED	Bowser	
		QUAN.CK.	TRACE CK.	Seltz	