FHWA REGION NO.	STATE	PROJECT NO.	FISCAL YEAR	SHEET NO.	TOTAL SHEETS
7	KANSAS	87-N-0225-01	2002	32	47

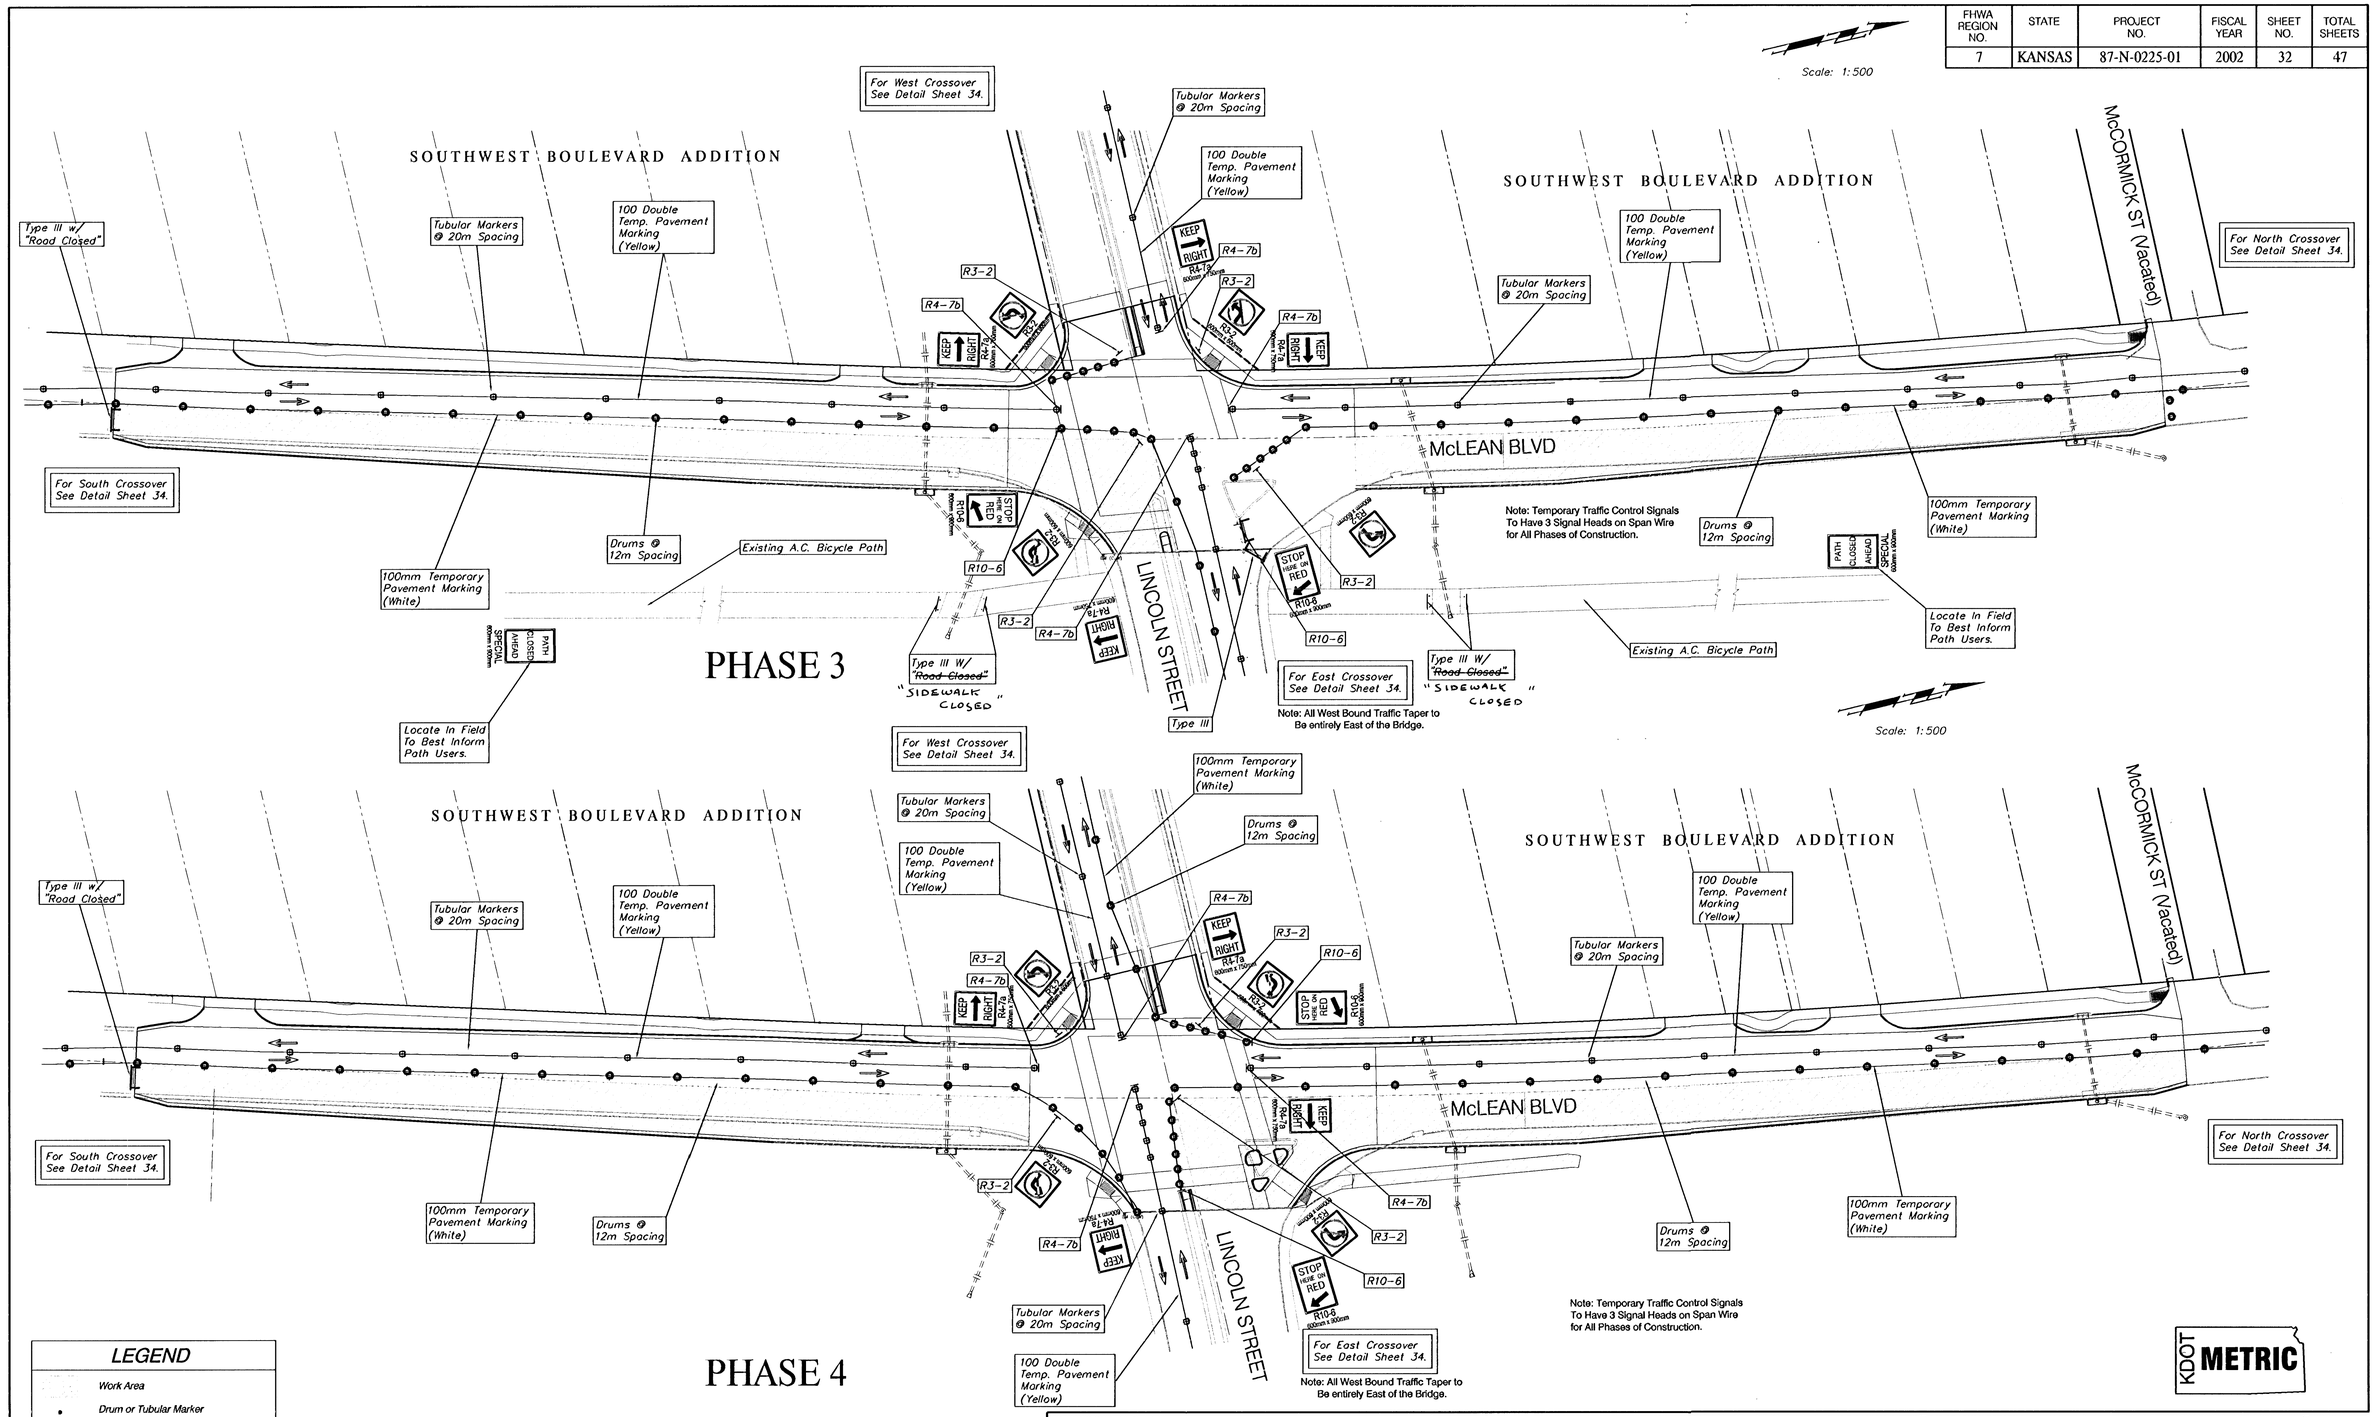

PROJECT NUMBER	SHEET NAME	ENGINEERING DIRECTORY
472-83799	Conseq02	F:\\LinMcln\Conseq

DESIGN	DRAWN	APPROVED	DATE	SCALE	BAUGHMAN NO
JFB	KWR	JFB	July 2003	1:500 SI	01-03-E944

CAPITAL IMPROVEMENT PROJECT

CONSTRUCTION SEQUENCING

LINCOLN AND MCLEAN INTERSECTION IMPROVEMENTS

BAUGHMAN COMPANY, P.A.
ENGINEERING, SURVEYING, & PLANNING
316-262-7271 • 315 ELLIS • WICHITA, KANSAS 67211