
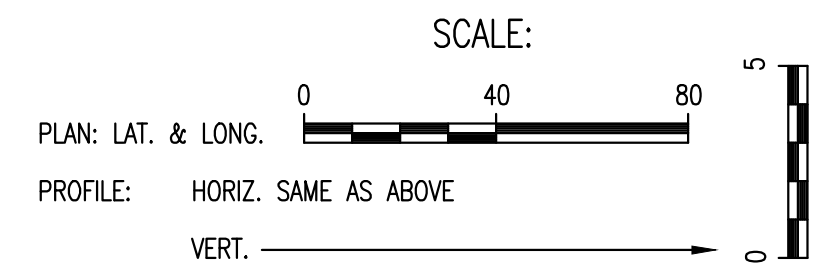


PLAN	CHECKED	DATE
	CHECKED	

PROFILE	CHECKED	DATE
	CHECKED	



Served 04-24-2012 9:33:18 AM by CSI
 Plot Scale 1:40 06-01-2012 11:30:44 AM by ROB F. JOHNSON
 G:\2011\1339\002\1339-002-SSPP02

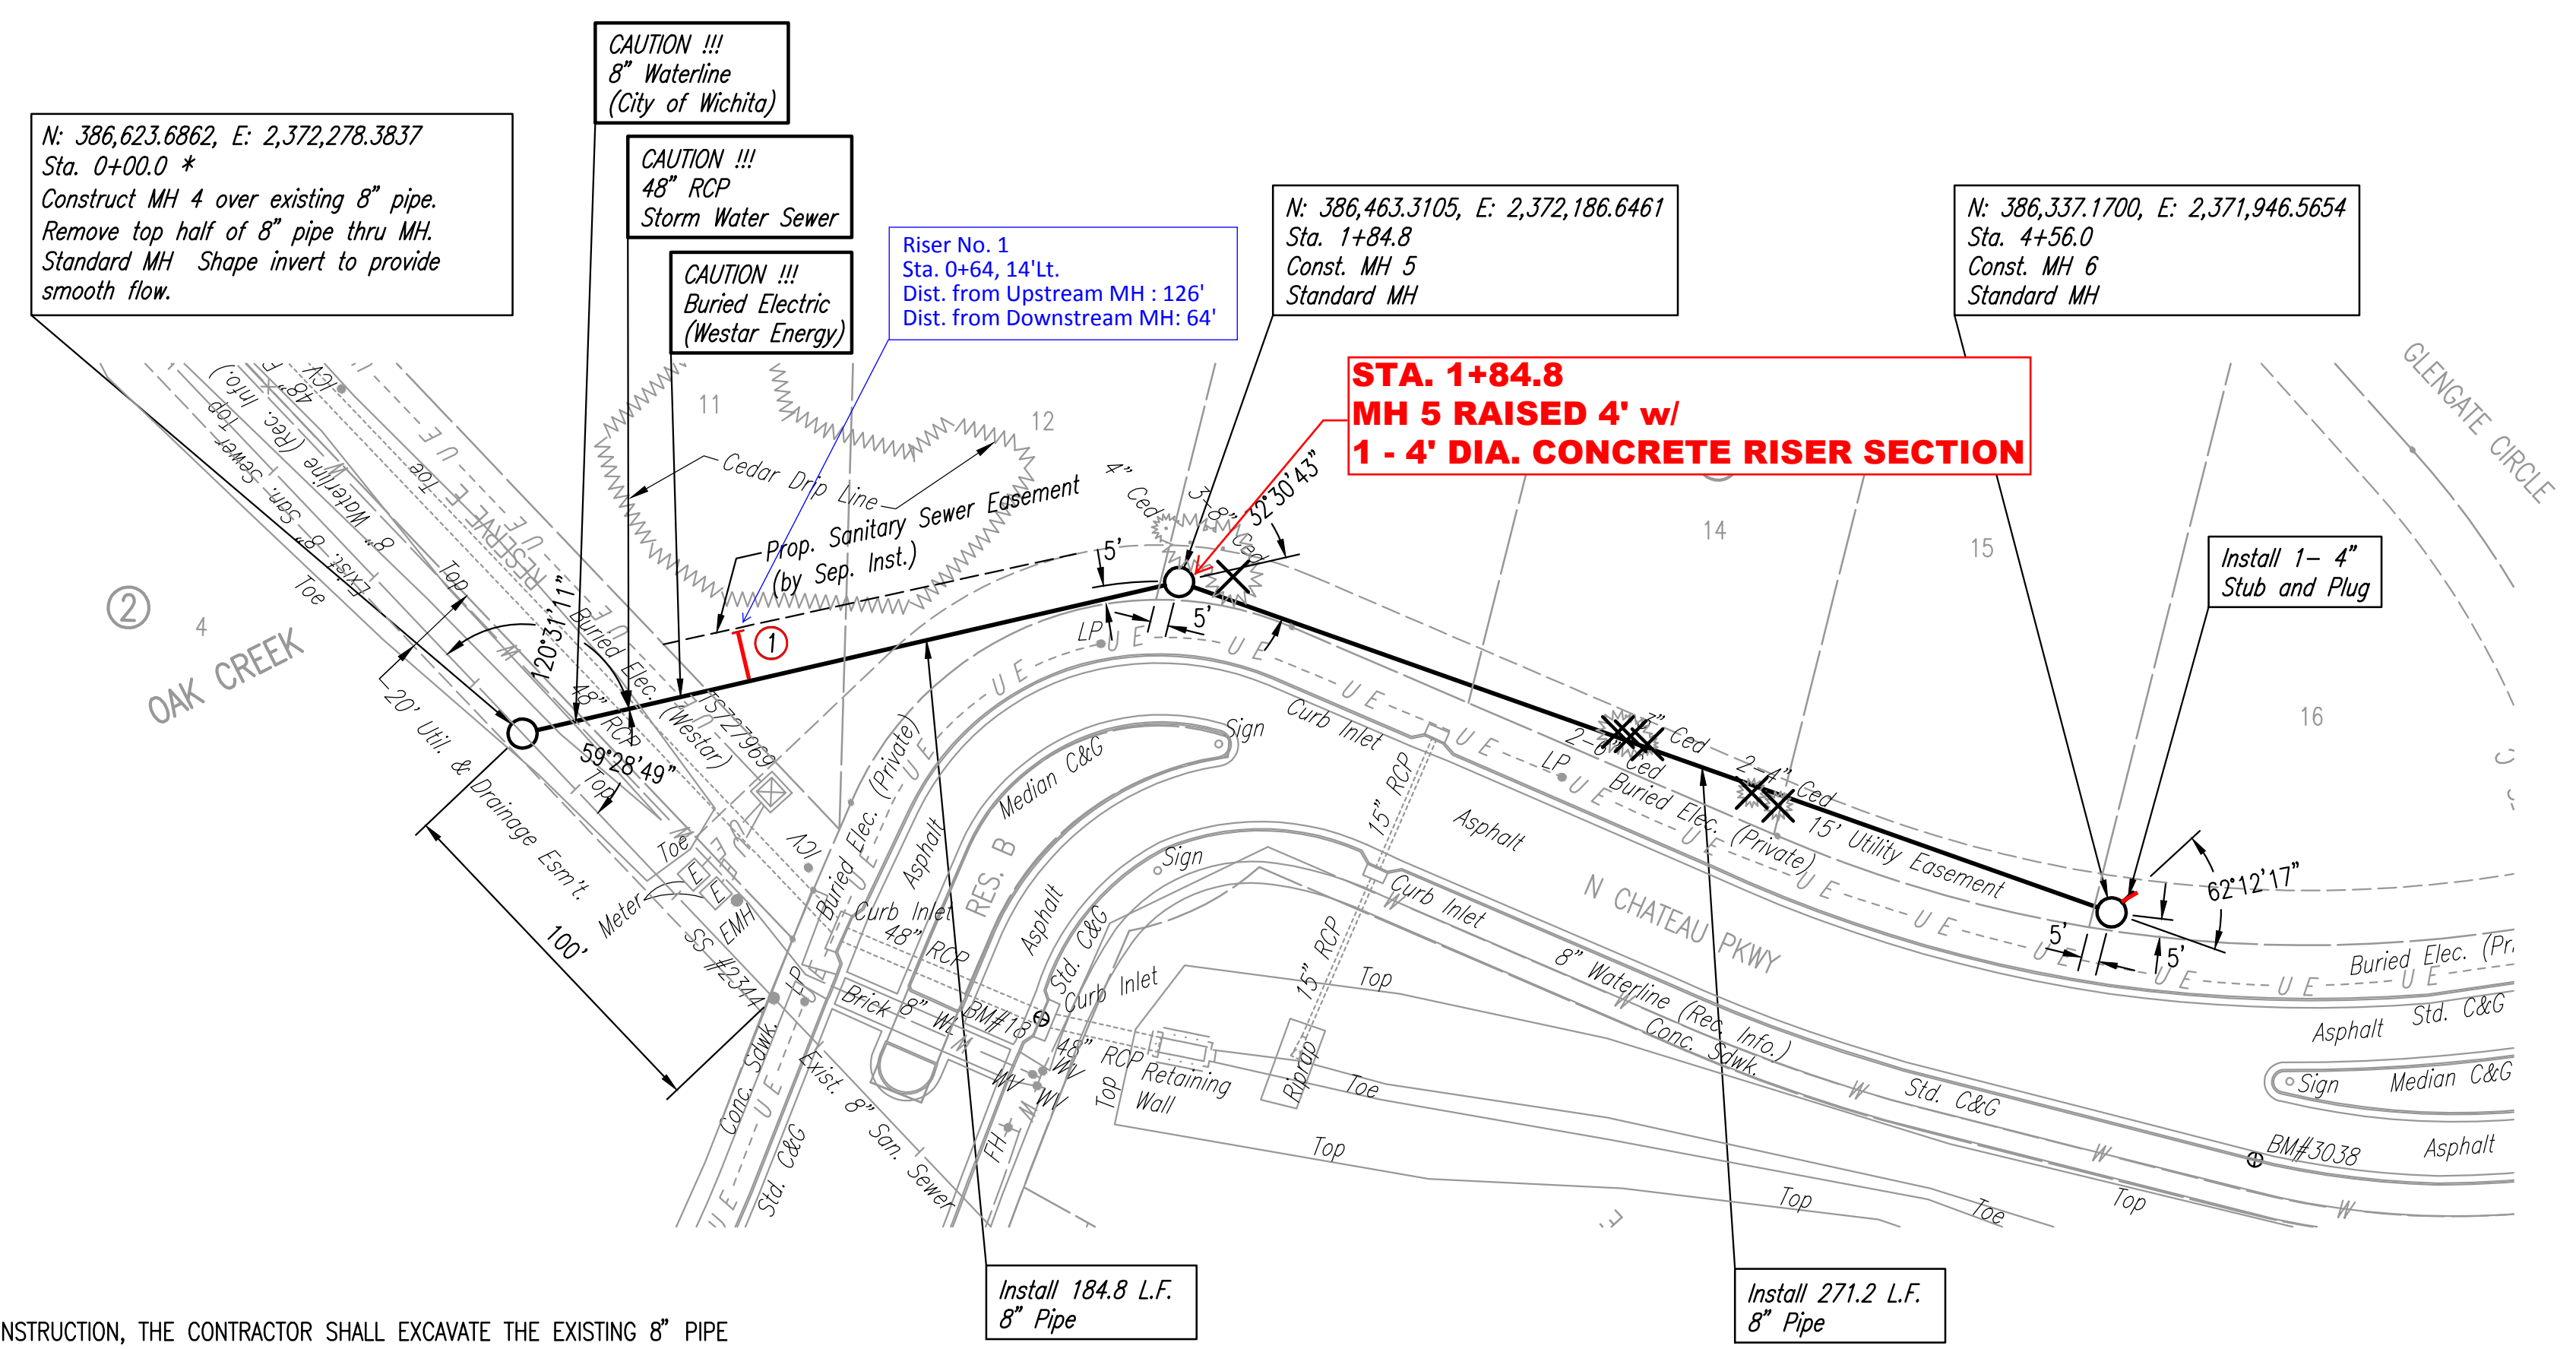

* PRIOR TO BEGINNING CONSTRUCTION, THE CONTRACTOR SHALL EXCAVATE THE EXISTING 8" PIPE AT SANITARY SEWER STATION 0+00.0 TO VERIFY ITS HORIZONTAL AND VERTICAL LOCATION. THE PIPE LOCATION SHALL BE REPORTED TO THE ENGINEER SO THAT ANY NECESSARY PLAN MODIFICATIONS CAN BE MADE. ANY ADDITIONAL LABOR OR MATERIALS NECESSARY TO COMPLETE THE CONNECTION SHALL BE CONSIDERED SUBSIDIARY TO THE PROJECT.

SANITARY SEWER LINE NO. 2

✕ - Denotes Tree to be removed.

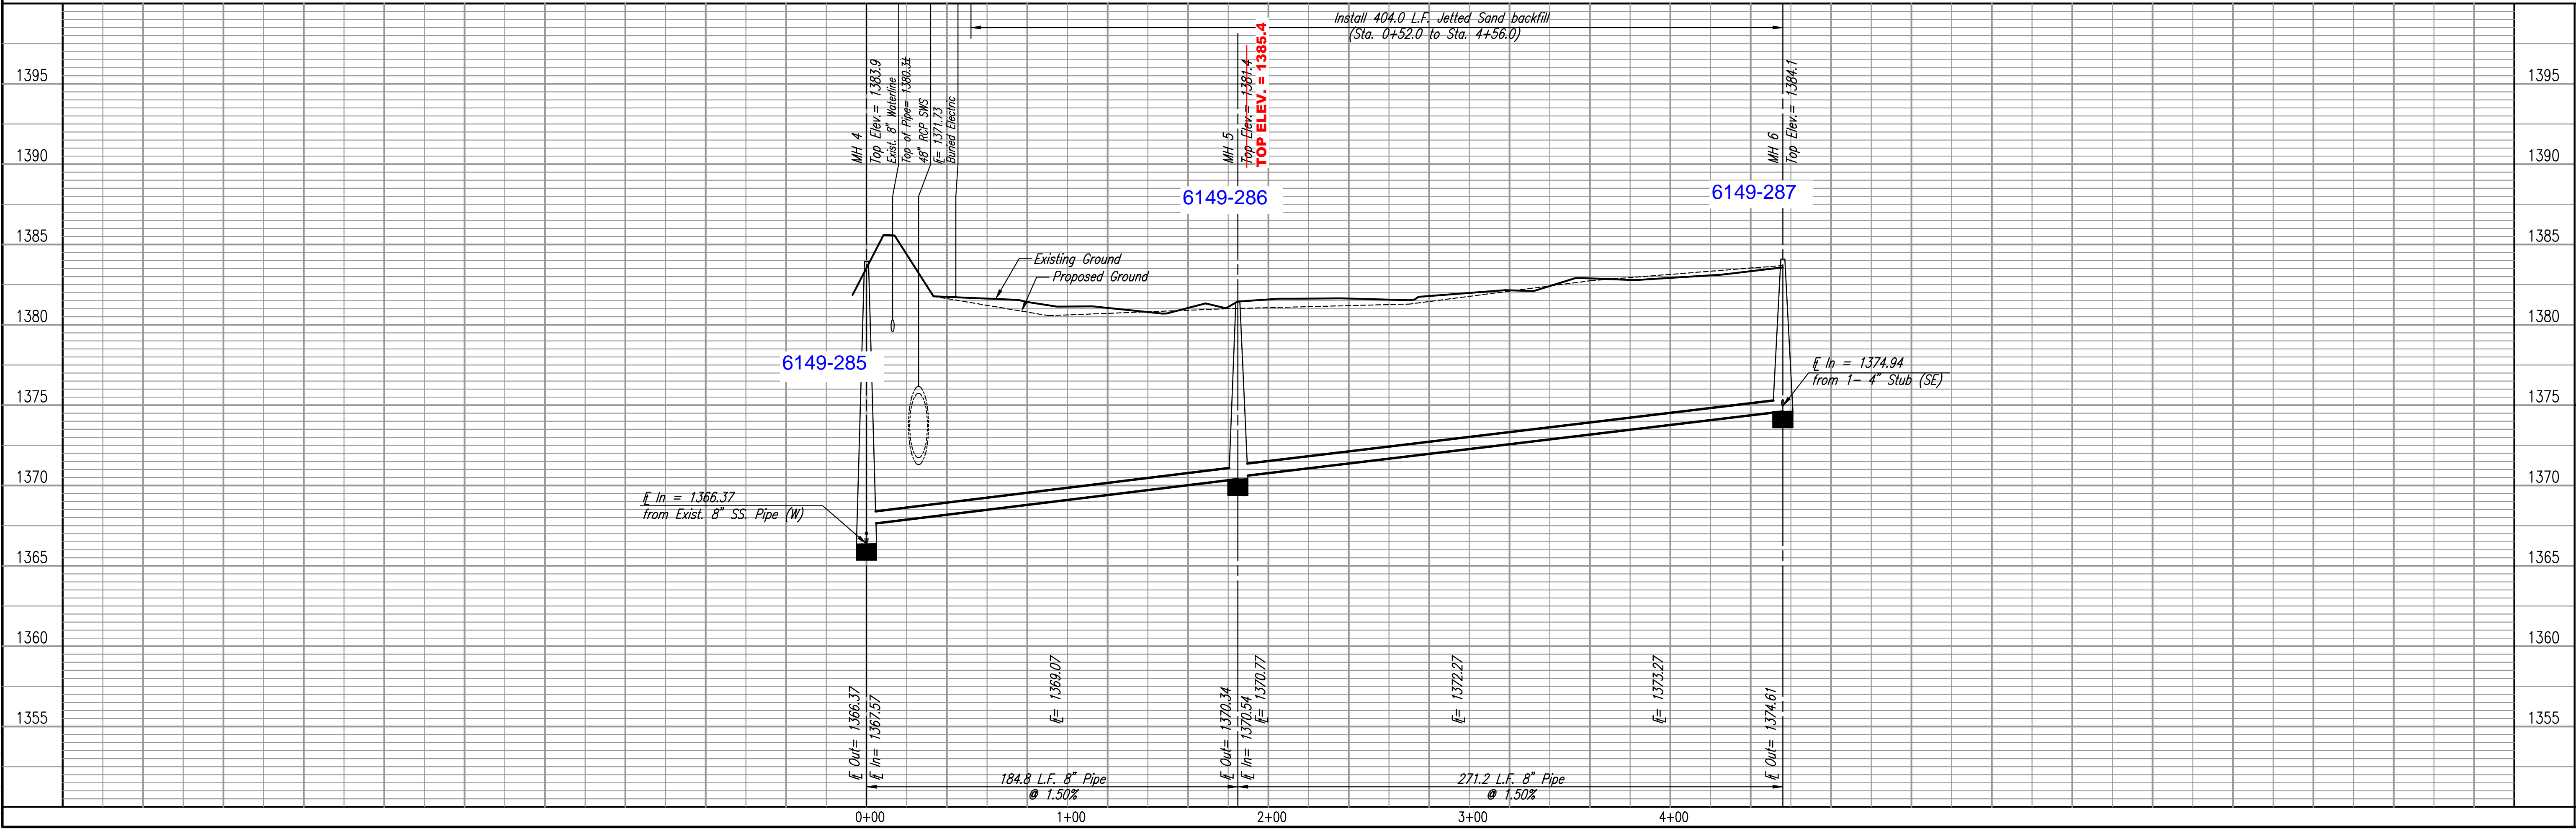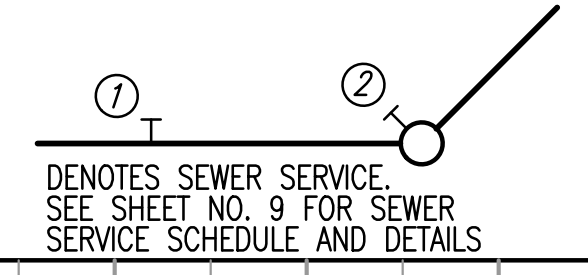

LATERAL 13, MAIN 16
 OF THE FOUR MILE CREEK INTERCEPTOR
SANITARY SEWER LINE NO. 2
 GARY JANZEN, P.E. - INTERIM CITY ENGINEER
 CITY OF WICHITA PROJECT NO. 468-84818

PEC
 PROFESSIONAL ENGINEERING CONSULTANTS P.A.
 303 SOUTH TOPEKA WICHITA, KS 67202
 316-262-2691 www.pec1.com

Job No. 35-11339-001
 Date August 2011

Designed By MDK
 Drawn By JAN, CSL