




Point Table			
Point #	Northing	Easting	Description
7050	1709361.72	1625606.12	BACKYARD INLET
7051	1709429.00	1625723.24	END SECTION
7052	1709445.23	1625902.27	END SECTION
7053	1709288.76	1625905.59	TYPE 1A INLET
7054	1709247.44	1625906.47	TYPE 1A INLET
7055	1709205.74	1625911.60	END SECTION
7056	1708923.36	1625608.13	BACKYARD INLET
7057	1708928.30	1625723.08	TYPE 1A INLET
7058	1708929.09	1625760.40	TYPE 1A INLET
7059	1708929.56	1625900.42	END SECTION
7060	1708334.93	1625585.25	MANHOLE
7061	1708335.24	1625610.41	MANHOLE
7062	1708589.53	1625607.26	MANHOLE
7063	1708592.81	1625761.65	MANHOLE
7064	1708595.53	1625889.84	MANHOLE
7065	1708633.32	1625925.45	END SECTION
7066	1708605.83	1625759.53	TYPE 1A INLET
7100	1709577.25	1625627.04	CL

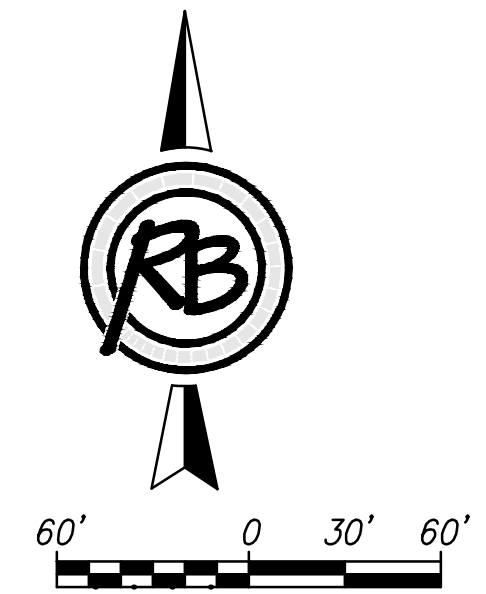

SIENA LAKES ADDITION PHASE 1 SWS Bubble Map				
SEAL	RUGGLES & BOHM		DATE 11-3-2015	
	ENGINEERING SURVEYING LANDSCAPE ARCHITECTURE GOVERNMENT 924 NORTH MAIN WICHITA, KANSAS 67203 P (316) 264-8008 F (316) 264-4621 WWW.RUGGLESANDBOHM.COM		DESIGN	
	PROJECT NUMBER 468-84971	RUGGLES & BOHM JOB NO. 4350E	DWG. SCALE ...	DRAWN
	DRAWING FILE Siena Lakes Eng Base [SWS Bubble Map]		REVIEW	SHEET 25
			OF 37	

(c) Copyright 2015, Ruggles & Bohm, P.A.