
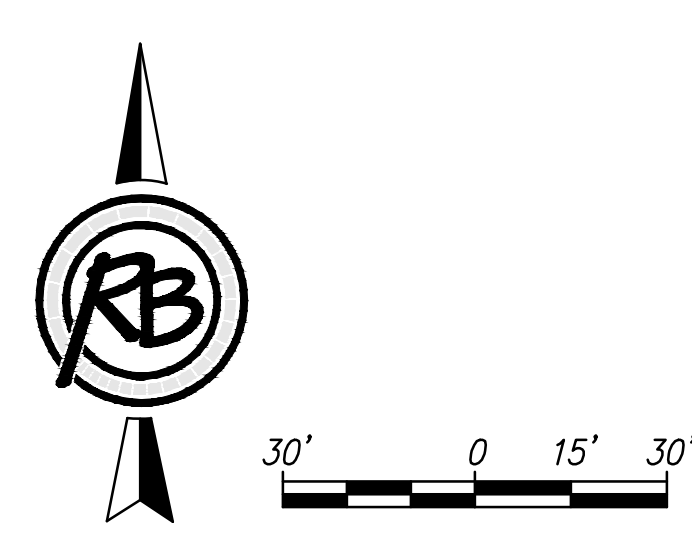



F:\Projects\Projects 4300-4399\4350E (Siena Lakes Ph 1 Engineering Randy Keltner)\Phase 1 - Joy Russell\Siena Lakes Eng Base.dwg

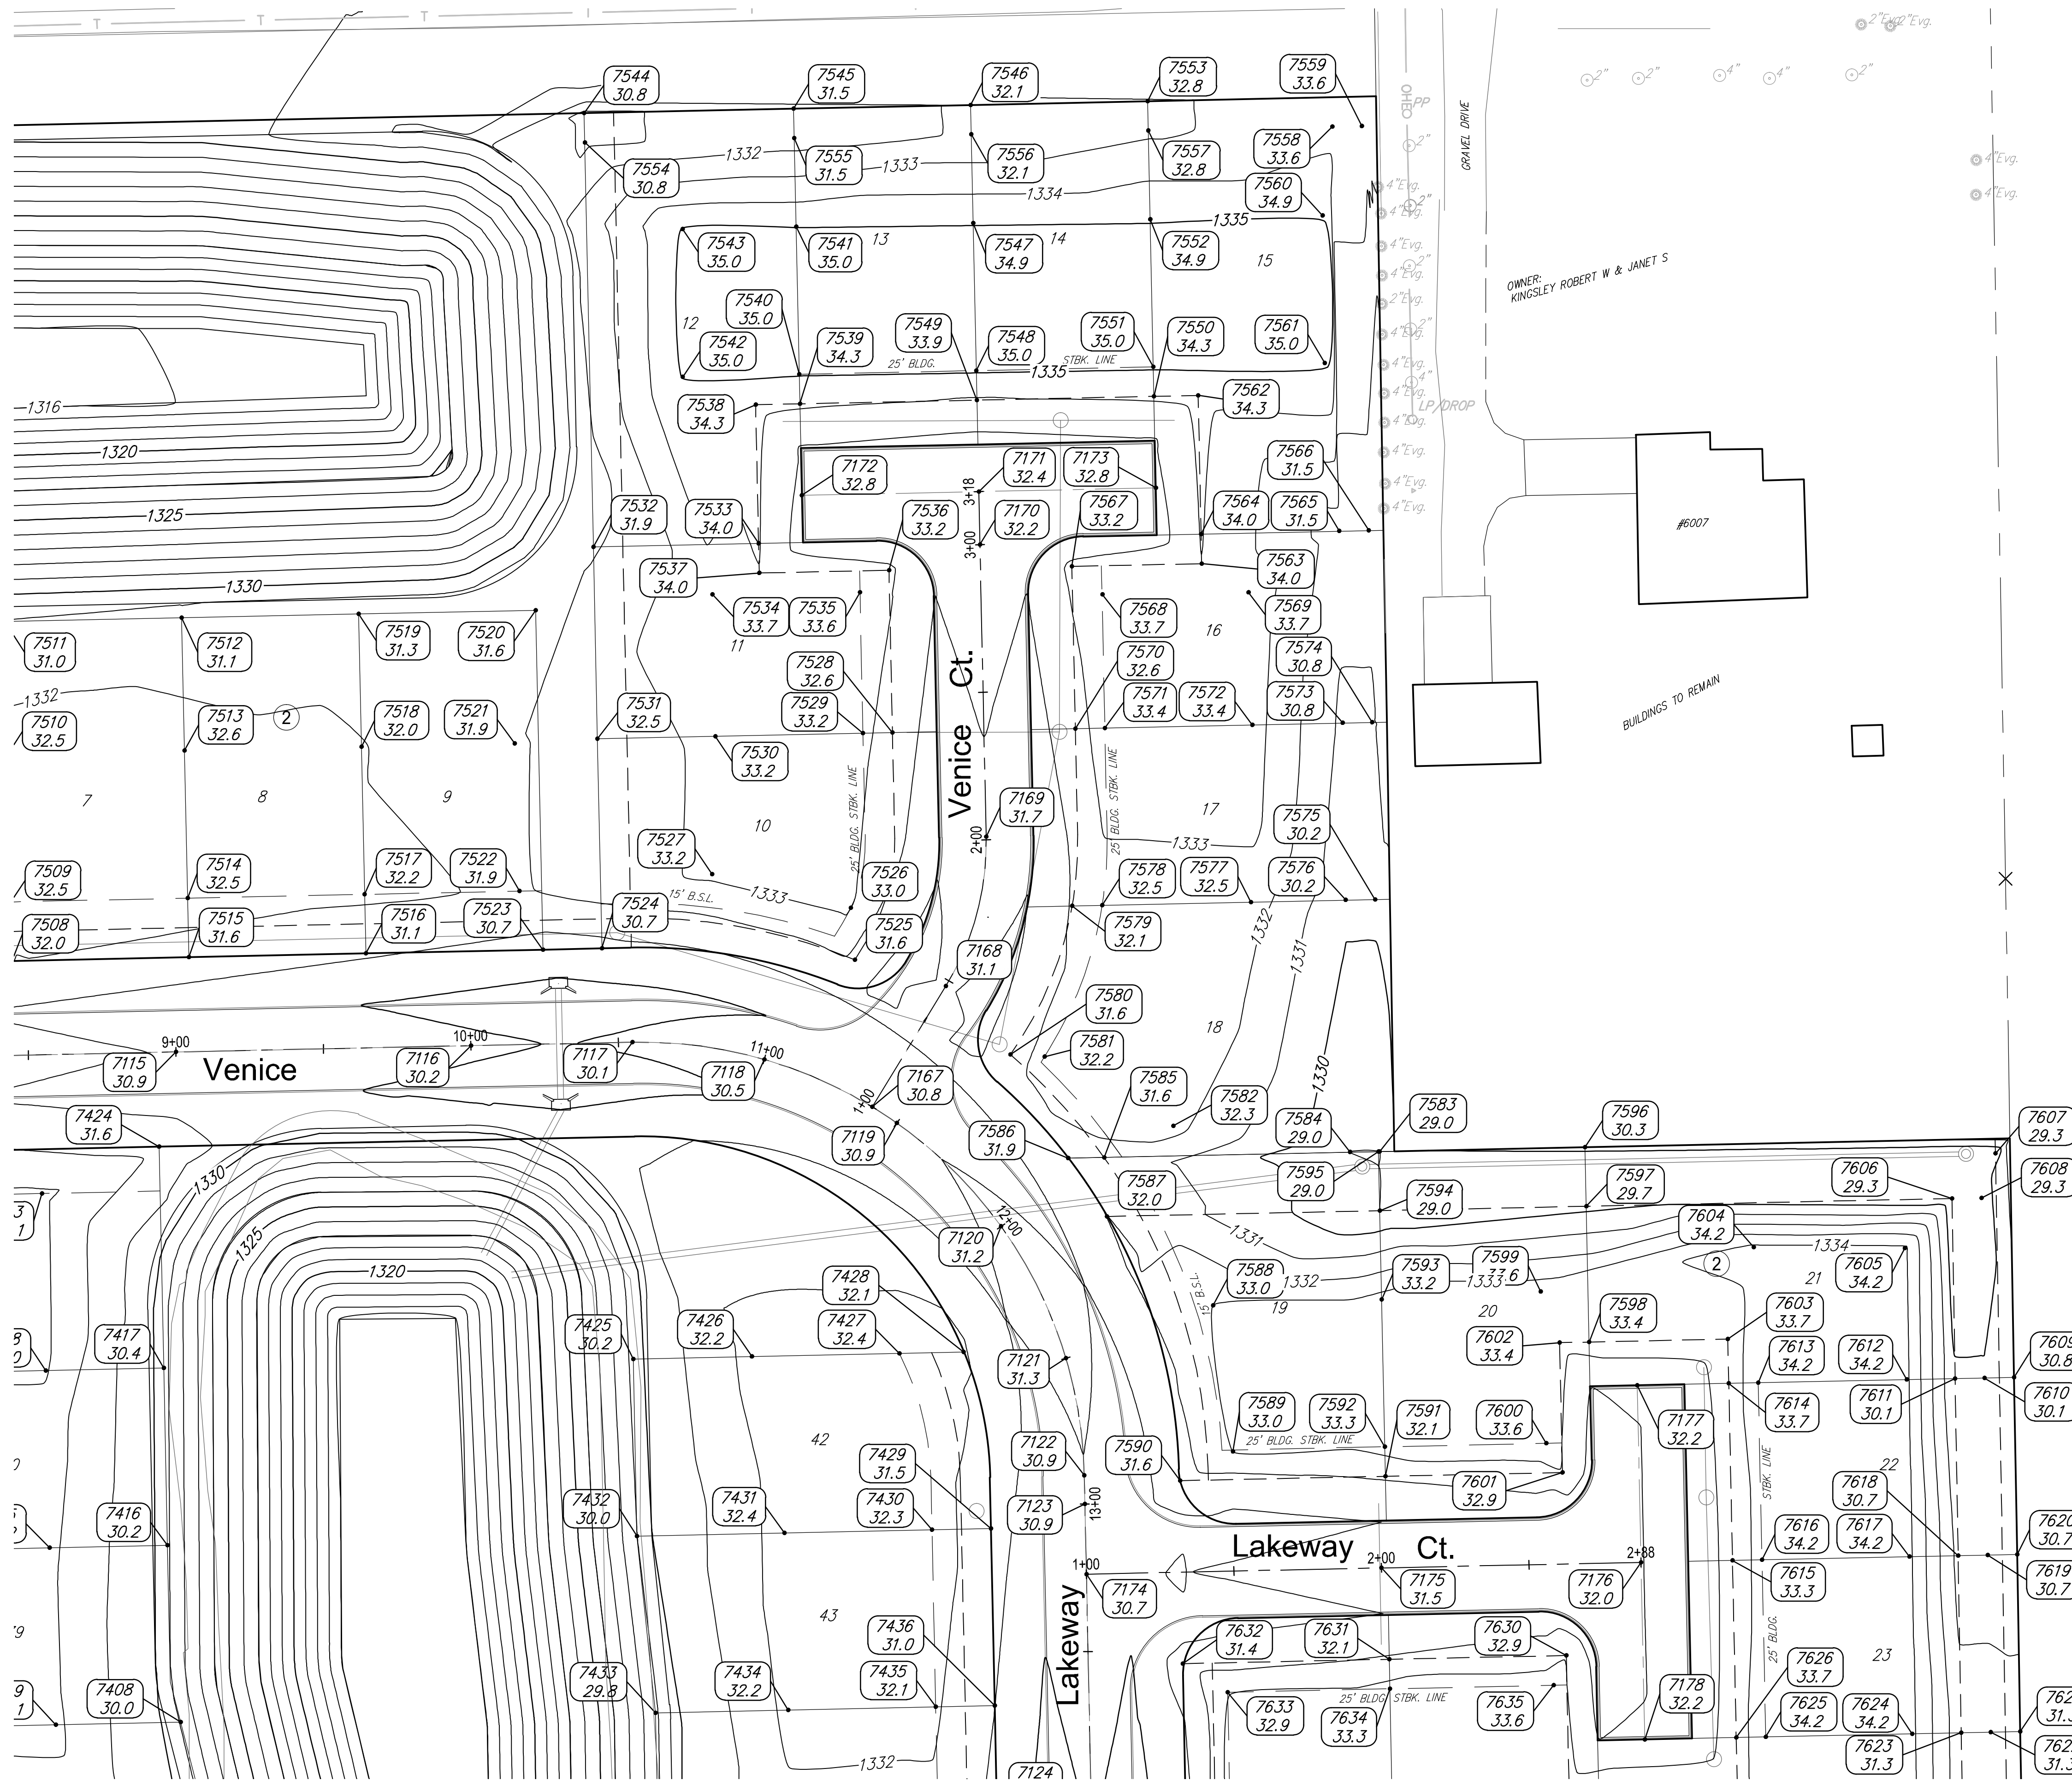

SIENA LAKES ADDITION PHASE 1 4-COR-NE		DATE 11-3-2015
 RUGGLES & BOHM		DESIGN EJG
<small>ENGINEERING SURVEYING LANDSCAPE ARCHITECTURE GOVERNMENT 924 NORTH MAIN WICHITA, KANSAS 67203 P (316) 264-8008 F (316) 264-4621 WWW.RUGGLESANDBOHM.COM</small>		DRAWN DS
PROJECT NUMBER 468-84971	REV. JOB NO. 4350E	REVIEW 9-30-2015
DRAWING FILE Siena Lakes Eng Base [4-COR-NE]	DWG. SCALE ...	SHEET 29
		OF 37