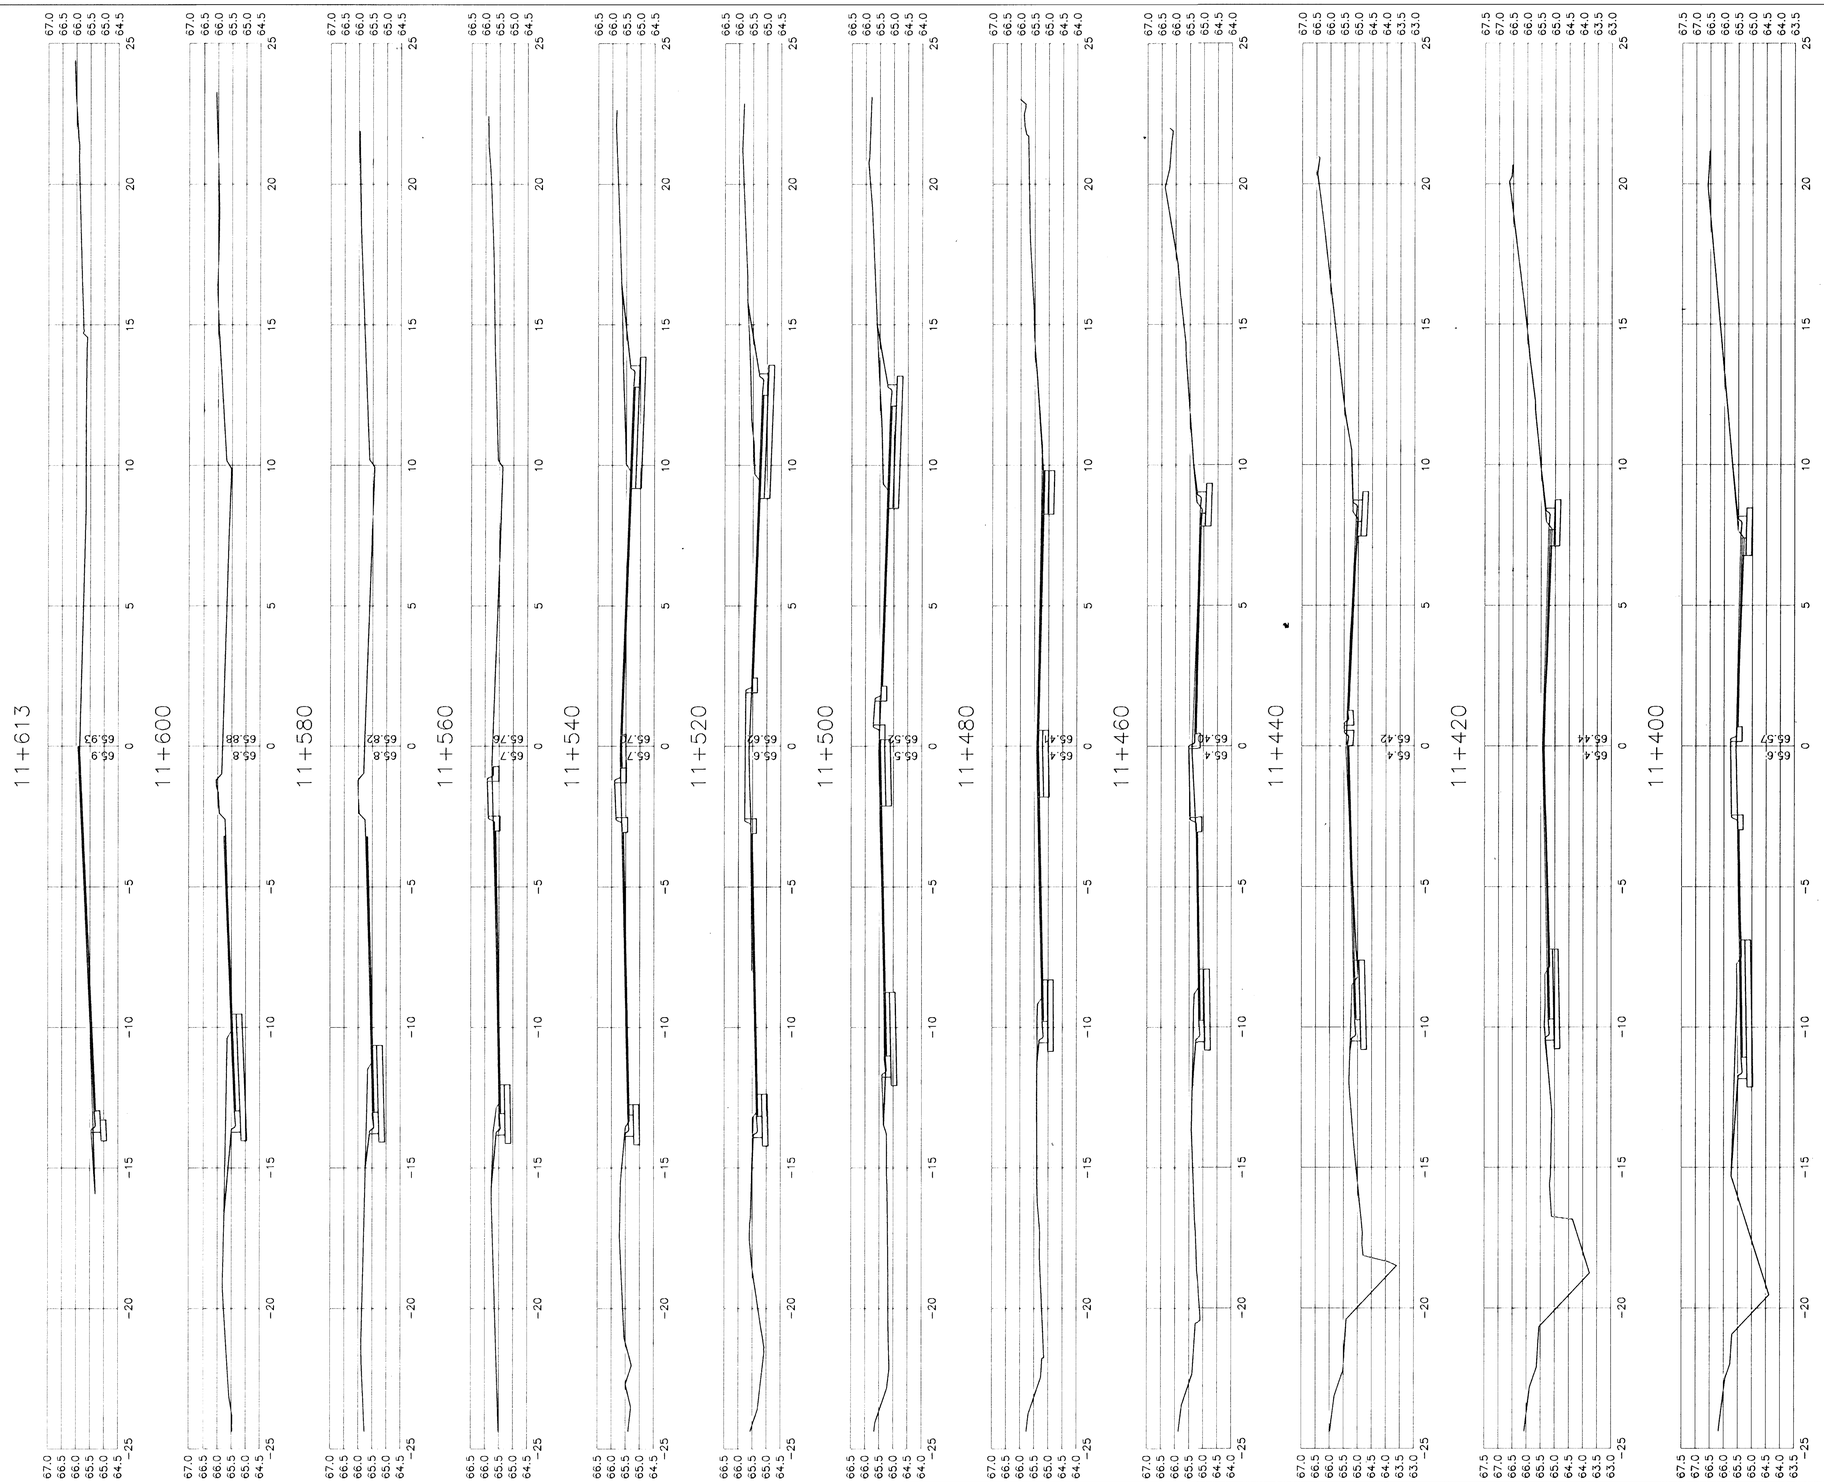

Rock Road - 21st Street North to 29th Street North

Sta. 11+400 to 11+613

City of Wichita

kemiller engineering

516 S. Market,
Wichita, KS 67202
316/264-0242

PROJECT NUMBER			
472-83889			
KEM NO. 02042	FILE Xsections	DATE 9/2002	SHEET 51
DESIGN	DRAWN	REVISED 12/2003	OF 51

AS BAD