



SANITARY SEWER PLANS FOR
17TH STREET SANITARY SEWER
 WICHITA, KANSAS

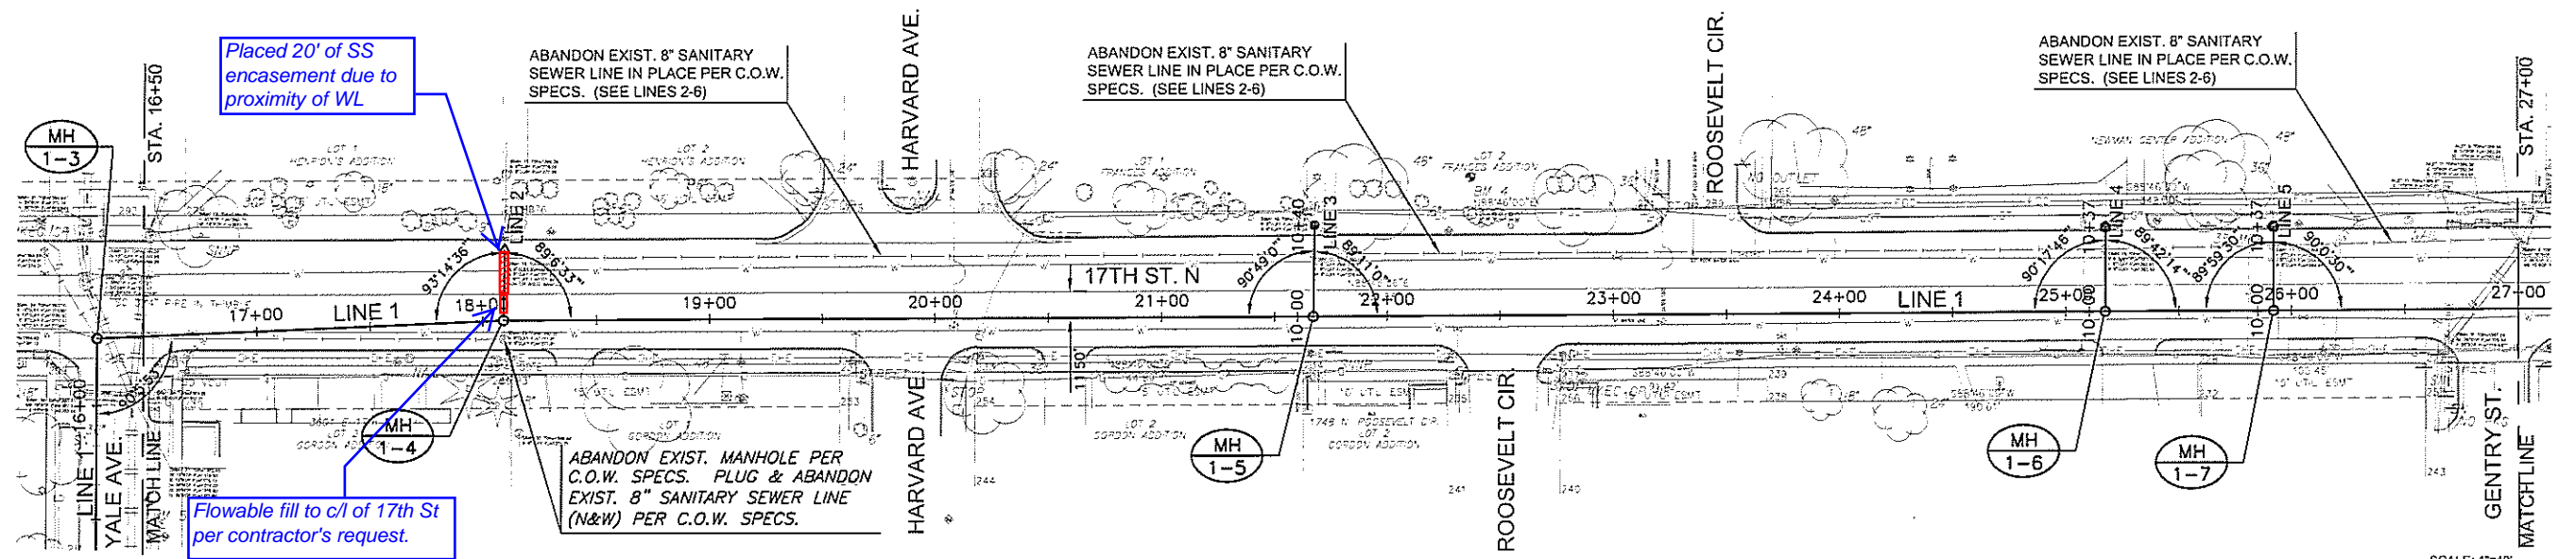

NOTE:
CONTRACTOR TO VERIFY THE
DEPTH AND LOCATION OF EXISTING
UTILITIES PRIOR TO CONSTRUCTION.

PLAN - SS LINE 1 (2)
PROFILE - SS LINE 1 (2)

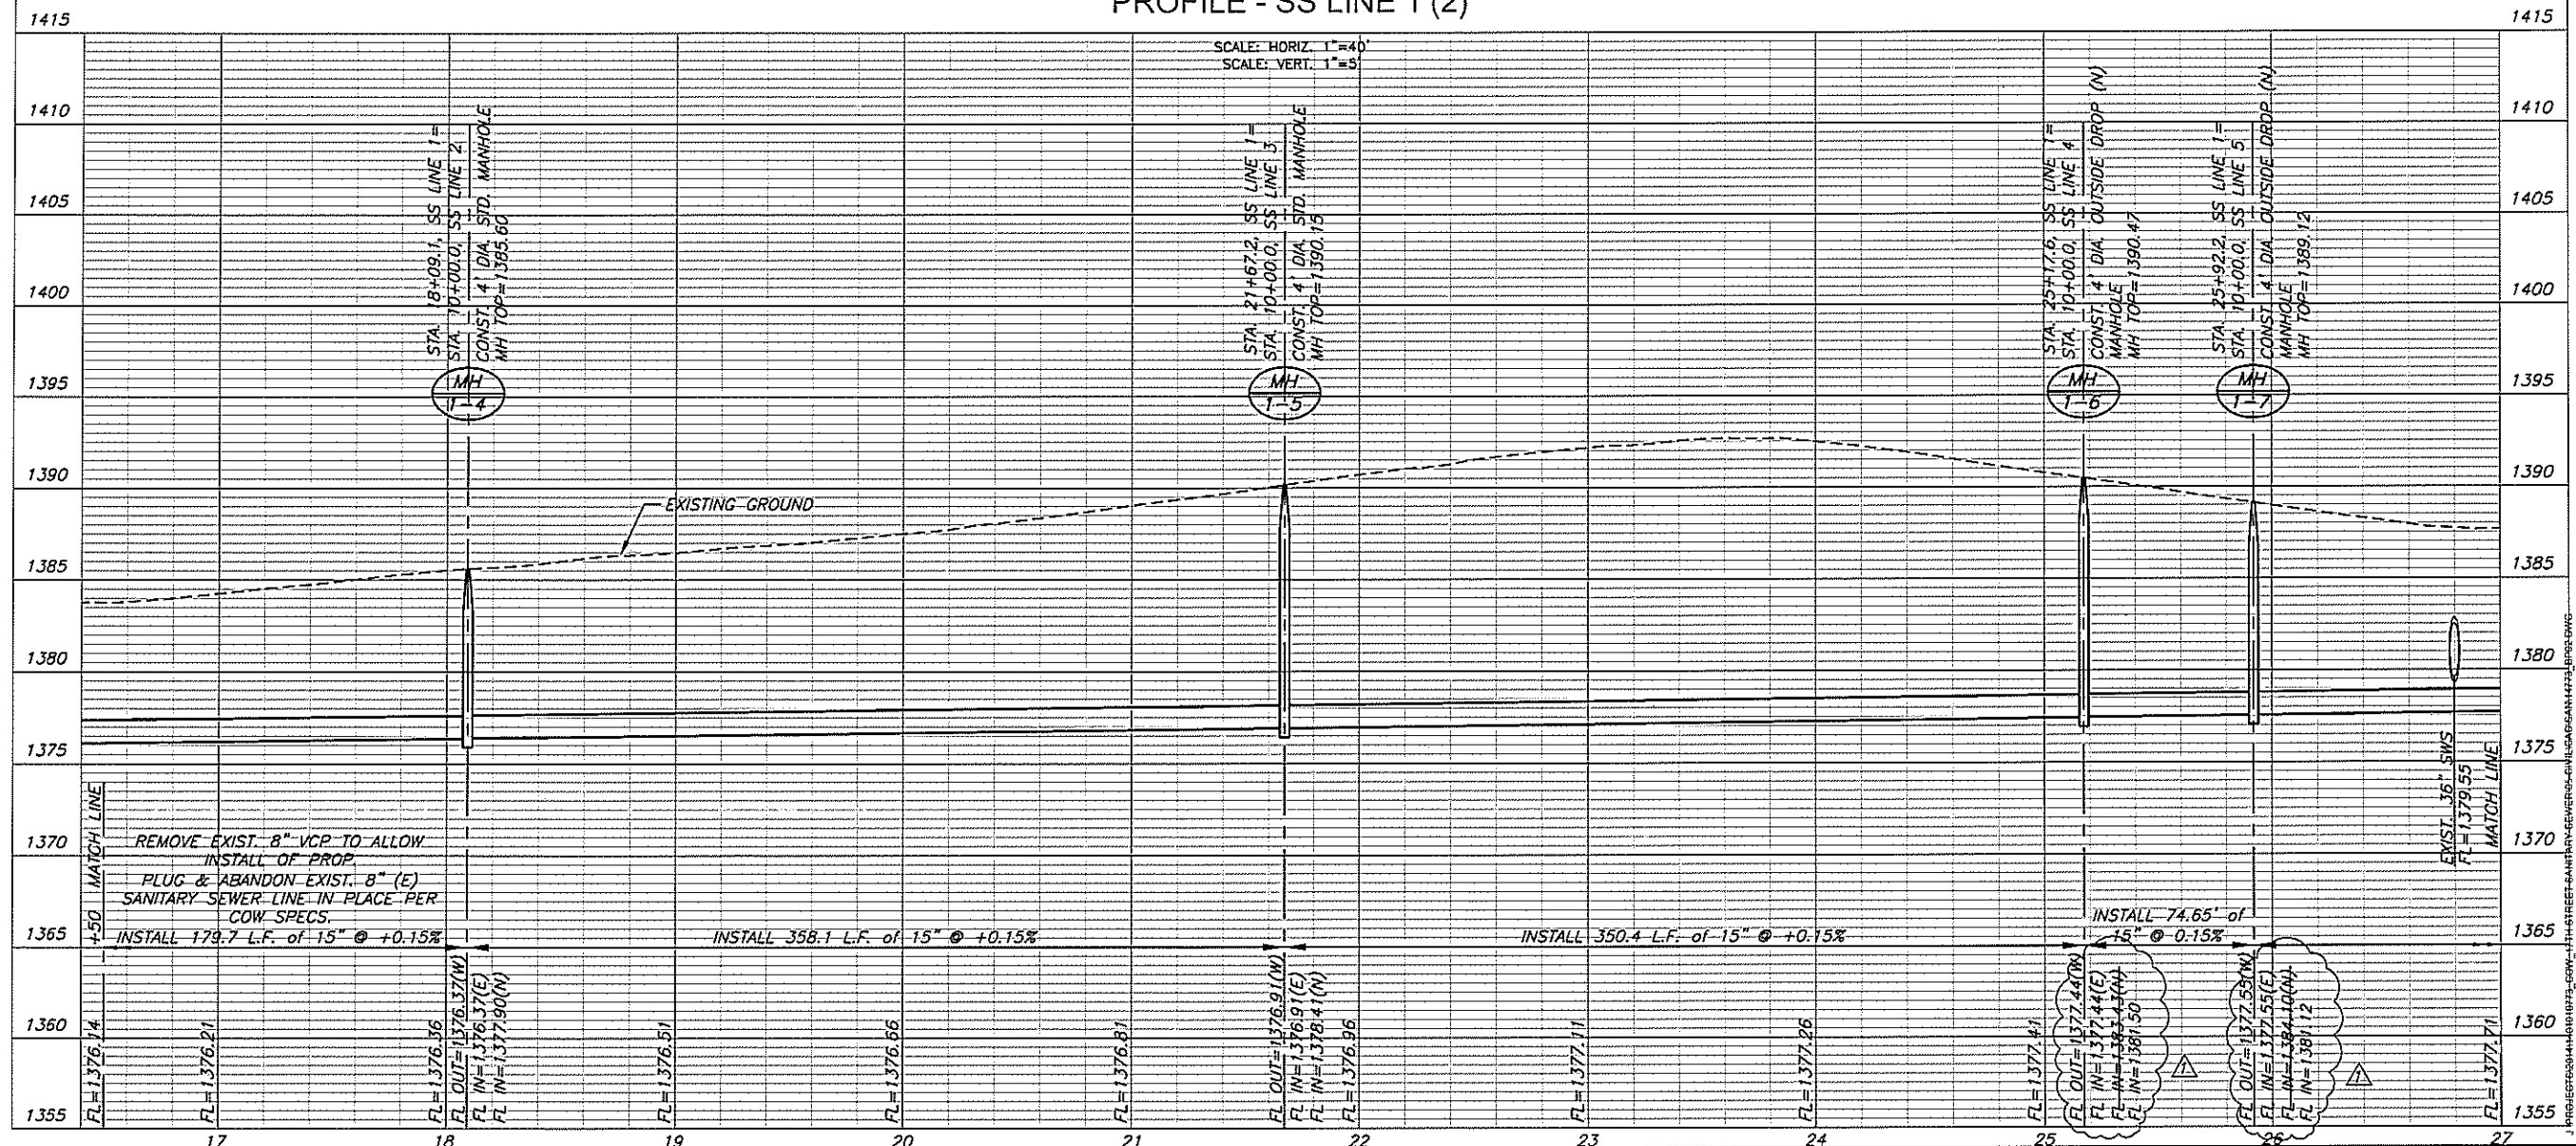

©2015
MKEC Engineering
All Rights Reserved
www.mkec.com
These drawings and their contents,
including but not limited to all concepts,
designs, & ideas are the exclusive
property of MKEC Engineering (MKEC),
and may not be used or reproduced in any
way without the express consent of MKEC.

SANITARY SEWER LINE 1 CONT.	
PROJECT NO	468-85021
DATE	MARCH 2015
SCALE	AS SHOWN
DESIGNED	DRAWN
JRA	WNJ
CHECKED	JRA
NO	REVISION
1	REV TO DEPICT 20" WTR
NO	REVISION
NO	DATE
SHEET NO.	
07 OF 51	