

SANITARY SEWER PLANS FOR
17TH STREET SANITARY SEWER
 WICHITA, KANSAS



©2015
 MKEC Engineering
 All Rights Reserved
 www.mkec.com
 These drawings and their contents, including but not limited to, all concepts, designs, & data are the exclusive property of MKEC Engineering (MKEC) and may not be used or reproduced in any way without the express consent of MKEC.

**SANITARY SEWER
 LINE 2 AND 3**


PROJECT NO	468-85021	
DATE	MARCH 2015	
SCALE	AS SHOWN	
DESIGNED	DRAWN	CHECKED
JRA	WNJ	JRA

1	REVISE TO DEPICT 20" WTR	7-27-15
NO.	REVISION	DATE


SHEET NO.
 09 OF 51

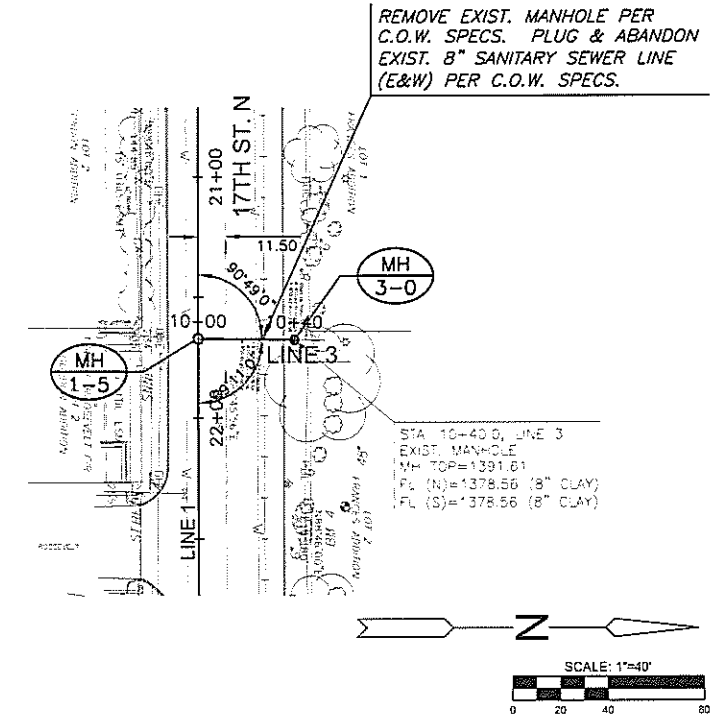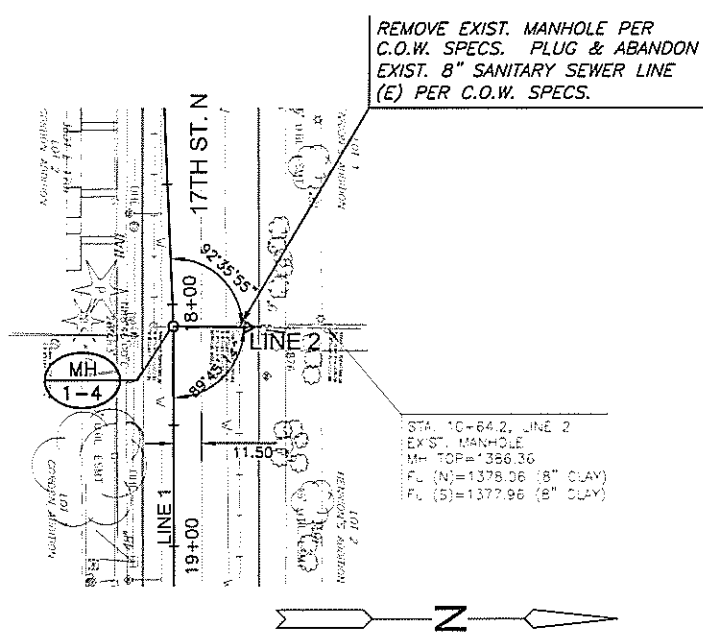

NOTE:
 CONTRACTOR TO VERIFY THE DEPTH AND LOCATION OF EXISTING UTILITIES PRIOR TO CONSTRUCTION.

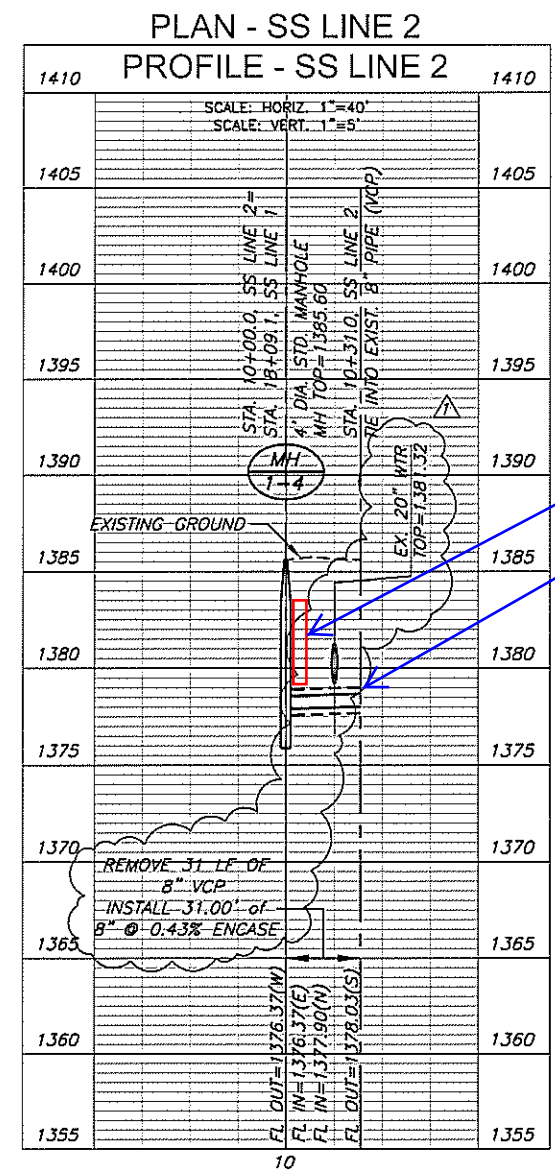

Flowable fill
 Concrete encasement

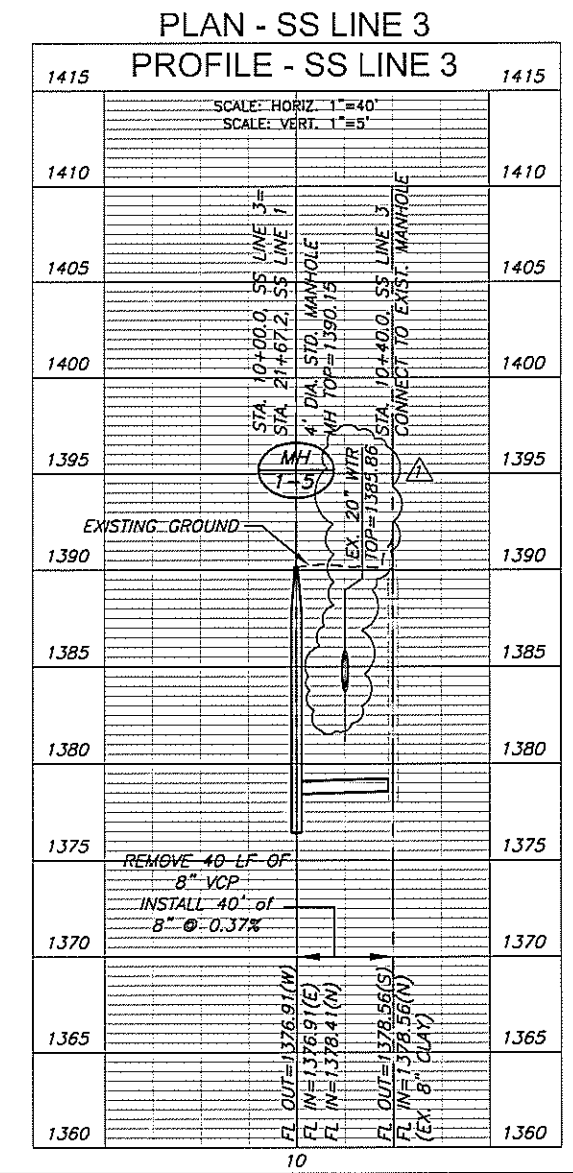

J:\PROJECTS\04146010731_C001_17TH STREET SANITARY SEWER\04-CAD\04-SAN\4731_DWG.DWG