


2260 PPS (607861)
Sanitary Sewer Abandonment
Contractor: Nowak Construction
Inspector: CED, Harlan Foraker
1-28-16

T.Mason - City of Wichita, Inspector
Release Date: 01/28/2016
:apr 02/22/20166

| SURVEY LEGEND | |
|--------------------|----------------------------|
| EXISTING UTILITIES | |
| ohe | OVERHEAD ELECTRIC |
| uge | UNDERGROUND ELECTRIC |
| gas | GAS LINE |
| ss | SANITARY SEWER LINE |
| st | STORM SEWER LINE (<12") |
| st | STORM SEWER LINE (≥12") |
| oht | OVERHEAD TELEPHONE LINE |
| ugt | UNDERGROUND TELEPHONE LINE |
| wtr | WATER LINE |
| EXISTING FEATURES | |
| □ | UTILITY PEDESTAL/RISER |
| ○ | UTILITY POLE |
| ○ | UTILITY POLE W/LIGHT |
| ○ | UTILITY POLE W/TRANSFORMER |
| ⊕ | UTILITY MANHOLE |
| ⊕ | UTILITY METER |
| ⊕ | UTILITY VALVE |
| ⊕ | UTILITY CLEAN OUT |
| — | GUY WIRE |
| ⊕ | LIGHT POLE |
| ⊕ | ARCHITECTURAL/SPOT LIGHT |
| ⊕ | FIRE HYDRANT |
| □ | CURB INLET |
| □ | AREA INLET |
| □ | JUNCTION BOX |
| □ | SINGLE POST SIGN |
| □ | MULTI-POST SIGN/BILLBOARD |
| ○ | DECIDUOUS TREE |
| ○ | EVERGREEN TREE |
| → | TRAFFIC ARROWS |
| → | TRAFFIC SIGNAL W/MAST ARM |
| → | TRAFFIC SIGNAL |
| → | TRAFFIC CONTROL BOX |
| → | BOLLARD |
| EXISTING FEATURES | |
| — | CURB LINE |
| — | EDGE OF ASPHALT |
| — | WOOD FENCE |
| — | WALL |
| — | GUARDRAIL |
| — | EXISTING STRUCTURE |


| EXISTING LEGEND (ITEMS TO BE REMOVED) | |
|---------------------------------------|------------------------|
| EXISTING UTILITIES | |
| ss | SANITARY SEWER LINE |
| ugt | TELEPHONE |
| uge | ELECTRIC (UNDERGROUND) |
| ohe | ELECTRIC (OVERHEAD) |
| st | STORM SEWER |
| EXISTING FEATURES | |
| — | CURB LINE |
| — | EDGE OF ASPHALT |

LEGAL DESCRIPTION:
 Lot 1, Block 1, QuikTrip 16th
 Addition, An Addition to Wichita,
 Sedgwick County, Kansas

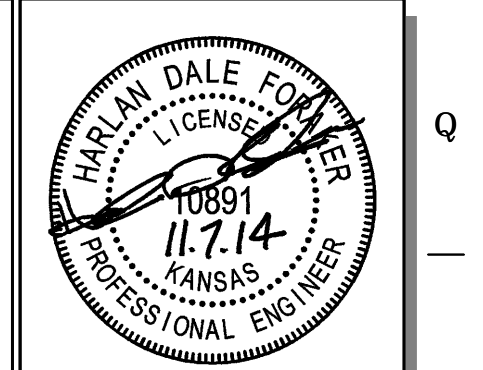

PROJECT NO.:
CEED
 CERTIFIED ENGINEERING DESIGN, P.A.
 1935 W. MAPLE STREET
 WICHITA, KANSAS 67213
 PH (316)262-8808
 FAX (316)262-1669

QuikTrip No. 0356R
 SWC 47TH & HYDRAULIC
 WICHITA, SEDGWICK, KS

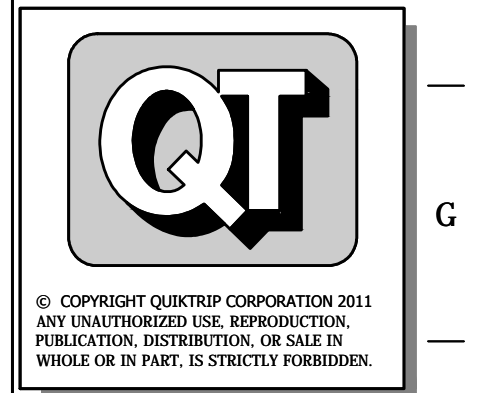

PROTOTYPE: P-80 (08/01/14)
 DIVISION: 03
 VERSION: 001
 DESIGNED BY:
 DRAWN BY: KSR
 REVIEWED BY:

| REV | DATE | DESCRIPTION |
|-----|----------|---------------------------------|
| 1 | 10/13/14 | REVISED PER MANCO CITY COMMENTS |
| 4 | 1/27/15 | TORNADO SIREN RELOCATOR CHANGES |

SHEET TITLE:
 DEMOLITION SHEET

SHEET NUMBER:
 C030

FILE LOCATIONS:\Drawing Files\Project AMG 9-16-13\QT #0356R\DWG\03-0356 Civil.dwg TAB NAME:Demo USER:regoodrich SAVED:2/19/2015 3:29 PM PLOTTED:12/23/2015 9:55 AM