


Point Table			Point Table			Point Table					
Point #	Northing	Easting	Description	Point #	Northing	Easting	Description	Point #	Northing	Easting	Description
1	18732.55	11316.63	Iron	61	18575.44	11580.75	Iron	8000	17986.32	12502.09	ExMH
2	18776.01	11269.65	Iron	62	18528.46	11537.30	Iron	8001	18131.96	12460.44	MH
3	18804.64	11238.69	Iron	63	18530.15	11718.36	Iron	8002	17977.73	12168.70	MH
4	18851.62	11282.15	Iron	64	18576.31	11674.03	Iron	8003	17869.37	11963.73	MH
5	18822.67	11194.95	Iron	65	19740.69	12230.21	Iron	8004	18281.93	12695.08	MH
6	18886.63	11197.23	Iron	66	18598.77	11105.72	Iron				
7	18953.71	11067.66	Iron	67	18555.32	11152.70	Iron				
8	18954.14	11131.65	Iron	68	18508.26	11070.62	Iron				
9	19022.53	11067.20	Iron	69	18508.69	11134.62	Iron				
10	19021.60	10927.20	Iron	70	18129.55	11073.15	Iron				
11	19085.59	10926.77	Iron	71	18129.98	11137.15	Iron				
12	19086.53	11066.77	Iron	72	18098.62	11138.00	Iron				
13	19096.47	11066.70	Iron	73	18040.65	11142.96	Iron				
14	19096.90	11130.70	Iron	74	18099.24	11231.42	Iron				
15	19190.06	11104.74	Iron	75	18041.24	11231.81	Iron				
16	19145.11	11150.30	Iron	76	17961.40	11091.46	Iron				
17	19231.35	11145.48	Iron	77	17974.76	11154.05	Iron				
18	19272.63	11186.22	Iron	78	17703.36	11095.57	Iron				
19	19272.37	11103.91	Iron	79	17692.00	11158.55	Iron				
20	19313.65	11144.65	Iron	80	17507.24	11192.07	Iron				
21	19363.63	11065.52	Iron	81	17388.49	11160.77	Iron				
22	19363.88	11123.52	Iron	82	17388.49	11224.77	Iron				
23	19514.87	11064.86	Iron	83	17346.65	11160.77	Iron				
24	19515.12	11122.86	Iron	84	17314.15	11224.77	Iron				
25	19473.31	11384.24	Iron	85	17249.33	11137.77	Iron				
26	19428.35	11429.79	Iron	86	17169.33	11137.77	Iron				
27	19521.64	11467.83	Iron	87	17169.33	11224.77	Iron				
28	19521.36	11403.83	Iron	88	17169.33	10939.54	Iron				
29	19533.36	11467.78	Iron	89	17815.75	12482.52	Iron				
30	19597.36	11467.50	Iron	90	17802.54	12423.41	Iron				
31	19534.01	11615.81	Iron	91	17953.29	12408.52	Iron				
32	19598.01	11615.53	Iron	92	17721.43	12272.66	Iron				
33	19466.48	11684.11	Iron	93	17695.83	12239.24	Iron				
34	19466.93	11748.10	Iron	94	17643.99	12209.03	Iron				
35	19246.38	11685.64	Iron	95	17631.72	12205.89	Iron				
36	19249.59	11749.62	Iron	96	17648.87	12200.66	Iron				
37	19198.37	11596.28	Iron	97	17645.18	12184.72	Iron				
38	19153.42	11641.84	Iron	98	17693.18	12137.80	Iron				
39	19099.13	11588.27	Iron	99	17727.54	12124.90	Iron				
40	19035.92	11652.33	Iron	100	17723.26	12192.18	Iron				
41	18990.97	11697.89	Iron	101	17734.02	12104.44	Iron				
42	19056.75	11672.89	Iron	102	17797.49	12087.58	Iron				
43	19011.80	11718.44	Iron	103	17786.49	12093.45	Iron				
44	19090.80	11686.72	Iron	104	17790.13	12127.78	Iron				
45	19091.24	11750.72	Iron	105	17812.56	12115.82	Iron				
46	19180.54	11686.10	Iron	106	17846.47	12074.07	Iron				
47	19185.59	11750.06	Iron	107	17864.44	12057.17	Iron				
48	18736.26	11840.58	Iron	108	17857.41	12020.25	Iron				
49	18690.10	11884.91	Iron	109	17838.49	11984.46	Iron				
50	18820.13	11995.18	Iron	110	17866.70	11969.35	Iron				
51	18757.80	12009.71	Iron	111	17885.70	12005.29	Iron				
52	18867.21	12032.28	Iron	112	17895.38	12066.73	Iron				
53	18867.66	12096.28	Iron	113	17905.37	12086.89	Iron				
54	19186.81	12030.06	Iron	114	17954.64	12135.72	Iron				
55	19250.81	12029.61	Iron	115	17926.35	12150.68	Iron				
56	19511.31	12027.80	Iron	116	18210.08	12618.94	Iron				
57	19511.75	12091.80	Iron	117	18231.28	12628.55	Iron				
58	19737.36	11466.89	Iron	118	18207.13	12681.83	Iron				
59	19737.08	11402.89	Iron	119	18013.63	12519.92	Iron				
60	19734.98	10922.45	Iron	120	18061.91	12611.89	Iron				

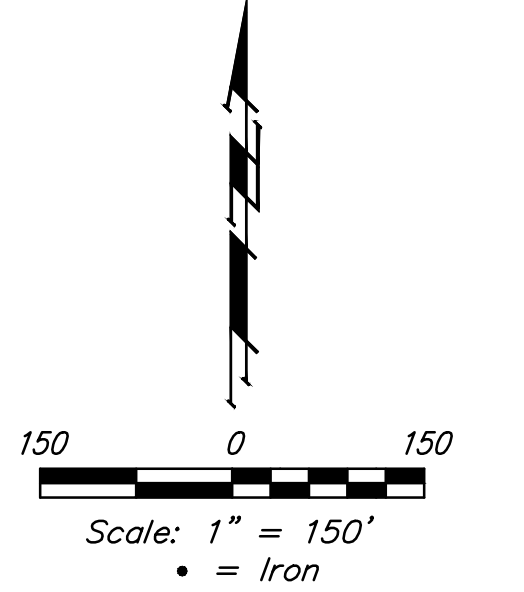

**Baughman** The Woods Addition - Phase III  
**COORDINATES**  
 Sanitary Sewer Improvements

Baughman Company, P.A. 315 Ellis St. Wichita, KS 67211 P 316-262-7271 F 316-262-0149  
 ENGINEERING | SURVEYING | PLANNING | LANDSCAPE ARCHITECTURE

PROJECT NUMBER 468-84130	DESIGN AEG	DRAWN JAK
REVISIONS:	APPROVED	DATE 2/18/16
	SCALE Noted	SHEET <b>12 OF 13</b>

E:\Projects\The Woods Addition\Phase 3\SS 1507-E271\SS\_PLANS.dwg