THE COORDINATES PROVIDED IN THESE PLANS ARE FOR INFORMATION AND CHECKING PURPOSES ONLY. IT IS THE CONTRACTOR'S RESPONSIBILITY TO CALCULATE CONSTRUCTION STAKING COORDINATES ACCORDING TO THE DIMENSIONS SHOWN ON THESE PLANS. CONTRACTOR SHALL VERIFY THE ACCURACY OF THE COORDINATES SHOWN HEREON BEFORE CONSTRUCTION.

NOTE: CONTRACTOR SHALL REPLACE/REPAIR ALL EXISTING GRAVEL SURFACING (IN-KIND) THAT IS DISTURBED/DESTROYED DURING CONSTRUCTION. ALL DITCHES SHALL BE GRADED AND RETURNED TO THERE ORIGINAL CONDITIONS UPON COMPLETION OF WORK.

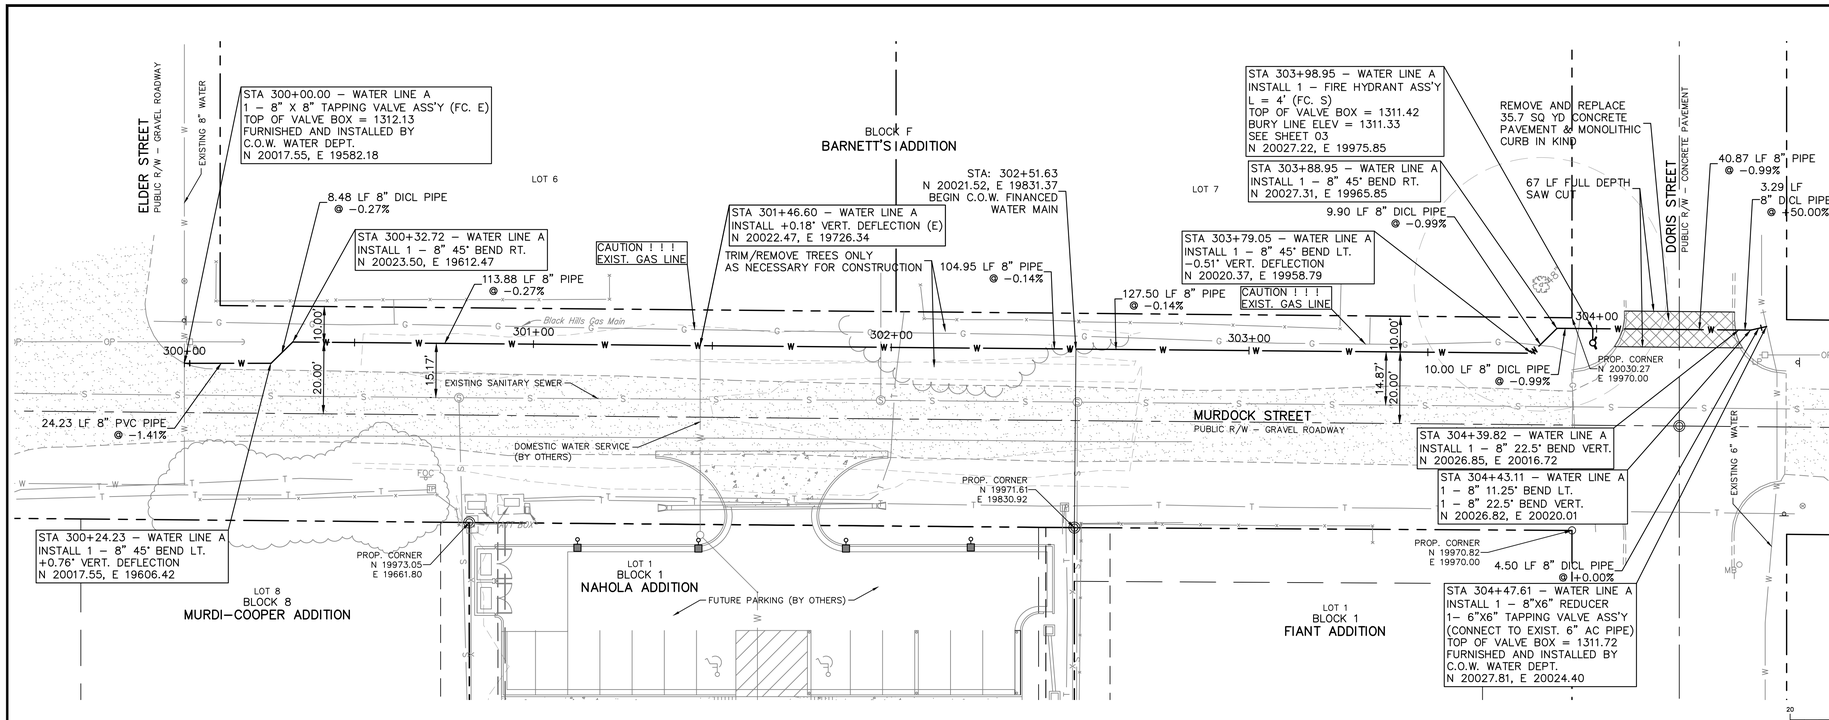

GRAPHIC SCALE

20 0 10 20 40 80

(IN FEET)
1 inch = 20 ft.
1" = 5' VERT.
PROFILE SCALING

WATER LINE A

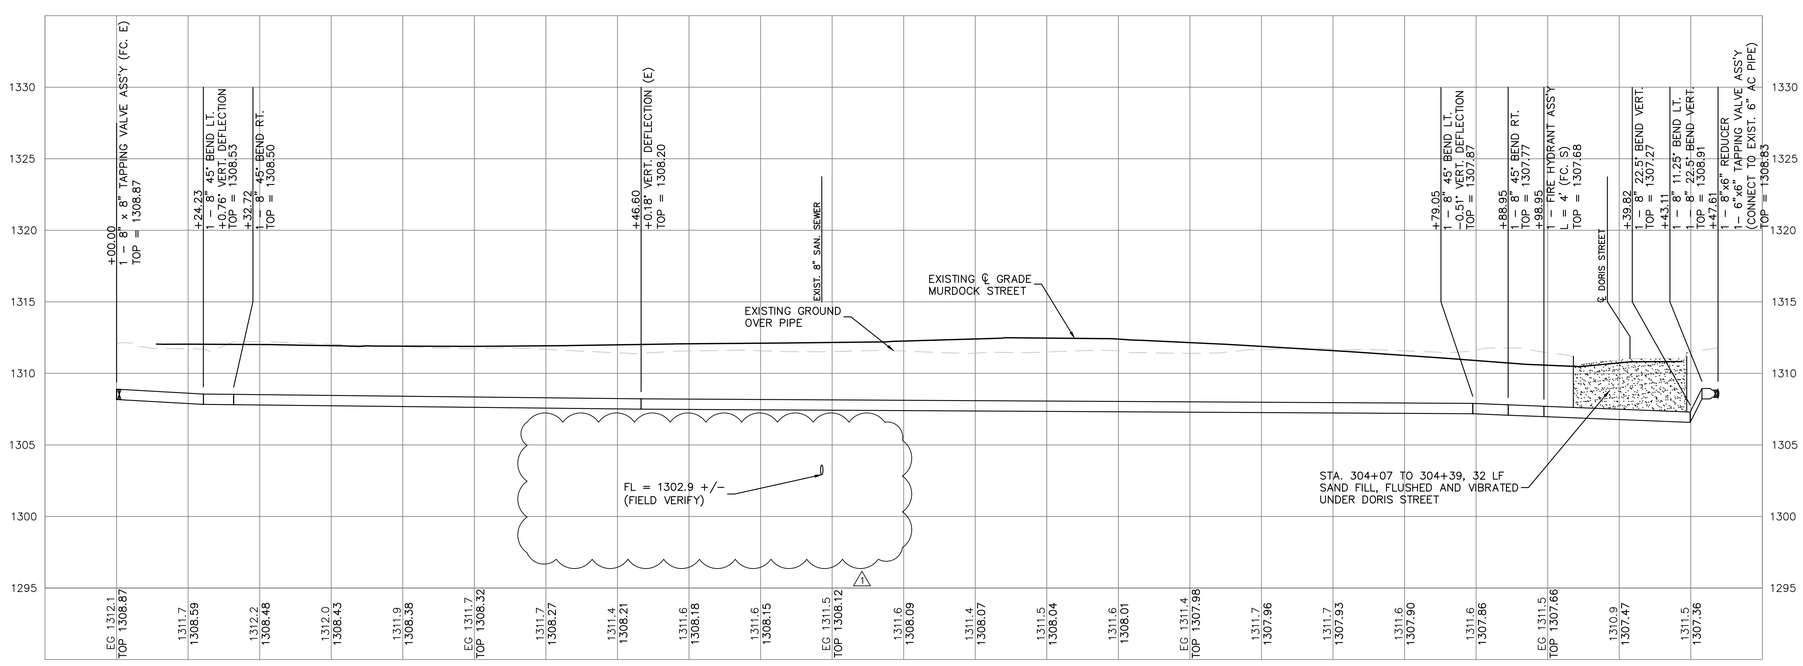

REV	DATE	DESCRIPTION	DSN	DWN	CHK
1	3–16–2016	C.O.W. REVISIONS	SRS	MLT	SRS
0	2–26–2016	FINAL PLANS – FOR CONSTRUCTION	SRS	MLT	SRS

SCOTT R. SERVIS
ENGINEER
KS # 17874

200 N. EMPORIA, SUITE 100
WICHITA, KANSAS 67202
PH. (316) 440-4304 | FAX (316) 440-4309
wv@kaveng.com | www.kaveng.com
KAW VALLEY ENGINEERING
KAW VALLEY ENGINEERING, INC. IS AUTHORIZED TO OFFER ENGINEERING SERVICES BY KANSAS STATE CERTIFICATE OF AUTHORIZATION # E-1113. EXPIRES 12/31/16

NAHOLA ADDITION
5223 WEST ELM CIRCLE
WICHITA, KANSAS

WATERLINE PLAN & PROFILE

PROJ. NO.	G14D0066
DESIGNER	SRS
DRAWN BY	MLT
CFN	0066WPP
SHEET	06
REV	1

THIS DRAWING SHALL NOT BE UTILIZED BY ANY PERSON, FIRM, OR CORPORATION IN WHOLE OR IN PART WITHOUT THE SPECIFIC PERMISSION OF KAW VALLEY ENGINEERING, INC.