
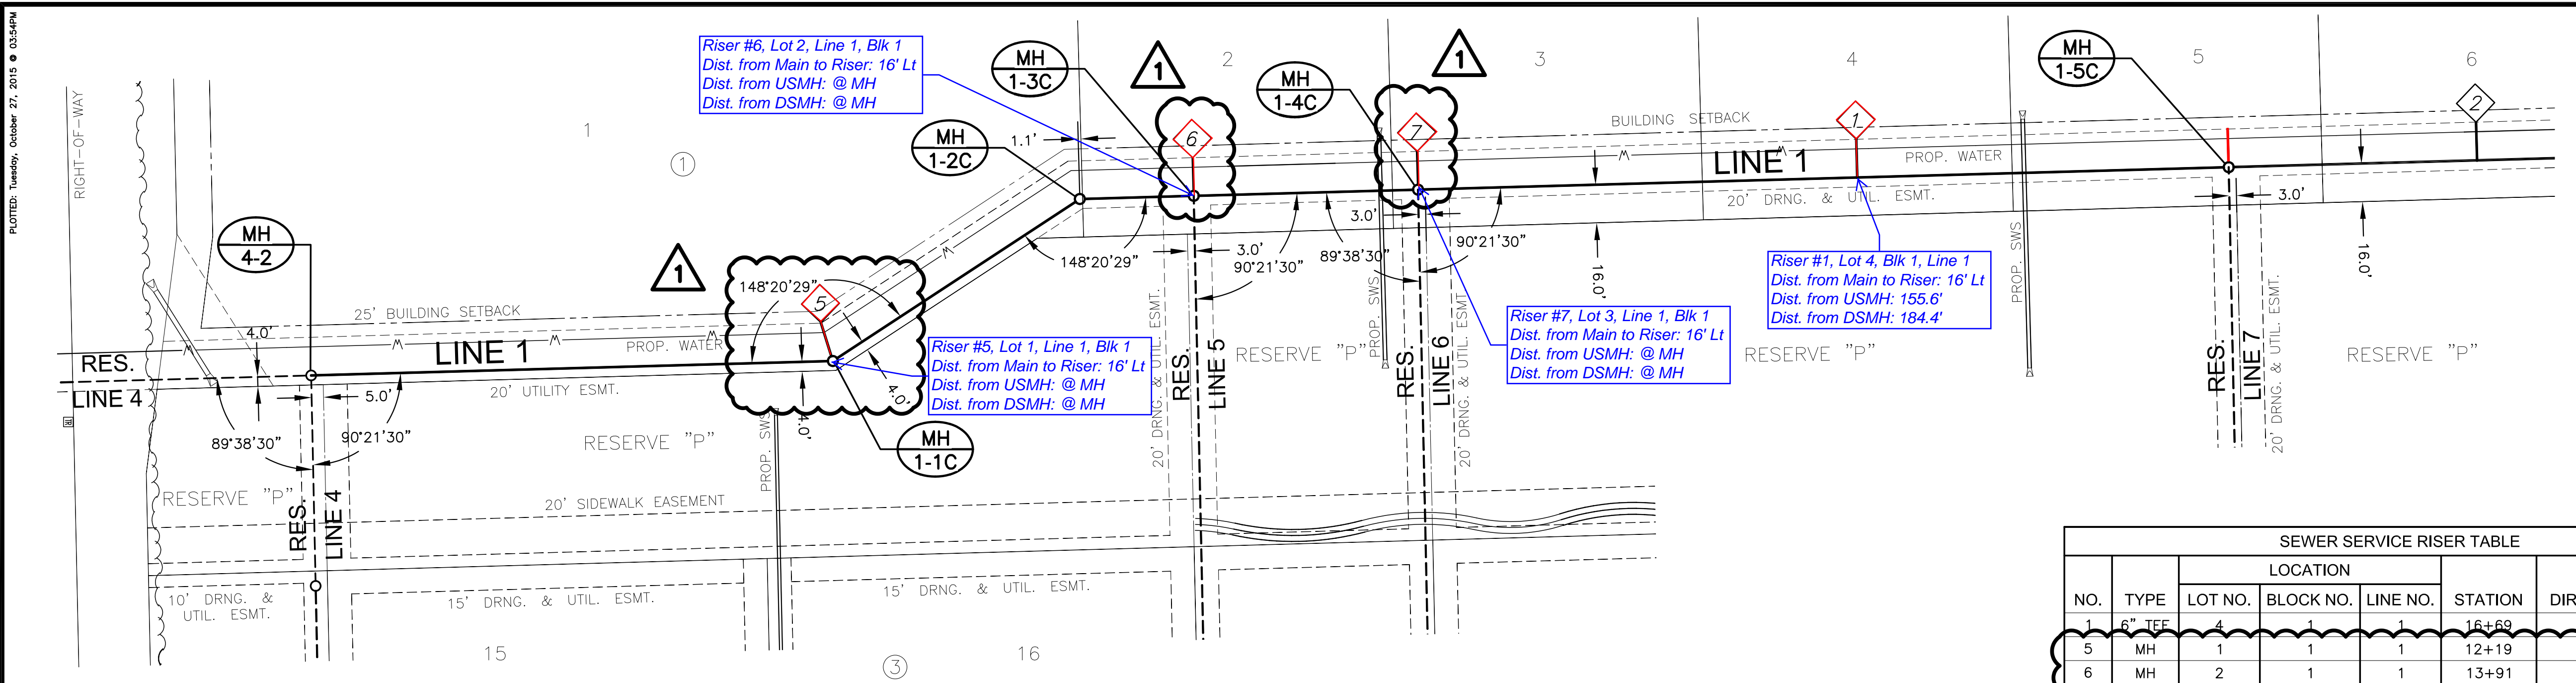


©2015 MKEC Engineering
 All Rights Reserved
 www.mkec.com
 These drawings and their contents, including, but not limited to, all concepts, designs, & ideas are the exclusive property of MKEC Engineering (MKEC), and may not be used or reproduced in any way without the express consent of MKEC.


SAN LINE 1

PROJECT NO.	468-85069	
DATE	OCT. 2015	
SCALE	1"=40'	
DESIGNED	DRAWN	CHECKED
DFL	TKL	GJA

NO.	1	ADDED 3 RISERS	10/27/15
		REVISION	DATE

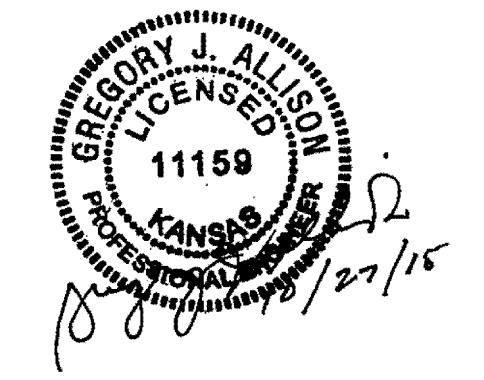

SEWER SERVICE RISER TABLE							FOR INFORMATION ONLY	
NO.	TYPE	LOCATION			STATION	DIRECTION	APPROXIMATE LENGTH	
		LOT NO.	BLOCK NO.	LINE NO.			VERTICAL (FT)	HORIZONTAL (FT)
1	6" TEF	4	1	1	16+69	LT.	10'	16'
5	MH	1	1	1	12+19	LT.	10'	16'
6	MH	2	1	1	13+91	LT.	10'	16'
7	MH	3	1	1	14+85	LT.	10'	16'

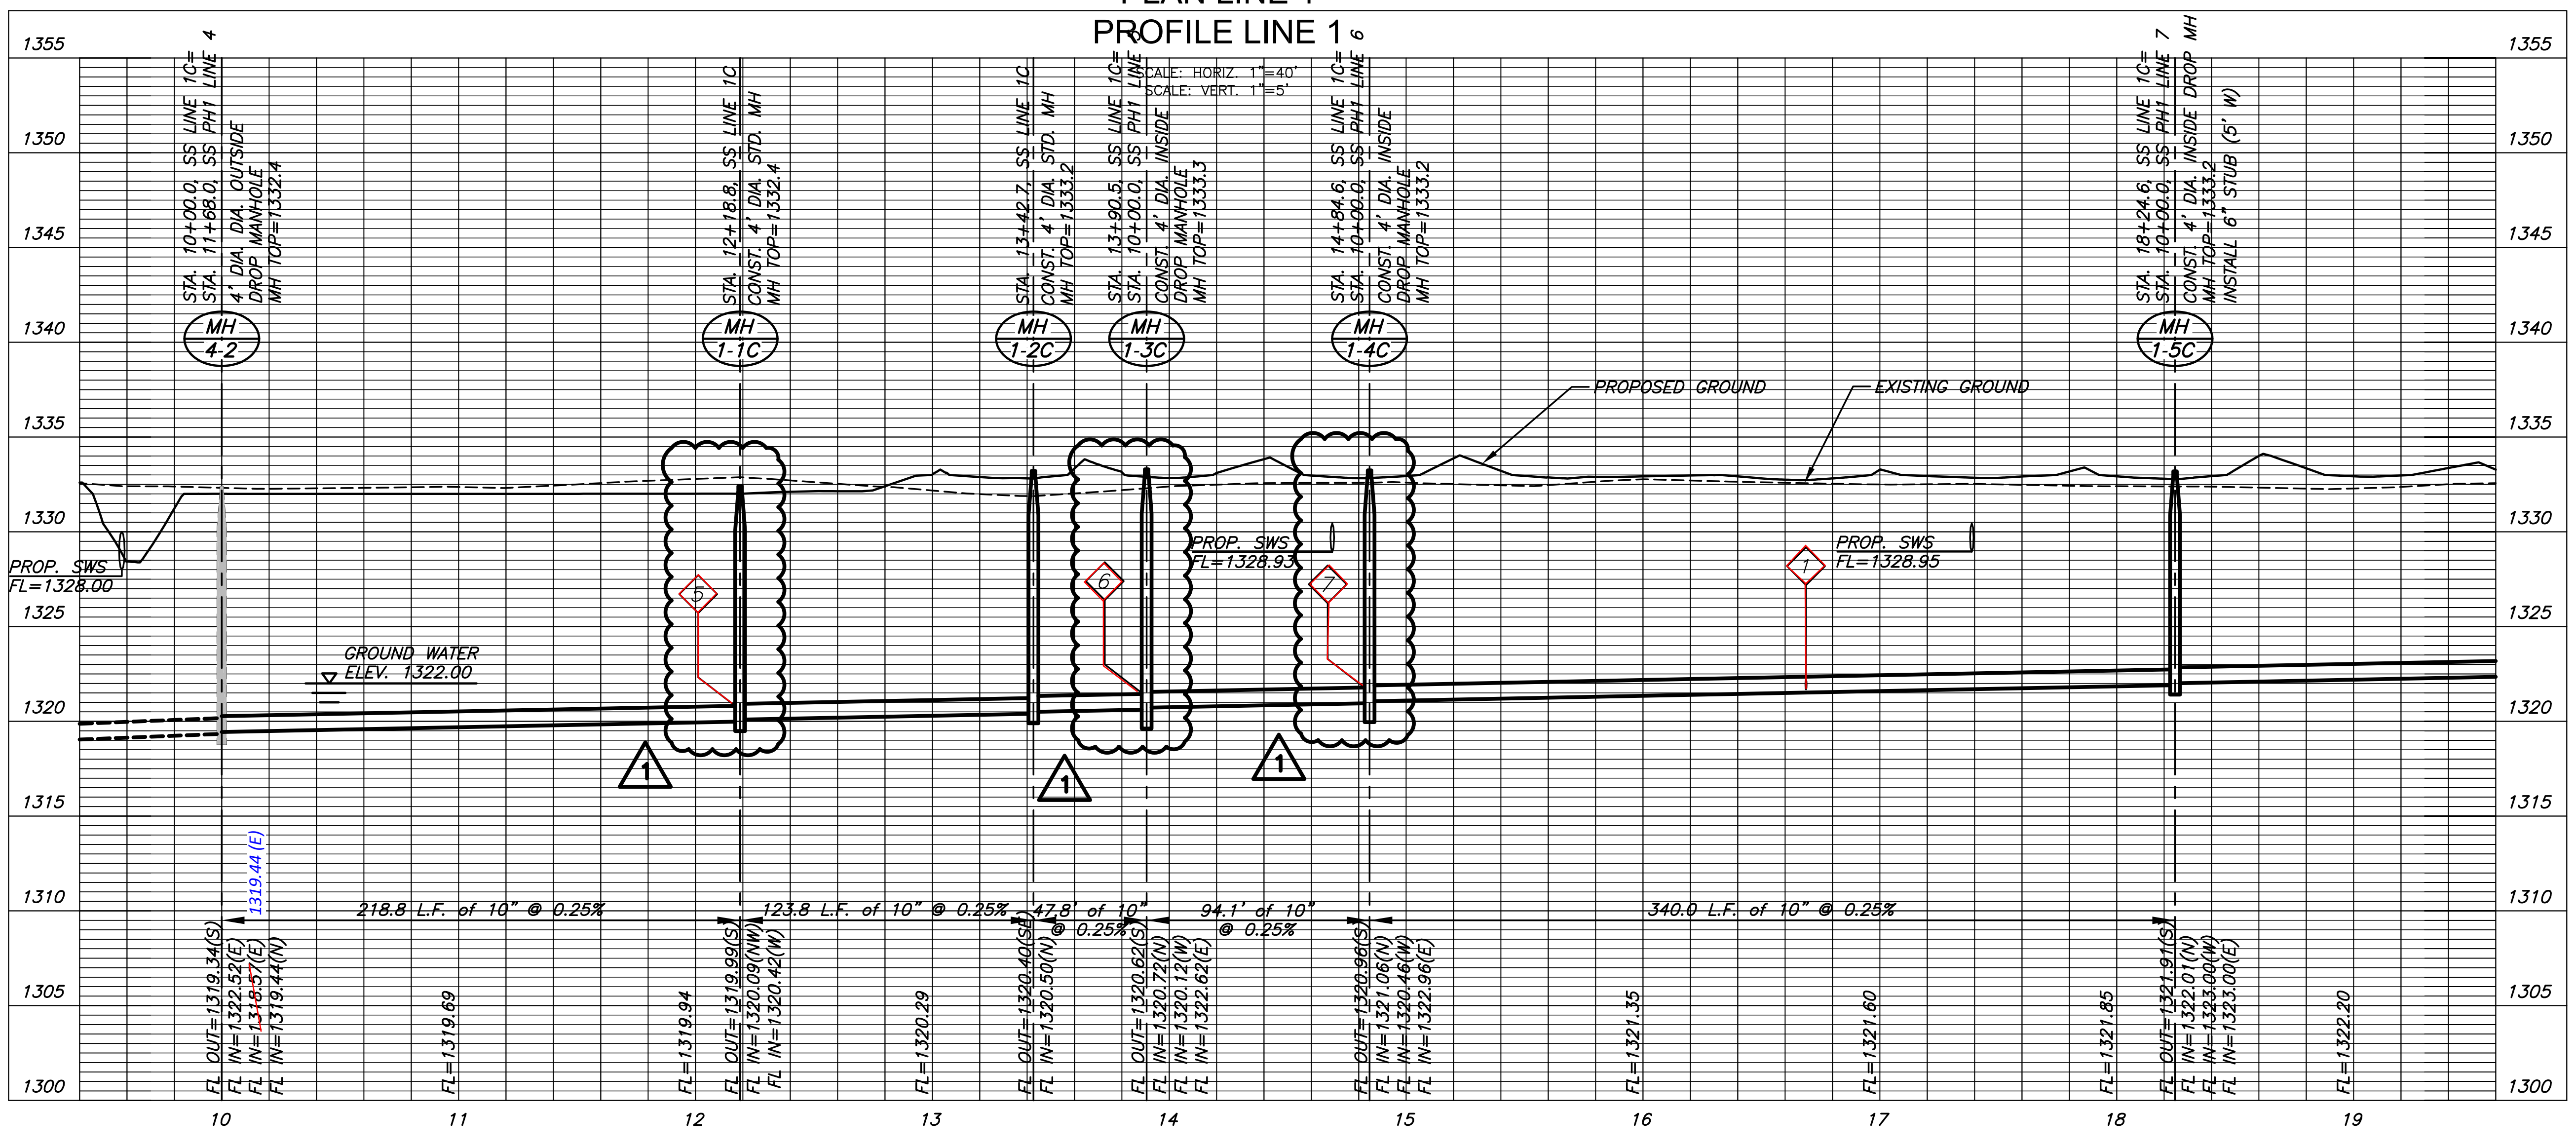

J:\PROJECTS\2015\1401010482_PREMIER_ESTANCIA\5-CIVIL\CADD\SANCOMMERCIAL\1482-BP010.DWG
 PLOTTED: Tuesday, October 27, 2015 @ 03:54PM