
  
 GREGORY J. ALLISON  
 LICENSED PROFESSIONAL ENGINEER  
 KANSAS  
 11159  
 10/13/15

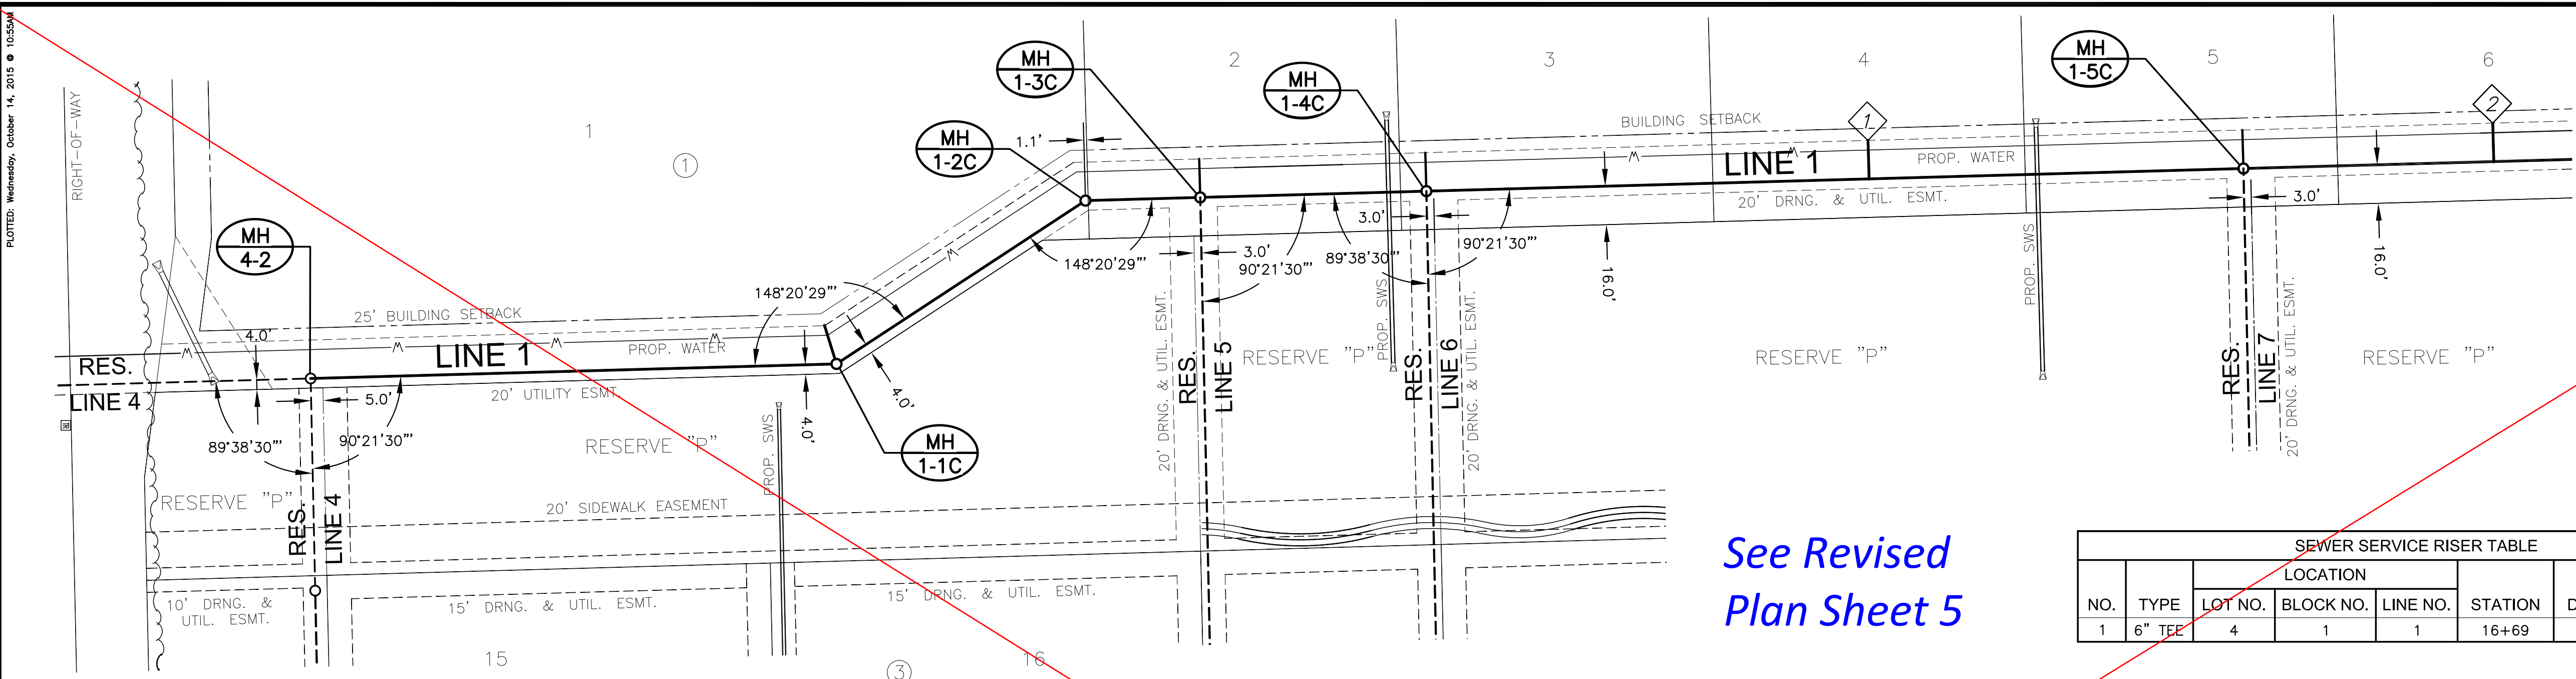


**NOTE:**  
CONTRACTOR TO VERIFY THE DEPTH AND LOCATION OF EXISTING UTILITIES PRIOR TO CONSTRUCTION.

See Revised  
Plan Sheet 5

SEWER SERVICE RISER TABLE							FOR INFORMATION ONLY	
NO.	TYPE	LOCATION			STATION	DIRECTION	APPROXIMATE LENGTH	
		LOT NO.	BLOCK NO.	LINE NO.			VERTICAL (FT)	HORIZONTAL (FT)
1	6" TEE	4	1	1	16+69	LT.	10'	16'

PLAN LINE 1  
PROFILE LINE 1 6

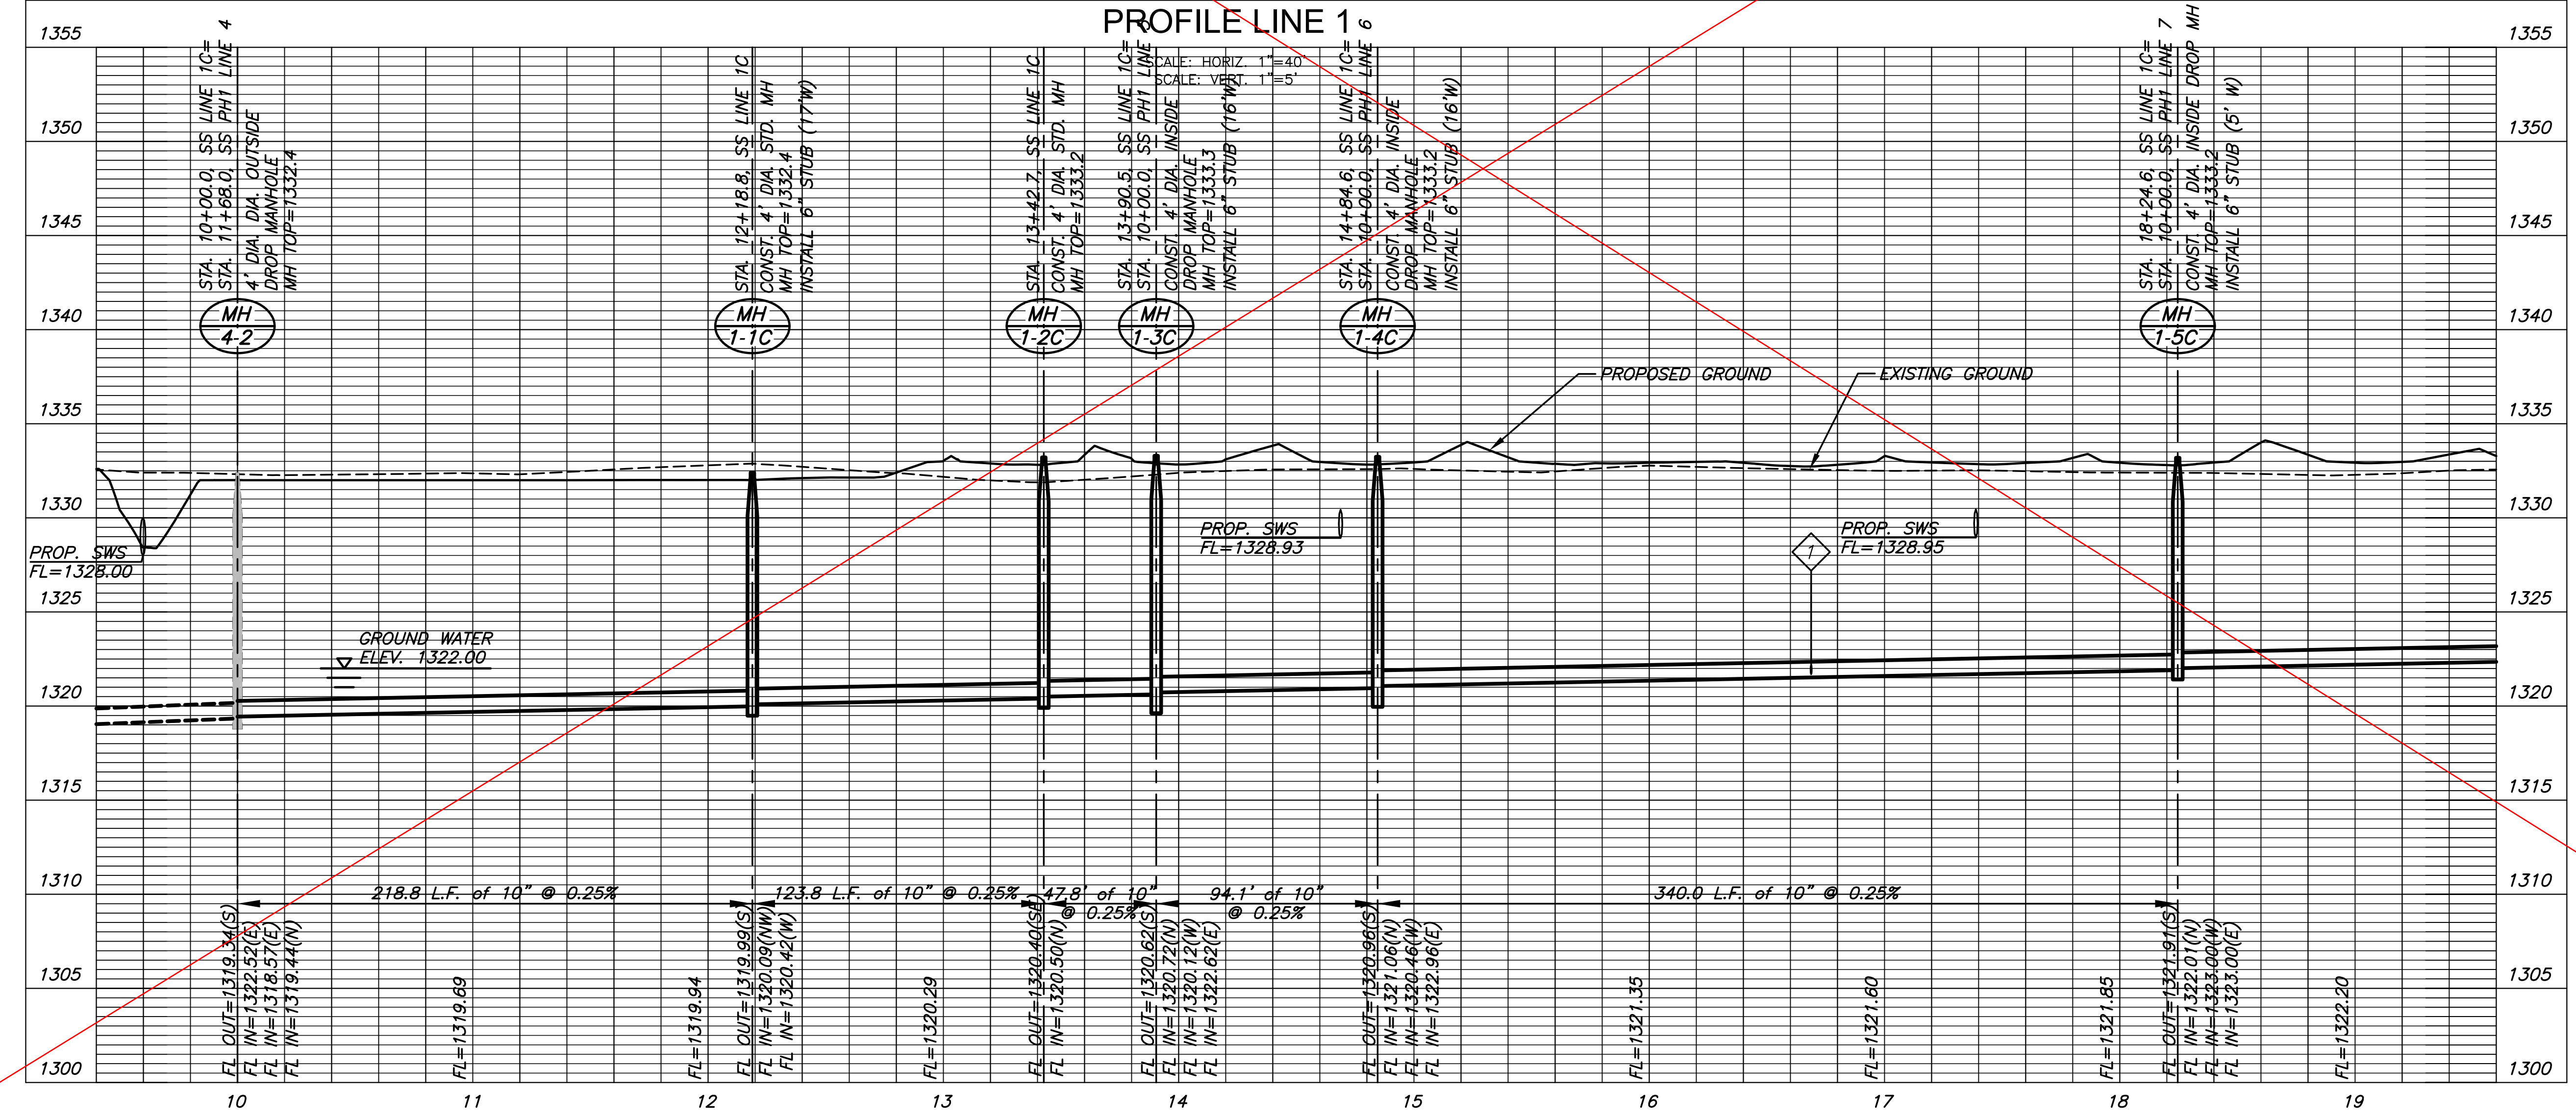

©2015 MKEC Engineering All Rights Reserved  
 These drawings and their contents, including, but not limited to, all concepts, designs, & ideas are the exclusive property of MKEC Engineering (MKEC), and may not be used or reproduced in any way without the express consent of MKEC.

**SAN LINE 1**

PROJECT NO.	468-85069	
DATE	OCT. 2015	
SCALE	1"=40'	
DESIGNED	DRAWN	CHECKED
DFL	TKL	GJA

NO.	REVISION	DATE