



J:\PROJECTS\2014\10\10\10462_PREMIER_ESTANCIA\DWG\CIVIL\CAD\SAN\COMMERCIAL\10462-BP-02C.DWG
 J:\PROJECTS\2014\10\10\10462_PREMIER_ESTANCIA\DWG\CIVIL\CAD\COMMERCIAL\10462-BP-02C.DWG
 PLOTTED: Wednesday, October 14, 2015 @ 10:56AM

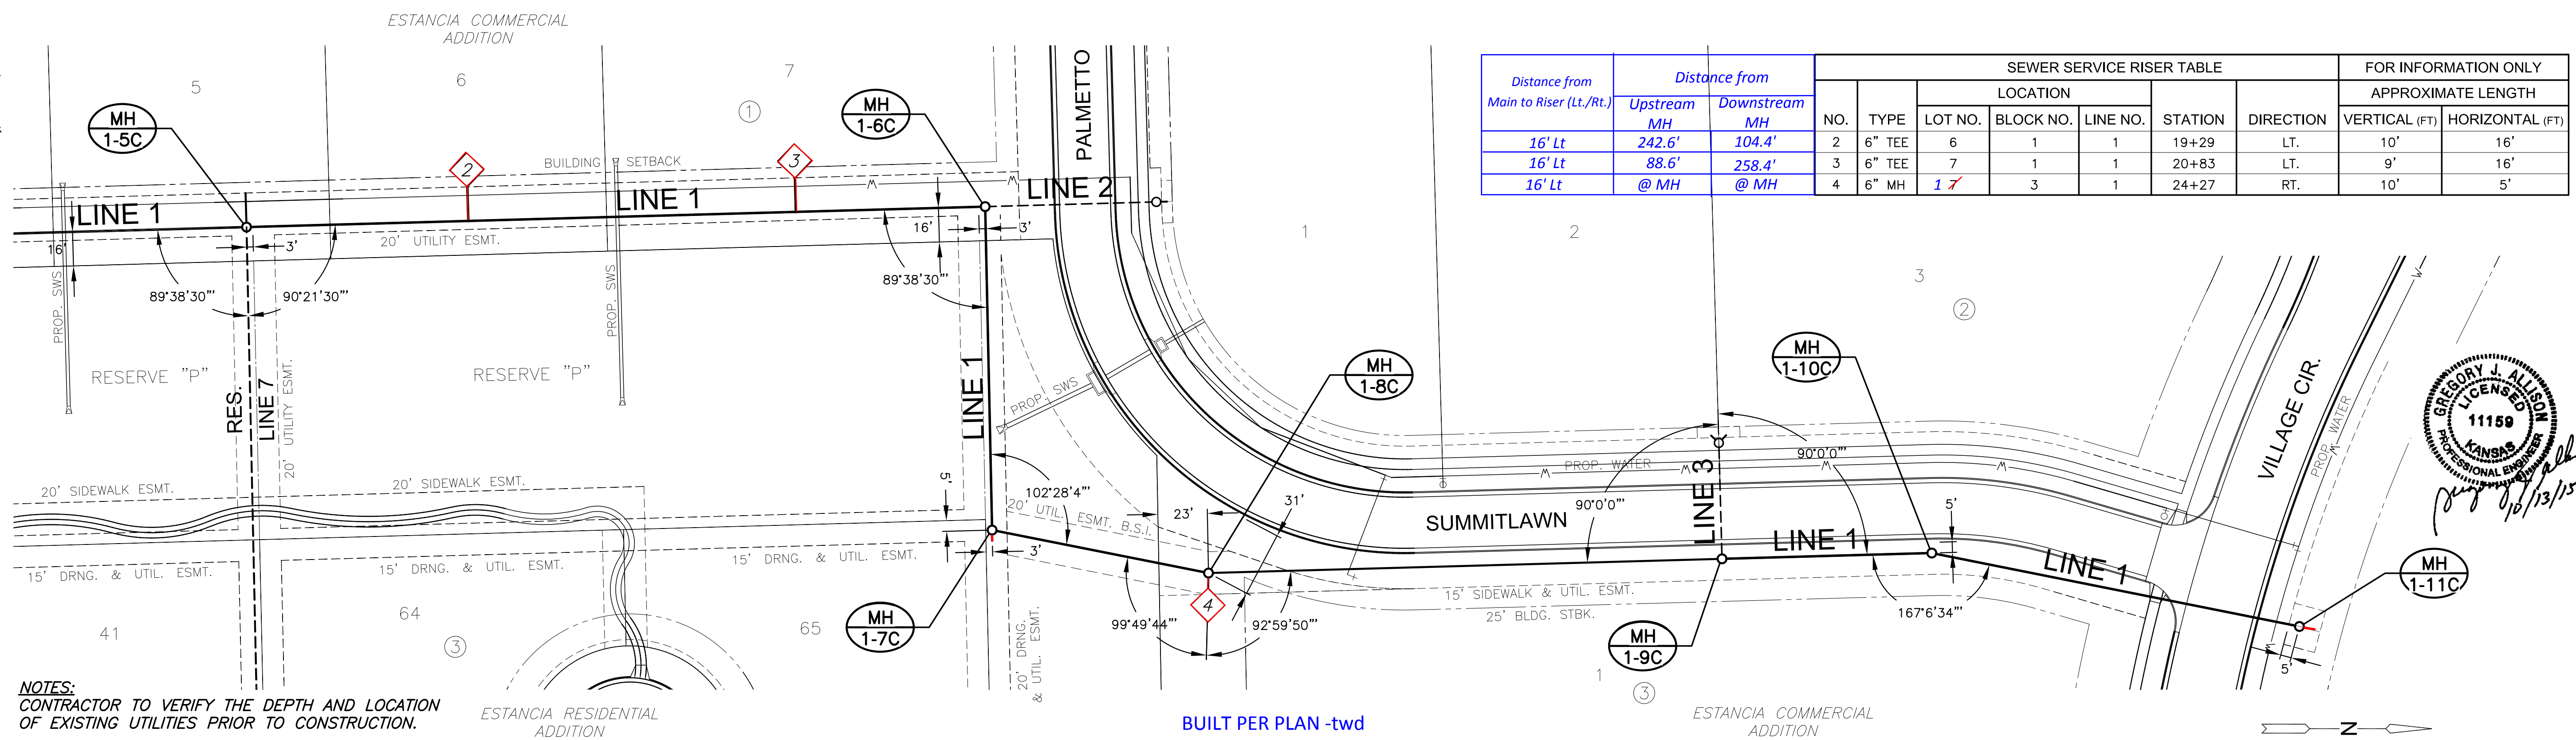


Distance from Main to Riser (Lt./Rt.)	Distance from		SEWER SERVICE RISER TABLE					FOR INFORMATION ONLY		
	Upstream MH	Downstream MH	NO.	TYPE	LOT NO.	BLOCK NO.	LINE NO.	STATION	DIRECTION	APPROXIMATE LENGTH
16' Lt	242.6'	104.4'	2	6" TEE	6	1	1	19+29	LT.	10' 16'
16' Lt	88.6'	258.4'	3	6" TEE	7	1	1	20+83	LT.	9' 16'
16' Lt	@ MH	@ MH	4	6" MH	17	3	1	24+27	RT.	10' 5'

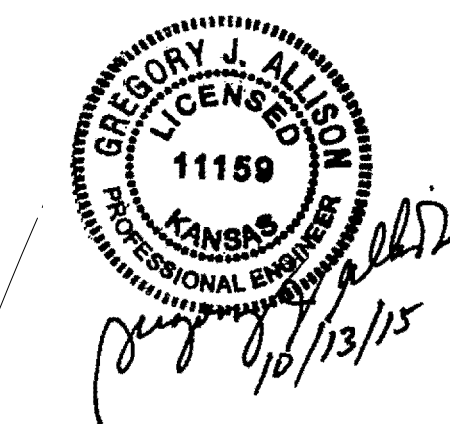

NOTES:
 CONTRACTOR TO VERIFY THE DEPTH AND LOCATION OF EXISTING UTILITIES PRIOR TO CONSTRUCTION.
 TRENCHES TO BE BACKFILLED WITH SAND AND FLUSHED/VIBRATED WHEN SWS LINE ARE WITHIN RIGHT-OF-WAY AND FRONT YARD UTILITY EASEMENTS.

PLAN LINE 1 (CONT.)
 PROFILE LINE 1 (CONT.)

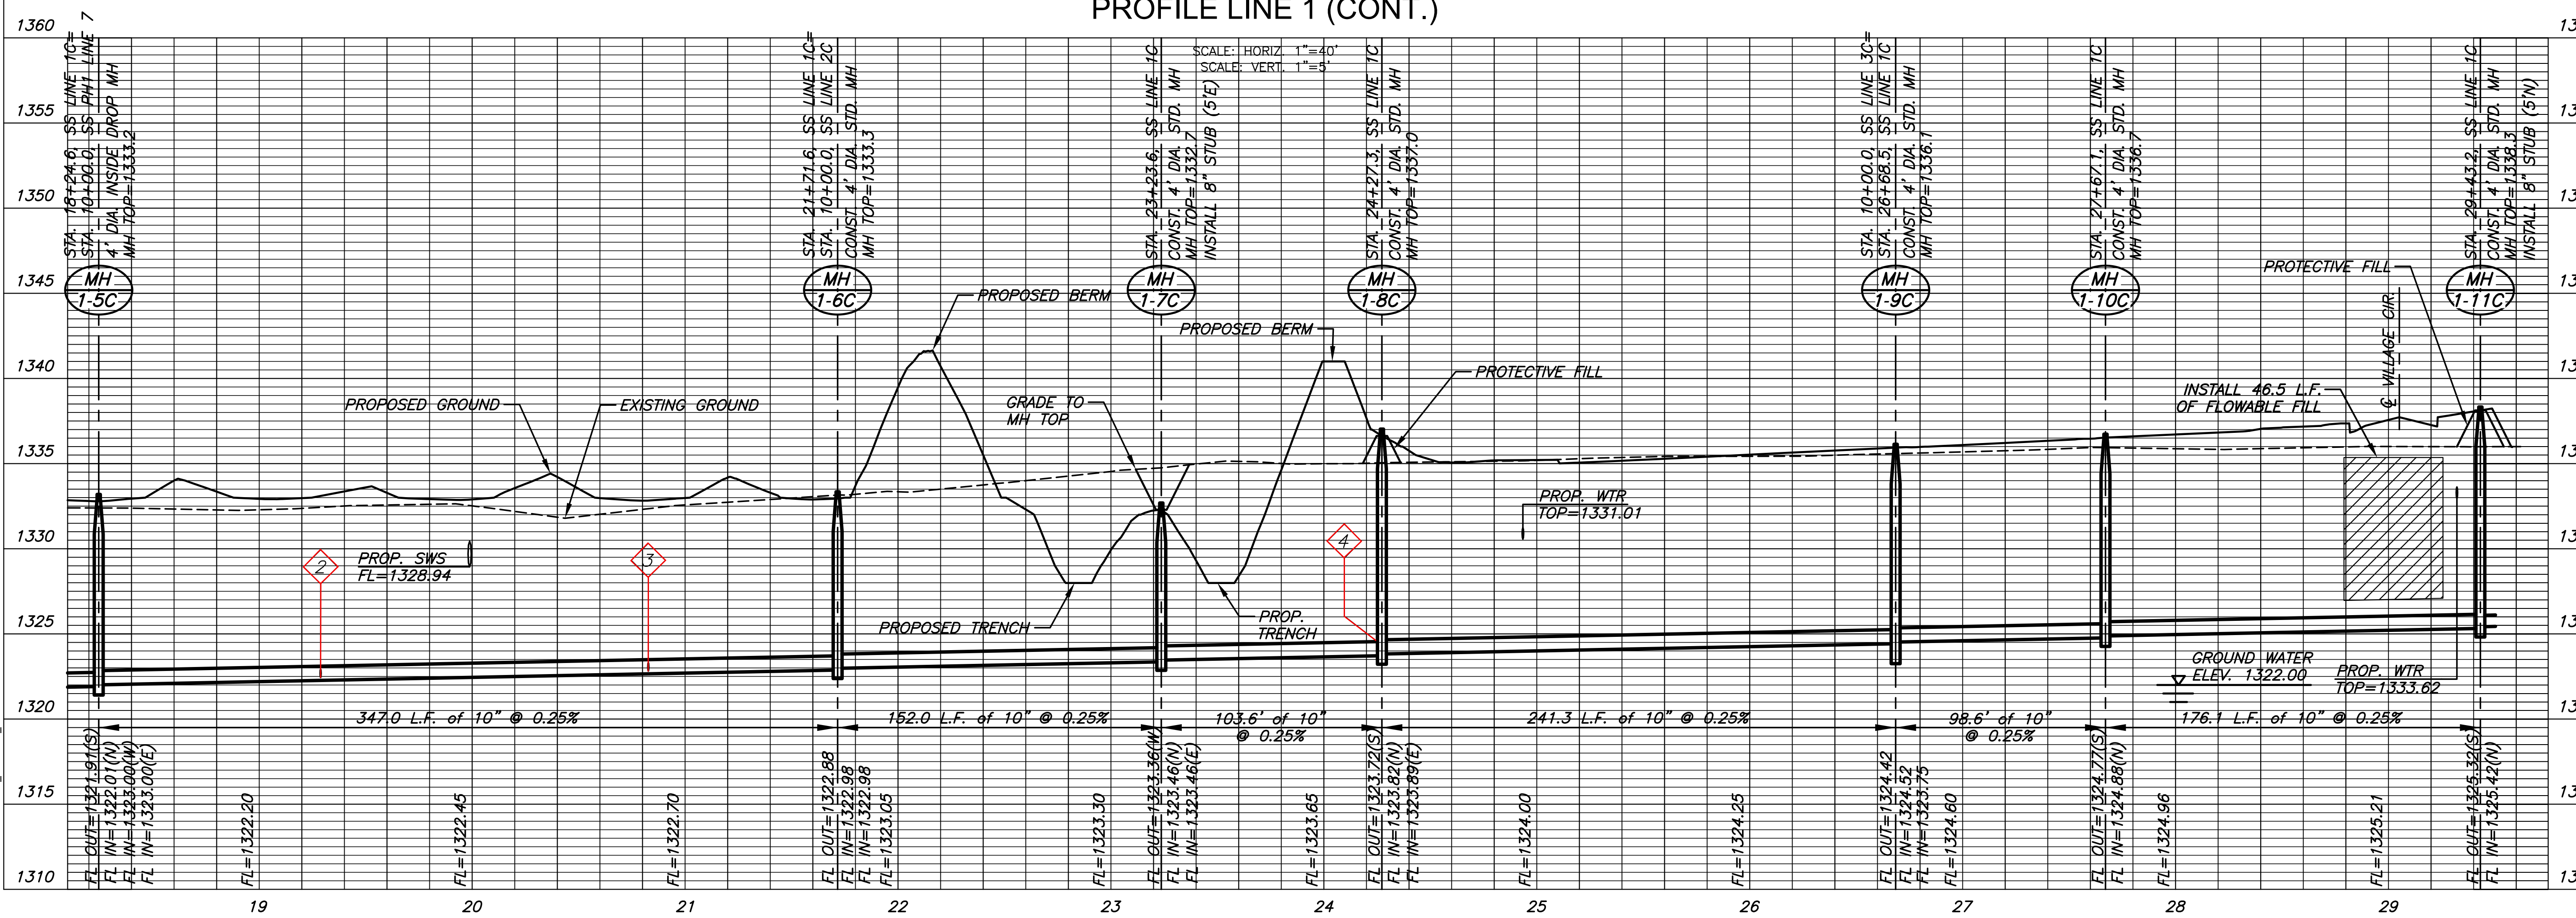

SANITARY SEWER PLANS FOR
ESTANCIA COMMERCIAL ADDITION
 COMMERCIAL PHASE 1

©2015 MKEC Engineering All Rights Reserved
 These drawings and their contents, including, but not limited to, all concepts, designs, & ideas are the exclusive property of MKEC Engineering (MKEC), and may not be used or reproduced in any way without the express consent of MKEC.

SAN LINE 1	
PROJECT NO.	468-85069
DATE	OCT. 2015
SCALE	1"=40'
DESIGNED	DRAWN
DFL	TKL
CHECKED	GJA
NO.	REVISION
DATE	
SHEET NO.	
6 OF 14	