

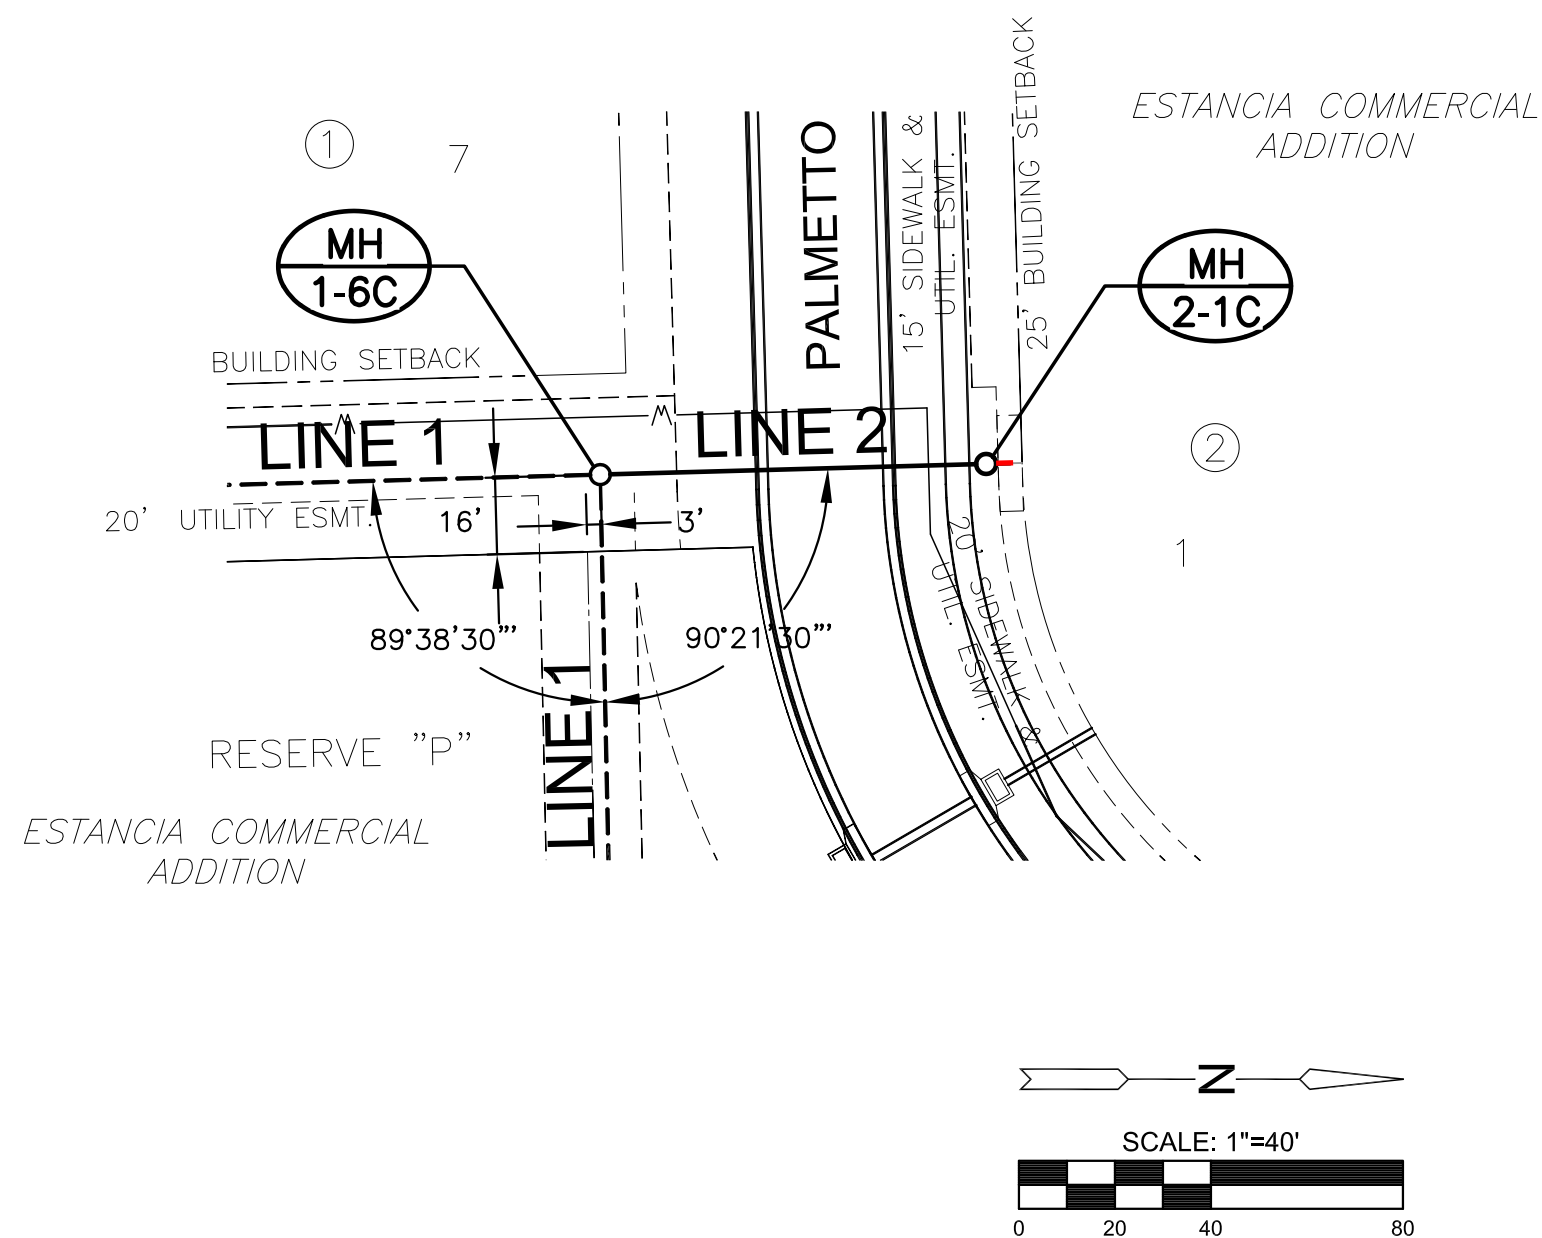


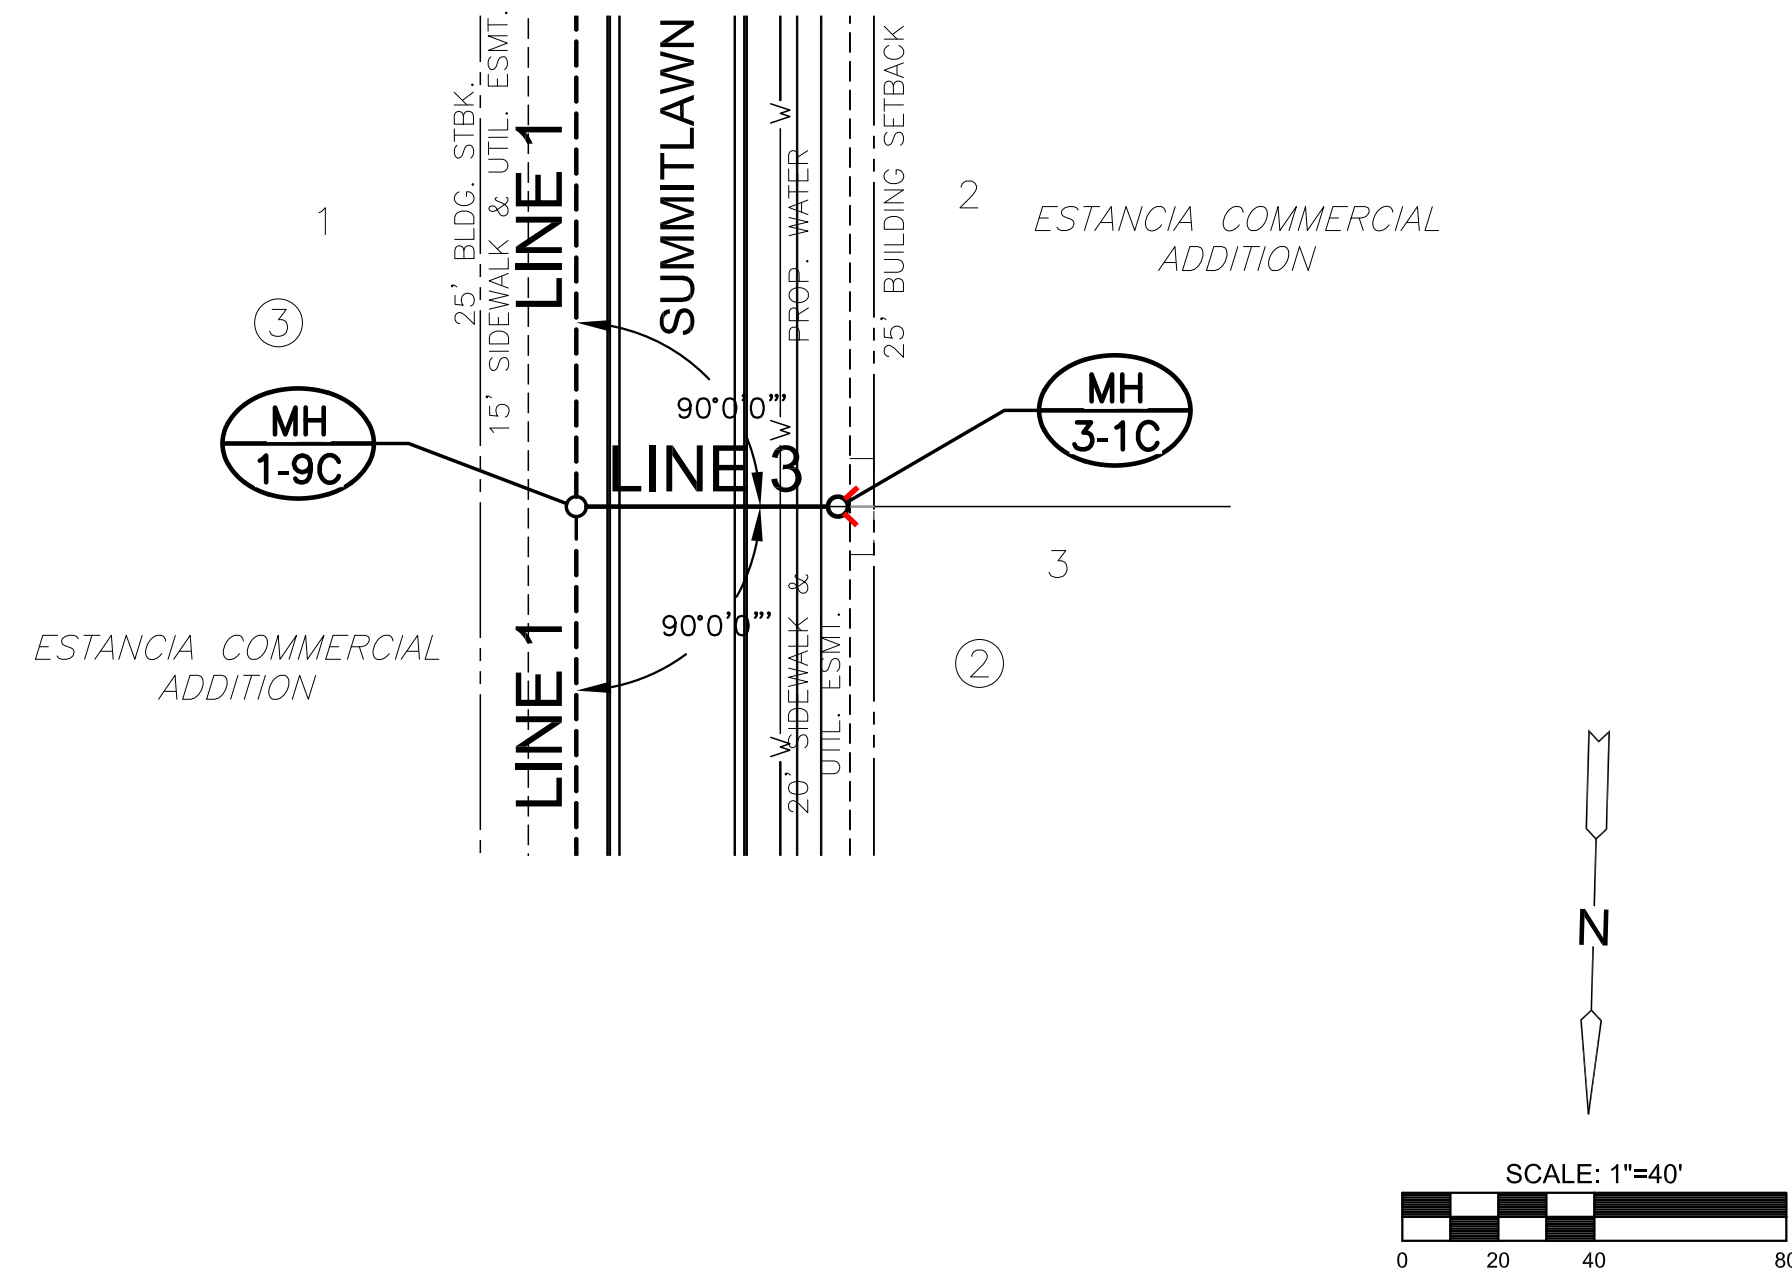


NOTE:
CONTRACTOR TO VERIFY THE
DEPTH AND LOCATION OF EXISTING
UTILITIES PRIOR TO CONSTRUCTION.

BUILT PER PLAN -twd

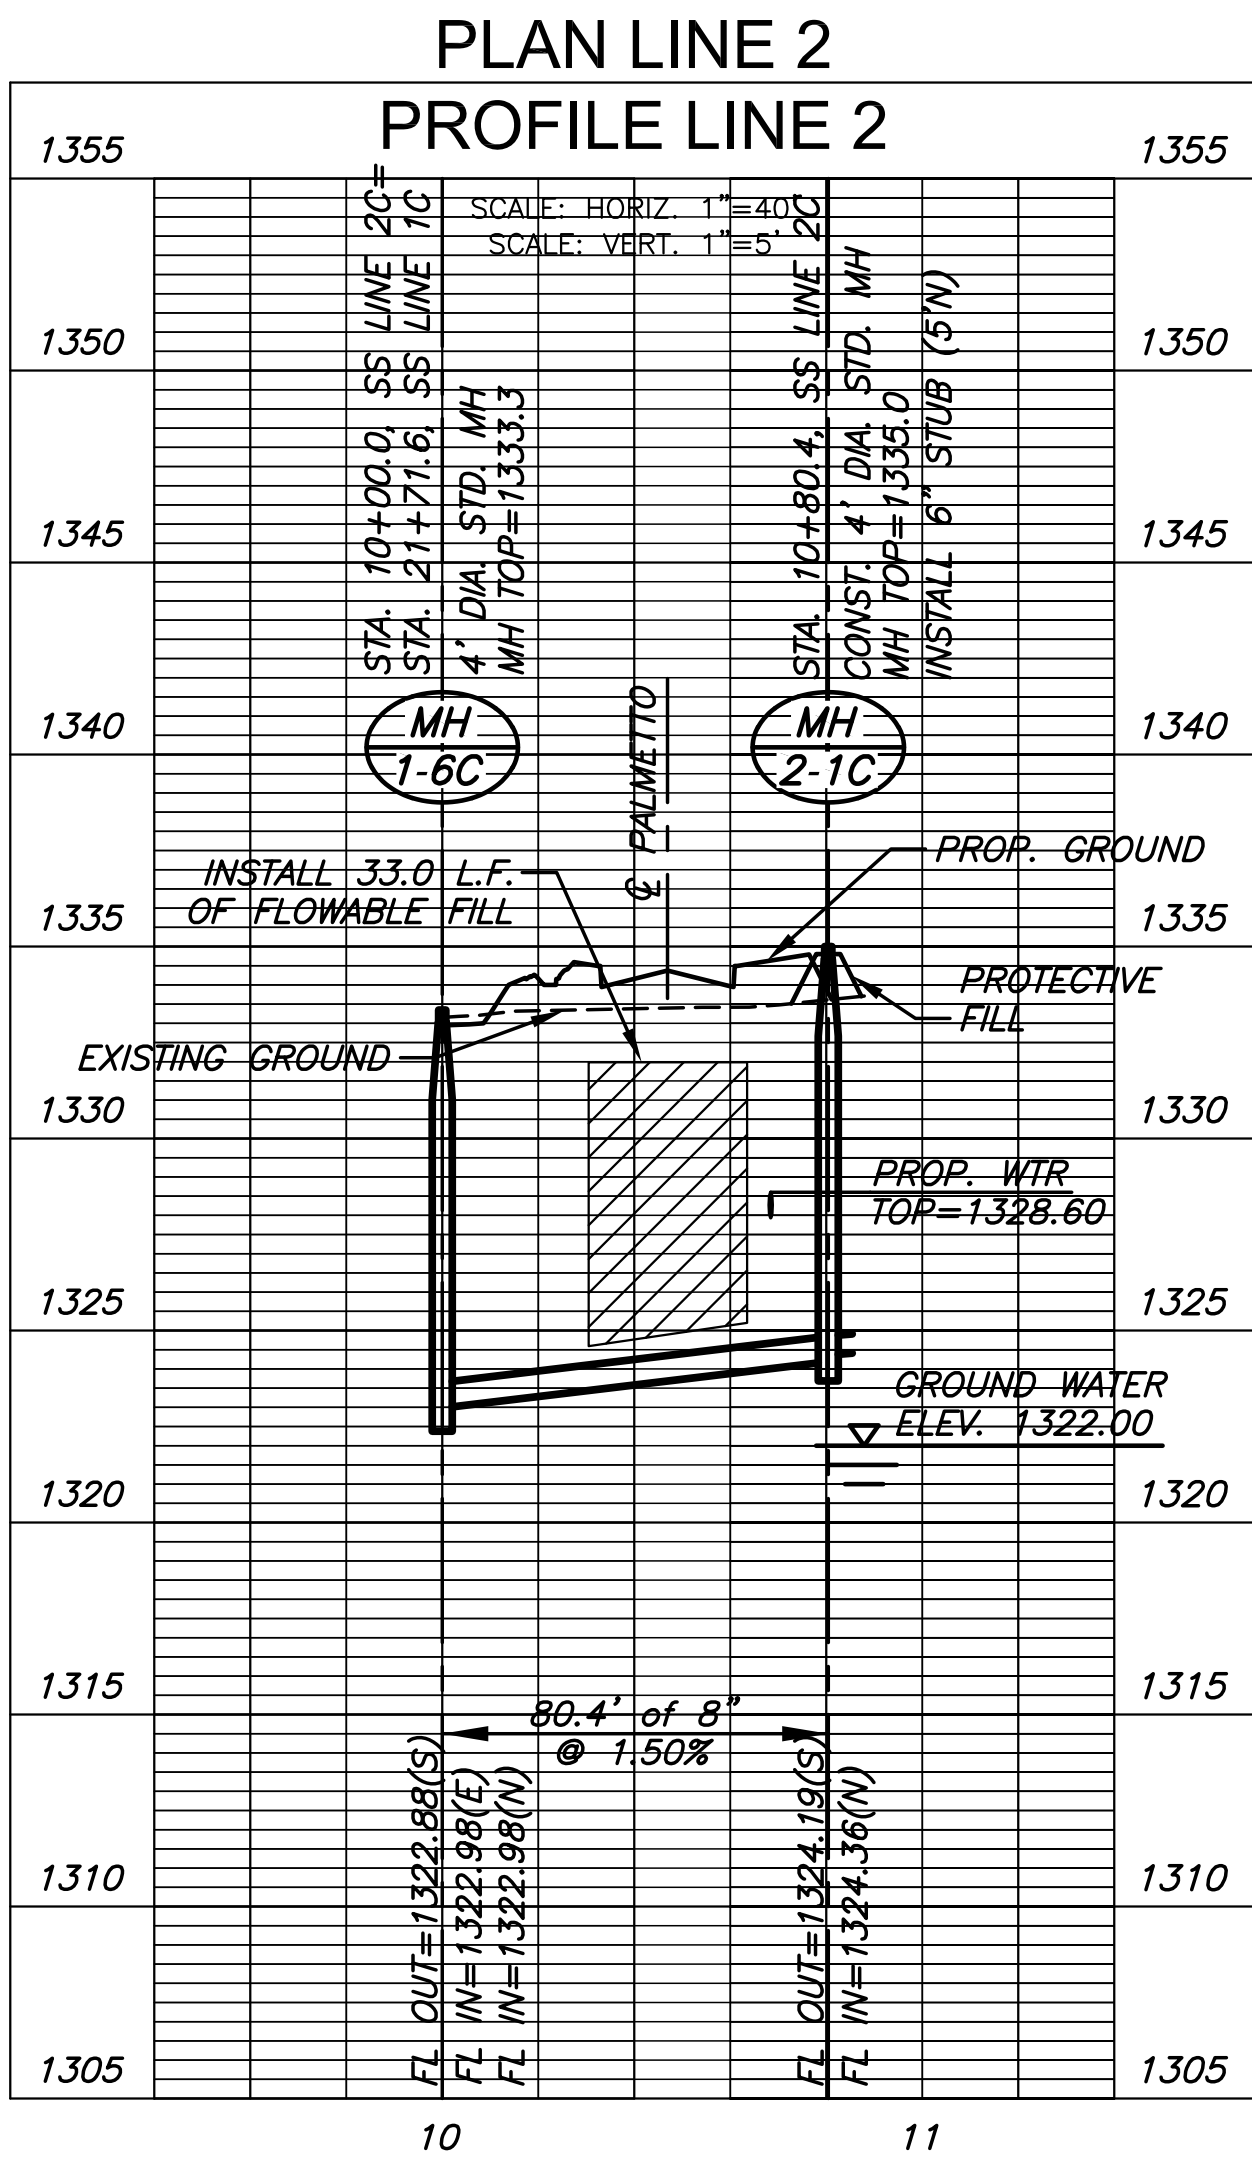

BUILT PER PLAN -twd

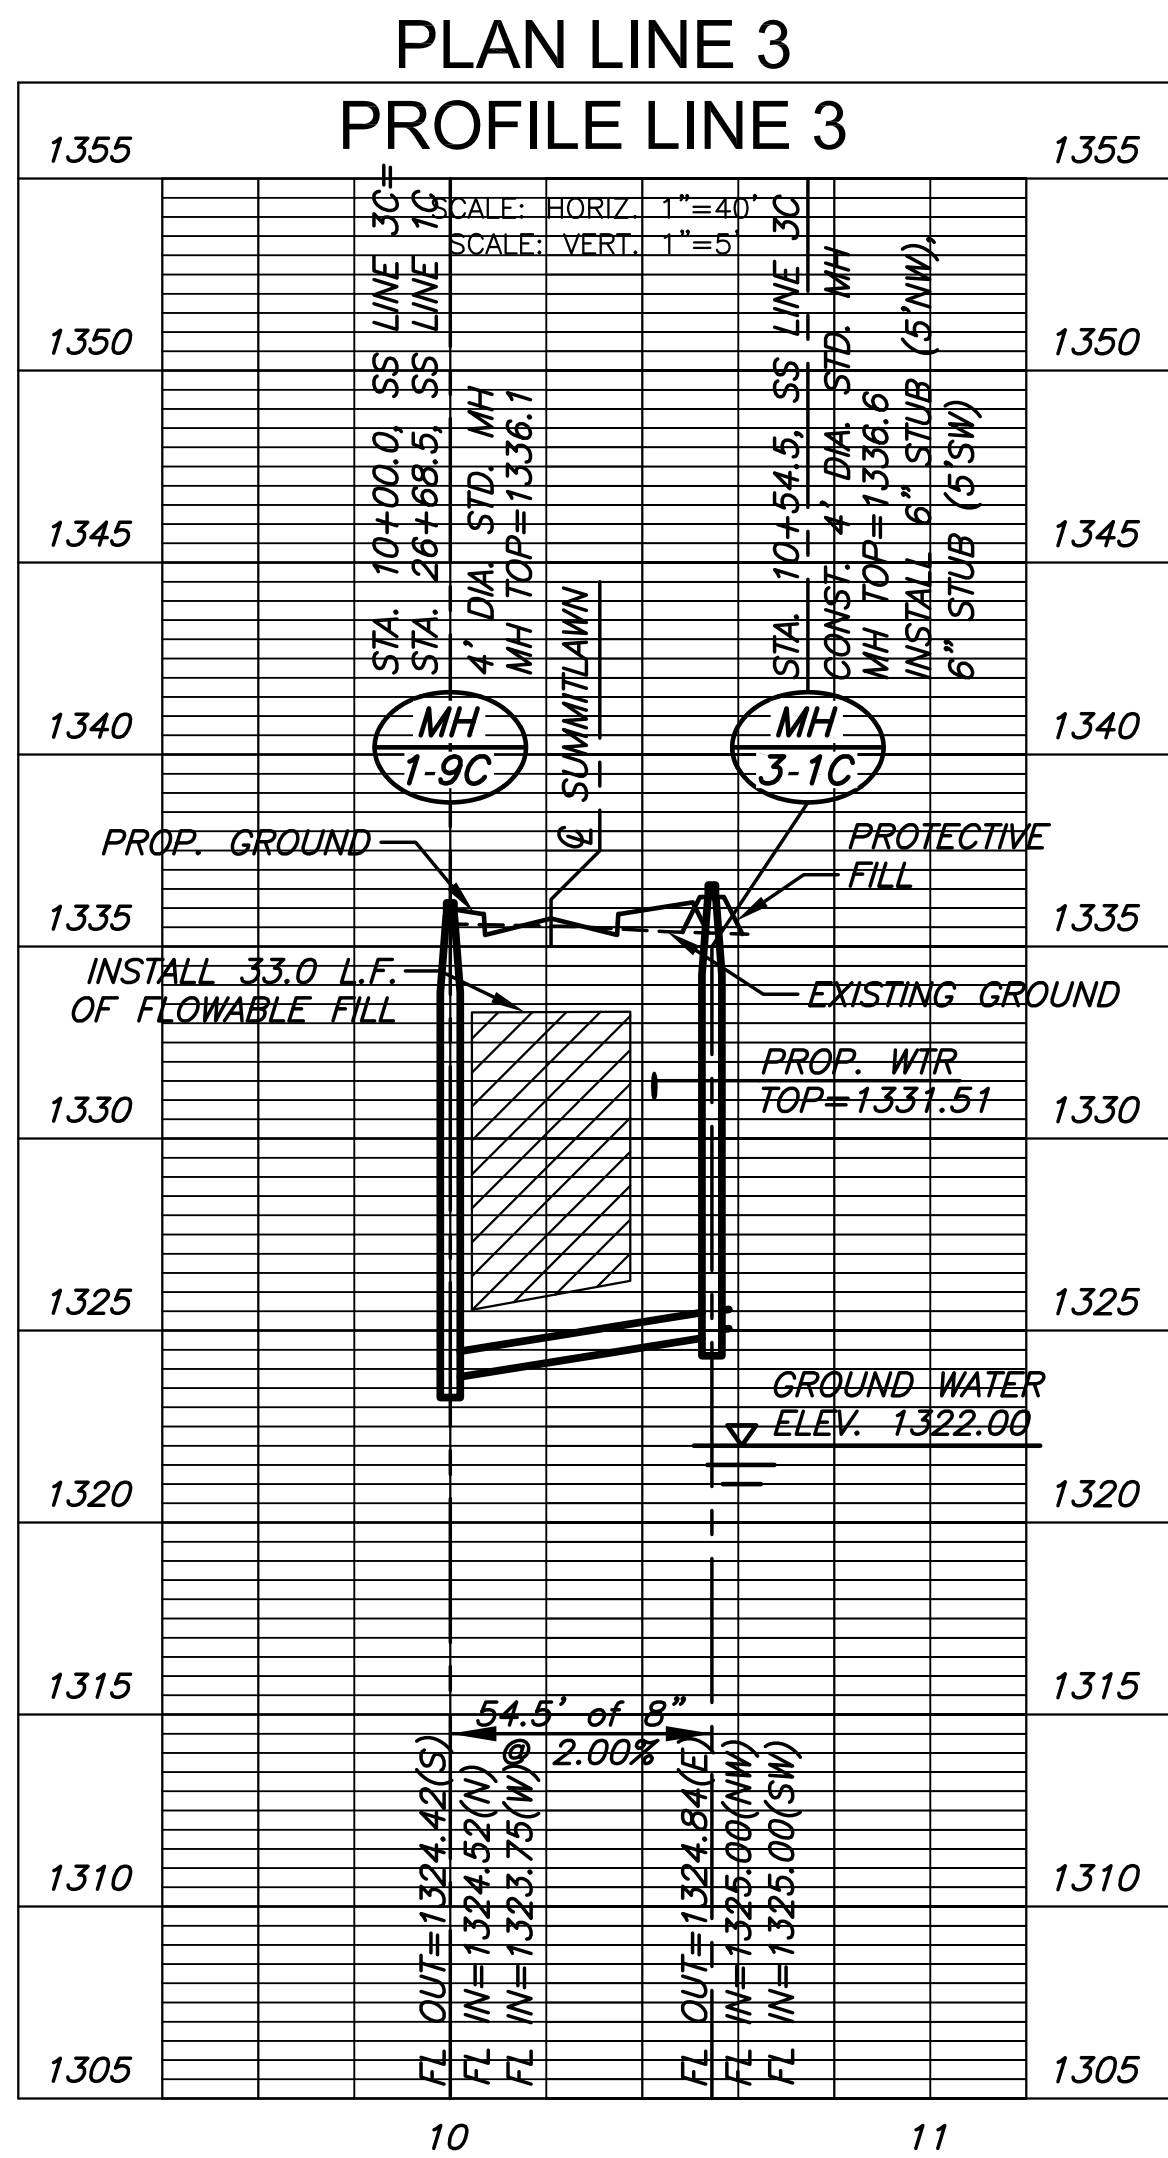

GREGORY J. ALLISON
LICENSED PROFESSIONAL ENGINEER
KANSAS
11159
10/13/15