



PLOTTED: Wednesday, October 14, 2015 @ 11:50AM

J:\PROJECTS\2014\10\10462_PREMIER_ESTANCIA\DWG\CIVIL\CAD\RESIDENTIAL\1462-8P-03R.DWG

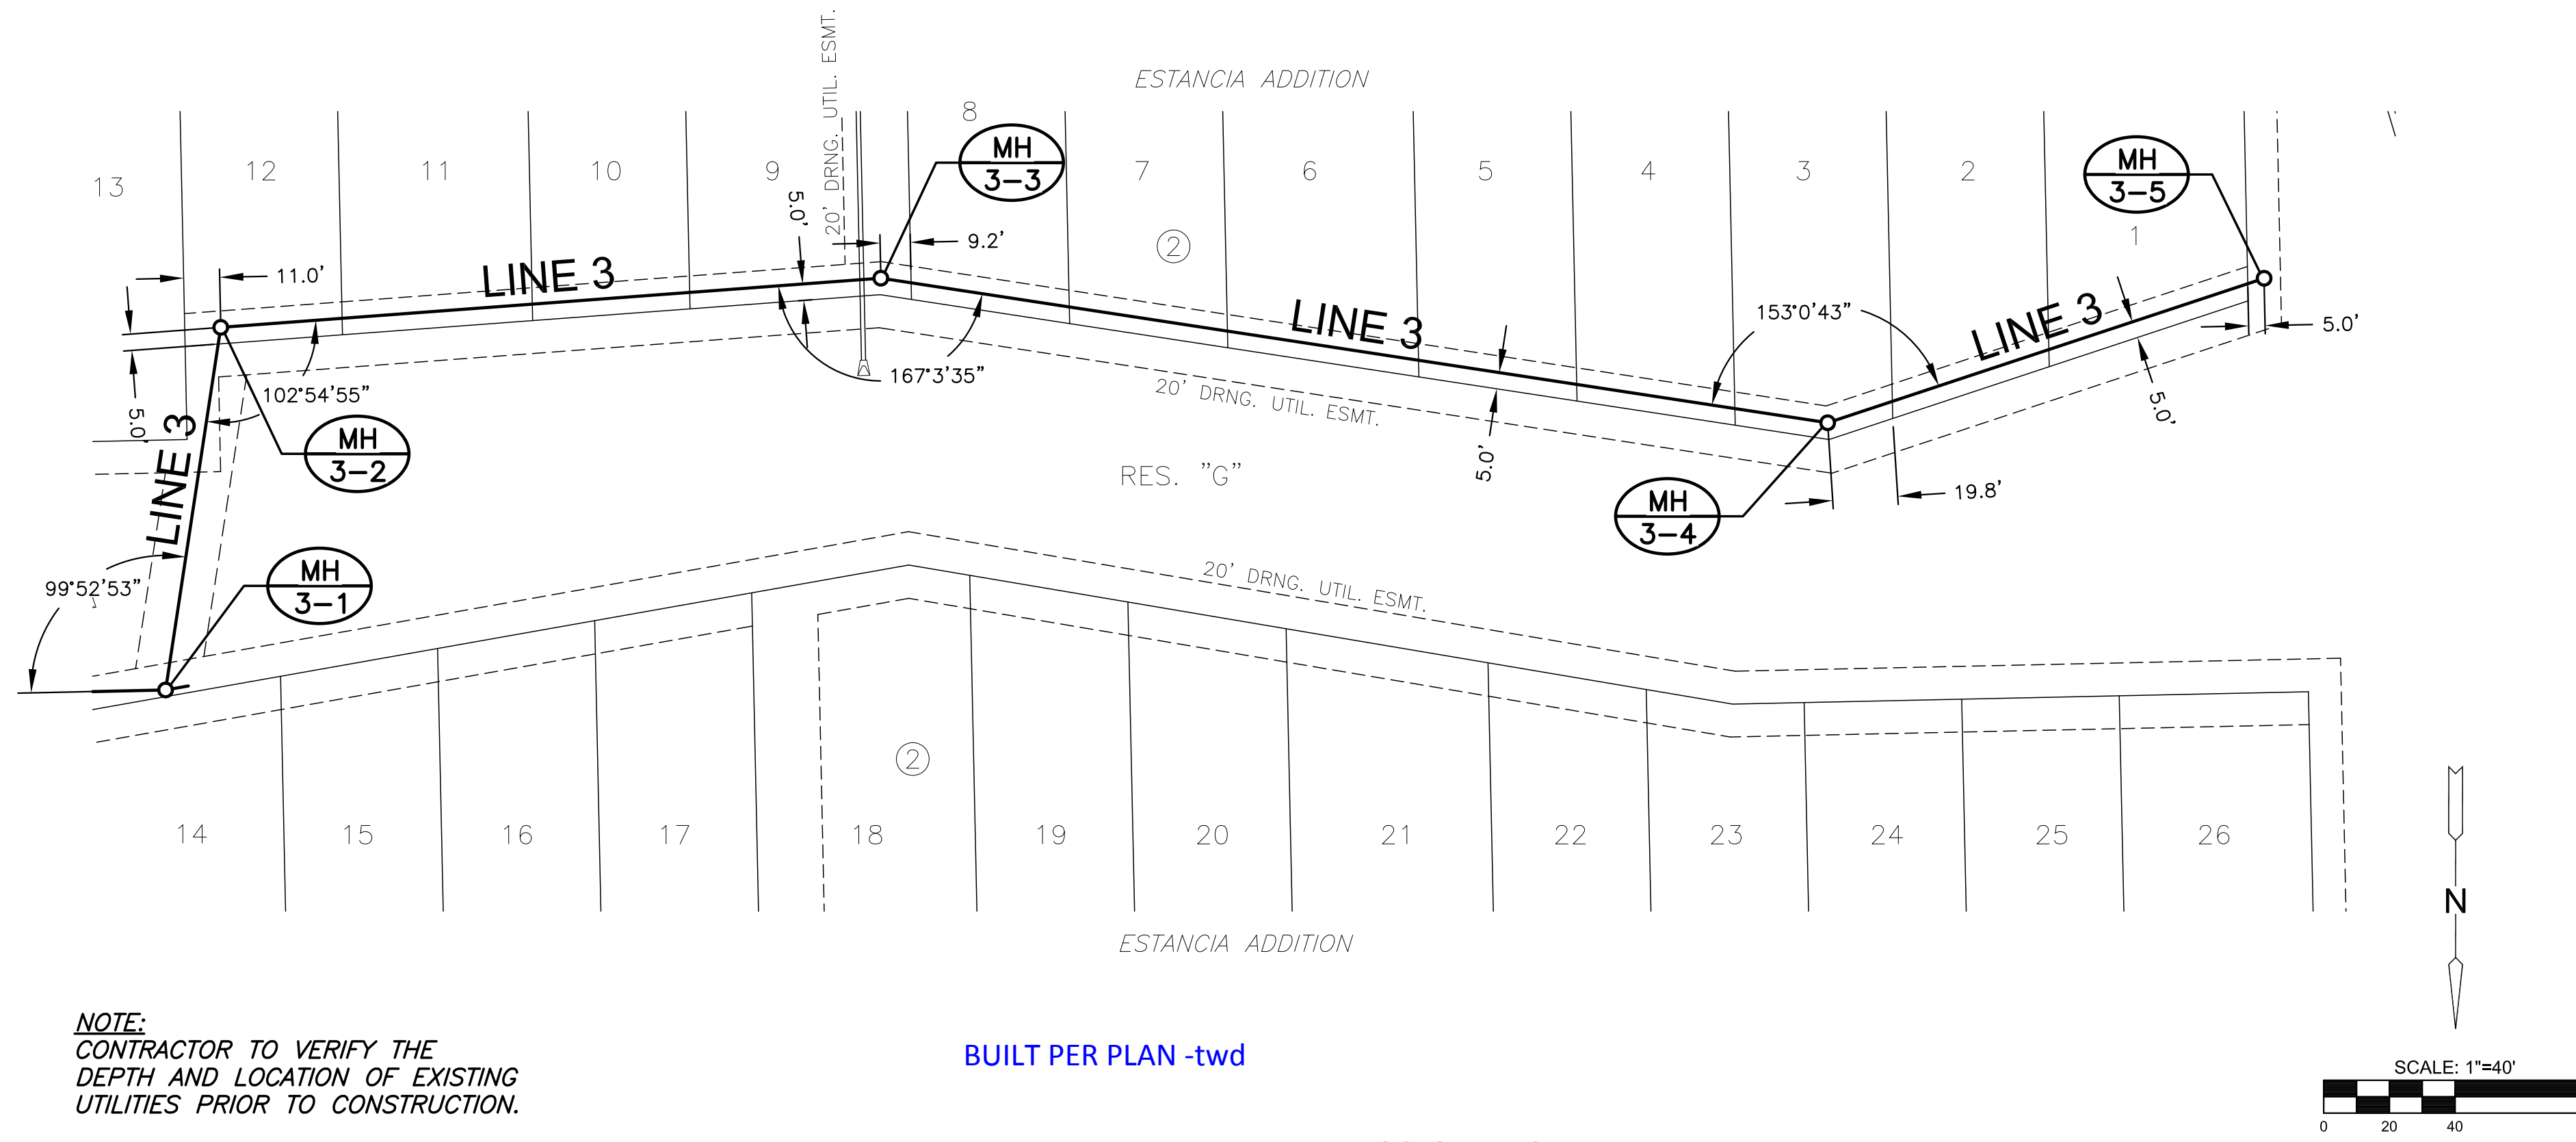

PLAN LINE 3 (CONT.)
PROFILE LINE 3 (CONT.)

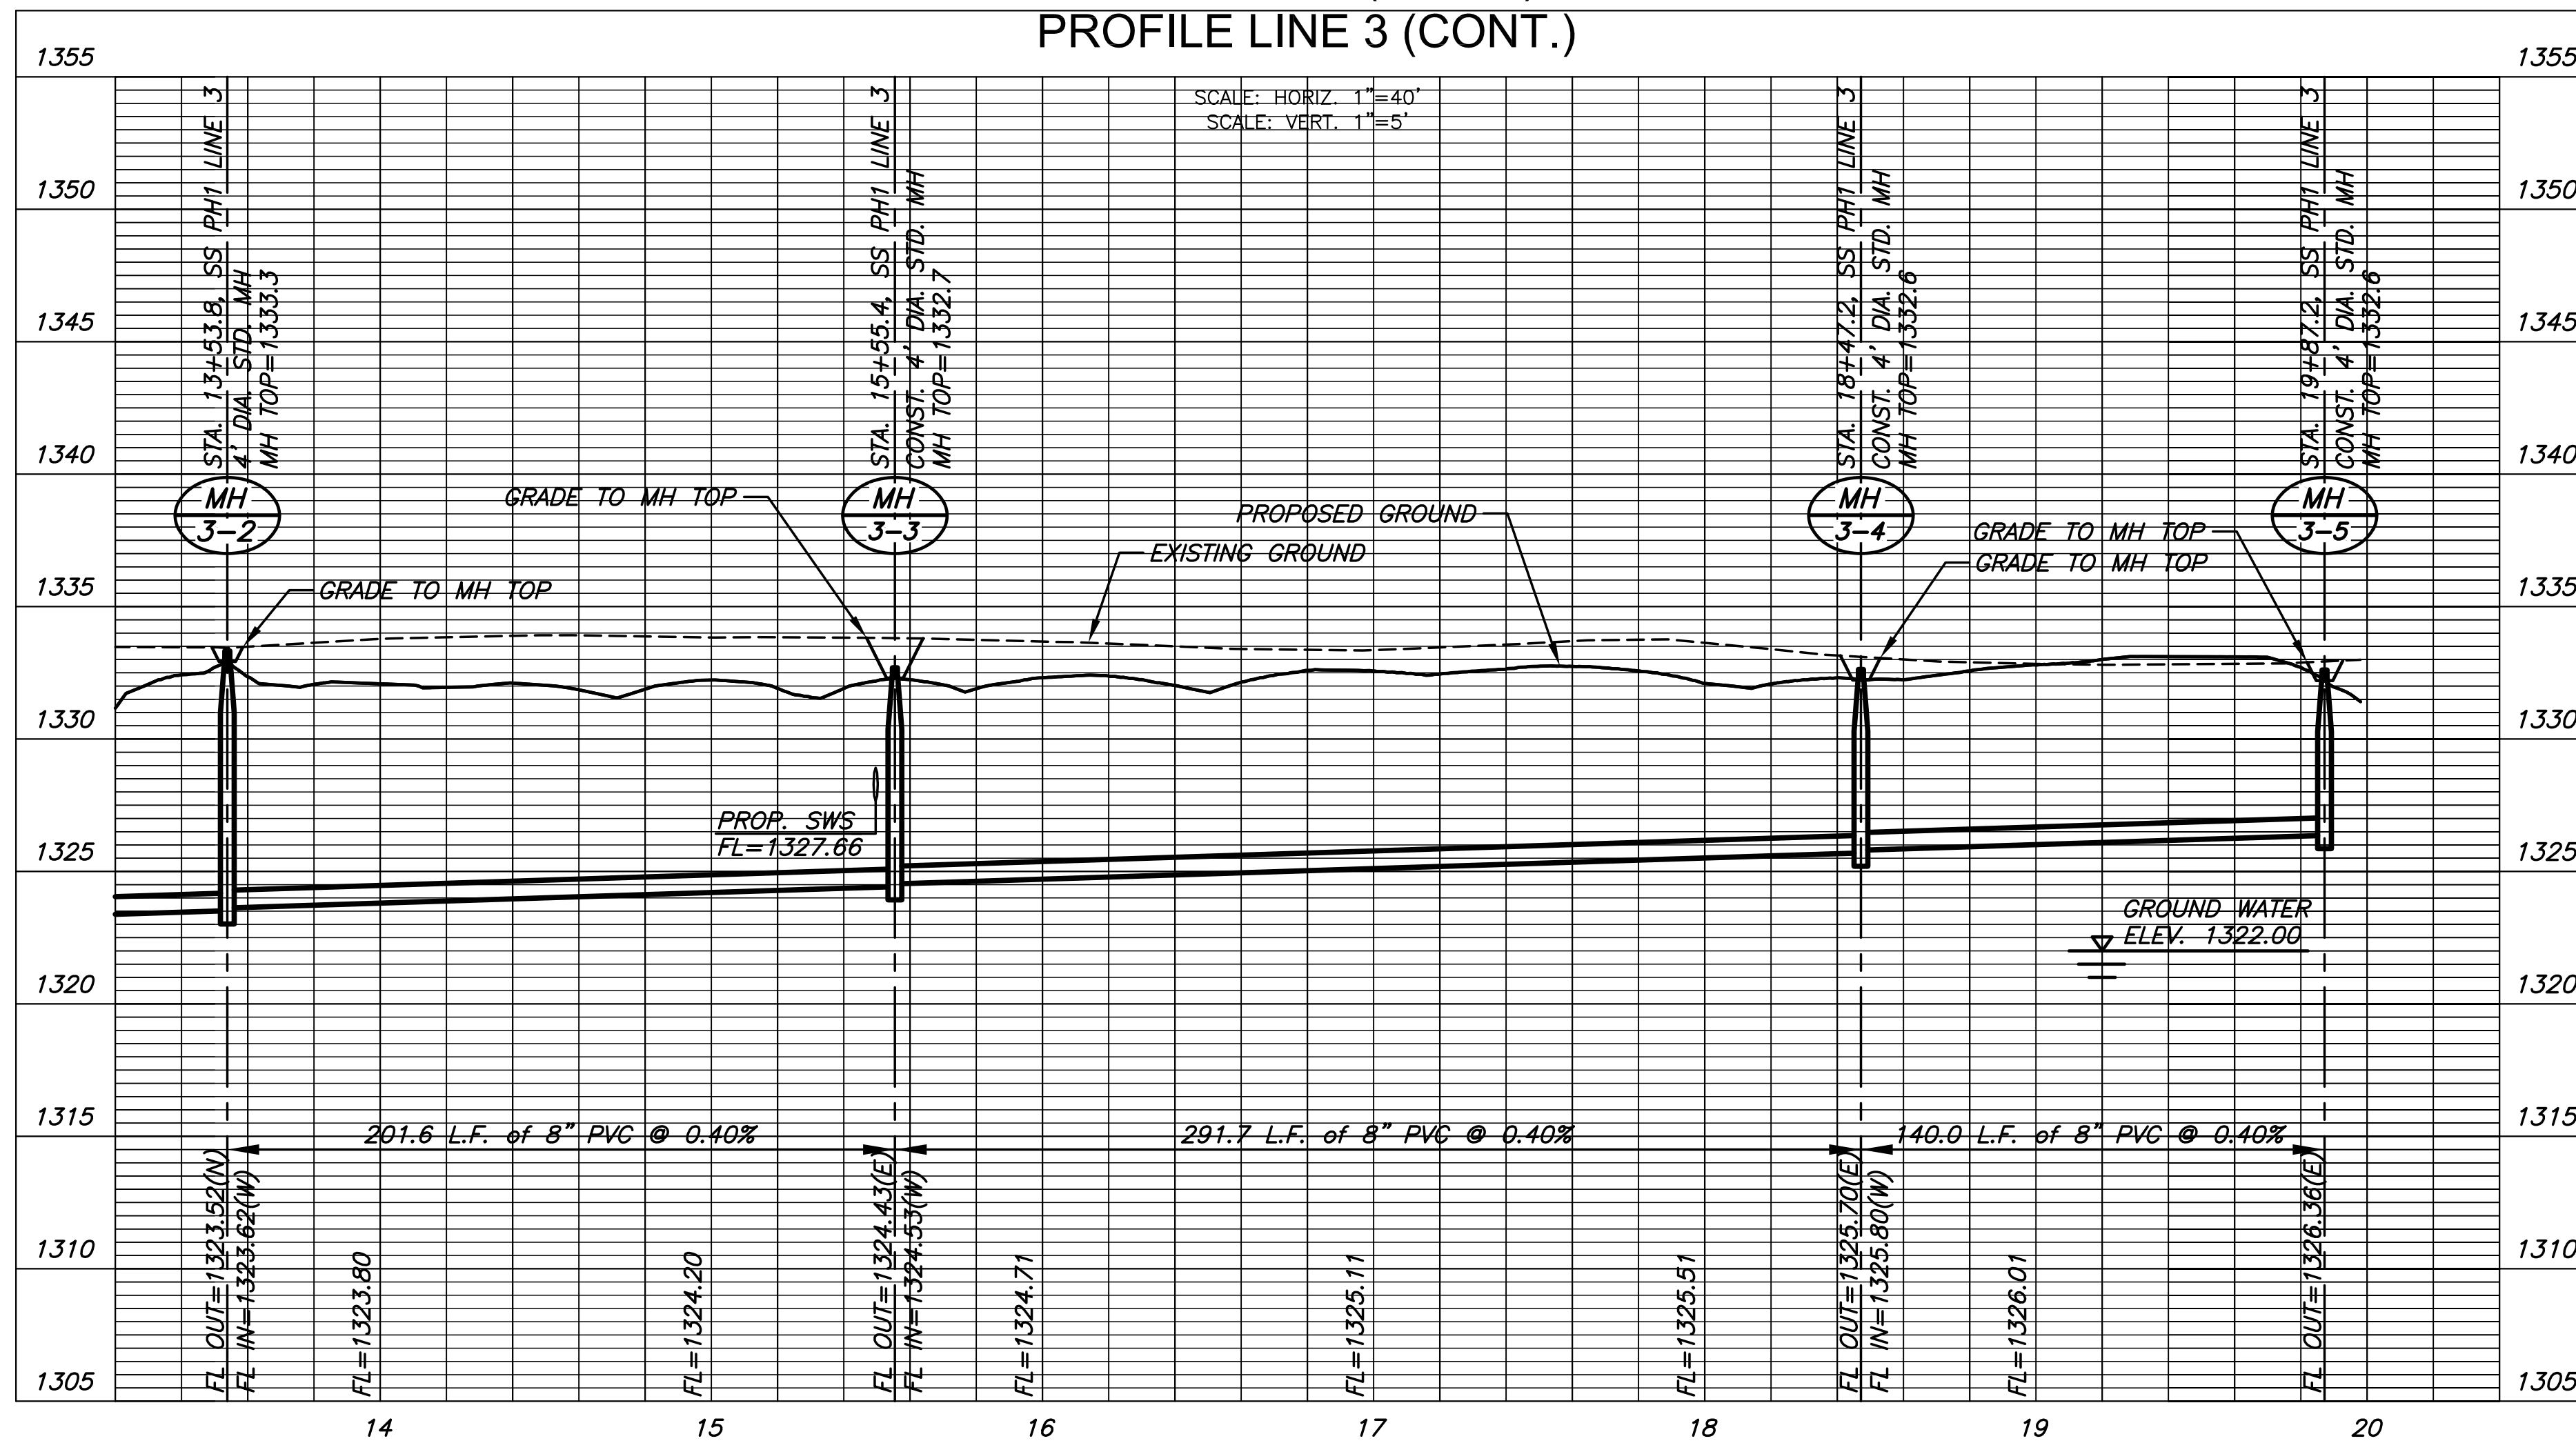

GREGORY J. ALLISON
LICENSED PROFESSIONAL ENGINEER
KANSAS
11159
10/13/15



SANITARY SEWER PLANS FOR
ESTANCIA ADDITION
RESIDENTIAL PHASE 1

©2015 MKEC Engineering All Rights Reserved
www.mkec.com
These drawings and their contents, including, but not limited to, all concepts, designs, & ideas are the exclusive property of MKEC Engineering (MKEC), and may not be used or reproduced in any way without the express consent of MKEC.

LINES 3		
PROJECT NO.	468-850785	
DATE	OCT. 2015	
SCALE	1" = 40'	
DESIGNED	DRAWN	CHECKED
DFL	JWC	GJA
NO.	REVISION	DATE
SHEET NO.		
7 OF 20		