

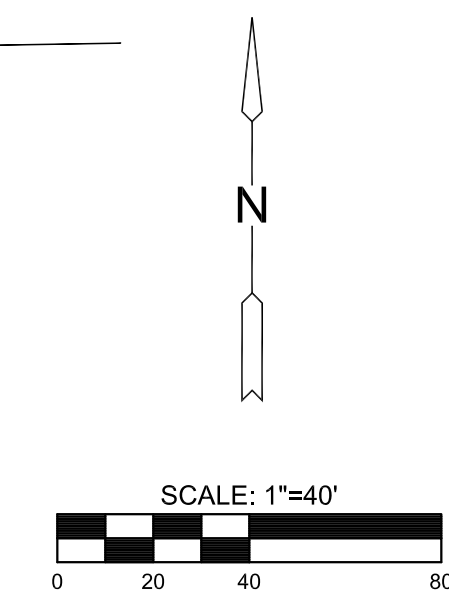
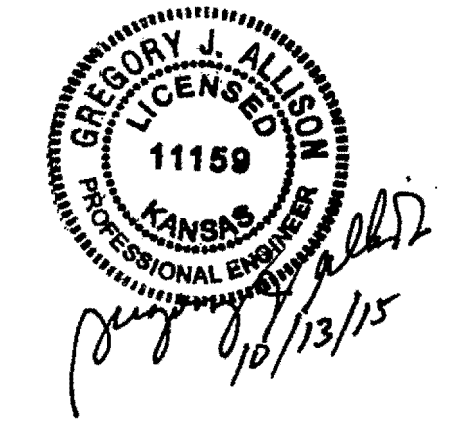
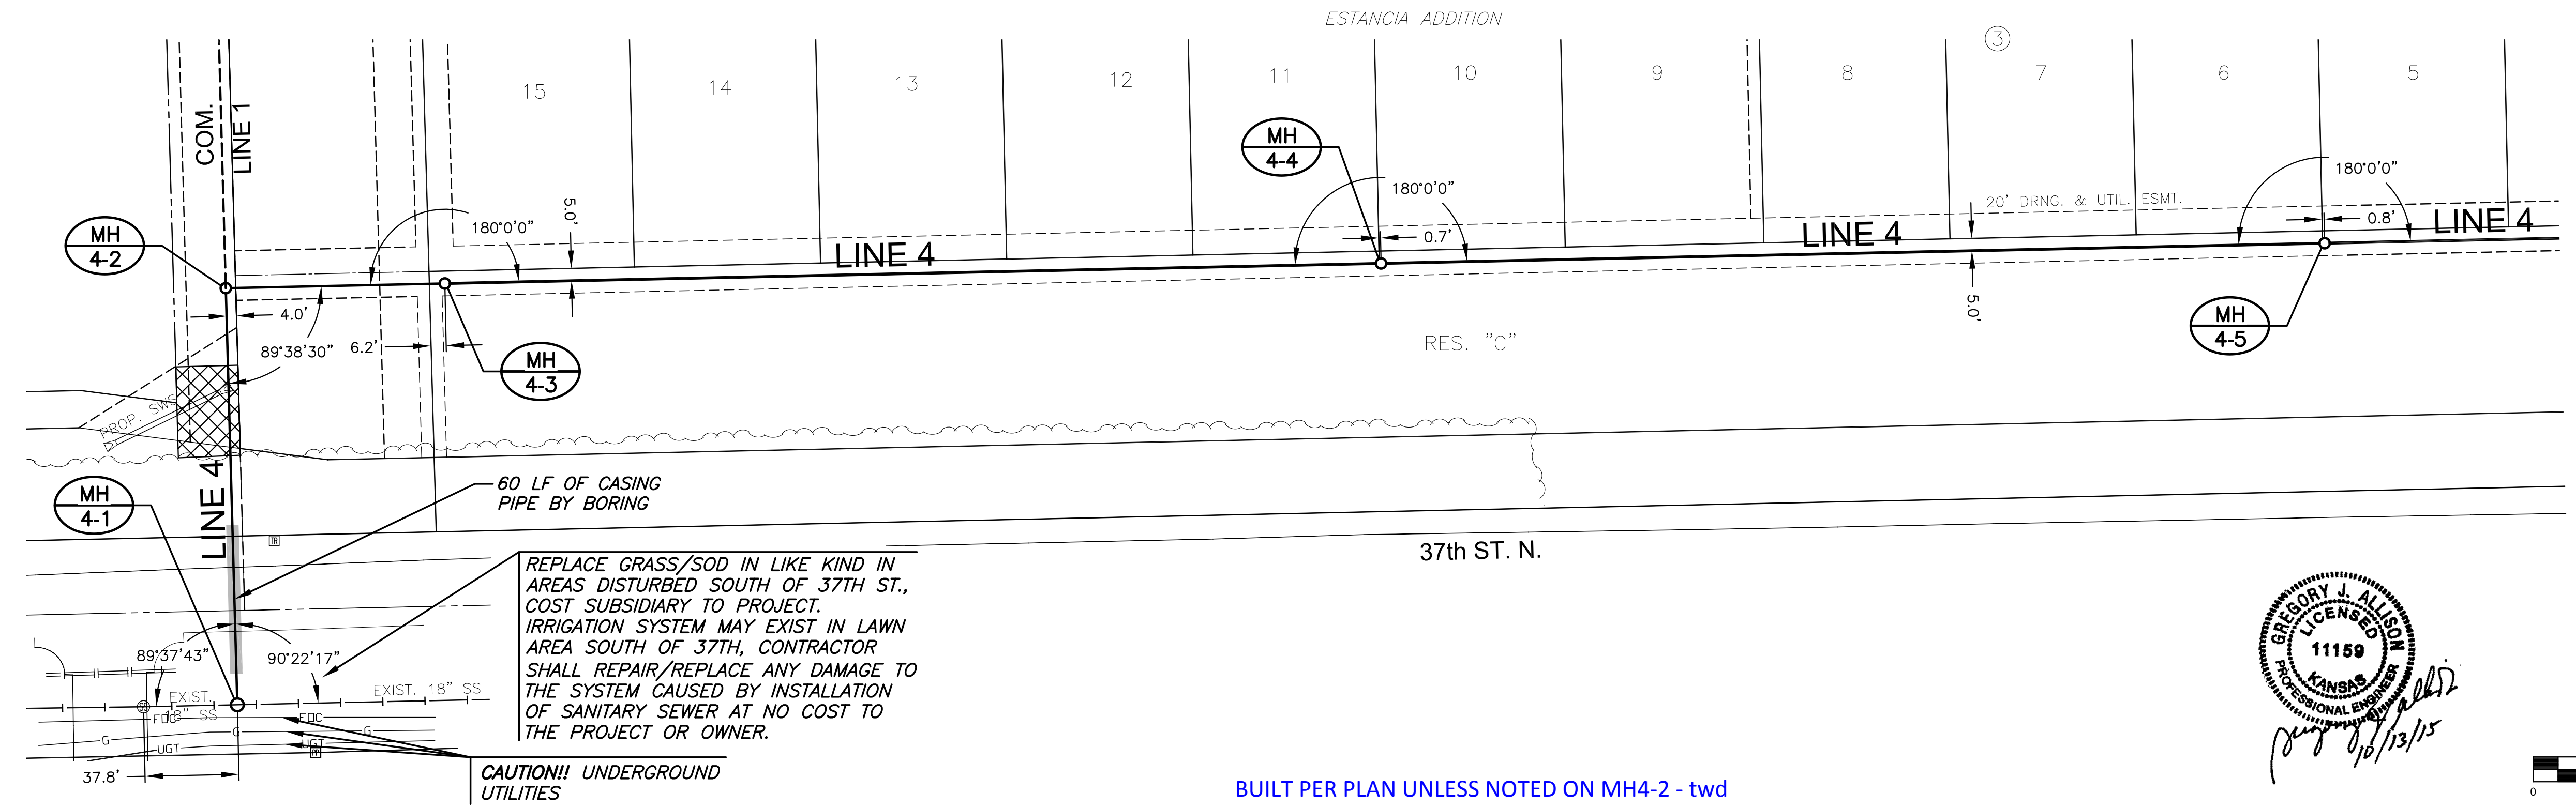


PLOTTED: Wednesday, October 14, 2015 @ 11:52AM

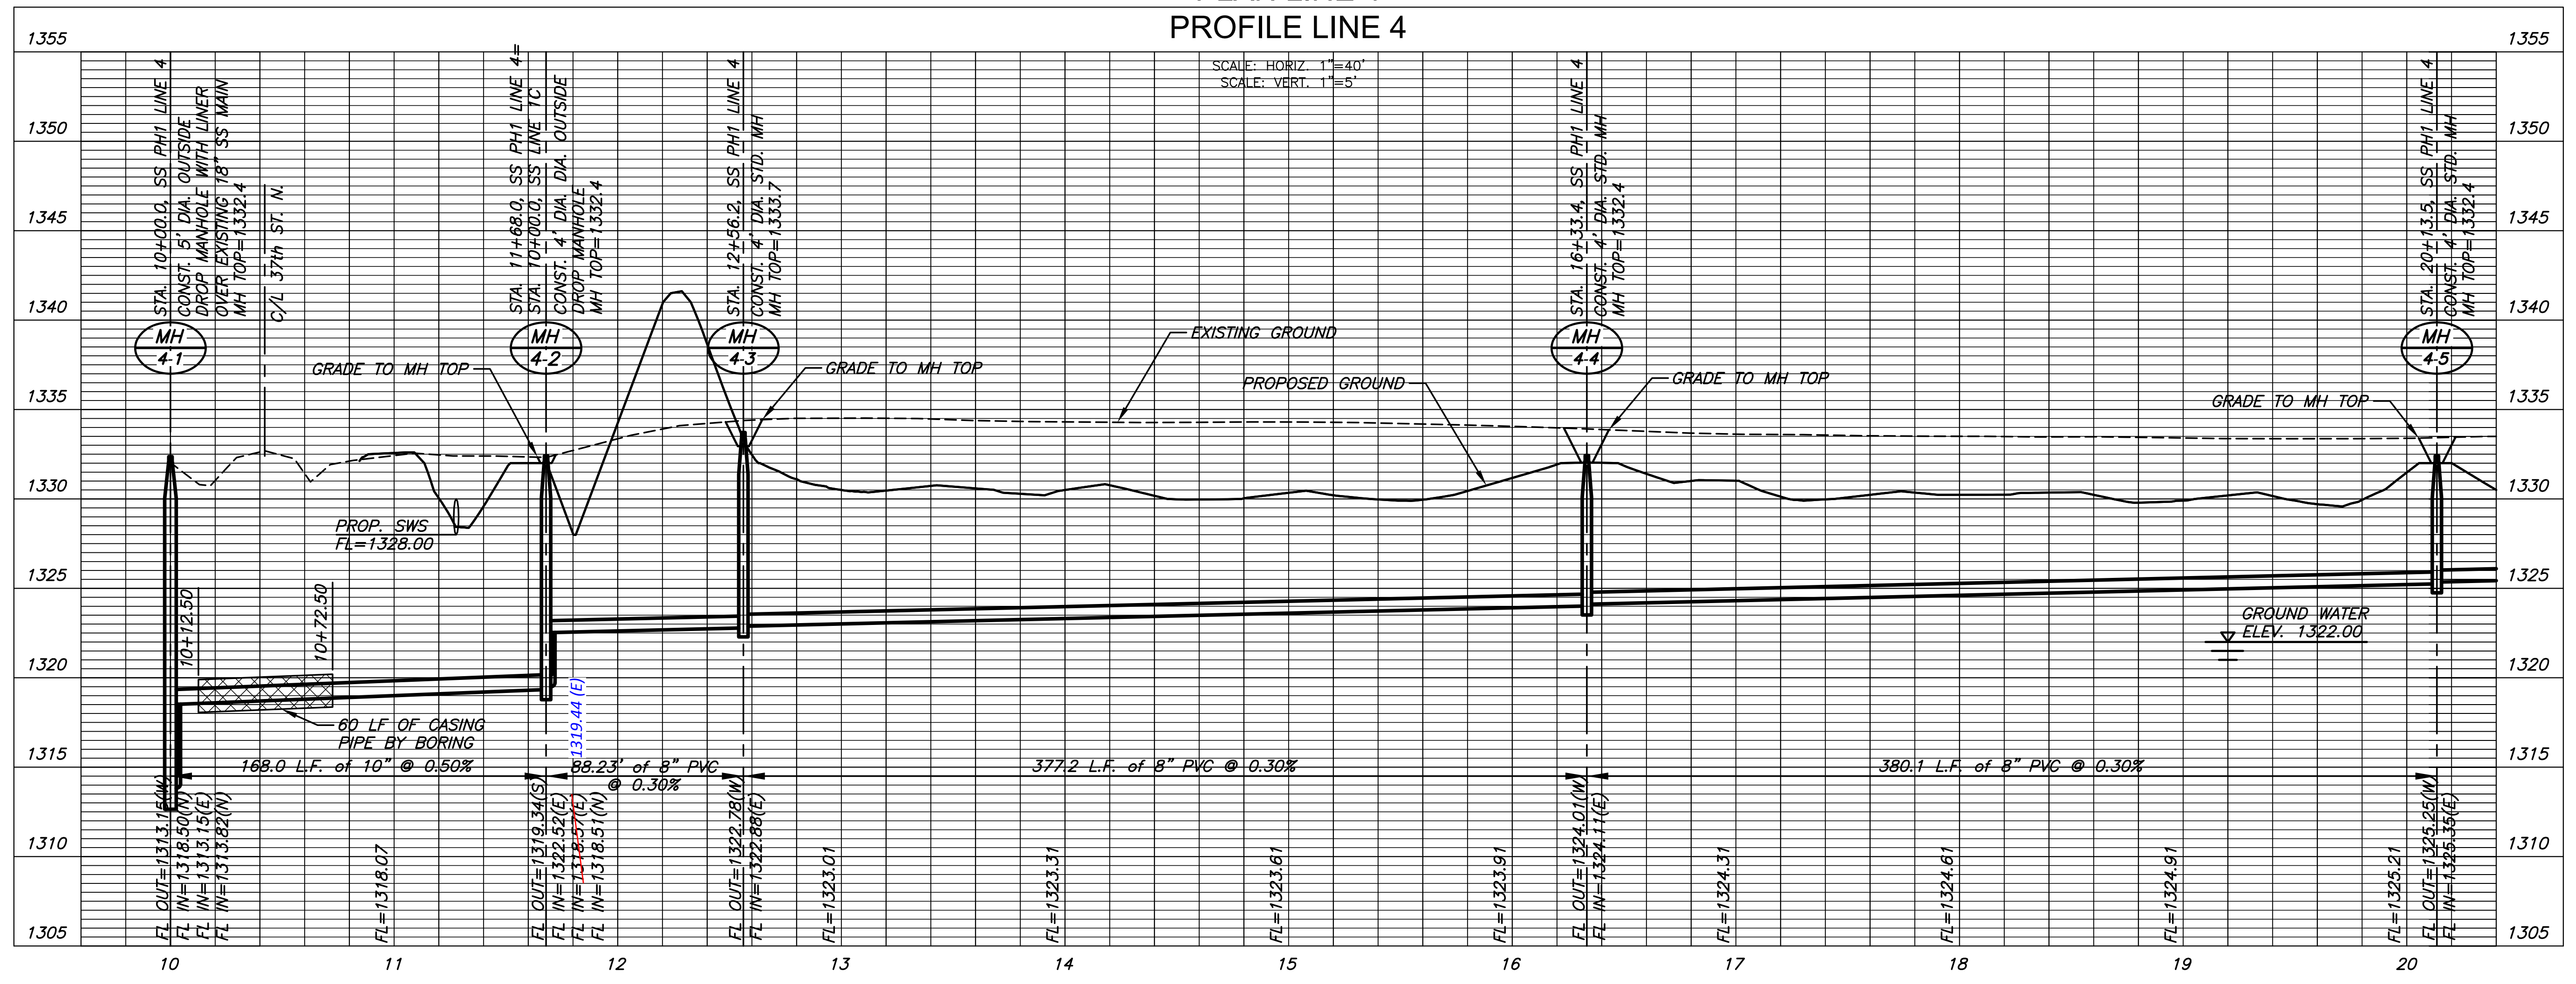

NOTE:
CONTRACTOR TO VERIFY THE DEPTH AND LOCATION OF EXISTING UTILITIES PRIOR TO CONSTRUCTION.

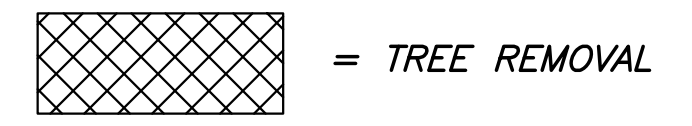

SANITARY SEWER PLANS FOR
ESTANCIA ADDITION
RESIDENTIAL PHASE 1

©2015 MKEC Engineering All Rights Reserved
www.mkec.com
These drawings and their contents, including, but not limited to, all concepts, designs, & ideas are the exclusive property of MKEC Engineering (MKEC), and may not be used or reproduced in any way without the express consent of MKEC.

LINE 4	
PROJECT NO.	468-850785
DATE	OCT. 2015
SCALE	1" = 40'
DESIGNED	DFL
DRAWN	JWC
CHECKED	GJA

NO.	REVISION	DATE

SHEET NO.
8 OF 20