



FHWA REGION NO.	STATE	PROJECT NUMBER	FISCAL YEAR	SHEET NUMBER	TOTAL SHEETS
7	KANSAS	871E-0115-01	1997	34	49

DATE	
BY	
REFERENCES NOTED	
REFERENCES CHECKED	

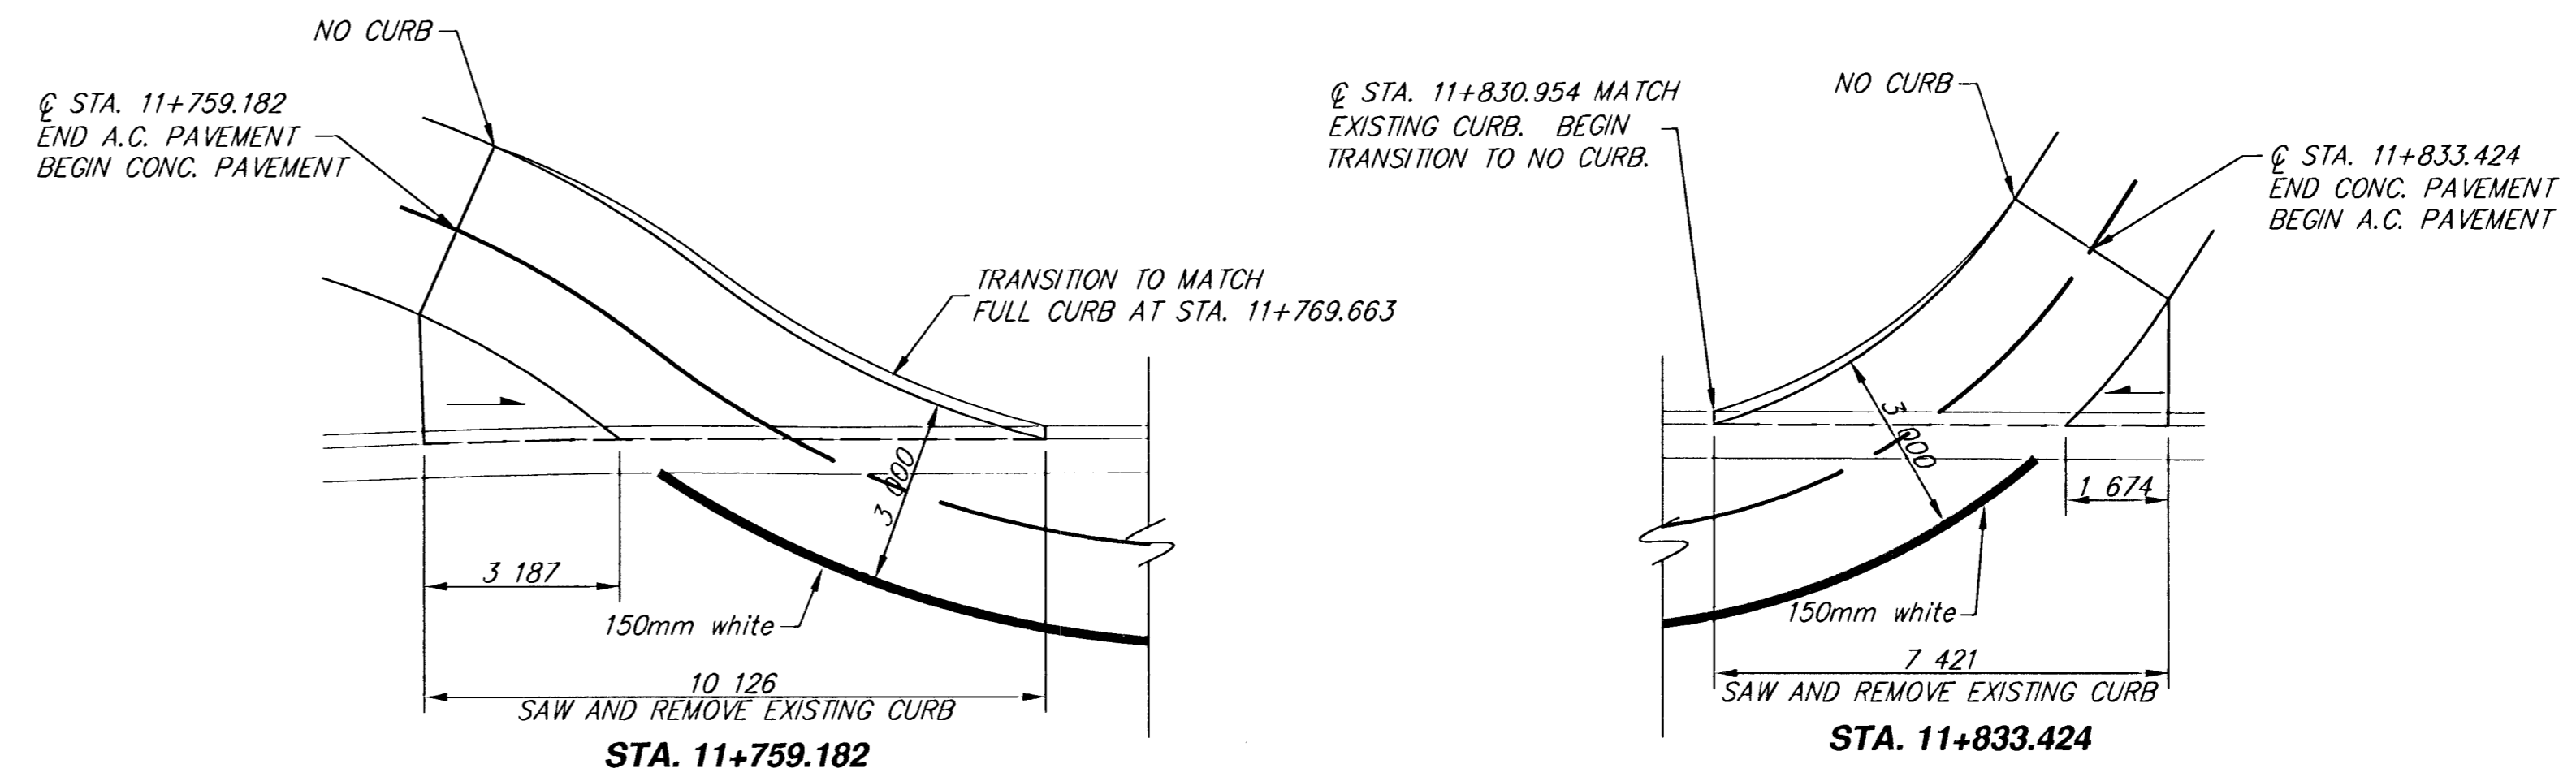

SPECIAL RAMPS

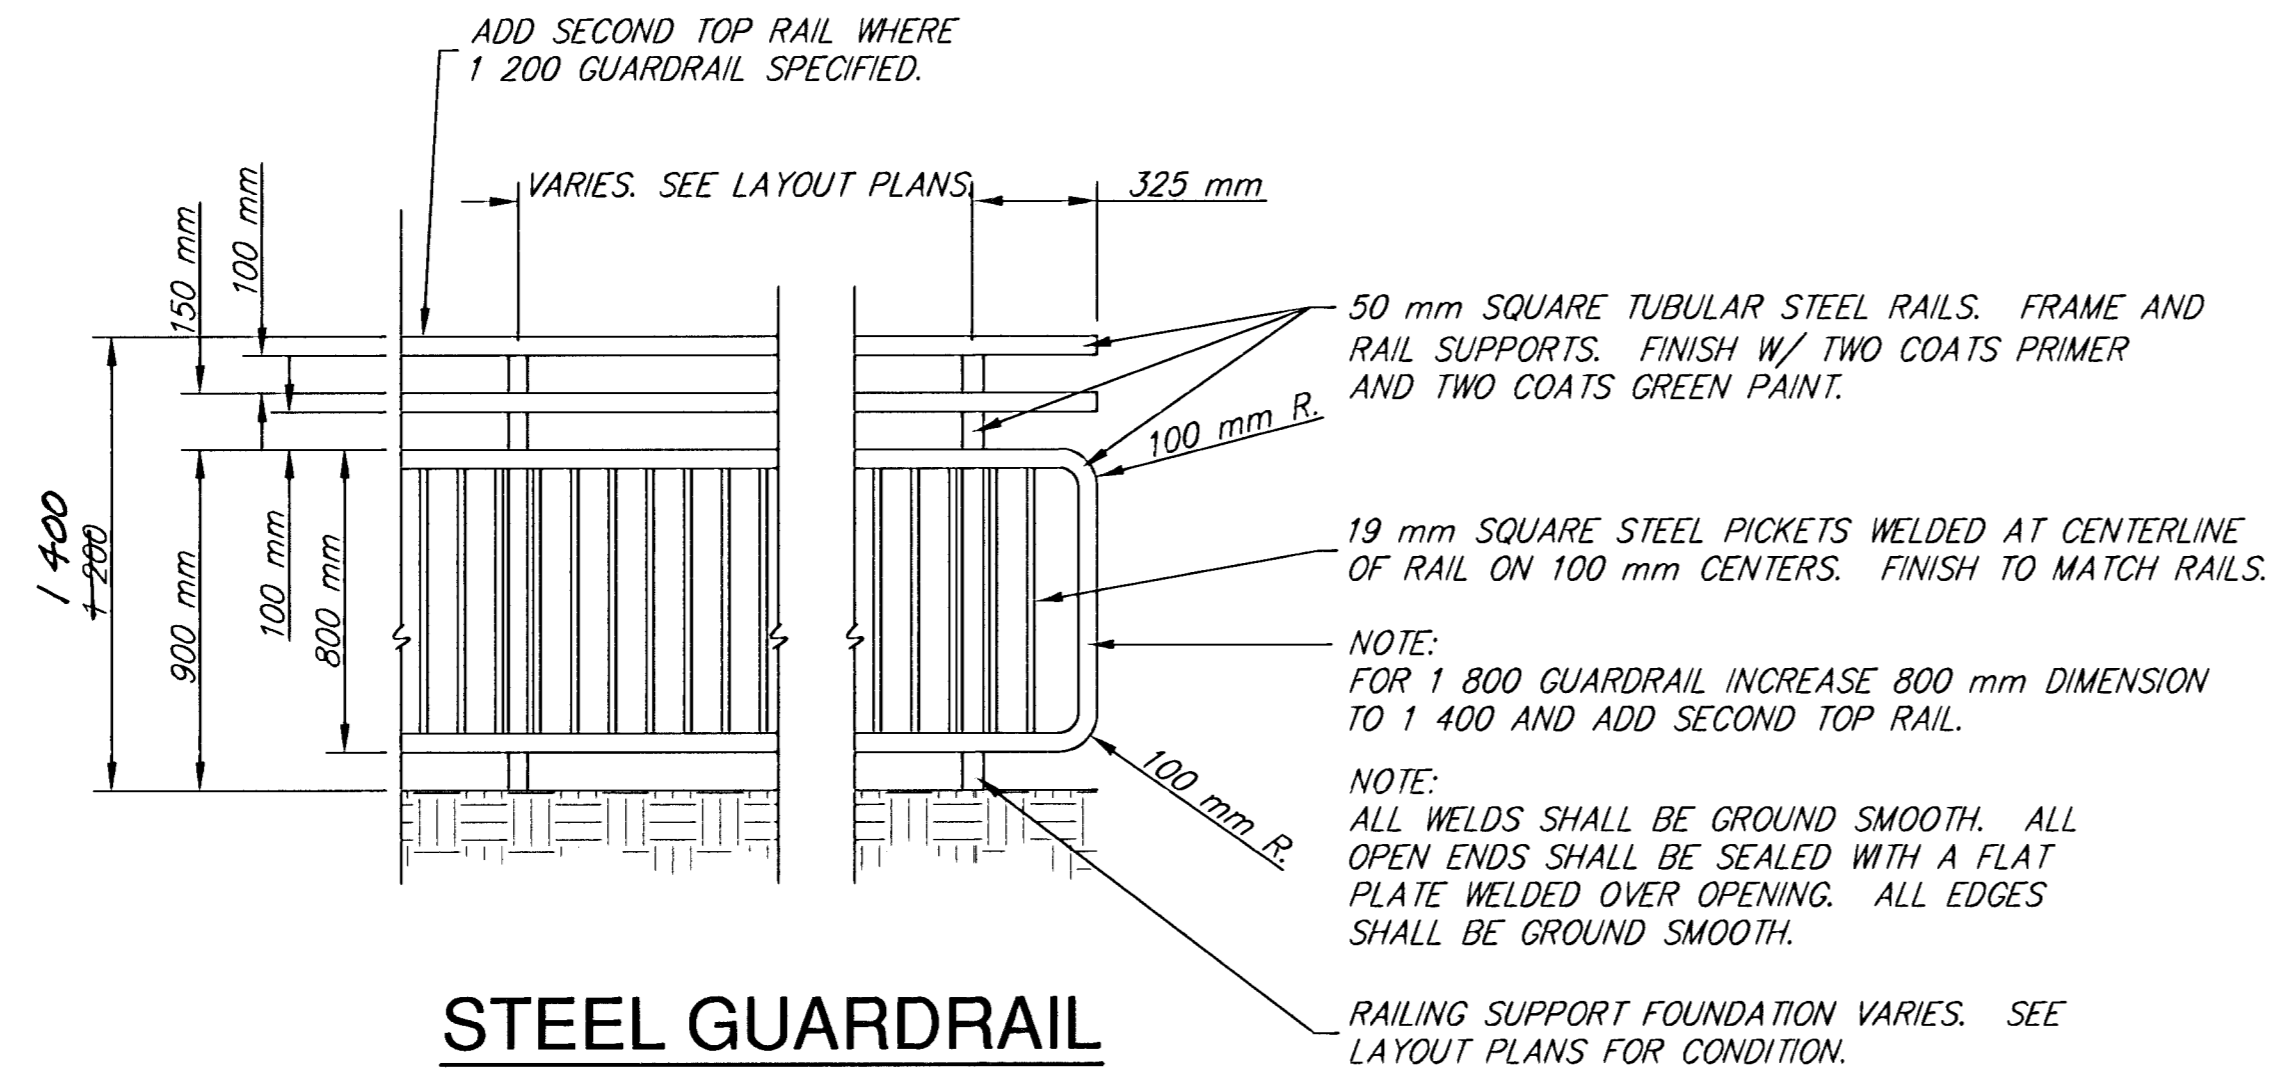

**K96 BIKEPATH
MISCELLANEOUS DETAILS**

	924 NORTH MAIN WICHITA, KANSAS 67203 www.srb1.com	316-264-8008 FAX 264-4621 E-Mail: info@srb1.com	REVISION 34
	SAVOY, RUGGLES & BOHM, P. A. ENGINEERING & SURVEYING		49
DRAWN JTS	DESIGN T.C.R.	REVIEW DATE June 27, 2001	UTILITY SRB JOB 1554T