


FHWA REG NO.	STATE	PROJECT NO.	YEAR	SHEET NO.	TOTAL SHEETS
7	KANSAS	87 N-0198-01	2001	45	82

FED. AID NO. - CMQ-N019(801)

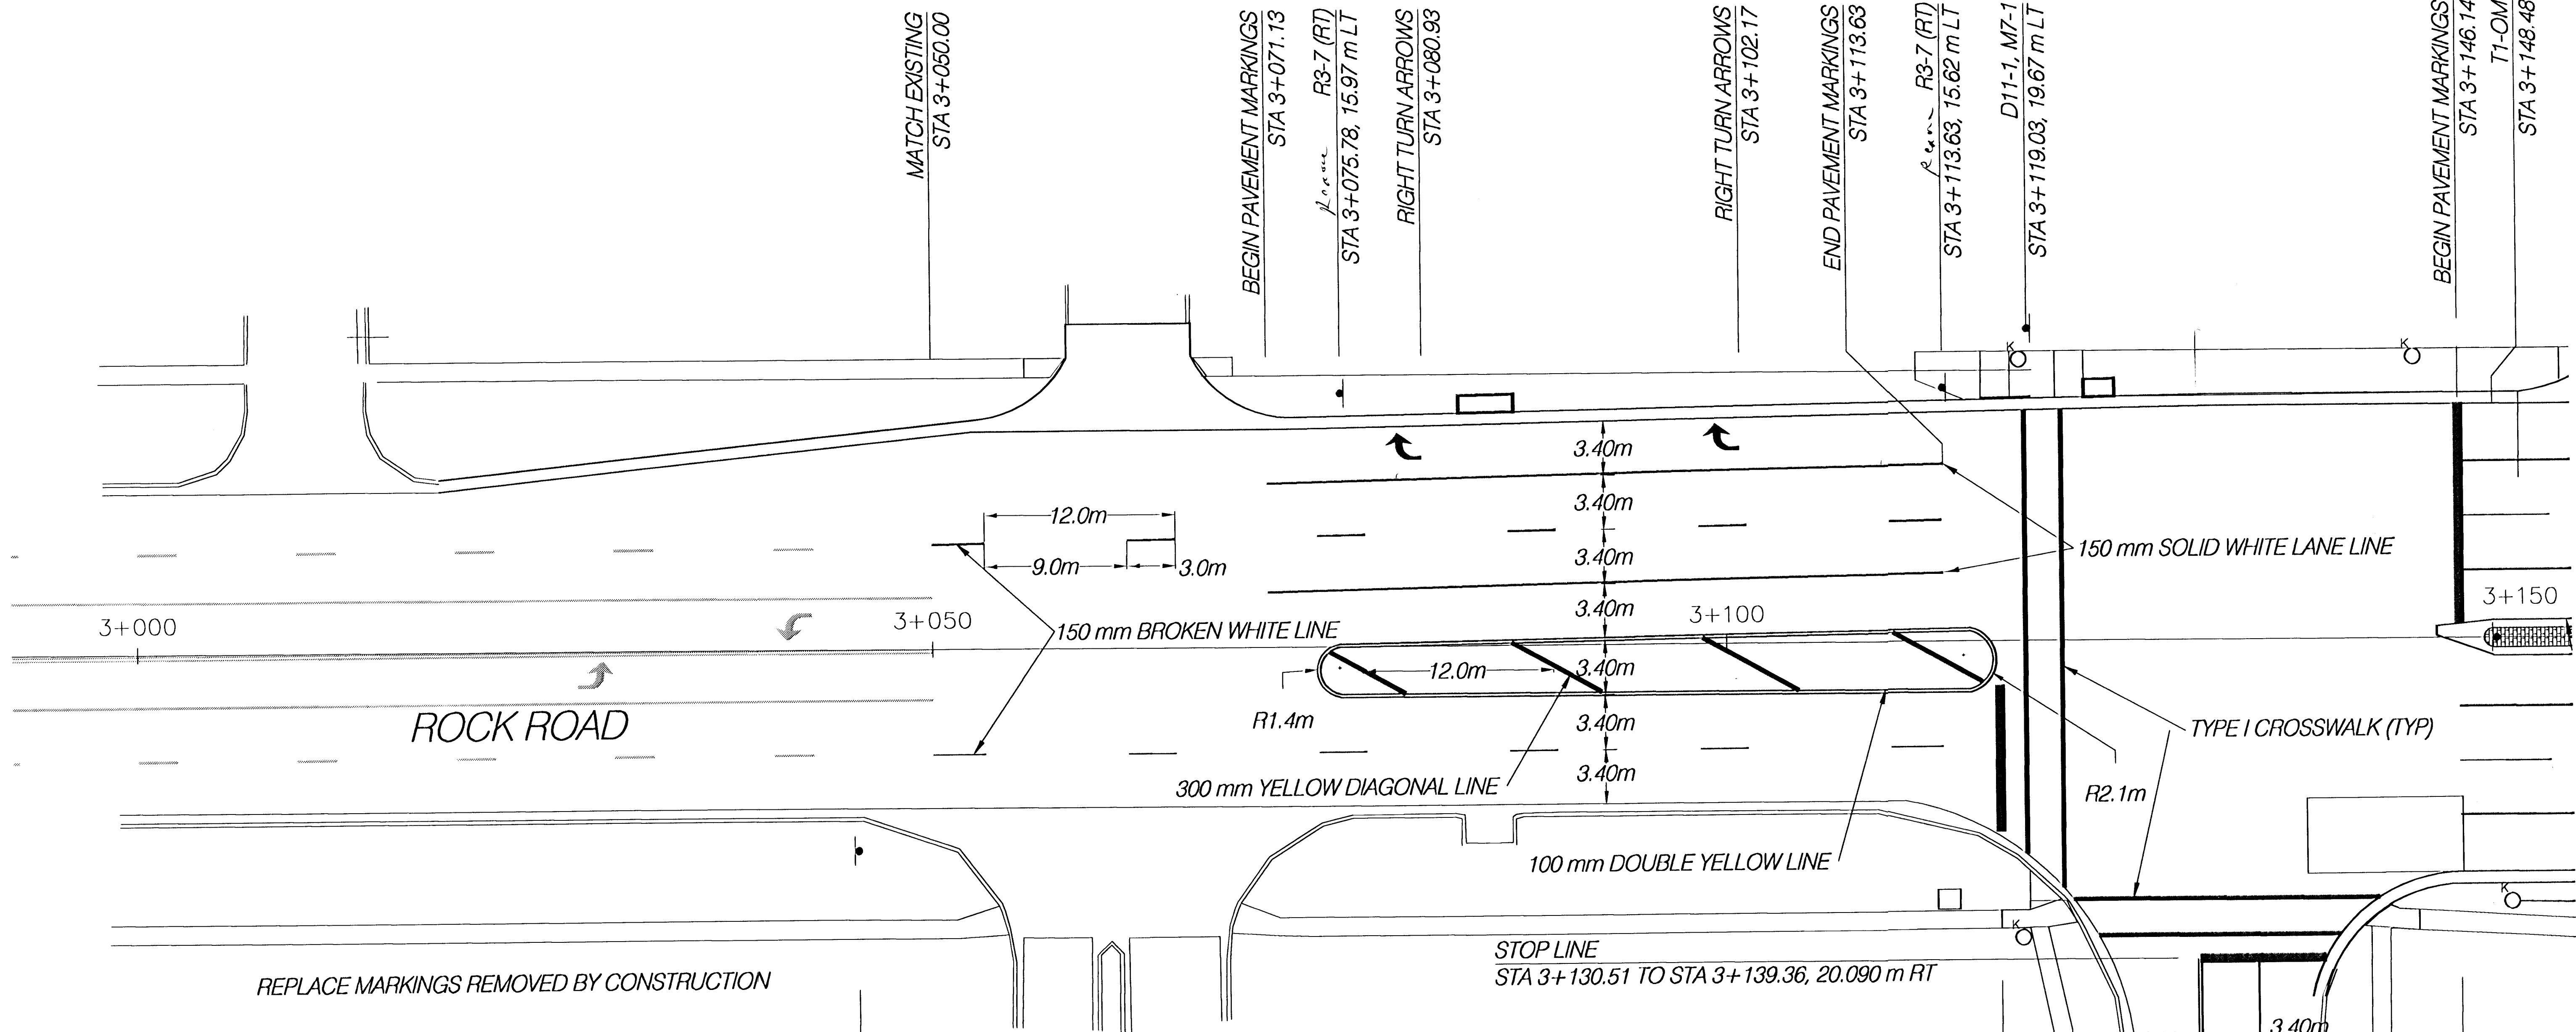

REPLACE MARKINGS REMOVED BY CONSTRUCTION

W11-1
STA 3+045.23, 12.63 m RT

LEGEND

TRAFFIC SIGNAL POLE

SIGN LEGEND		
R3-7	RIGHT LANE MUST TURN RIGHT	2
D11-1	BIKE ROUTE	1
M7-1	DIRECTIONAL ARROW	1
W11-1	BICYCLE CROSSING	1
T1-OM	TYPE I OBJECT MARKER	1

STOP LINE
STA 3+130.51 TO STA 3+139.36, 20.090 m RT

STOP LINE
STA 3+117.19

32nd Street

STOP LINE
STA 3+146.14

150 mm SOLID WHITE LINE
(25 m)

ROCK ROAD
PAVEMENT MARKINGS & SIGNING
STA. 3+000 - 3+150



Designed By:	JJH	Checked By:	JDM
Drawn By:	BJD	Date:	11/14/01
			Job No. 55-70-2003

