


Point Table			
Point #	Northing	Easting	Description
2000	1694067.82	1600390.51	0+00 CONNECT
2001	1694334.56	1600383.19	2+67 PC
2002	1694468.25	1600427.67	4+11 TEE
2003	1694536.50	1600526.60	5+33 BEND
2004	1694536.83	1600527.62	5+34 BEND
2005	1694541.87	1600547.00	5+54 BEND
2006	1694542.42	1600549.74	5+56 BEND
2007	1694546.15	1600583.99	5+91 PT
2008	1694548.09	1600661.96	6+69 TEE
2009	1694551.28	1600790.15	7+97 CONNECT
2010	1694513.46	1600370.67	0+73 BEND
2011	1694570.13	1600345.84	1+35 BEND
2012	1694592.92	1600322.10	1+68 BEND
2013	1694625.82	1600321.43	2+00 BEND
2014	1694649.56	1600344.23	2+33 BEND
2015	1694650.23	1600377.13	2+66 BEND
2016	1694627.44	1600400.87	2+99 BEND
2017	1694610.98	1600401.20	3+16 BO
2018	1694606.07	1600660.52	0+58 BO

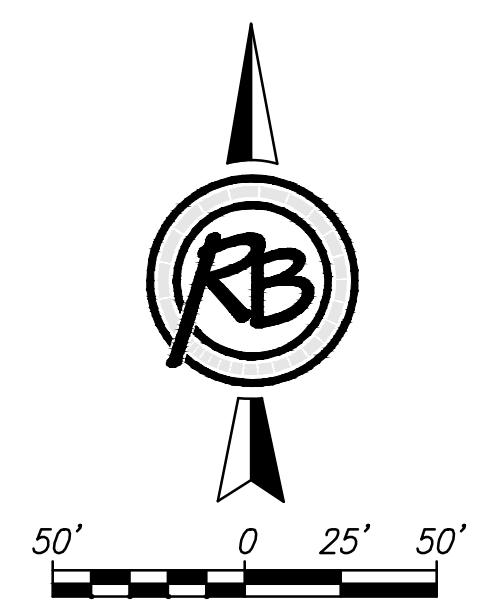

Cheryl's Hollow, 2nd Addition Bubble Map			
	RUGGLES & BOHM		DATE July 2016
	<small>ENGINEERING SURVEYING LANDSCAPE ARCHITECTURE GOVERNMENT</small> <small>924 NORTH MAIN WICHITA, KANSAS 67203 P (316) 264-8008 F (316) 264-4621</small> <small>WWW.RBKANSAS.COM</small>		DESIGN KWL
PROJECT NUMBER 448-90198	RB JOB NO. 4731E	DWG. SCALE 50	DRAWN CDJ
DRAWING FILE 07 - Bubble Map [Coordinate Map]			REVIEW July 2016
			SHEET 15
			OF 17