

STATE	PROJECT NO.	YEAR	SHEET NO.	TOTAL SHEETS
KANSAS	87 N-0230-01	2003	9	73

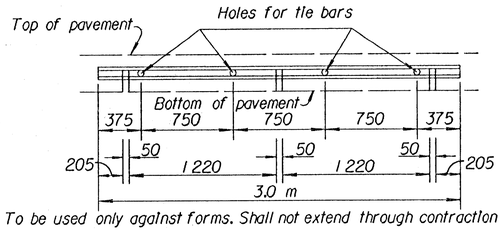


To be used only against forms. Shall not extend through contraction joints.

METAL STRIP FOR
LONGITUDINAL CONSTRUCTION JOINT (3.0 m)

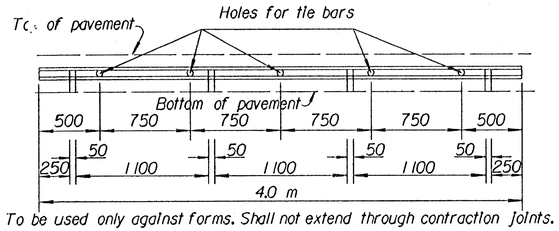


To be used only against forms. Shall not extend through contraction joints.

METAL STRIP FOR
LONGITUDINAL CONSTRUCTION JOINT (4.0 m)

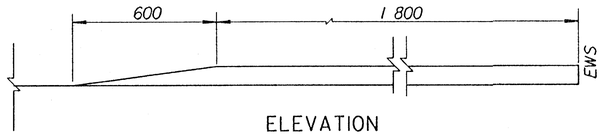

ELEVATION

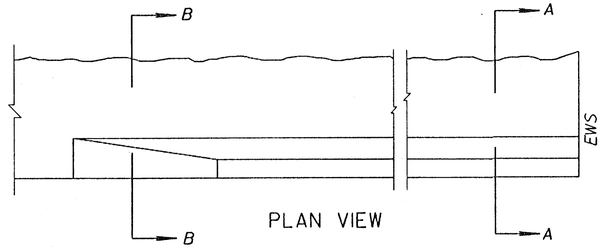

PLAN VIEW

100 mm EDGE CURB DETAIL

GENERAL NOTES

All work shall be done in conformity with the Standard Specifications applicable to the project.

The cost of all bars and joint material shown on this sheet is to be included in the bid price for Concrete Pavement.


At each planned transverse joint location, a 100 mm to 150 mm wide strip of the pavement surface shall be protected from the texturing operation to provide a transverse textureless surface centered over the joint sawcut.

All sawed joints on this project shall be filled with sealant. See Special provision for type of sealant.

The 100 mm edge curb shall be constructed integral with the approach slab shoulder.


All materials and work required for this construction shall be Subsidiary to the concrete approach slab.

Tie bars shall be evenly spaced along the length of the slab and no tie bars shall be within 300 mm of contraction joint.

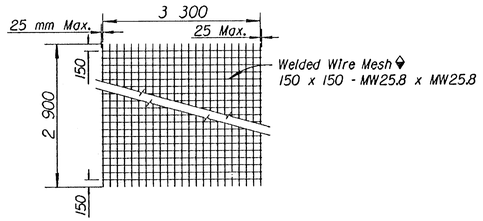


TYPICAL SHEET OF WELDED WIRE MESH FOR
SPECIAL BRIDGE APPROACH PAVEMENT

◆ Note: Epoxy coated #10 bars longitudinally @ 300 mm ctrs. & #10 bars transversely @ 450 mm ctrs. may be substituted for each layer of epoxy coated mesh.

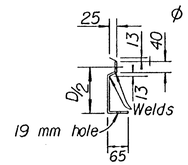

SECTION OF RECESSED
FORM LEG


ϕ Snap-in leg or other approved designs may be used in lieu of welded leg.

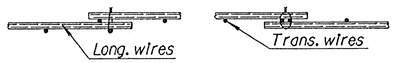


DETAIL OF LAP FOR WIRE MESH

The lap shall extend beyond the first transverse or bag wire of each sheet.


The sheet shall be wired securely at the edges and at intervals not to exceed 750 mm for the full width of the sheet. Approximate weight of wire mesh = 2.8 kg per m². Other methods for fastening the sheets of wire mesh at the laps may be used with the approval of the Engineer.

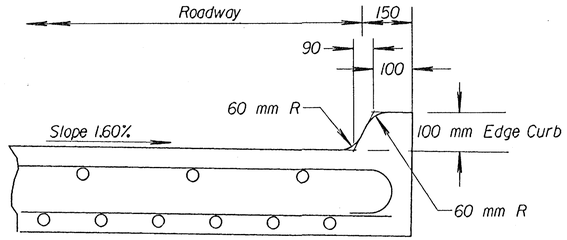


SECTION A - A

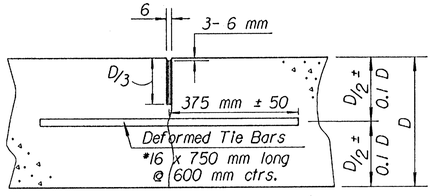

Tied Non-Keyed

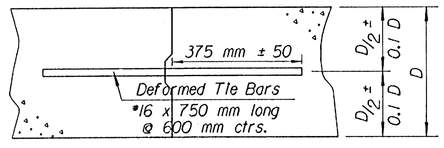


Tied Keyed Construction

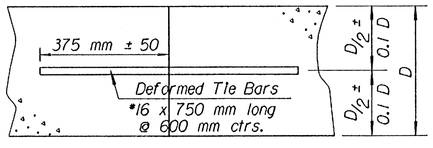


Tied Butt Construction

LONGITUDINAL JOINTS

Note: For longitudinal construction joints the contractor has the option of using either the keyed or butt type.

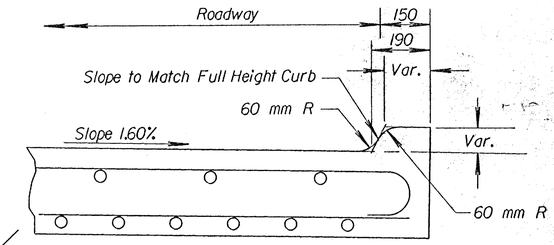

SECTION B - B

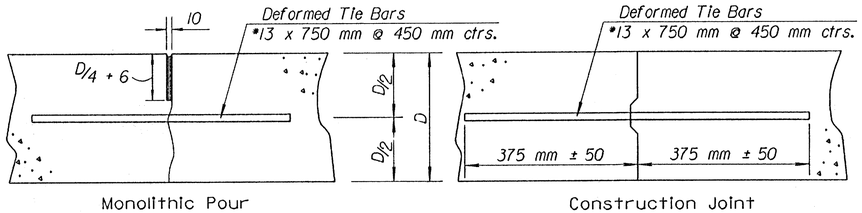


Monolithic Pour


Construction Joint

TRANSVERSE JOINTS

Note: A construction joint is required when the concrete placement has been interrupted for a substantial length of time or at the end of a day's placement.

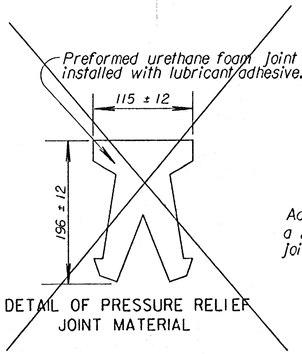

DETAIL OF PRESSURE RELIEF
JOINT MATERIAL

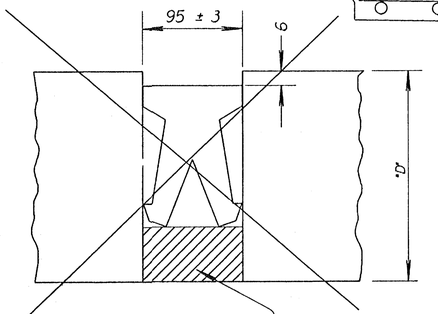

Adjust the bottom of the expansion joint trench and place a 25 mm x 95 mm polystyrene or polyurethane foam so that the joint material is positioned 6 mm below the pavement top surface.

ELEVATION
PRESSURE RELIEF JOINT TREATMENT

NO.	DATE	REVISIONS	BY	APP'D
6	3-7-02	Rev. General Note on sawed joints.	S.W.K.	J.O.B.
5	8-14-01	Rev. Longitudinal joint sealant	S.W.K.	J.O.B.

KANSAS DEPARTMENT OF TRANSPORTATION

MISCELLANEOUS DETAILS
FOR CONCRETE
BRIDGE APPROACH PAVEMENT

~~RD661-SI~~

FHWA APPROVAL	4-23-02	APP'D. James O. Brewer	
DESIGNED	DETAILED	QUANTITIES	TRACED Bowser
DESIGN CK.	DETAIL CK.	QUAN.CK.	TRACE CK. Seitz

Drawn By :untitled Plotted :4/26/2004
File : J:\0257\DWGS\RD661S1.dgn