
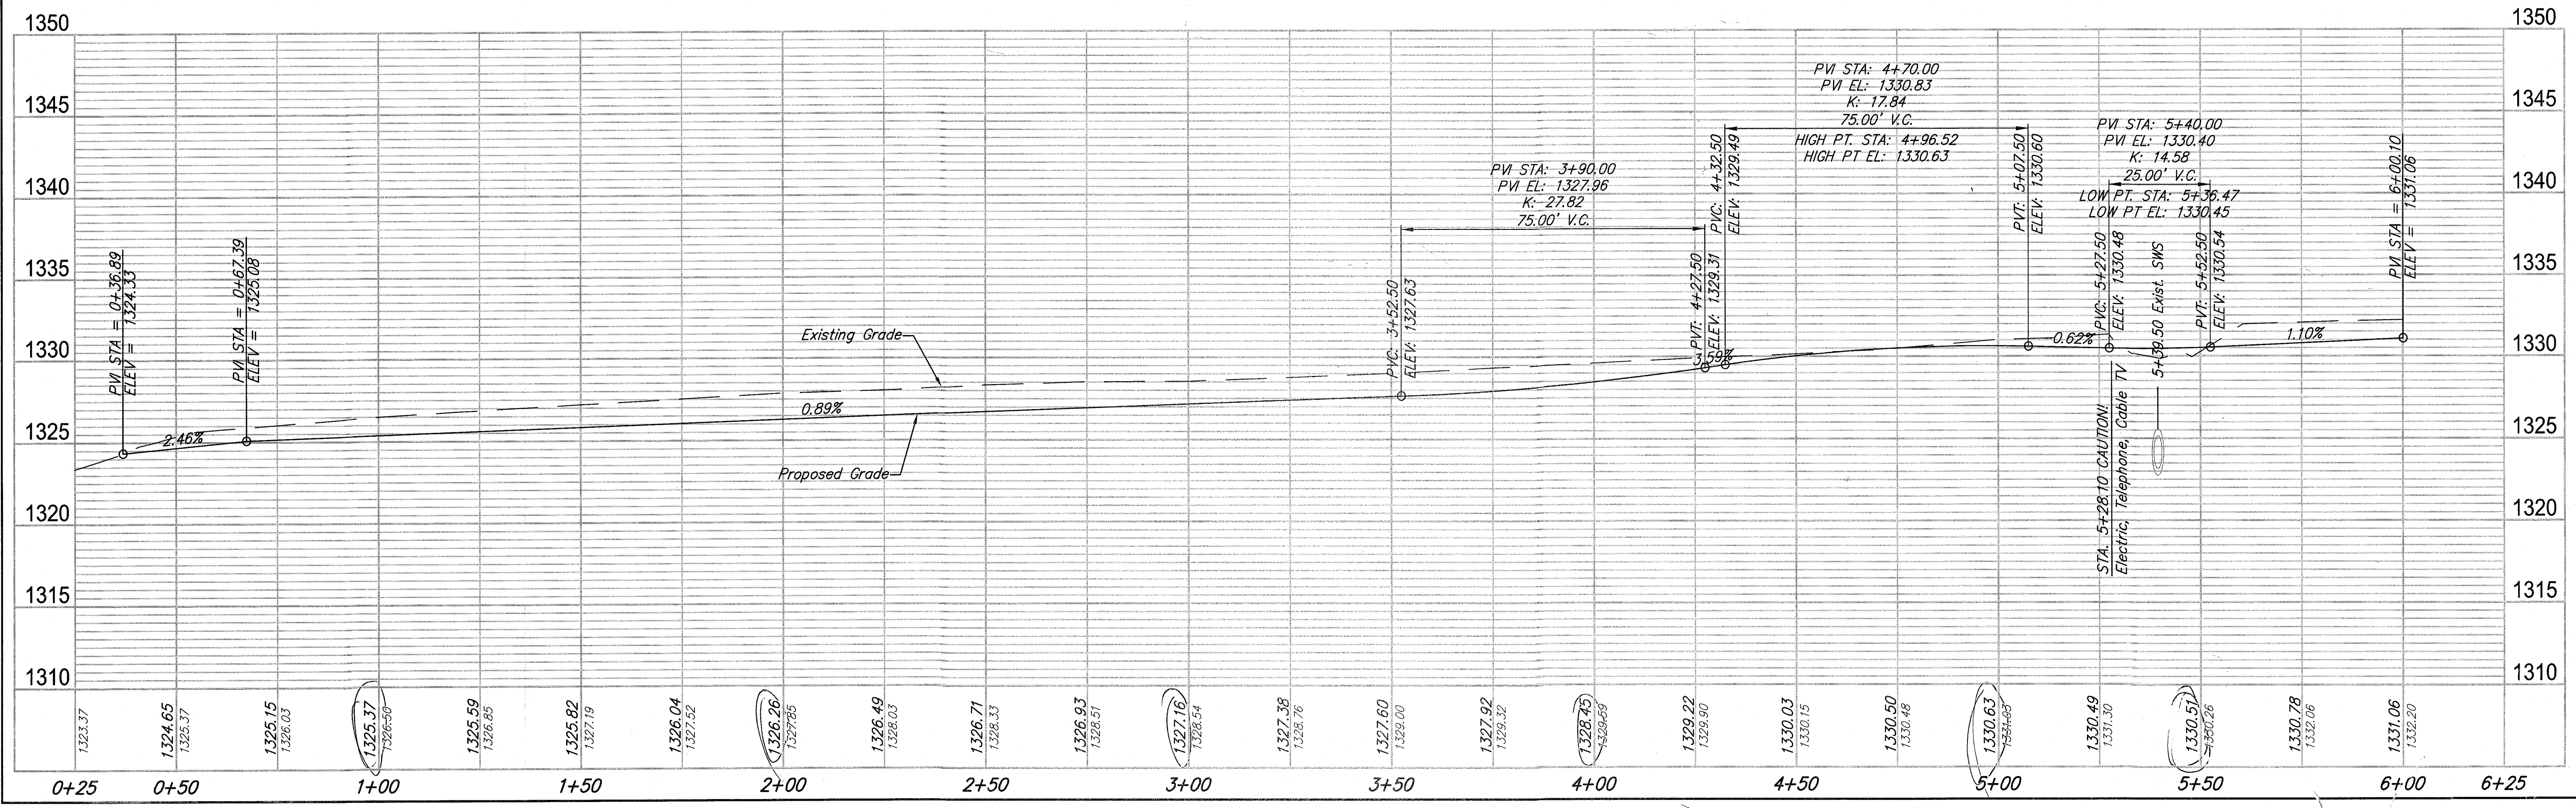
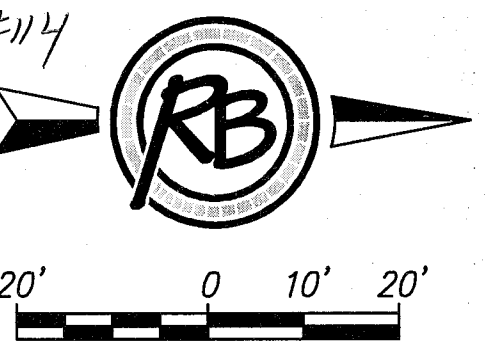


NOTE: GRADES ARE TOP OF FULL HEIGHT CURB.

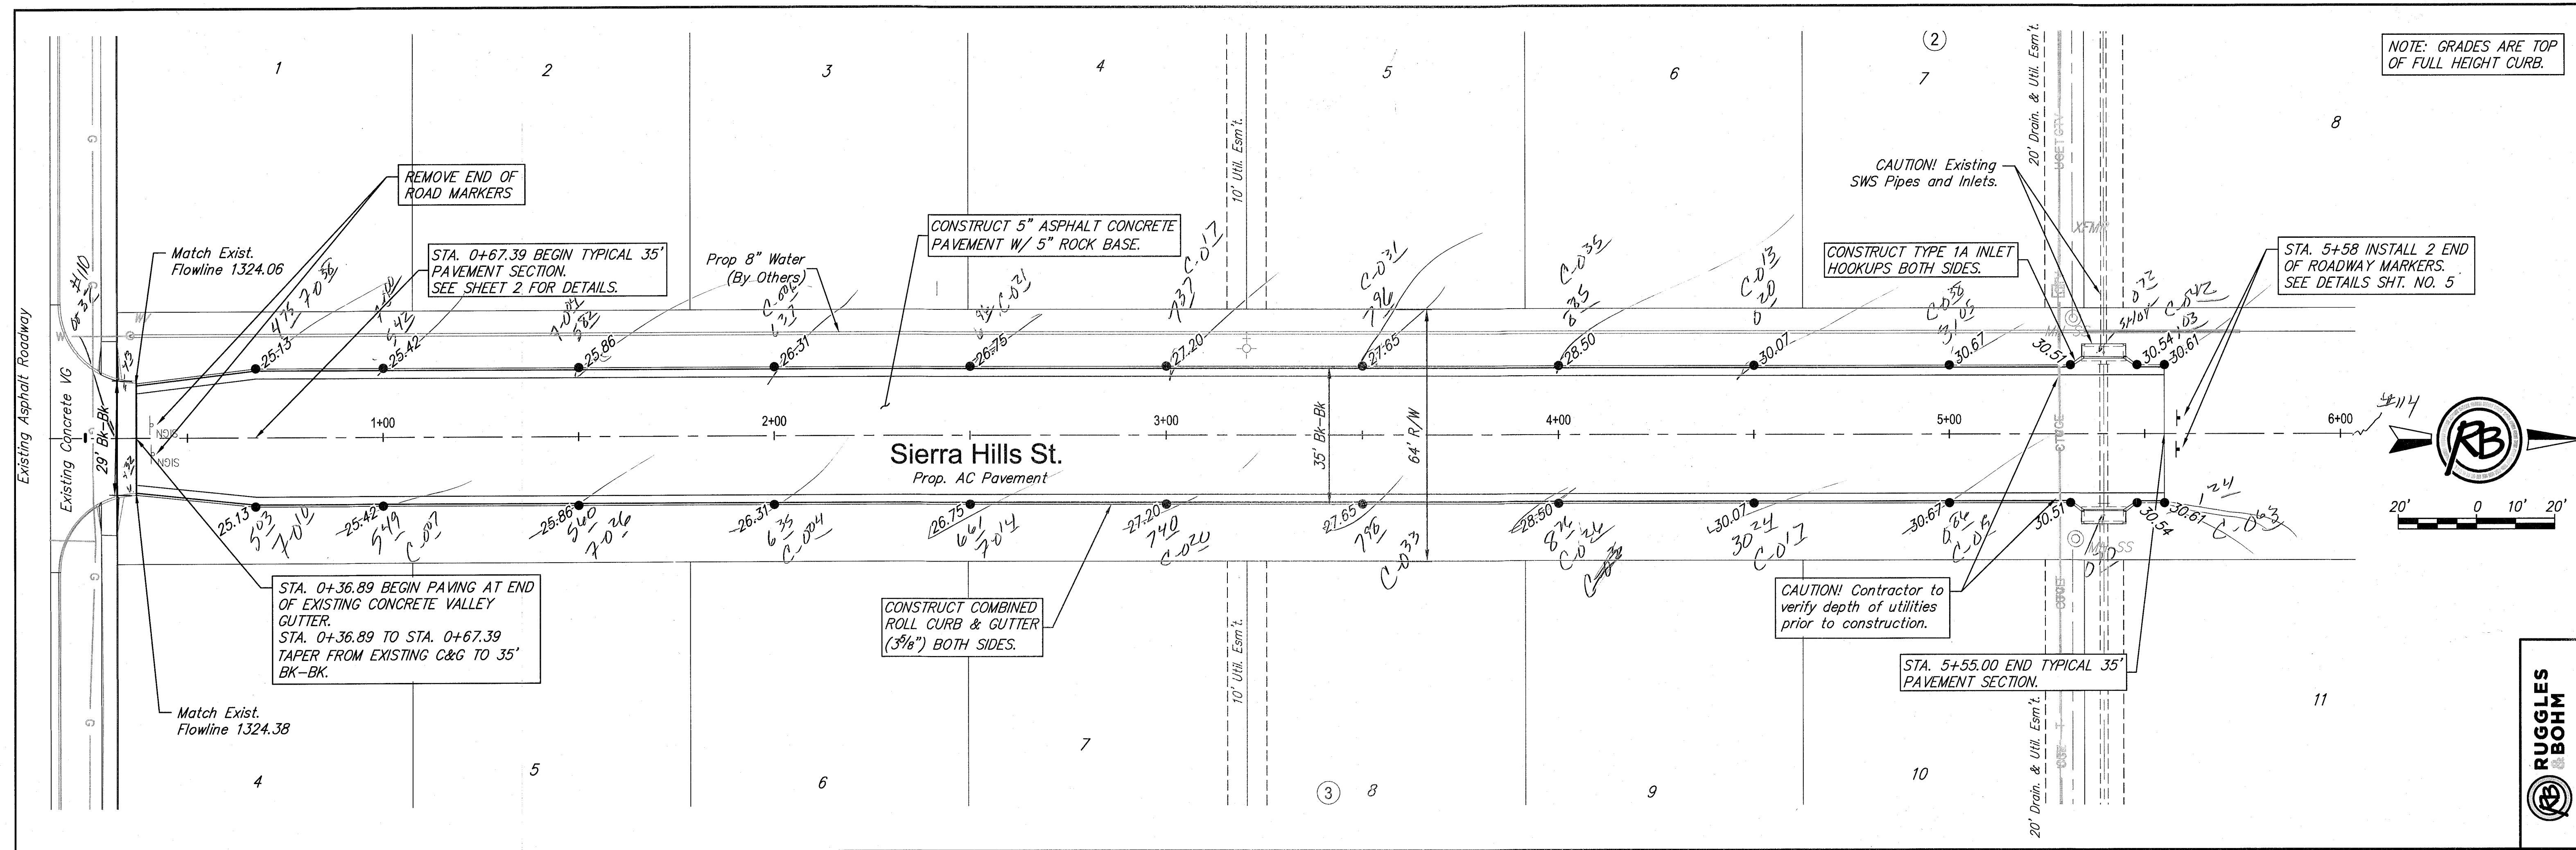

RUGGLES & BOHM
 ENGINEERS ARCHITECTS SURVEYORS
 4800E Eng Bldg
 WICHITA, KANSAS 67202-1114

PROJECT NUMBER: 472-85079
 DRAWING FILE: 4800E Eng Bldg

DESIGN: ***
 DRAWN: ***
 REVIEW: ***

DATE: 12/14/15

Bellechase 3rd Add. Ph. 2
Sierra Hills St.
 Wichita, Kansas

RB JOB: 4800E
 SHEET: 7
 OF: 20