
WATER VALVE BOX ELEVATIONS			
STREET	STATION	OFFSET	EXISTING ELEVATION
LINDBERG	56+08.00	23.50' Lt.	208.8
LINDBERG	56+33.00	23.50' Lt.	208.7

SCALE: 1"=20'

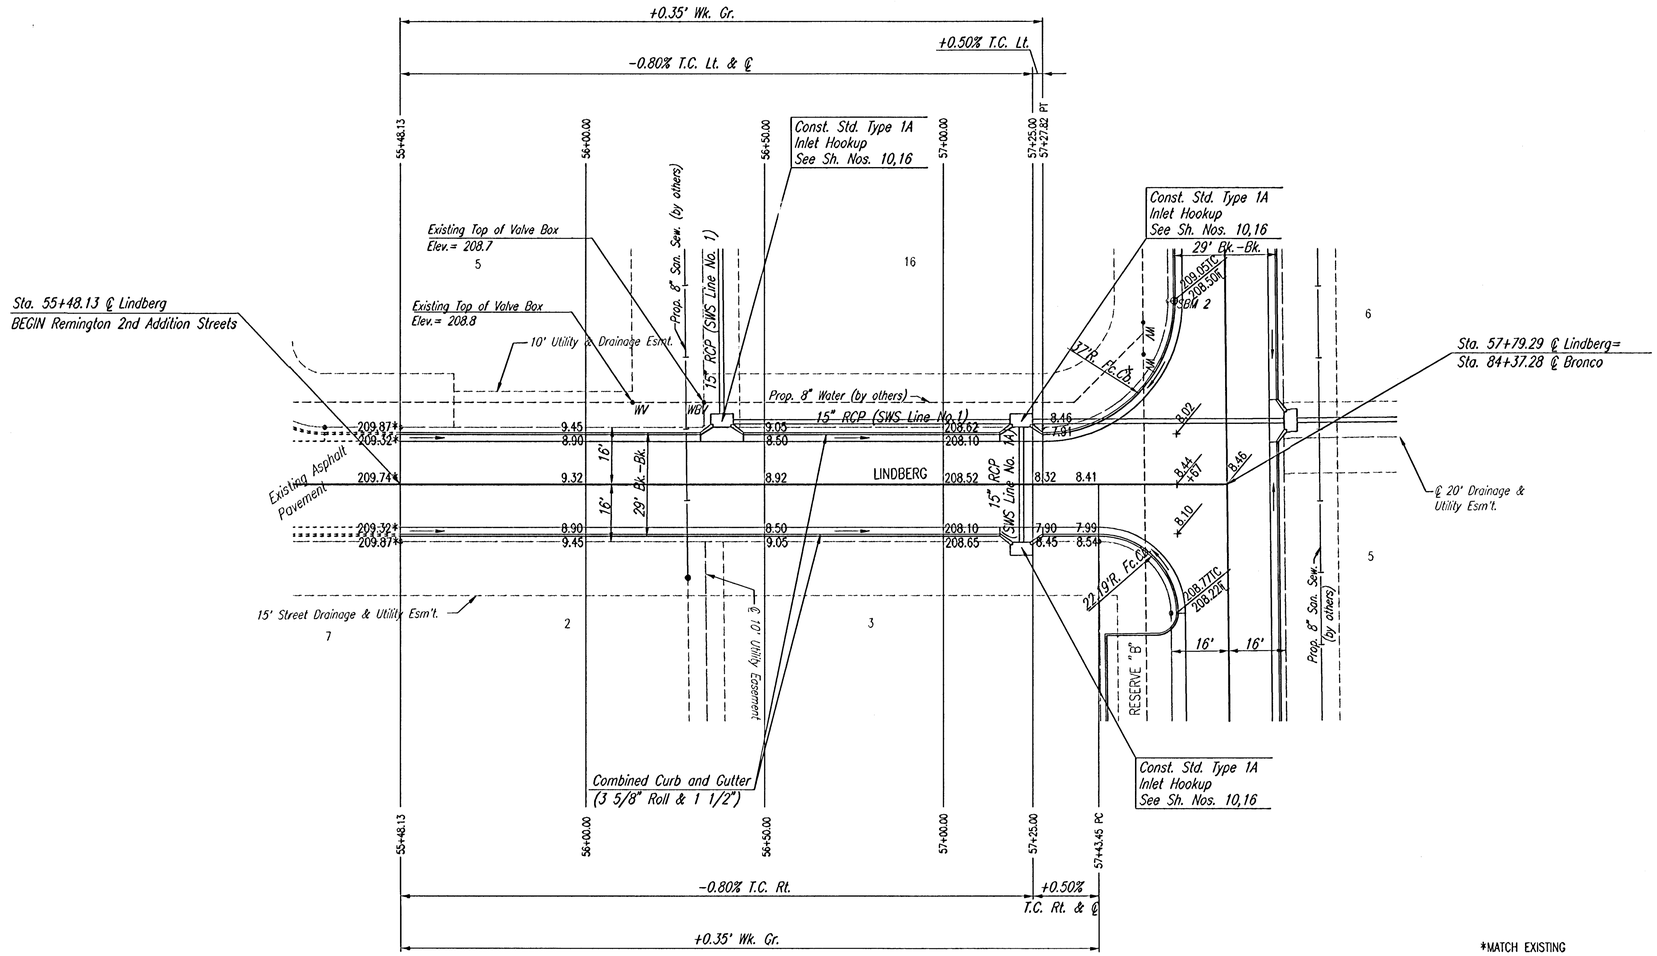

*MATCH EXISTING

NOTE: THIS STREET TO BE CONSTRUCTED WITH ROLL-TYPE CURB. TOP OF CURB ELEVATIONS GIVEN ARE FOR FULL HEIGHT CURB.

22 NOV 03
RECORD DRAWING

No.	Revision	By	Date

REMINGTON PLACE 2ND ADDITION
NEIL D. CABLE P.E. - CITY ENGINEER

LINDBERG
STA. 55+48.13 TO STA. 57+79.29

CITY OF WICHITA PROJECT NO. 472-83678

Professional Engineering Consultants, P.A.
303 S. TOPEKA • WICHITA, KANSAS 67202
316-262-2691 • FAX 316-262-3003

Designed by	BER, JJD	Job No.	35-02662
Drawn by	TLS	Date	January 2003

Sht. 4 of 17

DSNR: BER OPER: TLS SCALE: 1=20.00
Q:\2002\02662\000\LINDBERG 03-04-2003 11:14:38 am