
WATER VALVE BOX ELEVATIONS			
STREET	STATION	OFFSET	PROPOSED ELEVATION
BRONCO	79+88.80	23.00' Rt.	210.7
BRONCO	81+94.80	21.70' Rt.	211.5
BRONCO	83+91.62	23.00' Rt.	209.0
BRONCO	84+00.55	23.00' Rt.	209.1
BRONCO	85+40.09	23.00' Rt.	208.9

SCALE: 1" = 20'

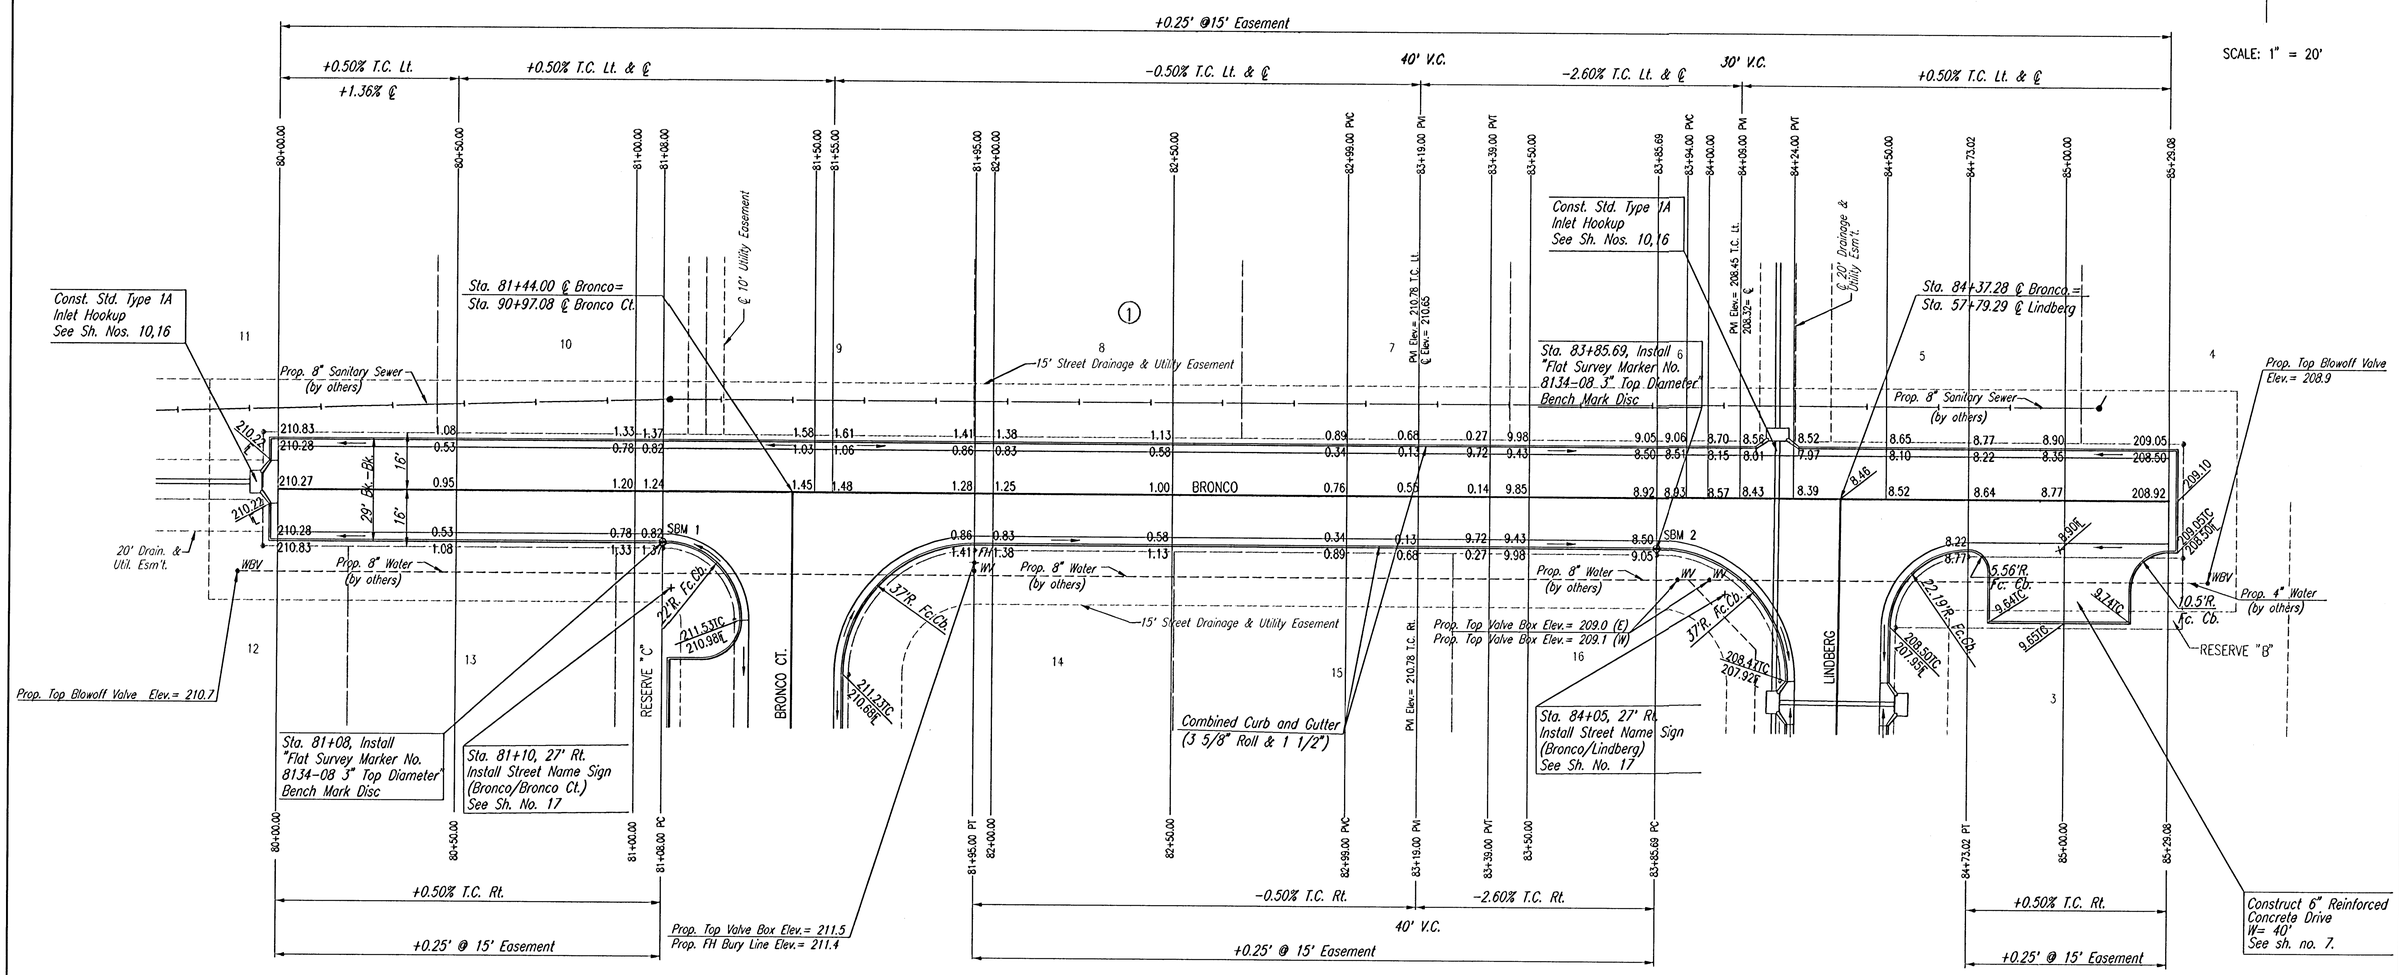

NOTE: THIS STREET TO BE CONSTRUCTED WITH ROLL-TYPE CURB. TOP OF CURB ELEVATIONS GIVEN ARE FOR FULL HEIGHT CURB.

RECORD DRAWING
24 NOV 03

No.	Revision	By	Date

REMINGTON PLACE 2ND ADDITION
NEIL D. CABLE P.E. - CITY ENGINEER

BRONCO

STA. 80+00.00 TO STA. 85+29.08

CITY OF WICHITA PROJECT NO. 472-83678

Professional Engineering Consultants, P.A.
303 S. TOPEKA • WICHITA, KANSAS 67202
316-262-2691 • FAX 316-262-3003

Designed by	BER, JJD	Job No.	35-02662
Drawn by	TLS	Date	January 2003

Sht. 5 of 17

DSNR: BER OPER: TLS SCALE: 1=20.00
Q:\2002\02662\000\BRONCO 03-04-2003 11:17:16 am