

SCALE: 1" = 20'

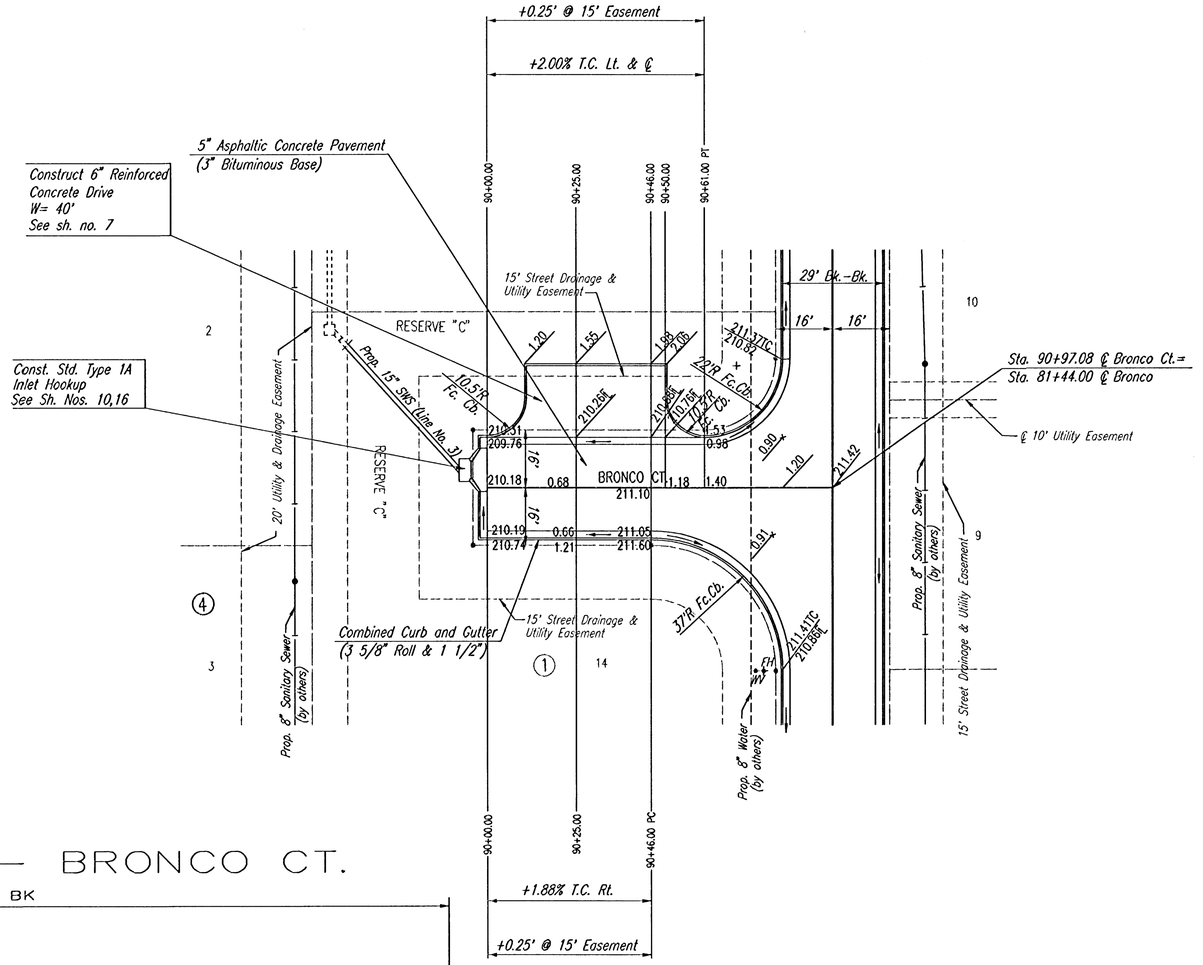

TYPICAL SECTION — BRONCO CT.

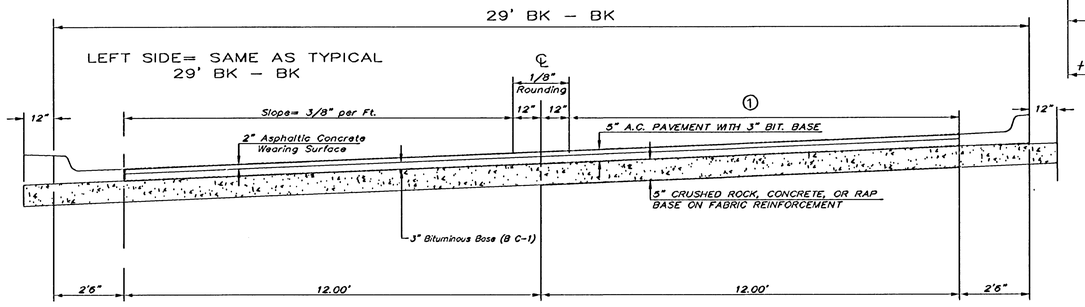

① CROSS SLOPE VARIES FROM 0% AT STA. 90+46 TO 0.5% AT STA. 90+00 SEE PLAN

NOTE: THIS STREET TO BE CONSTRUCTED WITH ROLL-TYPE CURB. TOP OF CURB ELEVATIONS GIVEN ARE FOR FULL HEIGHT CURB.

RECORD DRAWING
24 NOV 03

No.	Revision	By	Date

REMINGTON PLACE 2ND ADDITION
NEIL D. CABLE P.E. - CITY ENGINEER

BRONCO CT.

STA. 90+00.00 TO STA. 90+97.08

CITY OF WICHITA PROJECT NO. 472-83678

Professional Engineering Consultants, P.A.
303 S. TOPEKA • WICHITA, KANSAS 67202
316-262-2691 • FAX 316-262-3003

Designed by	BER, JJD	Job No.	35-02662
Drawn by	TLS	Date	January 2003

Sht. 6 of 17

DSNR: BER OPER: TLS SCALE: 1=20.00
Q:\2002\02662\000\BRONCOCT 03-04-2003 11:19:11 am