



Subdivision Bench Marks				
No.	Street and Station	From CL	Description	Elevation
5	Lydia, Sta. 0+48.49	17.25' Lt	Top of N curb at E end return at Lydia & Lotus	
6	Lydia, Sta. 2+76.51	17.25' Lt	Top of N curb on Lydia @ 61' W of @ of Crestline & Lydia	

Shelly's Orchard

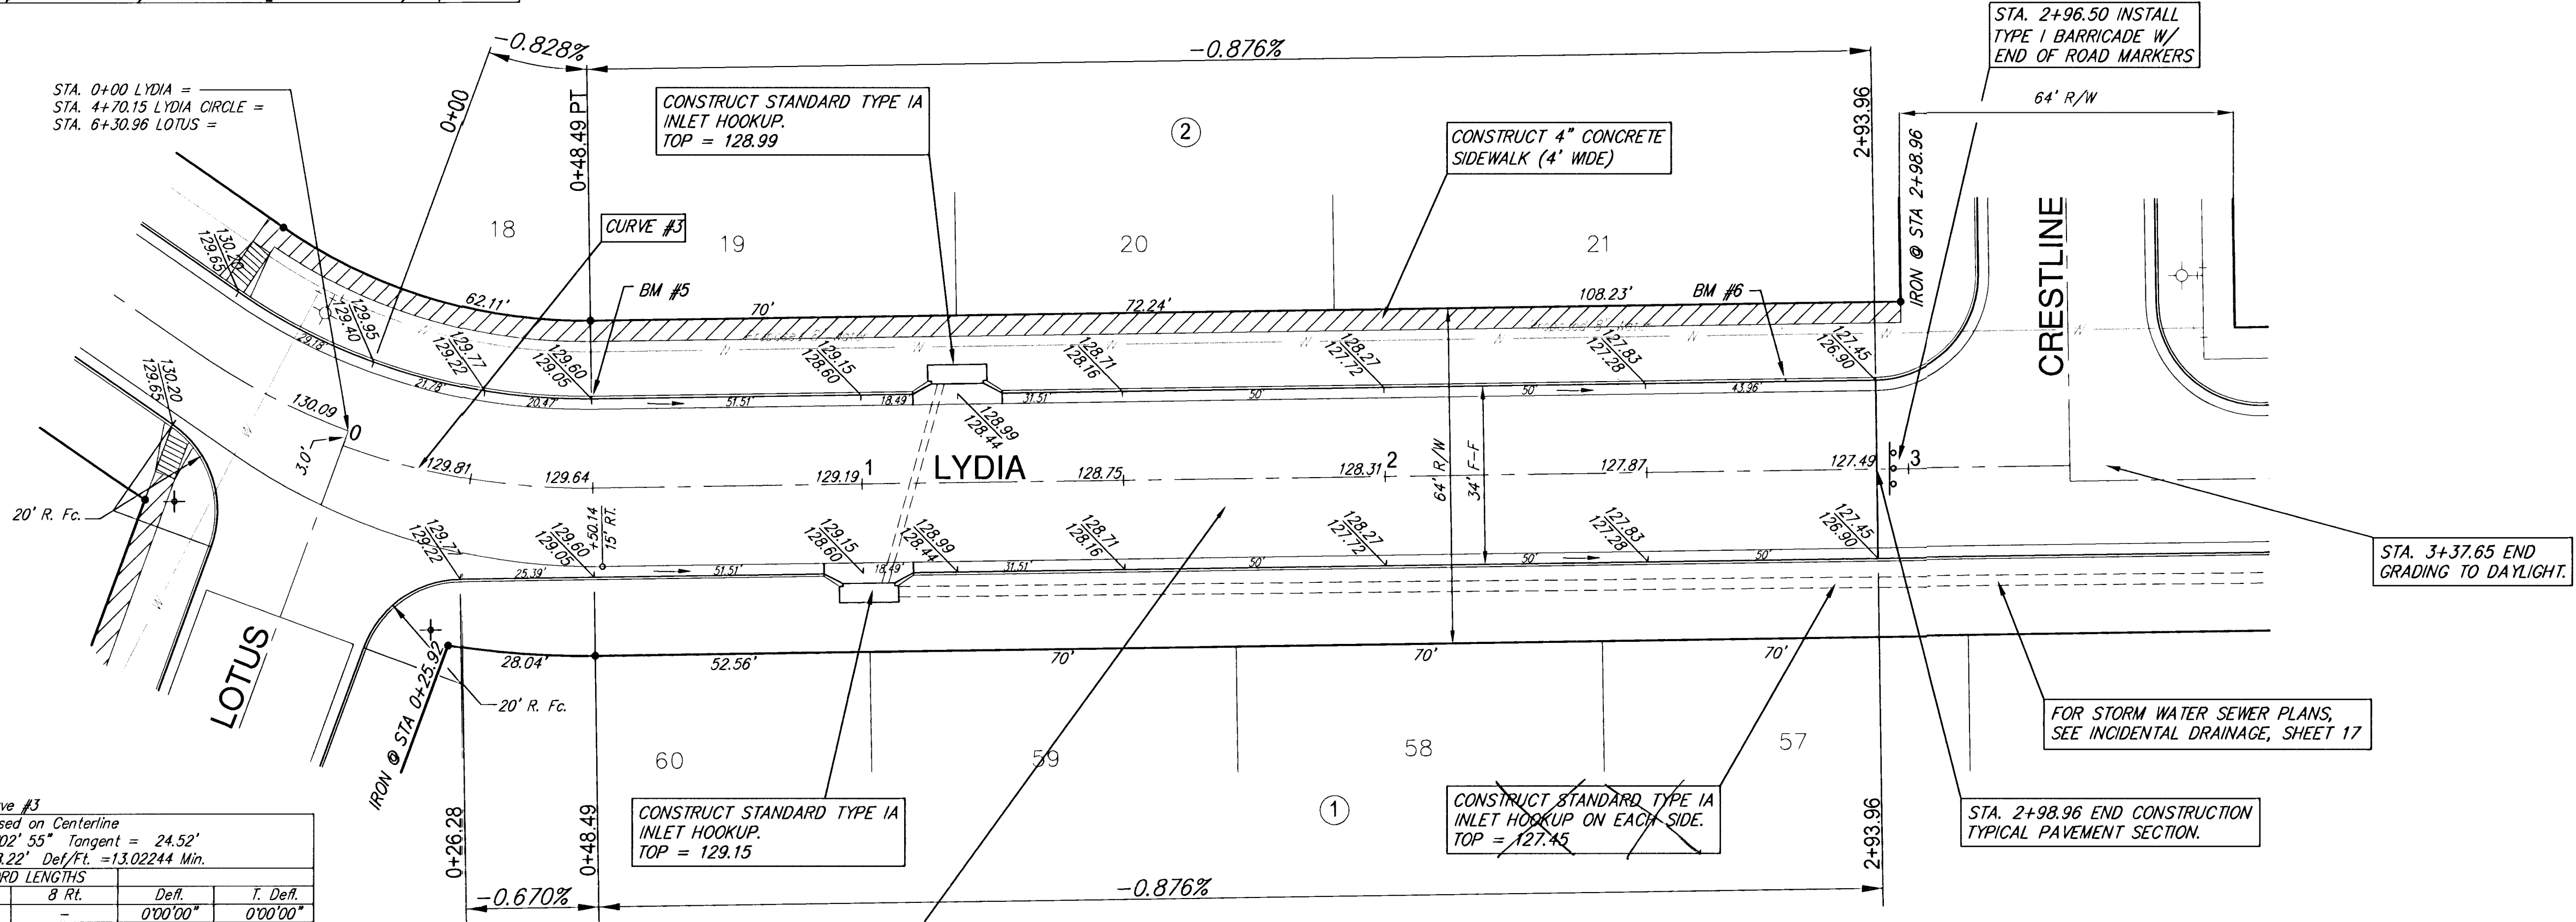

Curve #3				
Curve Data Based on Centerline				
Rad. = 132' Delta = 21°02'55" Tangent = 24.52'				
Arc = 48.49' L.C. = 48.22' Def/Ft. = 13.02244 Min.				
Station	Arc	8 Lt.	8 Rt.	T. Defl.
0+00.00	-	-	-	0°00'00"
0+25.00	25.00'	20.24'	29.69'	5°25'33"
0+48.49	23.49'	0.00'	0.00'	10°31'27"

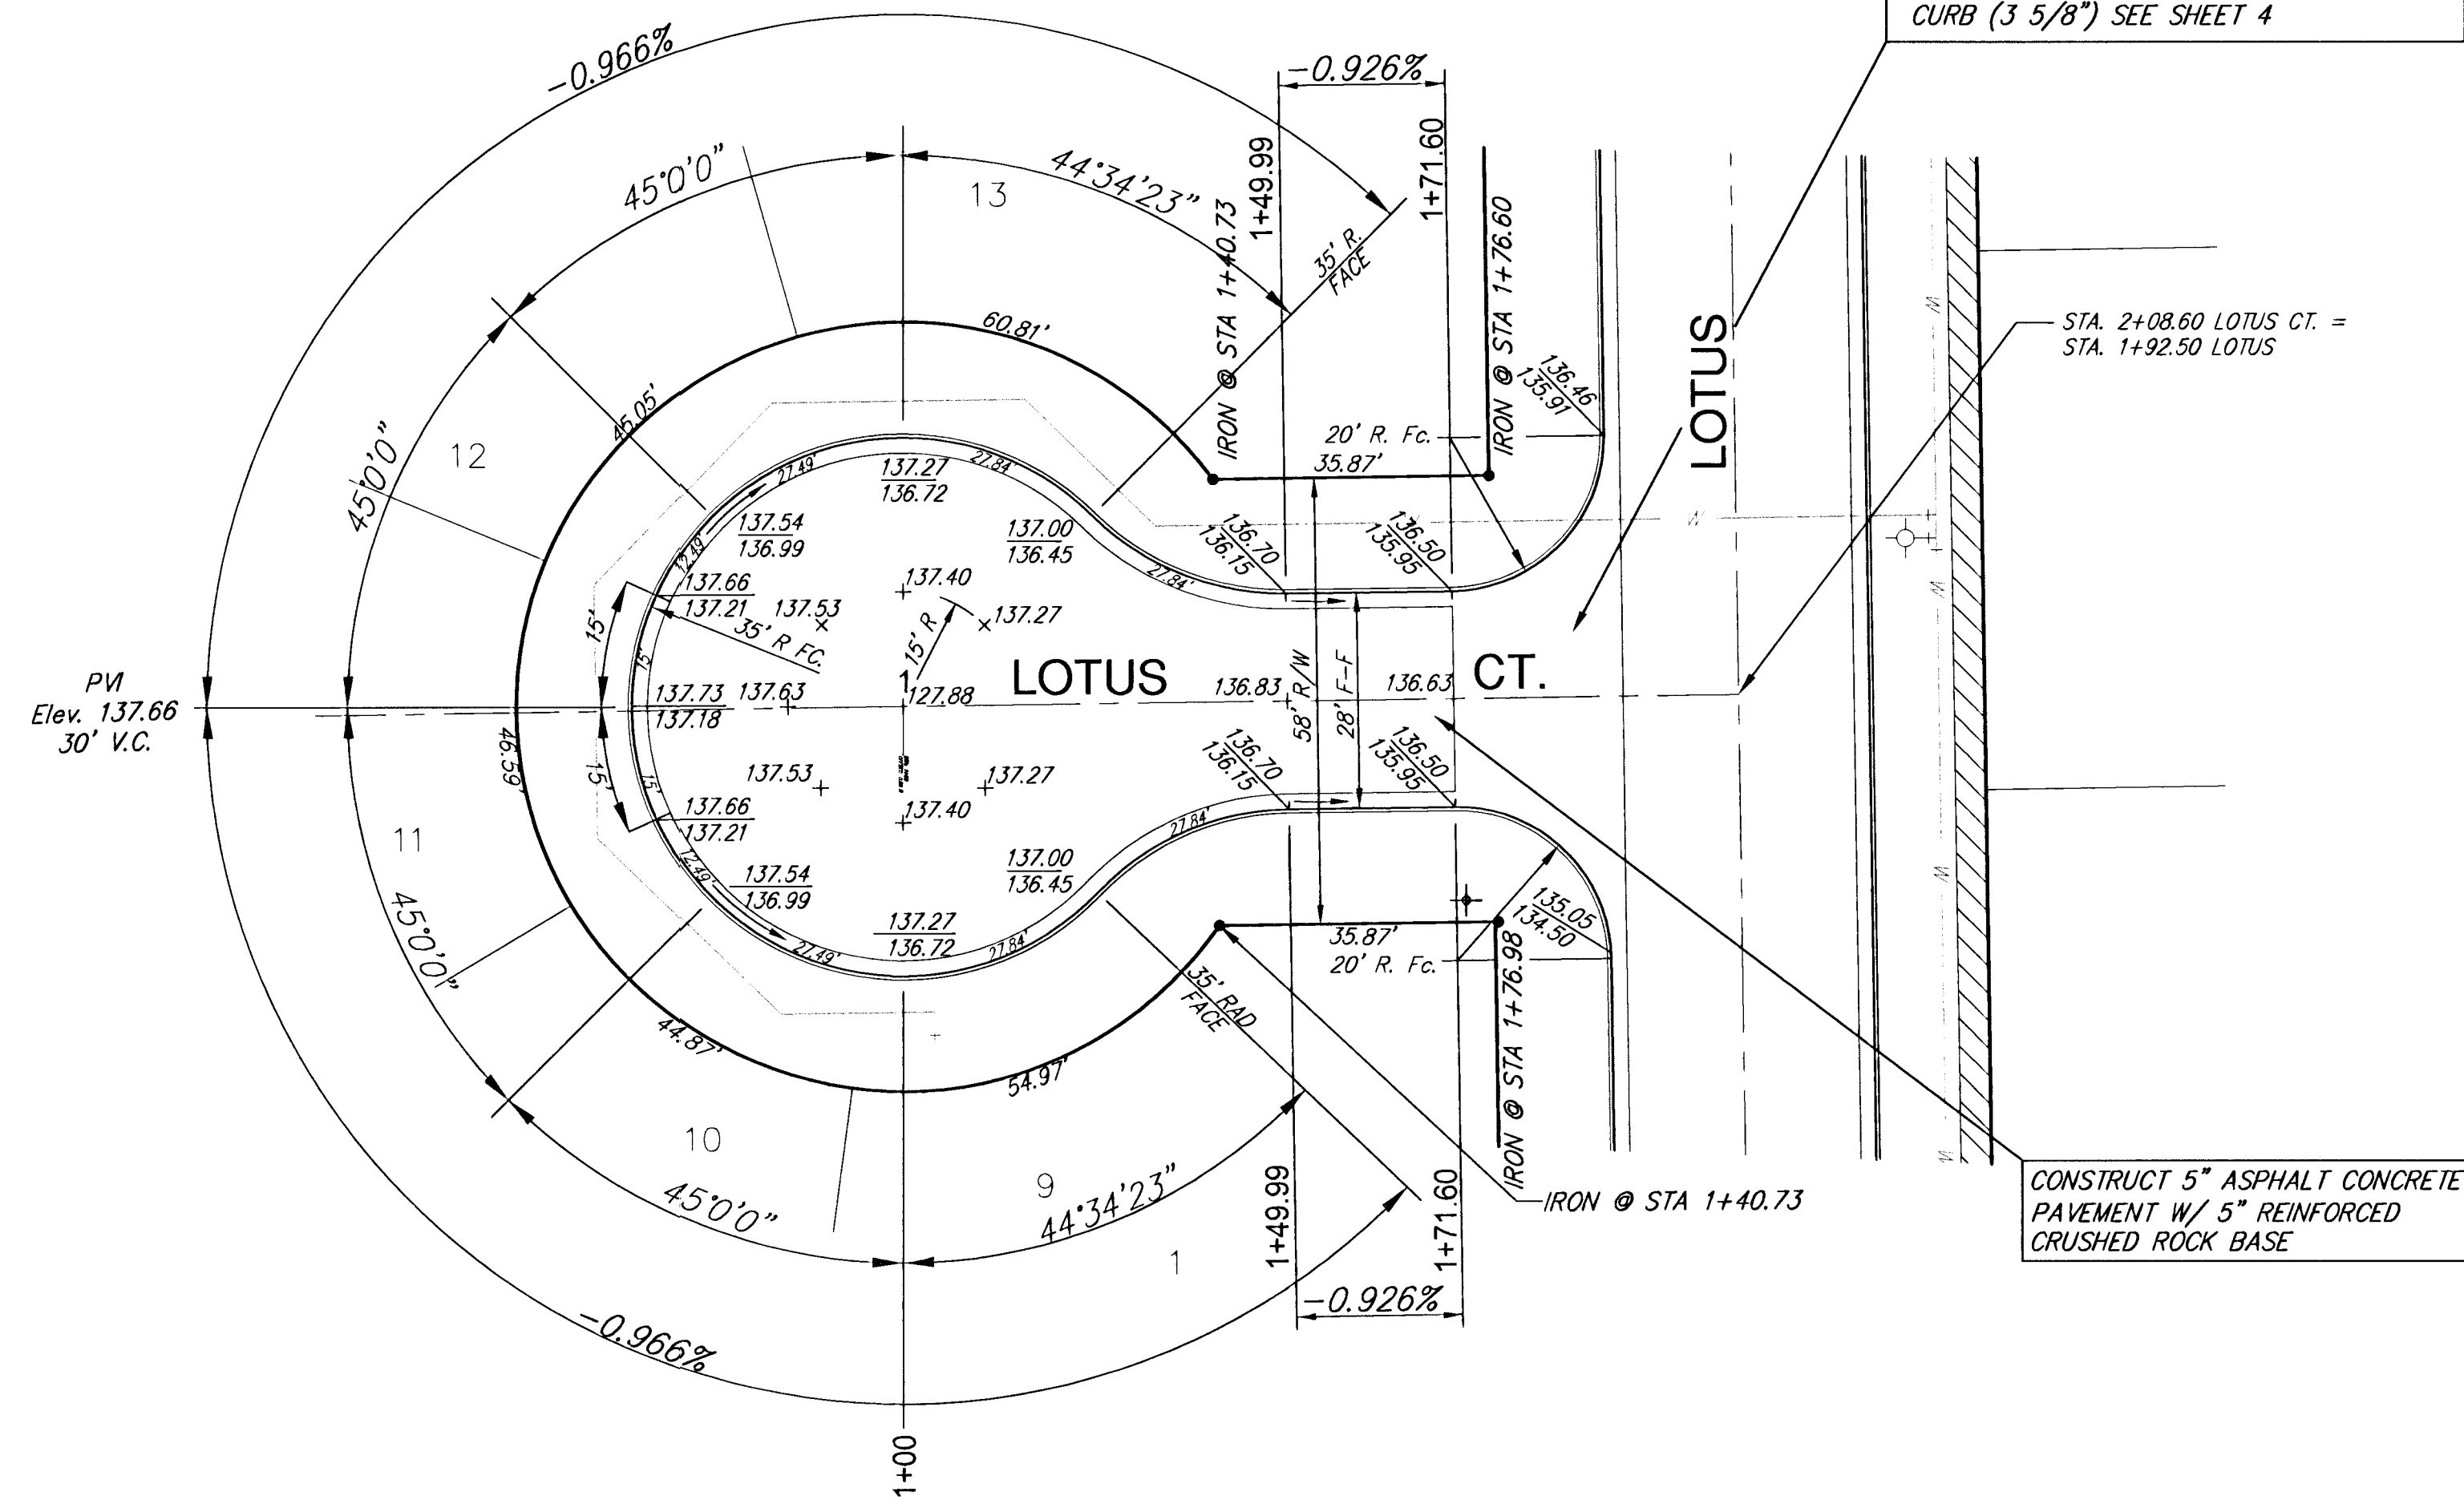

SRB
SCALE 1" = 20'
IRON = •

NOTE: ROLL TYPE CURB AND GUTTER TO BE CONSTRUCTED ALONG PAVEMENT DEPICTED ON THIS SHEET

Shelly's Orchard Addition
Lydia and Lotus Ct.
WICHITA, KANSAS

SRB 924 NORTH MAIN 316-264-8008
WICHITA, KANSAS 67203 FAX 264-4621
www.srb1.com E-mail: srb@srb1.com

SAVOY, RUGGLES & BOHM, P. A.
ENGINEERING & SURVEYING

PROJECT NUMBER
472-83326

DESIGN	DRAWN	UTILITY	REVIEW	DATE	REVISED
CMB	TEB			Apr. 4, 2001	

SRB 005 1855E
SHEET 6 OF 30