
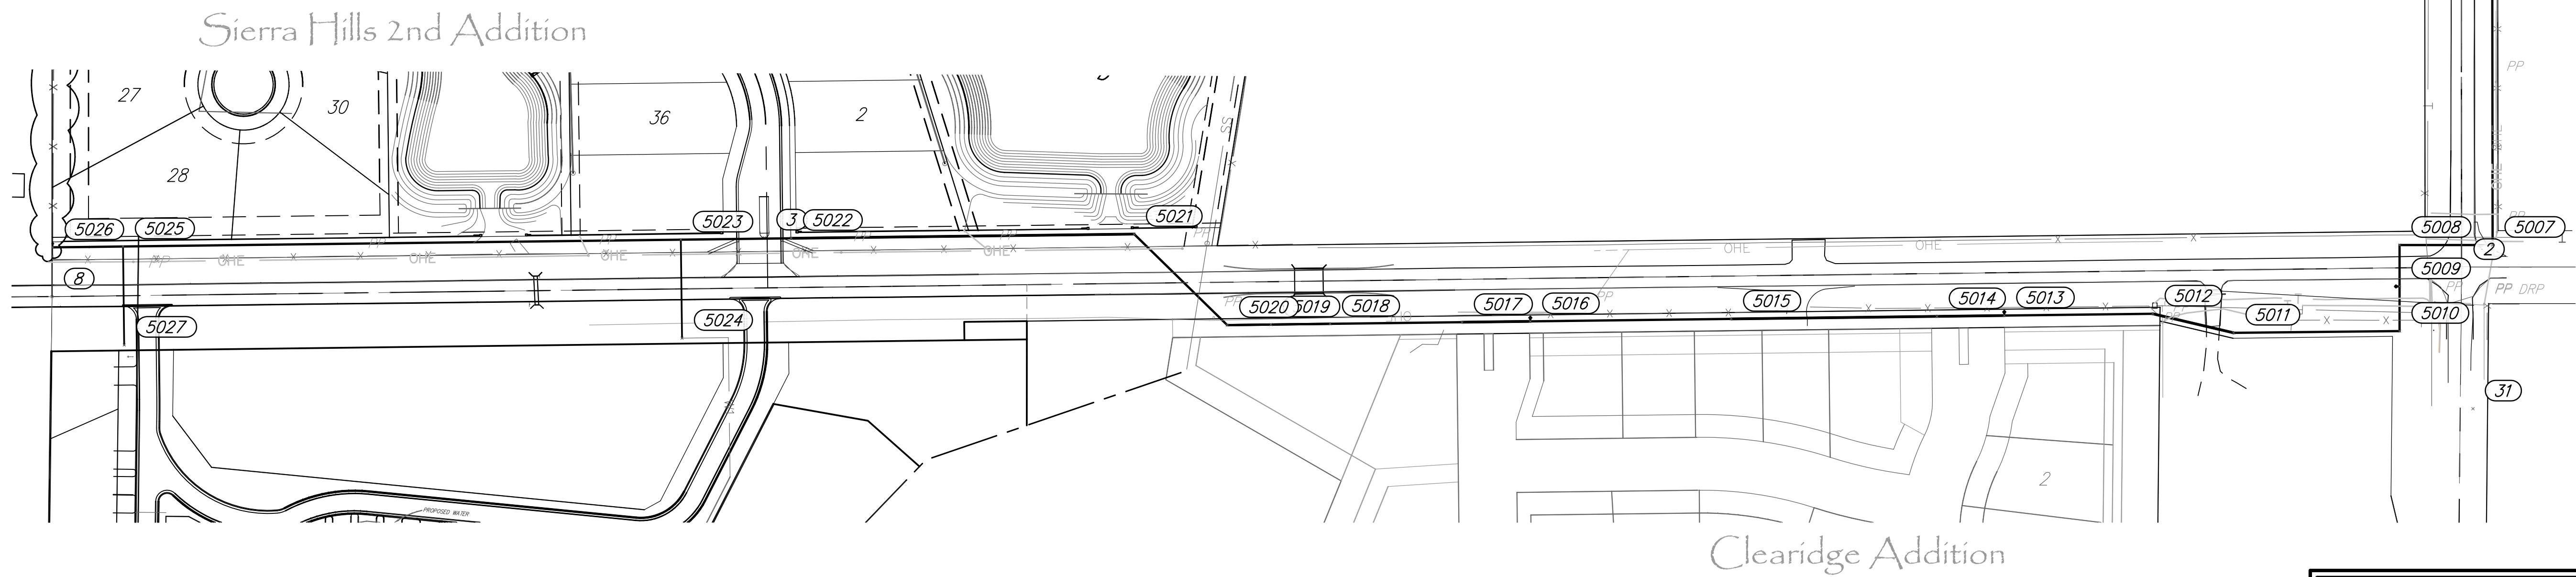
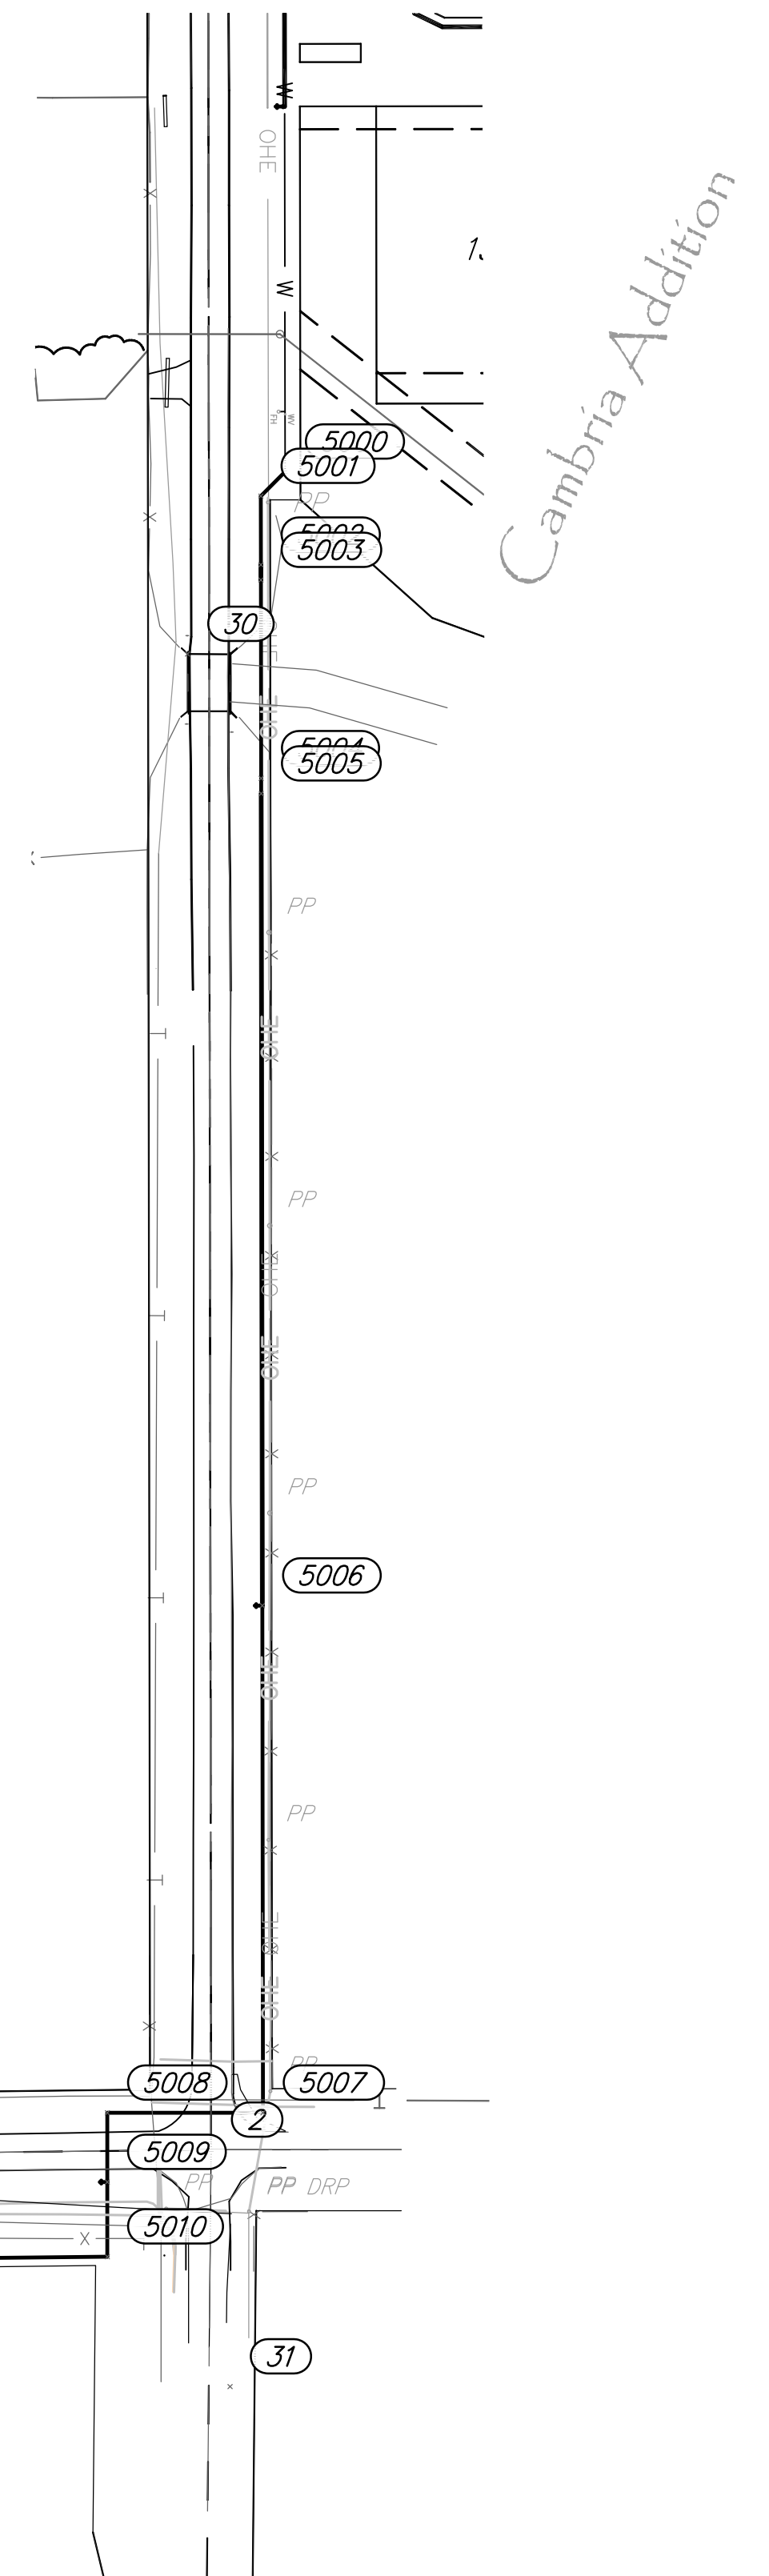


Point Table			
Point #	Northing	Easting	Description
1	20000.04	20000.04	SM 1/2IP
2	17334.17	20003.65	SM CPPD
3	17366.44	18141.82	
8	17301.85	17360.20	SM 5/8 GARBER
30	18314.86	19988.11	BM SQCUT
31	17178.90	20016.01	BM-NENDBRDG
5000	18434.35	20052.14	0+00 BEND
5001	18418.38	20036.21	0+22.56 BEND
5002	18373.34	20036.27	0+67.6 BEND
5003	18363.34	20036.28	0+77.6 BEND
5004	18233.34	20036.46	2+07.6 BEND
5005	18223.34	20036.47	2+17.6 BEND
5006	17690.94	20037.18	7+50 FH
5007	17358.41	20037.62	10+82.53 TEE
5008	17358.41	19935.56	11+84.56 BEND
5009	17312.99	19935.56	12+30 FH
5010	17264.10	19935.56	12+78.9 TEE
5011	17262.17	19753.56	14+60.91 BEND
5012	17283.08	19664.77	15+52.13 BEND
5013	17281.09	19501.91	15+52.31 FH

Point Table			
Point #	Northing	Easting	Description
5014	17280.18	19427.99	17+88.92 TEE
5015	17277.42	19202.33	20+14.61 PVI
5016	17274.72	18981.95	22+35 FH
5017	17273.80	18906.94	23+10.01 TEE
5018	17272.03	18762.36	24+54.61 PVI
5019	17271.23	18697.37	25+19.61 BEND
5020	17270.65	18649.52	25+67.46 BEND
5021	17370.40	18547.29	27+10.29 BEND
5022	17366.02	18171.02	30+86.89 CONNECT
5023	17364.31	18050.01	32+07.61 TEE
5024	17256.32	18051.34	PLUG
5025	17356.81	17438.06	38+19.61 TEE
5026	17355.86	17361.06	38+96.61 END
5027	17248.82	17439.38	PLUG

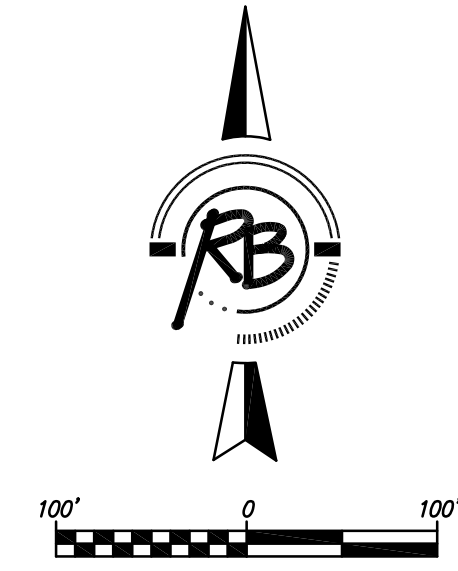

BUBBLE MAP WICHITA, KANSAS			
	RUGGLES & BOHM		DATE Dec. 15, 2016
	<small>ENGINEERING SURVEYING LANDSCAPE ARCHITECTURE GOVERNMENT</small> <small>924 NORTH MAIN WICHITA, KANSAS 67203 P (316) 264-8008 F (316) 264-4621</small> <small>WWW.RBANSAS.COM</small>		DESIGN EJG
PROJECT NUMBER 326BE		DWG. SCALE	SHEET 13
DRAWING FILE Water Engineering Base {Bubble Map}			OF 13