




Unplatted
(Future Clearridge
Addition)

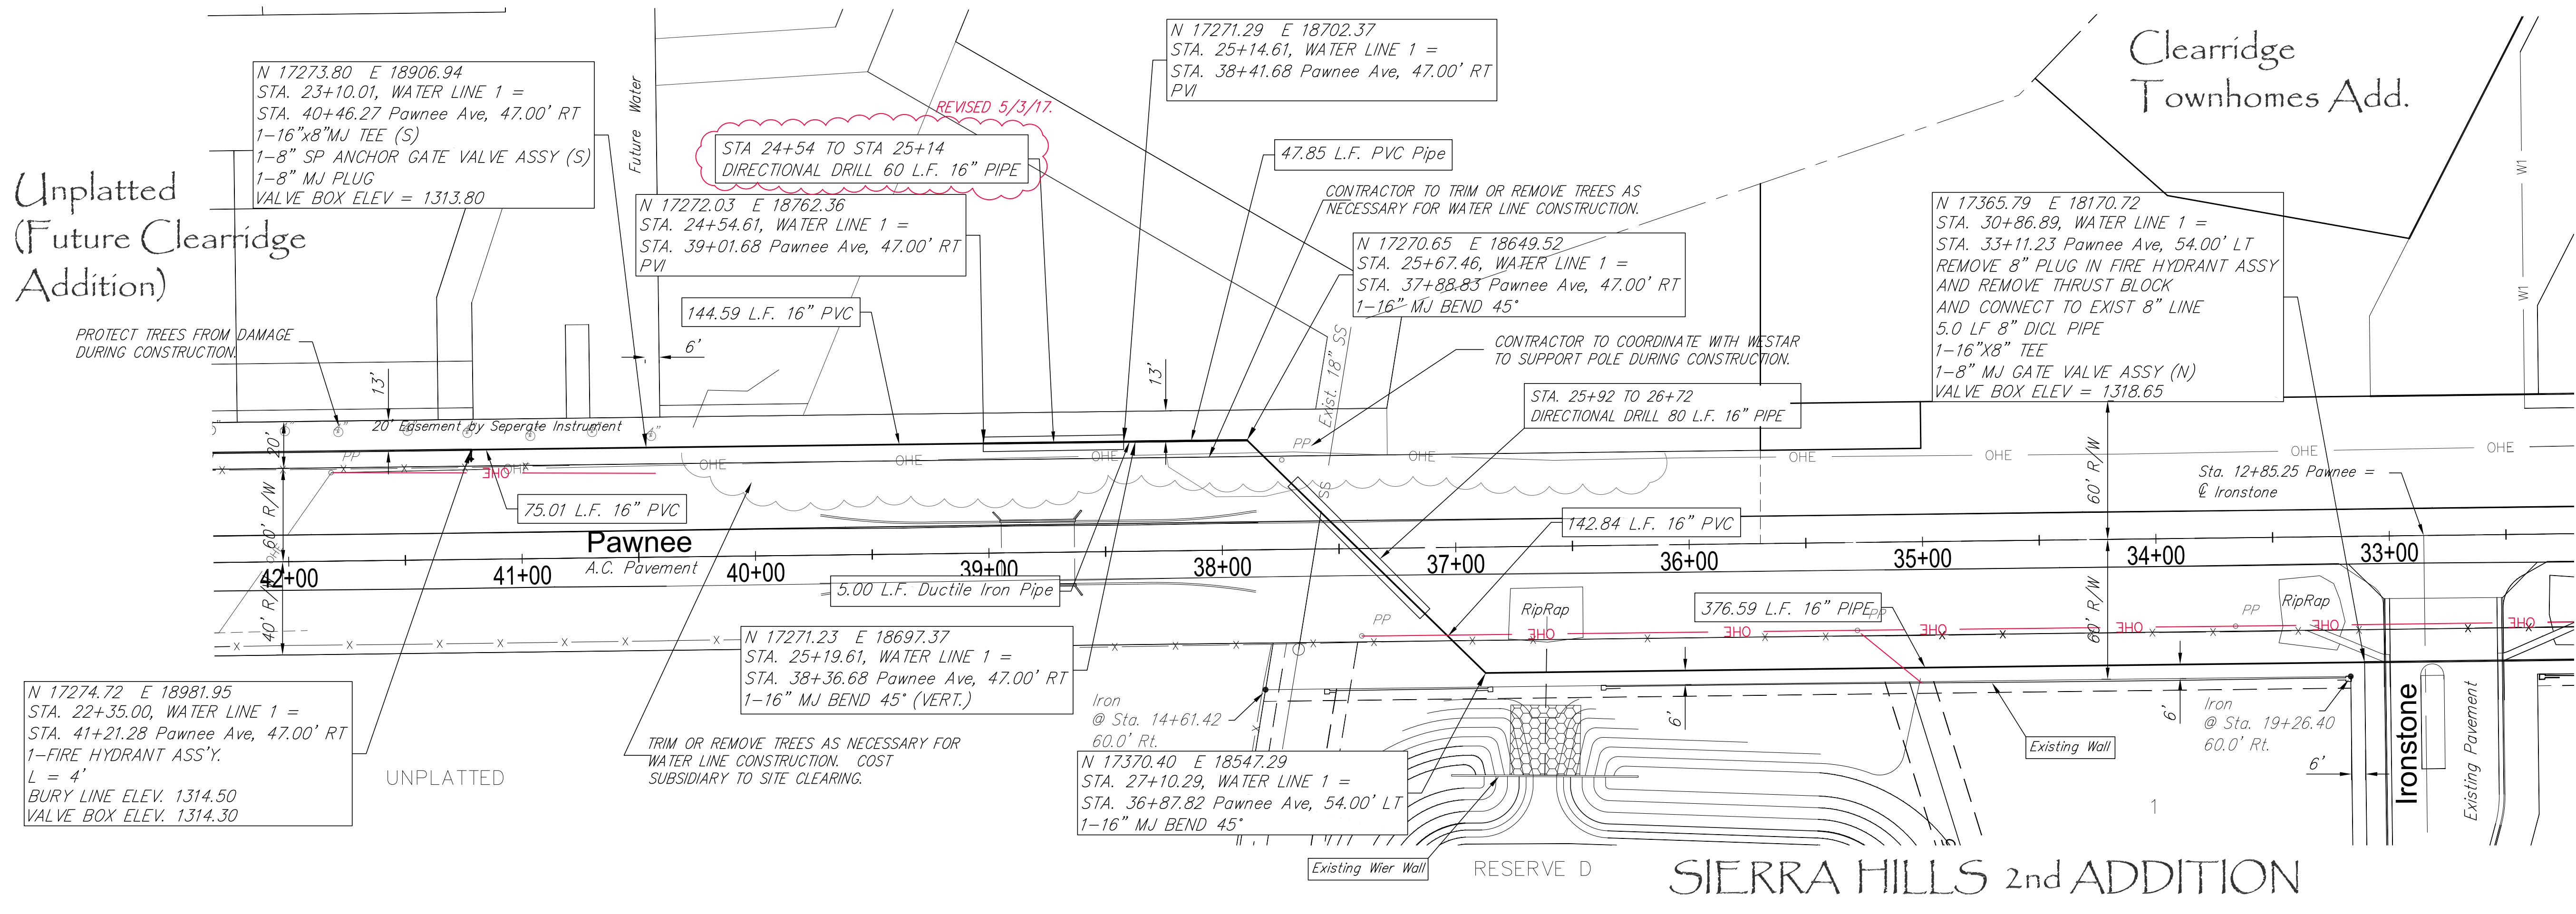

Clearridge
Townhomes Add.

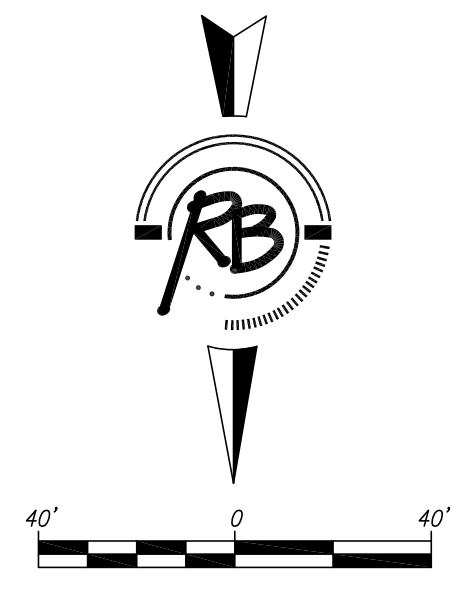

RESERVE D
SIERRA HILLS 2nd ADDITION

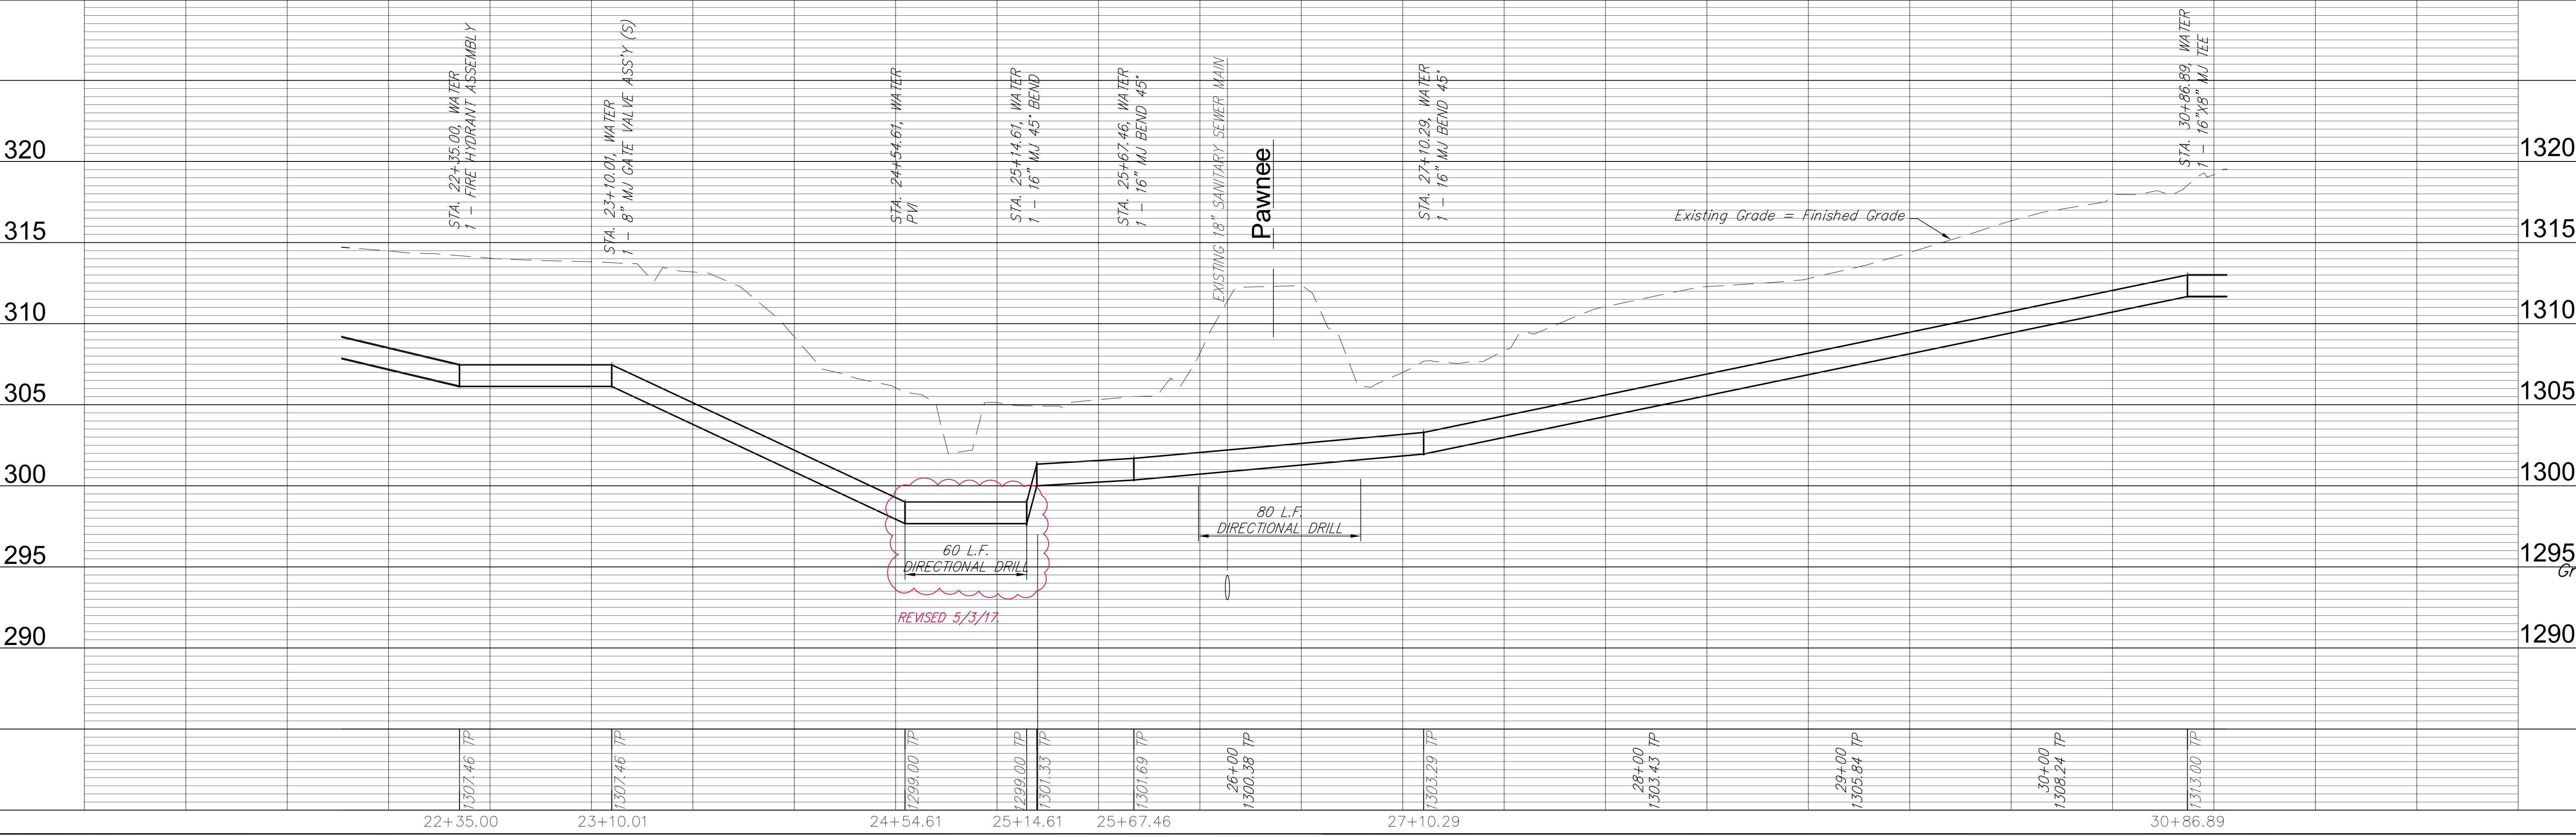

RUGGLES BOHM
 LICENSED PROFESSIONAL ENGINEER
 PROJECT NUMBER: 448-90388
 DESIGN: EJC
 DRAWING FILE: Water Engineering Base (WATER 3)
 REVIEW: RA
 DATE: Aug. 13, 2008
WATER DISTRIBUTION SYSTEM
LINE 1
WICHITA, KANSAS
 RB JOB 3268E
 SHEET 5 OF 13