


BENCHMARK:
 BM #7 - Chiseled "a" on the Top of Curb on the South Side of
 Irving Avenue, 100'± East of Centerline of Meridian.
 Elev. = 1295.86 (NAVD 88)

REGION NO.	STATE	PROJECT NO.	FISCAL YEAR	SHEET NO.	TOTAL SHEETS
7	KANSAS	087 N-0593-01	2015	48	153

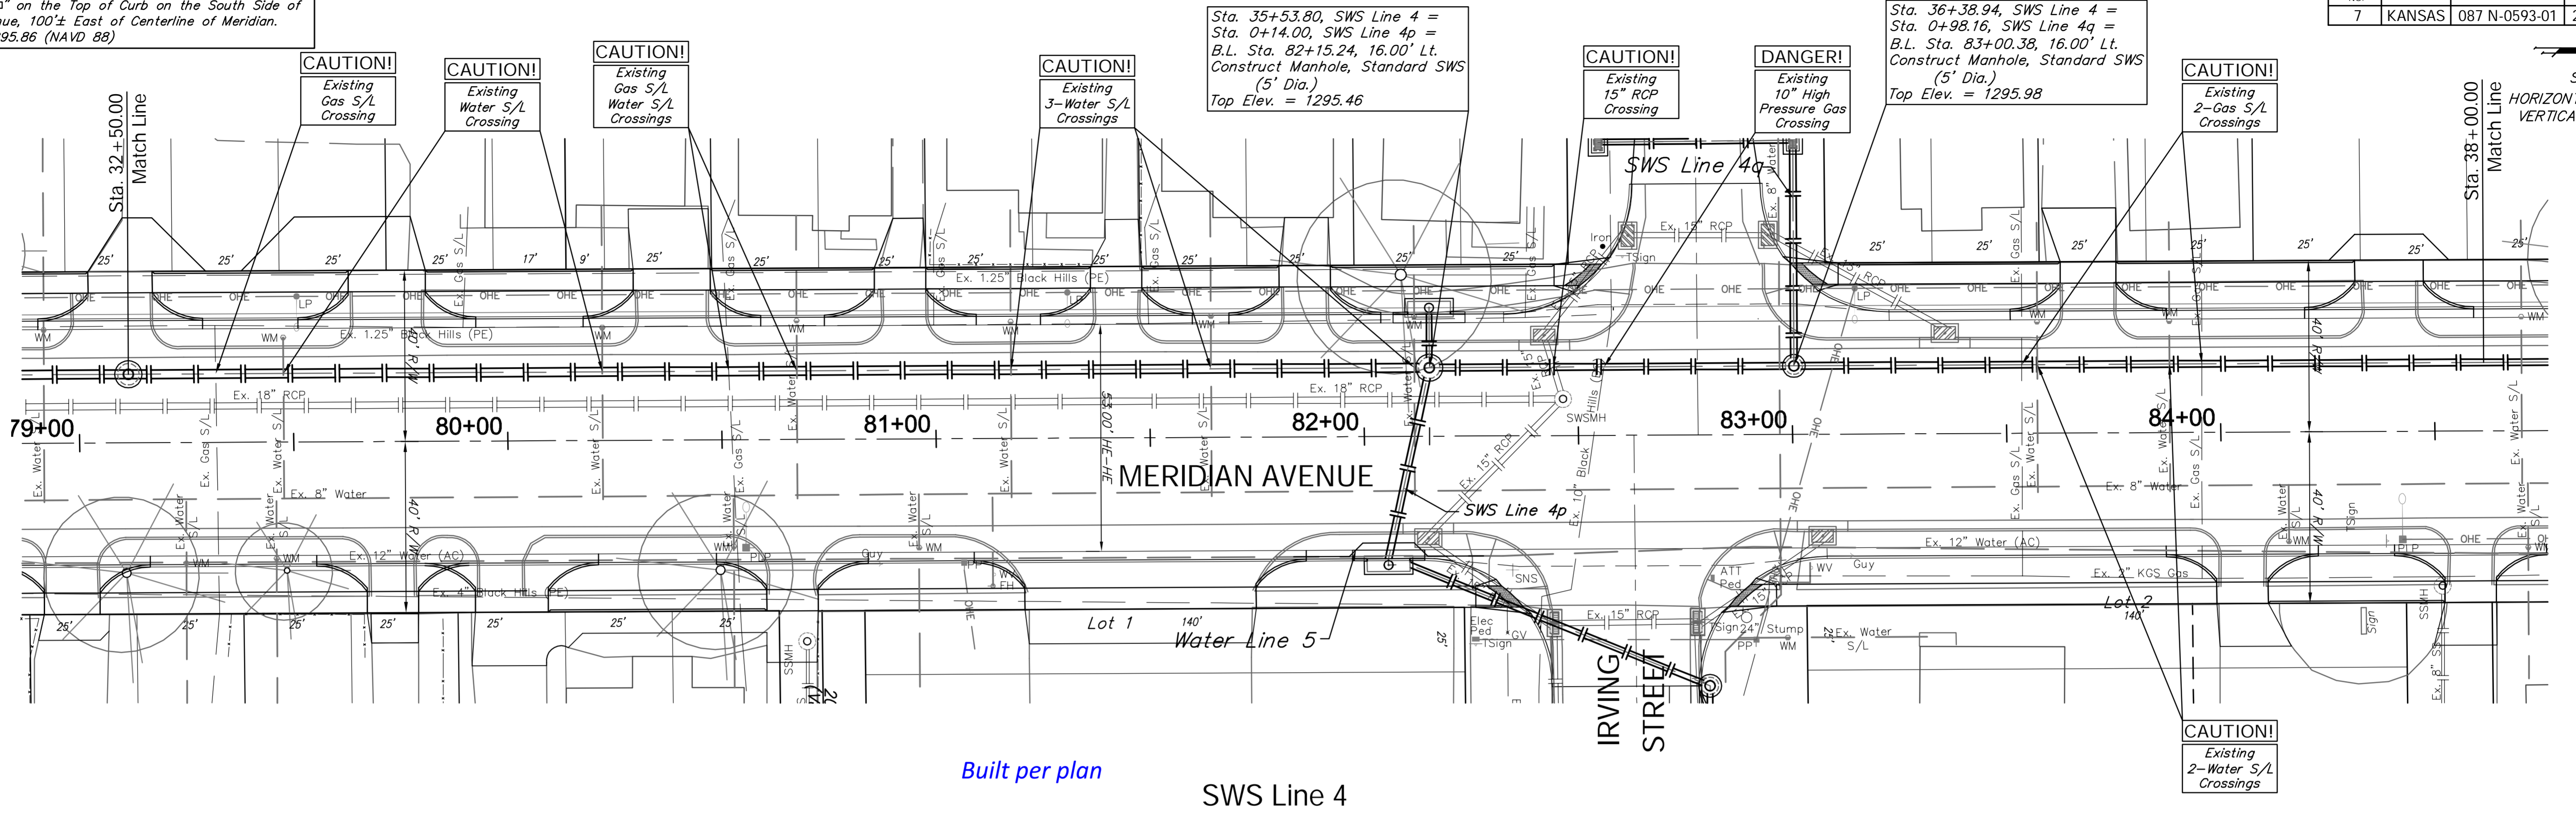

SCALE:
 HORIZONTAL: 1" = 20'
 VERTICAL: 1" = 5'

Built per plan
 SWS Line 4

