


BENCHMARKS:
 BM #3 - City of Wichita Benchmark Disc in the Southeast Corner of the Intersection of Meridian and Harry, 29.5' South and 61' East of the Centerline of Both.
 Elev. = 1294.17 (NAVD 88)

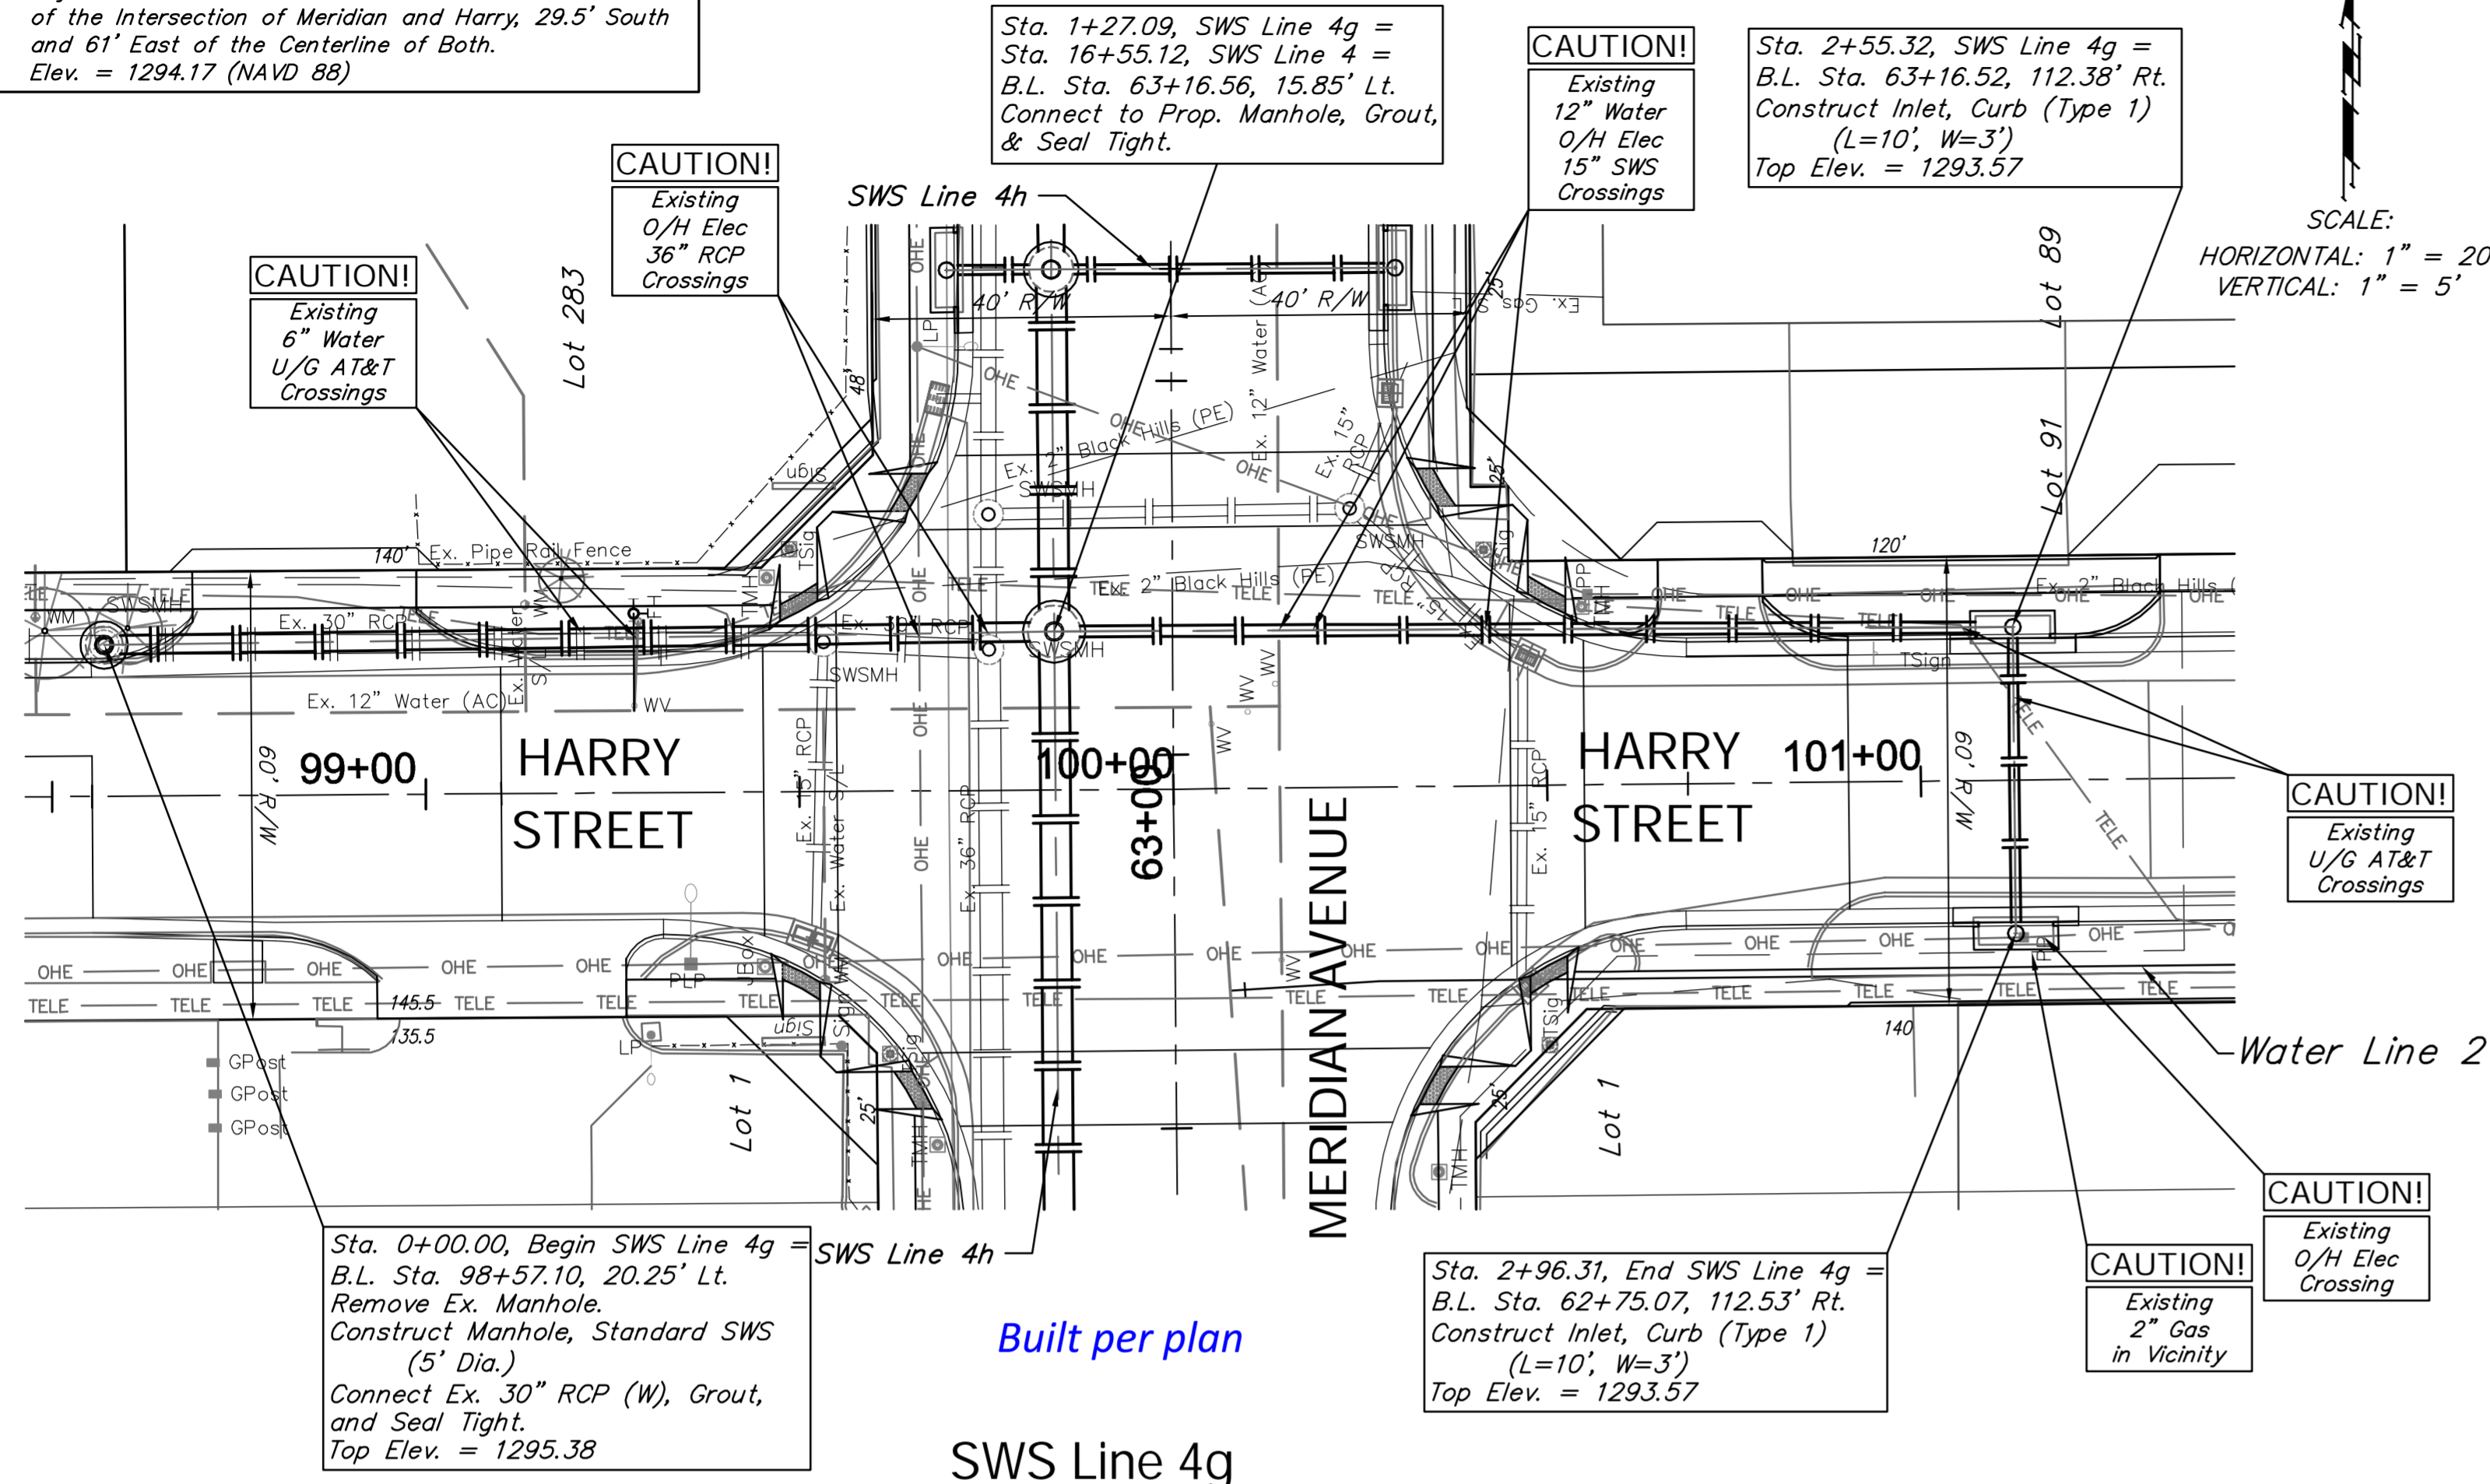

BENCHMARKS:
 BM #3 - City of Wichita Benchmark Disc in the Southeast Corner of the Intersection of Meridian and Harry, 29.5' South and 61' East of the Centerline of Both.
 Elev. = 1294.17 (NAVD 88)

