REMOVE BUTTERFLY VALVE AND REPLACE WITH STEEL PIPE SPOOL.

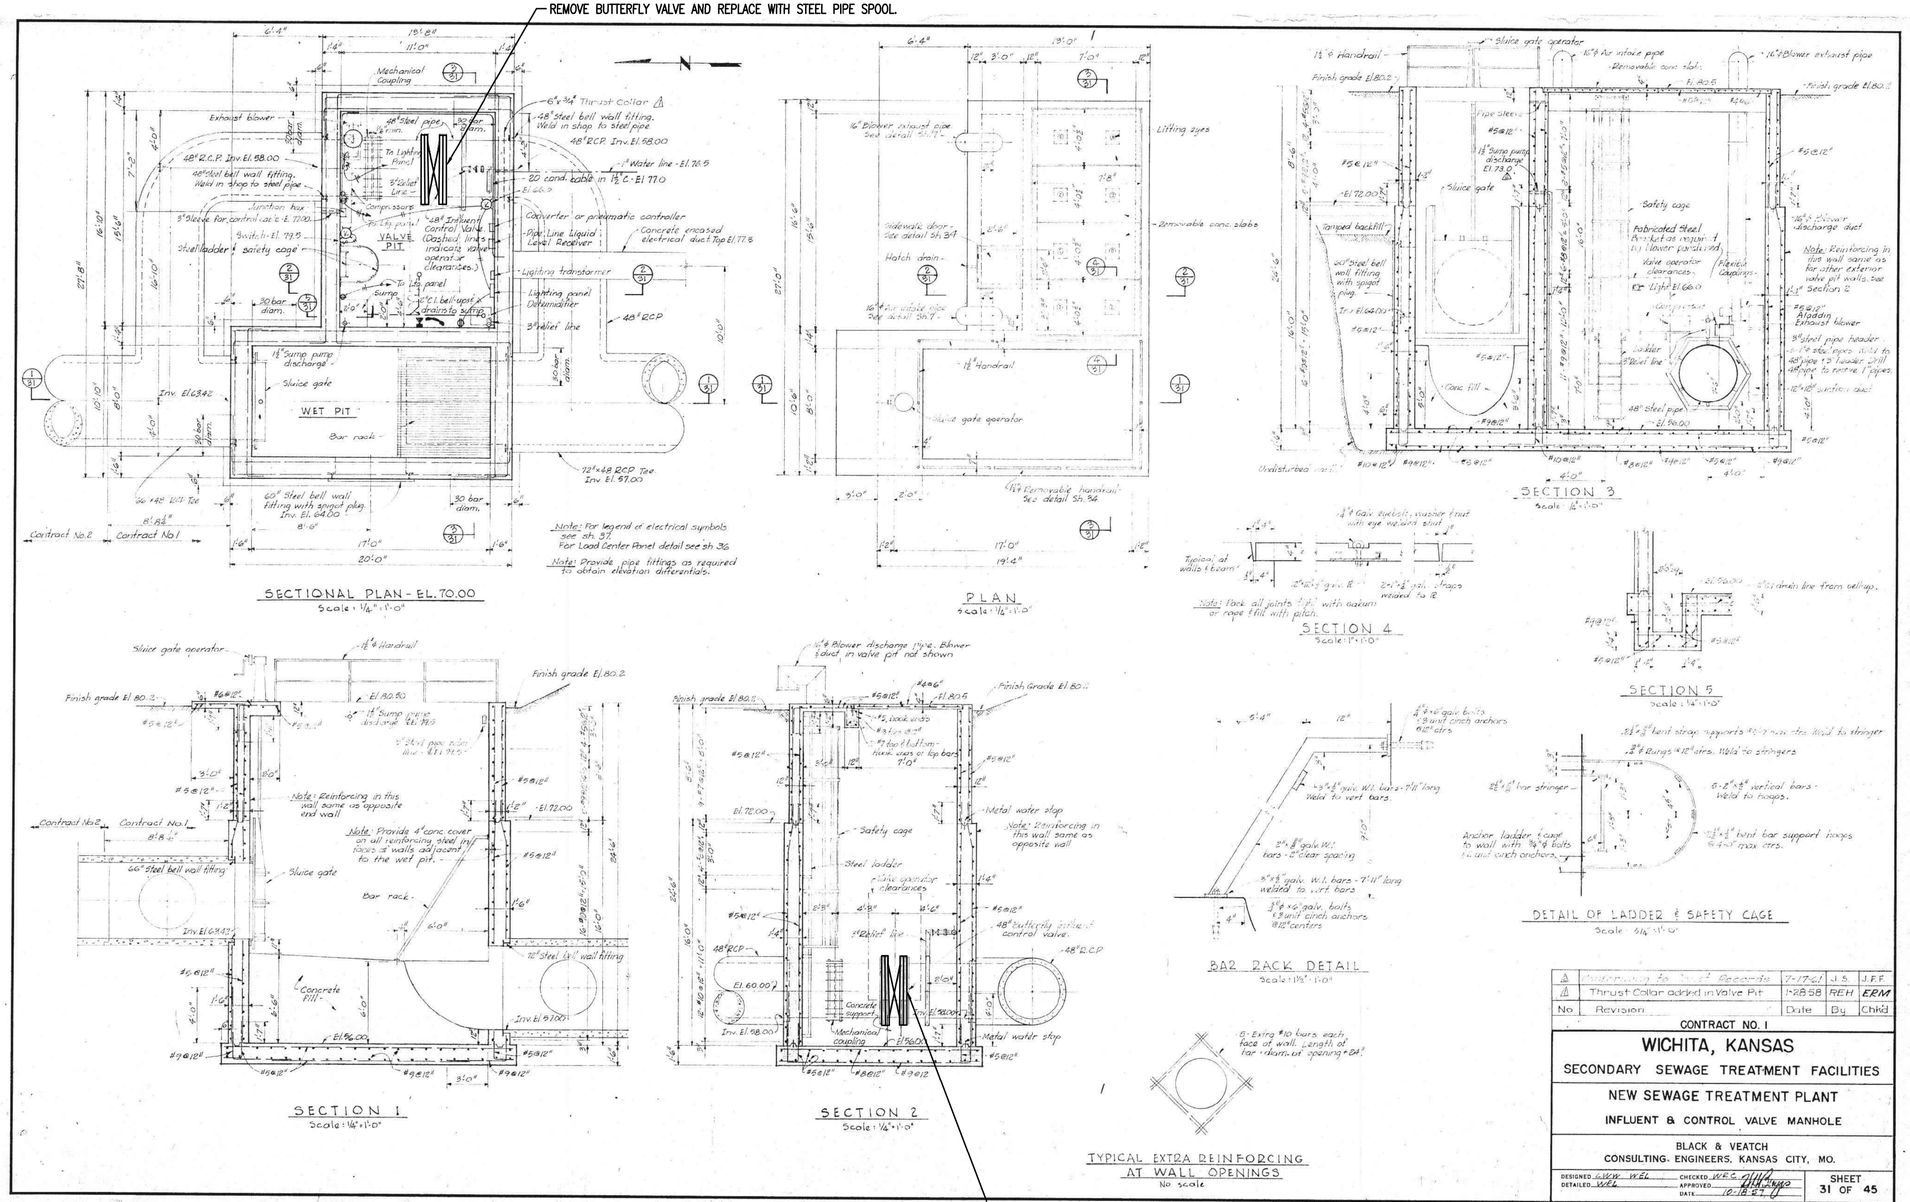

REMOVE BUTTERFLY VALVE AND REPLACE WITH STEEL PIPE SPOOL

No.	Revision	Date	By	Chkd
4	Conforming to "As-Built" Records	7-17-01	J.S.	J.F.F.
1	Thrust Collar added in Valve Pit	1-28-58	FREH	ERM

CONTRACT NO. 1

WICHITA, KANSAS

SECONDARY SEWAGE TREATMENT FACILITIES

NEW SEWAGE TREATMENT PLANT

INFLUENT & CONTROL VALVE MANHOLE

BLACK & VEATCH
CONSULTING ENGINEERS, KANSAS CITY, MO.

DESIGNED GWW WEL CHECKED WEC
DETAILED WEL APPROVED
DATE 10-18-57

SHEET 31 OF 45

PROJECT 263

No.	Revision	By	Date

WASTEWATER PLANT 2
INFLUENT FORCE MAIN – PHASE 2

BUTTERFLY VALVE REMOVAL 2

GARY JANZEN, P.E. – CITY ENGINEER
CITY OF WICHITA PROJECT NO. 468-85202

MICHAEL D. KELSEY LICENSED 13944 07/17/2017 KANSAS PROFESSIONAL ENGINEER

PEC PROFESSIONAL ENGINEERING CONSULTANTS, P.A.
303 SOUTH TOPEKA WICHITA, KS 67202
316-262-2691 www.pec1.com

Designed by	MDK, TBK	Job No.	35-15554-1-0042
Drawn by	CSL, KTD	Date	NOVEMBER 2016

Sht. CA330 of 60

Saved: 07-03-2017 2:34:12 PM by KURTIS DEKAT
Plot Scale: 1:1 07-03-2017 3:39:27 PM by KURTIS DEKAT
U:\Wichita-Civil\2015\155554\001\Main\Drawings\Phase 2\15554-001-CA330-BUTTERFLY VALVE REMOVAL 2