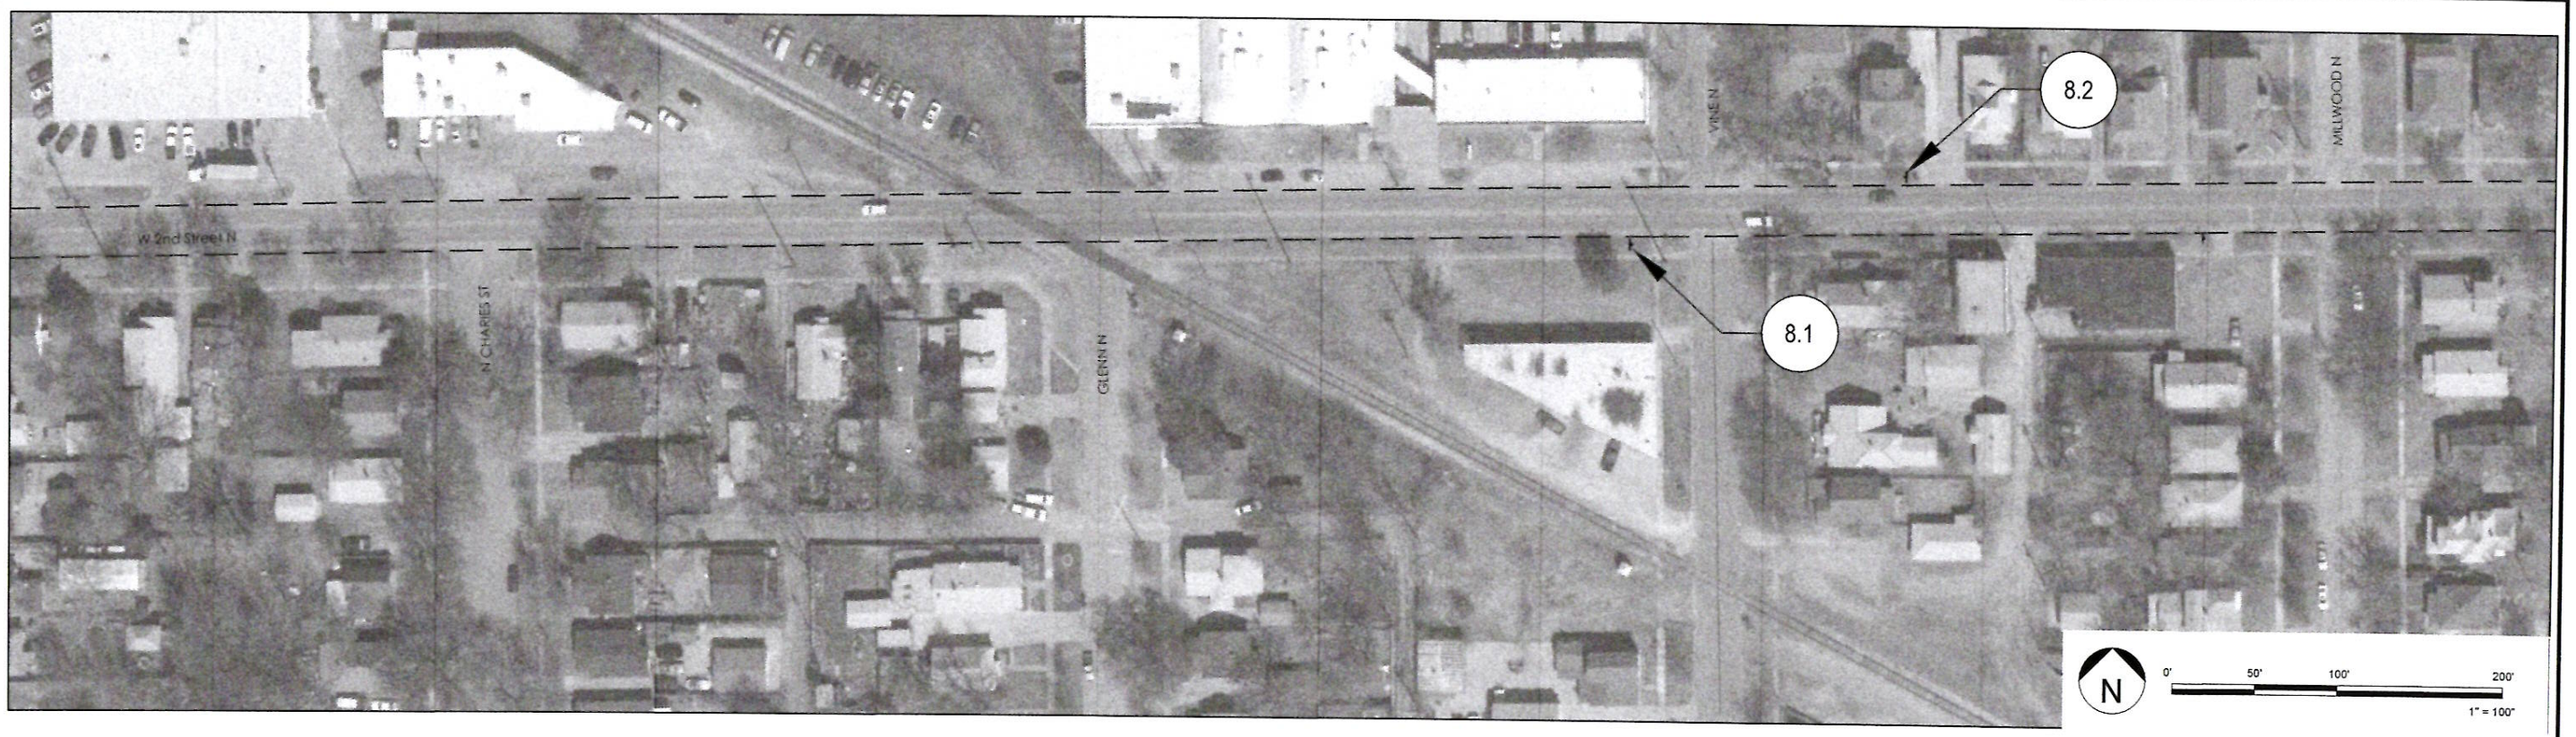

SIGN SCHEDULE

SIGN ID	TRAVEL DIRECTION	SIGN TYPE	ARROW DIRECTION	DESTINATION NAME	CODE	MILES	TRAVEL TIME (MIN)	PHASE	NOTES
8.1	Eastbound	On Street Directional	S	Downtown		1.0	6	1	Waco & 1st
			R	Delano Shopping District		0.1	1	1	Douglas and Vine
			~~R~~	~~Friends University~~				~~2~~	~~Add when safe facilities established~~
8.2	Westbound	On Street Directional	~~S~~	~~Zoo~~				~~2~~	~~Add when safe facilities established~~
			L	Delano Shopping District		0.1	1	1	Douglas and Vine
			~~L~~	~~Friends University~~				~~2~~	~~Add when safe facilities established~~

WAYFINDING DETAIL

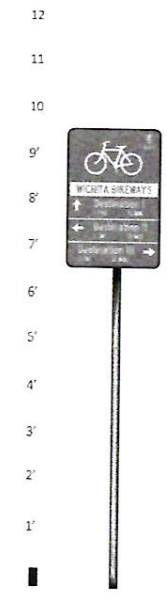

ON-STREET DIRECTIONAL

PAUL L. WOJCIECHOWSKI LICENSED 23198 KANSAS PROFESSIONAL ENGINEER 5/31/17

DESIGNED:
REVIEWED:
DRAWN:
PROJECT NO.
SCALE AS SHOWN

REVISIONS

NO	DATE	ITEM
1	05.09.17	MILEAGE AND SIGN 23/24 ADDITION
2	07.11.17	WAYFINDING DESIGN INTENT

alta PLANNING + DESIGN
www.altaplanning.com
711 SE Grand Avenue
Portland, Oregon 97211
p:503.230.9862 f:503.230.9862

KEY NOTES:

Reference Wichita Wayfinding Plan for dimensions,materials, and construction notes for the roadway directional signs.

Reference Wichita Wayfinding Plan for all colors, text, and logo information.

All improvements shall occur within public right of way. City to verify and approve final location.

City to field verify location prior to installation.

Contractor to verify exact locations for all underground and overhead utilities prior to installations and avoid all conflicts.

Contractor to calculate all mileage after stake locations are approved by project owner.

City of Wichita
Master Bicycle Plan
Wichita, Kansas

SHEET NO.
8 OF 28