


BENCHMARKS:
 RR spike in asphalt, SW COR., N1/2, SW1/4, Sec. 34, TWP. 26-S, R-2-E. Elev. = 1400.59 NAVD88

RR spike in E. face of power pole, 174± N. of S. line, N1/2, SW1/4 & 49± E. of W. line, SW1/4, Sec. 34, TWP. 26-S, R-2-E. Elev. = 1398.64 NAVD88

RR spike in S. face of power pole, 294± S. of N. line, SW1/4, & 48± E. of W. line, SW1/4, Sec. 34, TWP. 26-S, R-2-E. Elev. = 1386.14 NAVD88

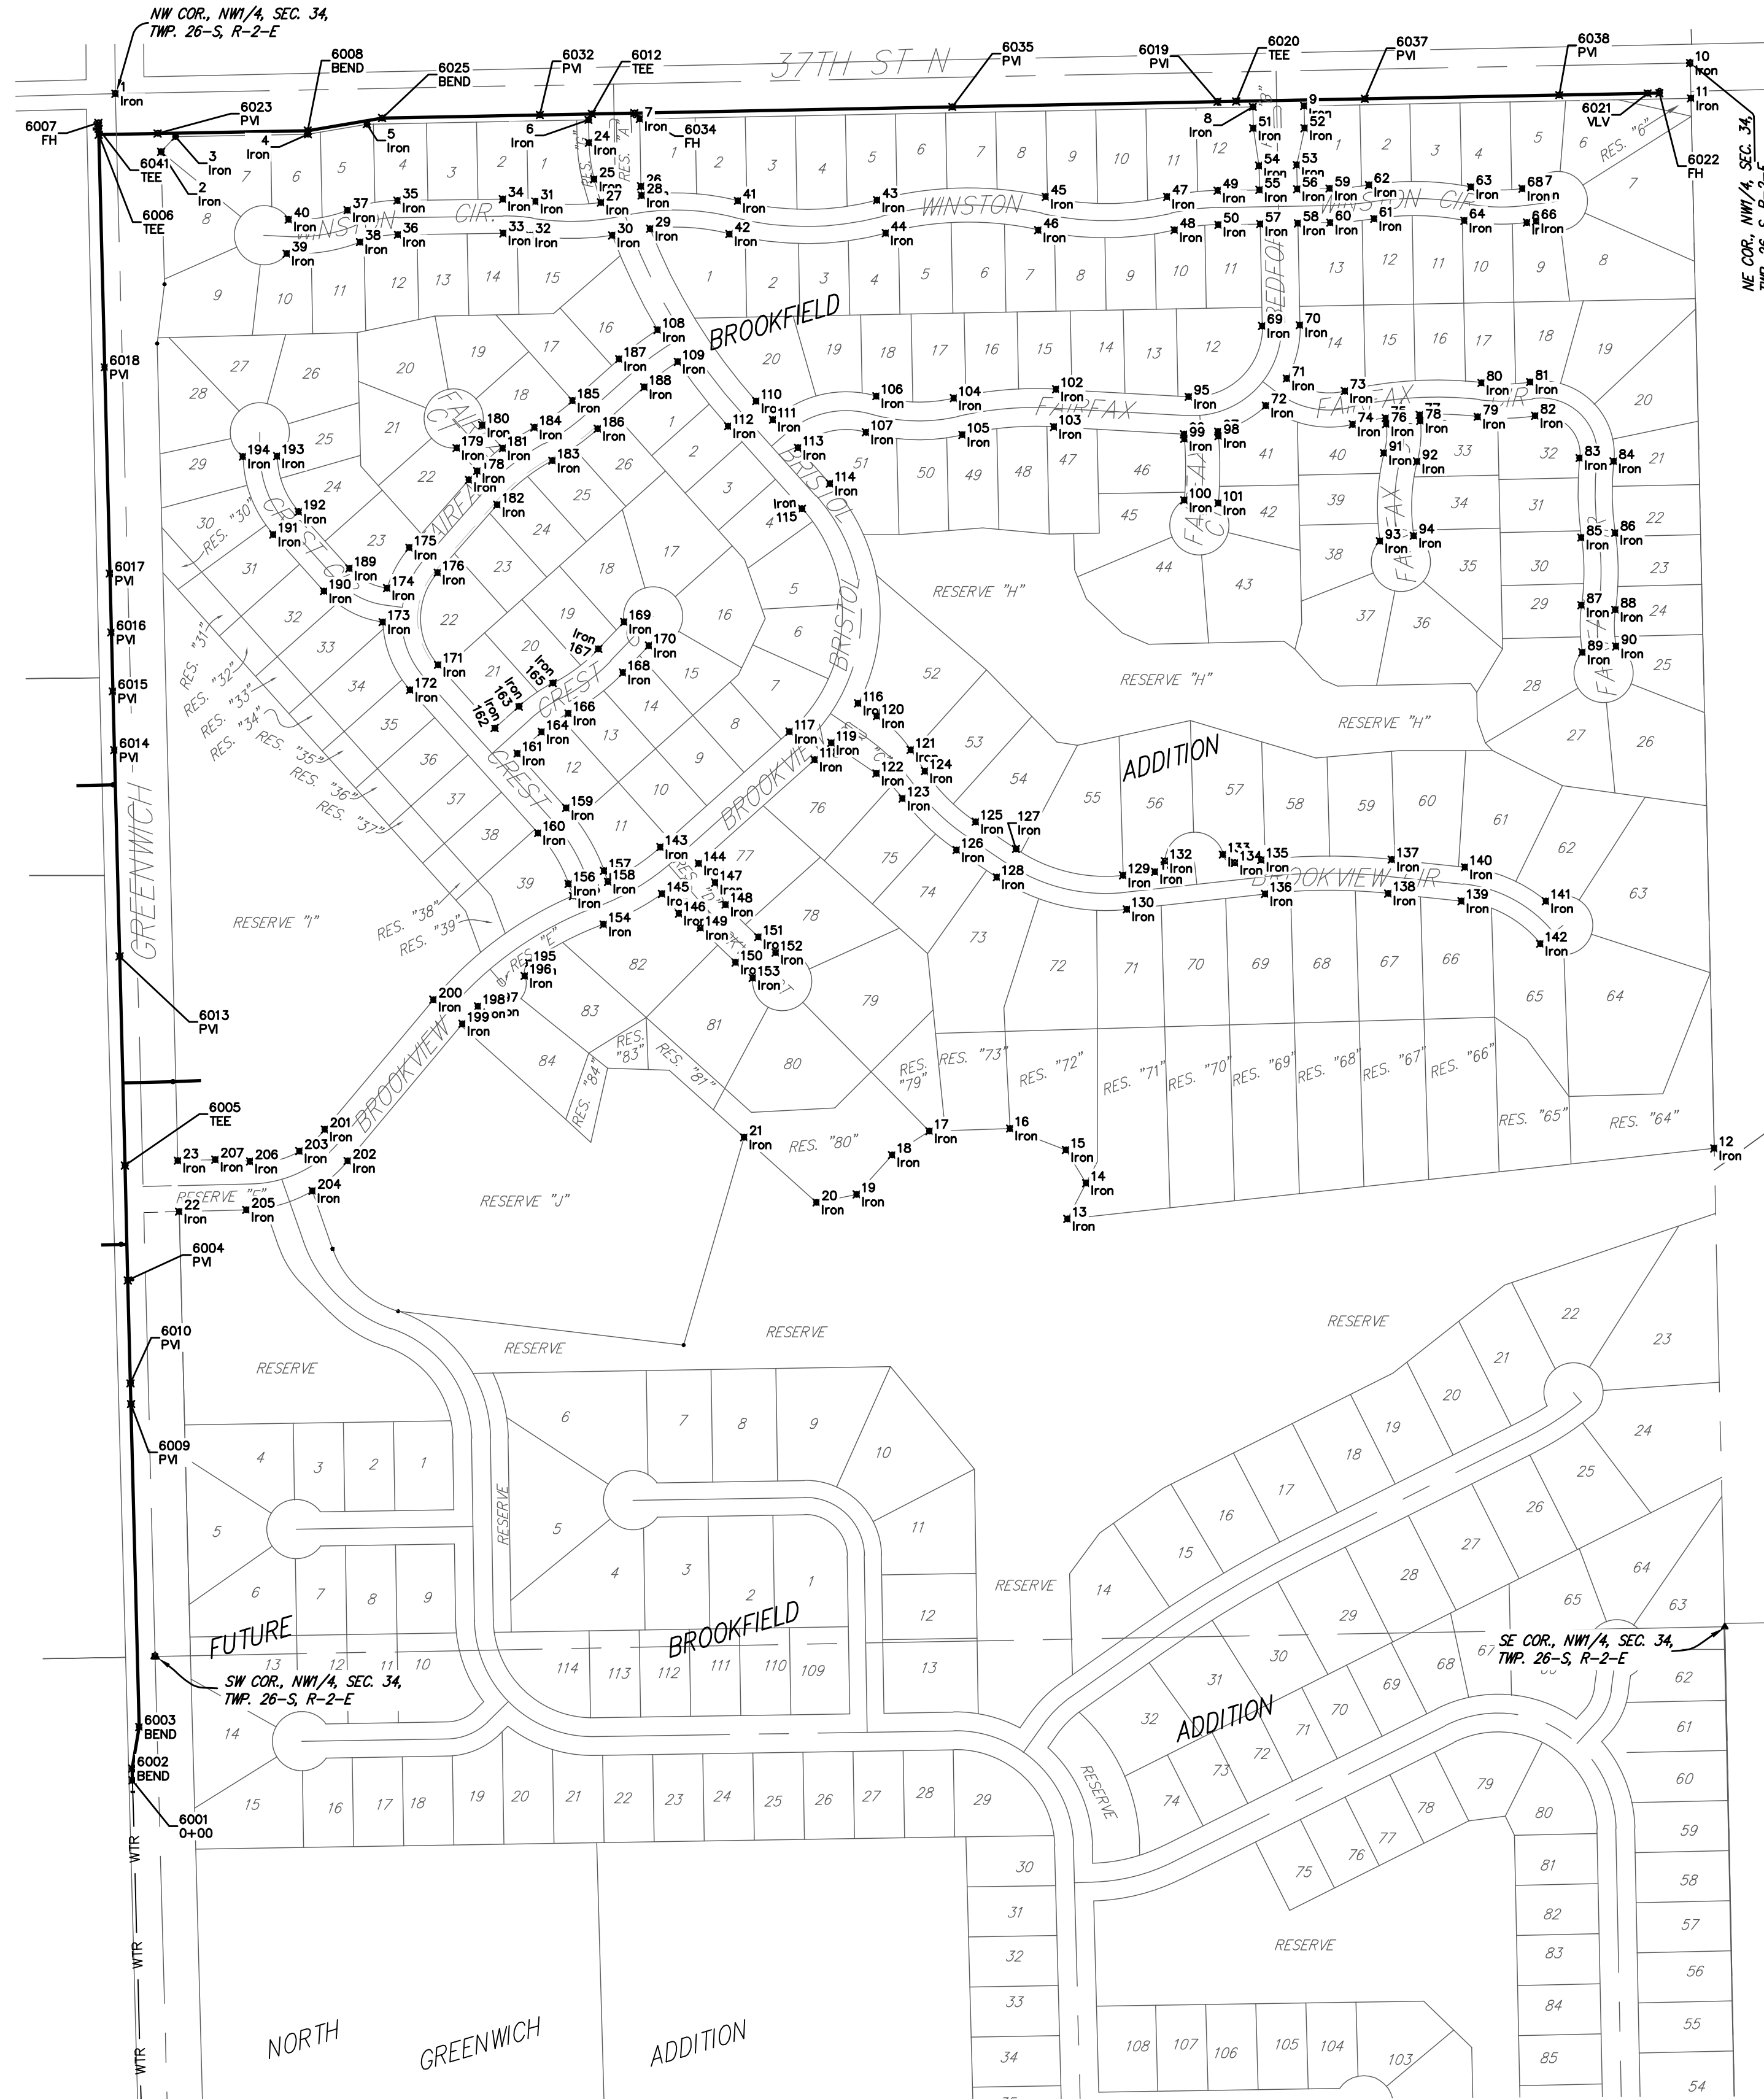

WTR POINTS			
Point #	Northing	Easting	Description
6001	1707361.72	1685848.64	0+00
6002	1707391.71	1685848.10	BEND
6003	1707452.45	1685860.19	BEND
6004	1708210.43	1685840.75	PM
6005	1708405.33	1685835.80	TEE
6006	1710154.82	1685791.43	TEE
6007	1710174.81	1685790.92	FH
6008	1710161.72	1686145.95	BEND
6009	1708000.50	1685846.13	PM
6010	1708035.49	1685845.23	PM
6011	1710190.11	1686228.14	TEE
6012	1708760.26	1685826.80	PM
6013	1709110.15	1685815.39	PM
6014	1709210.11	1685812.86	PM
6015	1709210.08	1685812.86	PM
6016	1709410.05	1685810.32	PM
6017	1709759.94	1685801.45	PM
6018	1709210.08	1685812.86	PM
6019	1710217.98	1685799.56	PM
6020	1710211.40	1687721.44	TEE
6021	1710224.99	1688119.42	VLV
6022	1710225.38	1688439.41	FH
6023	1710156.77	1685891.41	PM
6024	1710183.18	1686272.22	BEND
6025	1710188.39	1686539.77	PM
6026	1710224.99	1688119.42	VLV
6027	1710225.38	1688439.41	FH
6028	1710191.52	1686700.22	FH
6029	1710202.02	1687339.64	PM
6030	1710215.65	1687939.51	PM
6031	1710222.07	1688269.45	PM
6032	1710164.82	1685791.18	TEE

CONTROL POINTS				CONTROL POINTS				CONTROL POINTS			
Point #	Northing	Easting	Description	Point #	Northing	Easting	Description	Point #	Northing	Easting	Description
1	1710224.38	1688191.67	Iron	75	1709673.70	1687974.93	Iron	149	1708808.60	1688812.40	Iron
2	1710125.87	1685897.20	Iron	76	1709663.74	1687975.87	Iron	150	1708749.89	16886871.88	Iron
3	1710151.35	1685921.56	Iron	77	1709679.12	1688032.68	Iron	151	1708793.01	16886910.66	Iron
4	1710155.73	1686146.52	Iron	78	1709669.17	1688033.61	Iron	152	1708766.75	16886939.86	Iron
5	1710172.68	1686246.20	Iron	79	1709675.94	1688131.06	Iron	153	1708723.63	16886901.07	Iron
6	1710180.00	1686222.34	Iron	80	1709733.58	1688137.52	Iron	154	1708814.43	1688648.00	Iron
7	1710181.69	1686709.32	Iron	81	1709735.01	1688220.16	Iron	155	1708862.69	1688596.15	Iron
8	1710201.95	1687749.63	Iron	82	1709777.63	1688228.63	Iron	156	1708883.33	1688588.56	Iron
9	1710203.64	1687836.61	Iron	83	1709806.06	1688303.96	Iron	157	1708905.42	1688648.63	Iron
10	1710276.41	1688491.69	Iron	84	1709800.55	1688361.70	Iron	158	1708886.85	1688655.46	Iron
11	1710216.42	1688493.01	Iron	85	1709471.00	1688306.89	Iron	159	1709012.21	1688594.45	Iron
12	1708434.40	1688532.32	Iron	86	1709479.01	1688364.33	Iron	160	1708969.53	1688536.76	Iron
13	1708314.79	1687434.98	Iron	87	1709356.24	1688307.11	Iron	161	1709104.48	1688501.89	Iron
14	1708375.36	1687466.71	Iron	88	1709348.44	1688364.58	Iron	162	1709147.71	1688463.21	Iron
15	1708210.08	1685812.86	PM	89	1709276.17	1688308.79	Iron	163	1709184.38	1688504.20	Iron
16	1708468.12	1687337.71	Iron	90	1709286.37	1688365.88	Iron	164	1709141.16	1688542.87	Iron
17	1708463.53	1687200.91	Iron	91	1709614.43	1687972.08	Iron	165	1709224.06	1688561.64	Iron
18	1708423.09	1687137.52	Iron	92	1709600.28	1688028.33	Iron	166	1709172.58	1688588.37	Iron
19	1708356.21	1687077.37	Iron	93	1709465.01	1687965.29	Iron	167	1709282.02	1688639.00	Iron
20	1708342.53	1687009.18	Iron	94	1709474.02	1688022.59	Iron	168	1709241.91	1688680.89	Iron
21	1708452.99	1686886.36	Iron	95	1709710.07	1687640.79	Iron	169	1709327.86	1688682.89	Iron
22	1708327.13	1685927.82	Iron	96	1709646.42	1687632.83	Iron	170	1709287.74	1688724.78	Iron
23	1708413.61	1685925.62	Iron	97	1709651.10	1687690.64	Iron	171	1709255.02	1688371.19	Iron
24	1710141.15	1686223.10	Iron	98	1709643.31	1687691.26	Iron	172	1709212.35	1688319.50	Iron
25	1710079.18	1686631.93	Iron	99	1709638.68	1687633.45	Iron	173	1709327.60	1688273.23	Iron
26	1710067.22	1686711.55	Iron	100	1709534.39	1687633.28	Iron	174	1709385.13	1688280.55	Iron
27	1710039.71	1686643.43	Iron	101	1709529.57	1687691.08	Iron	175	1709453.79	1688318.37	Iron
28	1710051.74	1686712.48	Iron	102	1709722.68	1687415.67	Iron	176	1709411.56	1688366.46	Iron
29	1709995.10	1686726.94	Iron	103	1709658.78	1687412.09	Iron	177	1709568.84	1688419.39	Iron
30	1709983.85	1686662.70	Iron	104	1709707.66	1687424.19	Iron	178	1709584.09	1688433.49	Iron
31	1710041.37	1686532.22	Iron	105	1709645.33	1687256.69	Iron	179	1709623.06	1688398.77	Iron
32	1709984.06	1686523.25	Iron	106	1709711.10	1687110.71	Iron	180	1709661.65	1688442.08	Iron
33	1709987.30	1686477.84	Iron	107	1709649.60	1687092.97	Iron	181	1709622.68	1688478.80	Iron
34	1710045.30	1686477.10	Iron	108	1709823.40	1686739.62	Iron	182	1709526.61	1688467.49	Iron
35	1710043.00	1686298.19	Iron	109	1709769.33	1686773.86	Iron	183	1709601.55	1688561.24	Iron
36	1709985.01	1686298.94	Iron	110	1709702.65	1686906.88	Iron	184	1709657.77	1688530.65	Iron
37	1710026.60	1686213.67	Iron	111	1709671.01	1686935.20	Iron	185	1709703.41	1688595.38	Iron
38	1709972.54	1686234.68	Iron	112	1709659.98	1686859.19	Iron	186	1709655.72	1688638.06	Iron
39	1709952.90	1686110.33	Iron	113	1709623.32	1686977.87	Iron	187	1709774.09	1688674.37	Iron
40	1710010.80	1686113.64	Iron	114	1709562.78	1687032.06	Iron	188	1709726.39	1688717.05	Iron
41	1710042.43	1686875.70	Iron	115	1709520.08	1686984.36	Iron	189	1709418.63	1688216.77	Iron
42	1709986.21	1686861.45	Iron	116	1709189.64	1687079.94	Iron	190	1709379.96	1688173.55	Iron
43	1710043.68	1687111.90	Iron	117	1709141.65	1686963.34	Iron	191	1709476.23	1688087.41	Iron
44	1709987.61	1687126.74	Iron	118	1709093.96	1687006.02	Iron	192	1709514.91	1688130.63	Iron
45	1710049.25	1687398.10	Iron	119	1709122.65	1687034.40	Iron	193	1709609.21	1688093.87	Iron
46	1709992.64	1687385.46	Iron	120	1709168.02	1687111.74	Iron	194	1709608.44	1688035.88	Iron
47	1710049.39	1687604.10	Iron	121	1709110.68	1687168.96	Iron	195	1708748.79	1688521.37	Iron
48	1709992.80	1687616.82	Iron	122	1709070.69	1687110.84	Iron	196	1708727.05	1688514.17	Iron
49	1710059.76	1687689.85	Iron	123	1709028.22	1687155.19	Iron	197	1708678.90	1688457.50	Iron
50	1710001.77	1687690.98	Iron	124	1709074.77	1687193.25	Iron	198	1708675.31	1688434.89	Iron
51	1710165.70	1687750.33	Iron	125	1708988.72	1687279.34	Iron	199	1708645.70	1688408.32	Iron
52	1710165.79	1687737.35	Iron	126	1708940.67	1687246.85	Iron	200	1708686.76	1688359.22	Iron
53	1710103.39	1687824.06	Iron	127	1708942.55	1687347.63	Iron	201	1708466.44	1688174.99	Iron
54	1710102.13	1687760.07	Iron	128	1708894.50	1687315.14	Iron	202	1708413.12	1688213.83	Iron
55	1710061.14	1687760.87	Iron	129	1708897.73	1687529.40	Iron	203	1708429.72	1688131.81	Iron
56	1710062.38	1687824.86	Iron	130	1708840.08	1687535.82	Iron	204	1708362.21	1688153.87	Iron
57	1710003.15	1687762.00	Iron	131	1708803.76	1687583.57	Iron	205	1708330.02	1688041.74	Iron
58	1710004.40	1687825.99	Iron	132	1708822.02	1687600.46	Iron	206	1708412.28	1688048.00	Iron
59	1710063.46	1687879.85	Iron	133	1708932.97	1687698.82	Iron	207	1708415.22	1688089.19	Iron
60	1710005.47	1687880.98	Iron	134	1708918.87	1687719.31	Iron				
61	1710011.94	1687955.56	Iron	135	1708923.84	1687763.90	Iron				
62	1710069.26	1687946.68	Iron	136	1708866.20	1687770.32	Iron				
63	1710065.77	1688119.66	Iron	137	1708924.52	1687985.37	Iron				
64	1710008.86	1688108.48	Iron	138	1708866.84	1687979.31	Iron				
65	1710005.68	1688214.63	Iron	139	1708853.79	1688103.46	Iron				
66	1710007.80	1688230.32	Iron	140	1708911.47	1688109.52	Iron				
67	1710065.27	1688222.56	Iron	141	1708853.87	1688246.77	Iron				
68	1710063.16	1688206.87	Iron	142	1708781.60	1688237.28	Iron				
69	1709830.18	1687765.37	Iron	143	1708945.64	1686744.27	Iron				
70	1709831.43	1687829.35	Iron	144	1708918.08	1686809.45	Iron				
71	1709740.93	1687807.27	Iron	145	1708866.33	1686747.13	Iron				
72	1709695.04	1687771.79	Iron	146	1708832.81	1686775.72	Iron				
73	1709719.62	1687905.73	Iron	147	1708885.36	1686837.35	Iron				
74	1709663.17	1687919.07	Iron	148	1708847.94	1686855.01	Iron				

