


BENCHMARKS:
 RR spike in asphalt, SW COR., N1/2,
 SW1/4, Sec. 34, TWP. 26-S, R-2-E.
 Elev. = 1400.59 NAVD88

RR spike in E. face of power pole,
 174± N. of S. line, N1/2, SW1/4 &
 49± E. of W. line, SW1/4,
 Sec. 34, TWP. 26-S, R-2-E.
 Elev. = 1398.64 NAVD88

RR spike in S. face of power pole,
 294± S. of N. line, SW1/4, &
 48± E. of W. line, SW1/4,
 Sec. 34, TWP. 26-S, R-2-E.
 Elev. = 1386.14 NAVD88

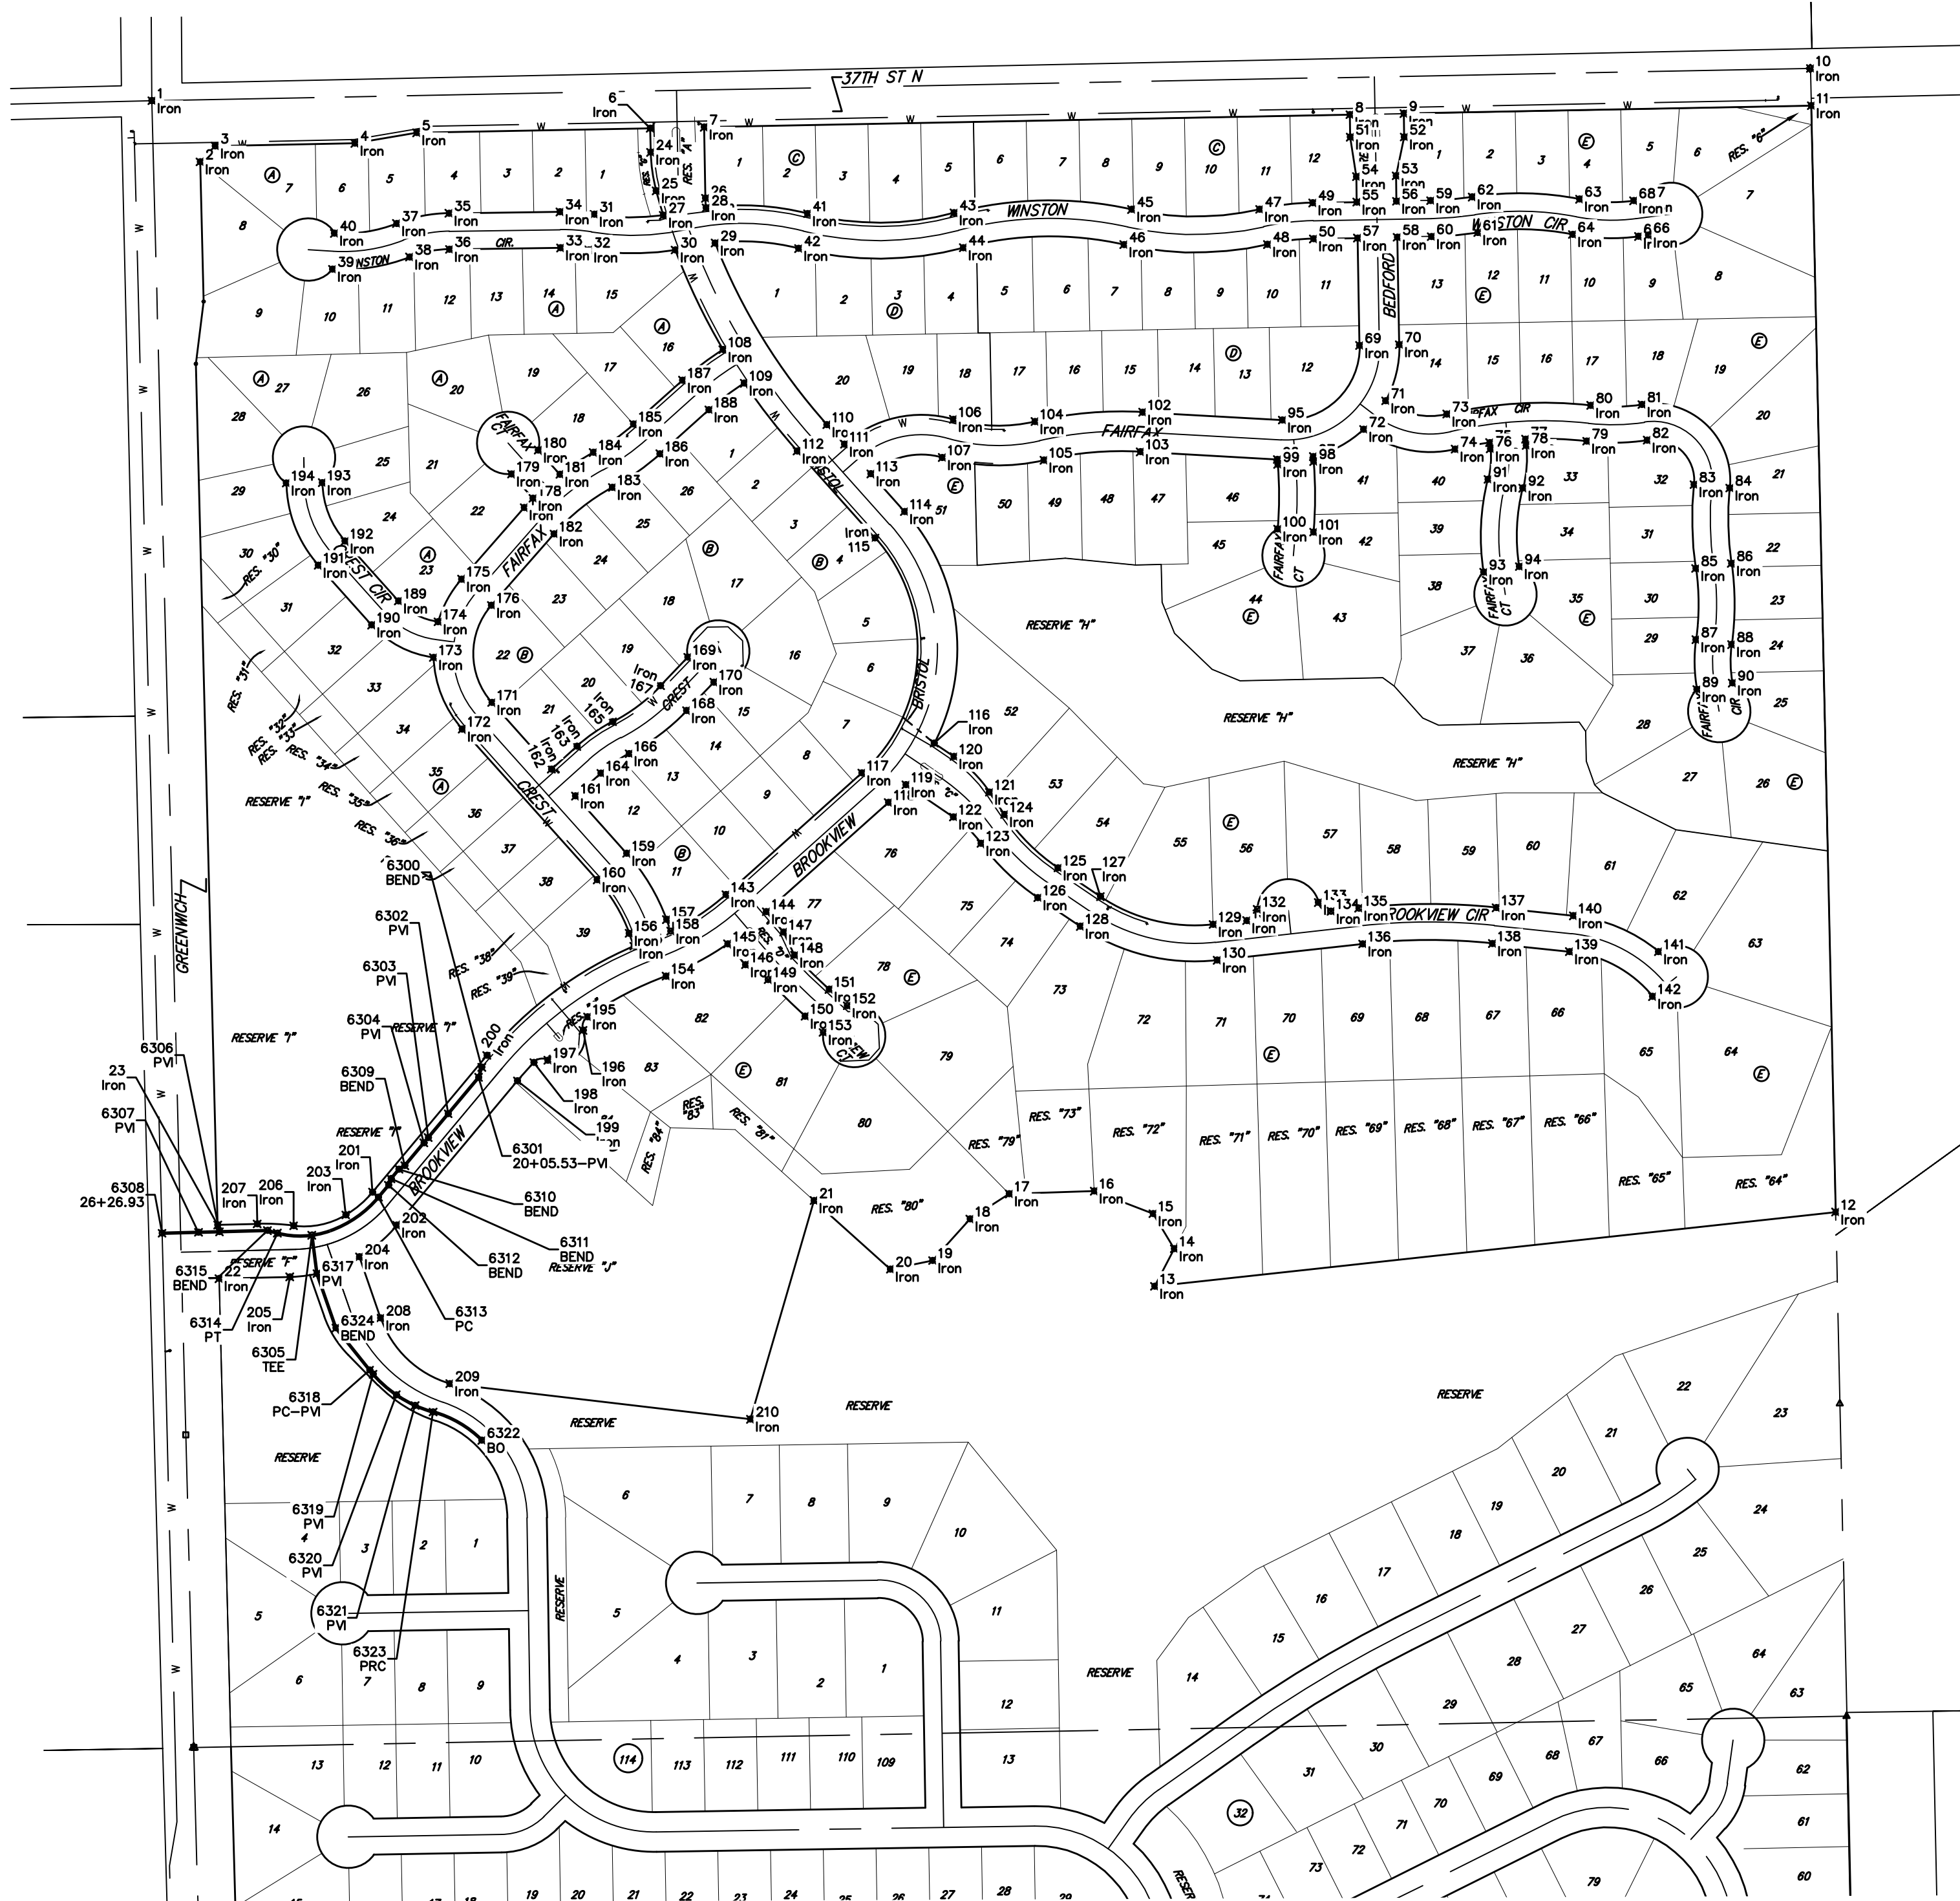

WTR POINTS			CONTROL POINTS			CONTROL POINTS			CONTROL POINTS						
Point #	Northing	Easting	Description	Point #	Northing	Easting	Description	Point #	Northing	Easting	Description	Point #	Northing	Easting	Description
6300	1,708,667.57	1,686,350.99	BEND	1	1,710,224.38	1,685,819.67	Iron	75	1,709,673.70	1,687,974.93	Iron	149	1,708,808.60	1,686,812.40	Iron
6301	1,708,651.36	1,686,345.91	20+05.53-PW	2	1,710,125.87	1,685,897.20	Iron	76	1,709,663.74	1,687,975.87	Iron	150	1,708,749.89	1,686,871.88	Iron
6302	1,708,592.70	1,686,296.86	PW	3	1,710,151.35	1,685,921.56	Iron	77	1,709,679.12	1,688,032.68	Iron	151	1,708,793.01	1,686,910.66	Iron
6303	1,708,554.34	1,686,264.79	PW	4	1,710,155.73	1,686,146.52	Iron	78	1,709,669.17	1,688,033.61	Iron	152	1,708,766.75	1,686,939.86	Iron
6304	1,708,545.90	1,686,257.73	PW	5	1,710,172.68	1,686,246.20	Iron	79	1,709,675.94	1,688,131.06	Iron	153	1,708,723.63	1,686,901.07	Iron
6305	1,708,397.05	1,686,077.20	TEE	6	1,710,180.00	1,686,622.34	Iron	80	1,709,733.59	1,688,137.52	Iron	154	1,708,814.43	1,686,648.00	Iron
6306	1,708,402.67	1,685,928.40	PW	7	1,710,181.69	1,686,709.32	Iron	81	1,709,735.01	1,688,220.16	Iron	155	1,708,862.69	1,686,596.15	Iron
6307	1,708,401.82	1,685,894.59	PW	8	1,710,201.95	1,687,749.63	Iron	82	1,709,676.06	1,688,228.63	Iron	156	1,708,883.33	1,686,588.56	Iron
6308	1,708,400.33	1,685,835.93	26+26.93	9	1,710,203.64	1,687,836.61	Iron	83	1,709,606.06	1,688,303.96	Iron	157	1,708,905.42	1,686,648.63	Iron
6309	1,708,508.14	1,686,226.98	BEND	10	1,710,276.41	1,688,491.69	Iron	84	1,708,600.55	1,688,361.70	Iron	158	1,708,886.85	1,686,655.46	Iron
6310	1,708,503.38	1,686,217.61	BEND	11	1,710,216.42	1,688,493.01	Iron	85	1,709,471.00	1,688,306.89	Iron	159	1,709,012.21	1,686,584.45	Iron
6311	1,708,488.04	1,686,204.78	BEND	12	1,708,434.40	1,688,532.32	Iron	86	1,709,479.01	1,688,364.33	Iron	160	1,708,969.53	1,686,536.76	Iron
6312	1,708,477.80	1,686,200.78	BEND	13	1,708,314.79	1,687,434.98	Iron	87	1,709,356.24	1,688,307.11	Iron	161	1,709,104.48	1,686,501.89	Iron
6313	1,708,458.42	1,686,184.58	PC	14	1,708,375.36	1,687,466.71	Iron	88	1,709,348.44	1,688,364.58	Iron	162	1,709,147.71	1,686,463.21	Iron
6314	1,708,400.46	1,686,021.68	PT	15	1,708,431.69	1,687,432.50	Iron	89	1,709,276.17	1,688,308.79	Iron	163	1,709,184.38	1,686,504.20	Iron
6315	1,708,404.63	1,686,005.69	BEND	16	1,708,468.12	1,687,337.71	Iron	90	1,709,286.37	1,688,365.88	Iron	164	1,709,141.16	1,686,542.87	Iron
6317	1,708,335.30	1,686,025.41	PW	17	1,708,463.53	1,687,200.91	Iron	91	1,709,614.43	1,687,972.08	Iron	165	1,709,224.06	1,686,561.64	Iron
6318	1,708,179.73	1,686,170.46	PC-PW	18	1,708,423.09	1,687,137.52	Iron	92	1,709,600.26	1,688,028.33	Iron	166	1,709,172.58	1,686,588.37	Iron
6319	1,708,173.24	1,686,175.91	PW	19	1,708,356.21	1,687,077.37	Iron	93	1,709,465.01	1,687,965.29	Iron	167	1,709,282.02	1,686,639.00	Iron
6320	1,708,140.08	1,686,213.16	PW	20	1,708,342.53	1,687,009.18	Iron	94	1,709,474.02	1,688,022.59	Iron	168	1,709,241.91	1,686,680.89	Iron
6321	1,708,122.88	1,686,233.59	PW	21	1,708,452.99	1,686,886.36	Iron	95	1,709,710.07	1,687,640.79	Iron	169	1,709,327.86	1,686,628.89	Iron
6322	1,708,066.64	1,686,351.09	BO	22	1,708,327.13	1,685,927.82	Iron	96	1,709,646.42	1,687,632.83	Iron	170	1,709,287.74	1,686,724.78	Iron
6323	1,708,112.29	1,686,272.61	PRC	23	1,708,413.61	1,685,925.62	Iron	97	1,709,651.10	1,687,690.64	Iron	171	1,709,255.02	1,686,367.19	Iron
6324	1,708,247.66	1,686,115.95	BEND	24	1,710,141.15	1,686,623.10	Iron	98	1,709,643.31	1,687,691.26	Iron	172	1,709,212.35	1,686,319.50	Iron
				25	1,710,079.18	1,686,631.93	Iron	99	1,709,638.68	1,687,633.45	Iron	173	1,709,327.60	1,686,273.23	Iron
				26	1,710,067.22	1,686,711.55	Iron	100	1,709,534.39	1,687,633.28	Iron	174	1,709,385.13	1,686,280.55	Iron
				27	1,710,039.71	1,686,643.43	Iron	101	1,709,529.57	1,687,691.08	Iron	175	1,709,453.79	1,686,318.37	Iron
				28	1,710,051.74	1,686,712.48	Iron	102	1,709,722.68	1,687,415.67	Iron	176	1,709,411.56	1,686,366.46	Iron
				29	1,709,995.10	1,686,726.94	Iron	103	1,709,658.78	1,687,412.09	Iron	177	1,709,568.84	1,686,419.39	Iron
				30	1,709,983.85	1,686,662.70	Iron	104	1,709,707.66	1,687,242.19	Iron	178	1,709,584.09	1,686,433.49	Iron
				31	1,710,041.37	1,686,532.22	Iron	105	1,709,645.33	1,687,256.69	Iron	179	1,709,623.06	1,686,398.77	Iron
				32	1,709,984.06	1,686,523.25	Iron	106	1,709,711.10	1,687,110.71	Iron	180	1,709,661.65	1,686,442.08	Iron
				33	1,709,987.30	1,686,477.84	Iron	107	1,709,649.60	1,687,092.97	Iron	181	1,709,622.68	1,686,476.80	Iron
				34	1,710,045.30	1,686,477.10	Iron	108	1,709,823.40	1,686,739.62	Iron	182	1,709,526.61	1,686,467.49	Iron
				35	1,710,043.00	1,686,298.19	Iron	109	1,709,769.33	1,686,773.86	Iron	183	1,709,601.55	1,686,561.24	Iron
				36	1,709,985.01	1,686,298.94	Iron	110	1,709,702.65	1,686,906.88	Iron	184	1,709,657.77	1,686,530.65	Iron
				37	1,710,026.60	1,686,213.67	Iron	111	1,709,671.01	1,686,935.20	Iron	185	1,709,703.41	1,686,595.38	Iron
				38	1,709,972.54	1,686,234.68	Iron	112	1,709,659.98	1,686,859.19	Iron	186	1,709,655.72	1,686,638.06	Iron
				39	1,709,952.90	1,686,110.33	Iron	113	1,709,623.32	1,686,977.87	Iron	187	1,709,774.09	1,686,674.37	Iron
				40	1,710,010.80	1,686,113.64	Iron	114	1,709,562.76	1,687,032.06	Iron	188	1,709,726.39	1,686,717.05	Iron
				41	1,710,042.43	1,686,875.70	Iron	115	1,709,520.08	1,686,984.36	Iron	189	1,709,418.63	1,686,216.77	Iron
				42	1,709,986.21	1,686,861.45	Iron	116	1,709,189.64	1,687,079.94	Iron	190	1,709,379.96	1,686,173.55	Iron
				43	1,710,043.68	1,687,111.90	Iron	117	1,709,141.65	1,686,963.34	Iron	191	1,709,476.23	1,686,087.41	Iron
				44	1,709,987.61	1,687,126.74	Iron	118	1,709,093.96	1,687,006.02	Iron	192	1,709,514.91	1,686,130.63	Iron
				45	1,710,049.25	1,687,398.10	Iron	119	1,709,122.65	1,687,034.40	Iron	193	1,709,608.21	1,686,083.87	Iron
				46	1,709,992.64	1,687,385.46	Iron	120	1,709,168.02	1,687,111.74	Iron	194	1,709,608.44	1,686,035.88	Iron
				47	1,710,049.39	1,687,604.10	Iron	121	1,709,110.68	1,687,168.96	Iron	195	1,708,748.79	1,686,521.37	Iron
				48	1,709,992.80	1,687,616.82	Iron	122	1,709,070.69	1,687,110.84	Iron	196	1,708,727.05	1,686,514.17	Iron
				49	1,710,059.76	1,687,689.85	Iron	123	1,709,028.22	1,687,155.19	Iron	197	1,708,678.90	1,686,457.50	Iron
				50	1,710,001.77	1,687,690.98	Iron	124	1,709,074.77	1,687,193.25	Iron	198	1,708,675.31	1,686,434.89	Iron
				51	1,710,165.70	1,687,750.33	Iron	125	1,708,988.72	1,687,279.34	Iron	199	1,708,645.70	1,686,408.32	Iron
				52	1,710,165.79	1,687,837.35	Iron	126	1,708,940.67	1,687,246.85	Iron	200	1,708,686.76	1,686,359.22	Iron
				53	1,710,103.38	1,687,824.06	Iron	127	1,708,942.55	1,687,347.63	Iron	201	1,708,466.44	1,686,174.99	Iron
				54	1,710,102.13	1,687,760.07	Iron	128	1,708,894.50	1,687,315.14	Iron	202	1,708,413.12	1,686,213.83	Iron
				55	1,710,061.14	1,687,760.87	Iron	129	1,708,897.73	1,687,529.40	Iron	203	1,708,429.72	1,686,131.81	Iron
				56	1,710,062.38	1,687,824.86	Iron	130	1,708,840.08	1,687,535.82	Iron	204	1,708,362.21	1,686,153.87	Iron
				57	1,710,003.15	1,687,762.00	Iron	131	1,708,903.76	1,687,583.57	Iron	205	1,708,330.02	1,686,041.74	Iron
				58	1,710,004.40	1,687,825.99	Iron	132	1,708,922.02	1,687,600.46	Iron	206	1,708,412.28	1,686,048.00	Iron
				59	1,710,063.46	1,687,879.85	Iron	133	1,708,932.97	1,687,698.82	Iron	207	1,708,415.22	1,685,989.19	Iron
				60	1,710,005.47	1,687,880.98	Iron	134	1,708,918.87	1,687,719.31	Iron	208	1,708,263.86	1,686,188.14	Iron
				61	1,710,011.94	1,687,955.56	Iron	135	1,708,923.84	1,687,763.90	Iron	209	1,708,157.98	1,686,299.37	Iron
				62	1,710,069.26	1,687,946.68	Iron	136	1,708,866.20	1,687,770.32	Iron	210	1,708,100.66	1,686,783.81	Iron
				63	1,710,065.77	1,688,119.66	Iron	137	1,708,924.52	1,687,985.37	Iron				
				64	1,710,008.86	1,688,108.48	Iron	138	1,708,866.84	1,687,979.31	Iron				
				65	1,710,005.68	1,688,214.63	Iron	139	1,708,853.79	1,688,103.46	Iron				
				66	1,710,007.80	1,688,230.32	Iron	140	1,708,911.47	1,688,109.52	Iron				
				67	1,710,065.27	1,688,222.56	Iron	141	1,708,853.87	1,688,246.77	Iron				
				68	1,710,063.16	1,688,206.87	Iron	142	1,708,791.60						