




**BENCHMARKS:**  
 CITY OF WICHITA BENCHMARK DISK  
 34.9' S. & 31.2' W. OF THE SW COR.,  
 NW1/4, SEC. 2, TWP. 27-S, R-1-W.  
 ELEV. = 1327.57 NAVD88

CITY OF WICHITA BENCHMARK DISK  
 26.2' S. & 46.1' W. OF THE NW COR.,  
 NW1/4, SEC. 2, TWP. 27-S, R-1-W.  
 ELEV. = 1330.50 NAVD88

CITY OF WICHITA BENCHMARK DISK  
 0.9' E. & 29' N. OF THE NE COR.,  
 NW1/4, SEC. 2, TWP. 27-S, R-1-W.  
 ELEV. = 1325.19 NAVD88

SANDCREST ADDITION

33

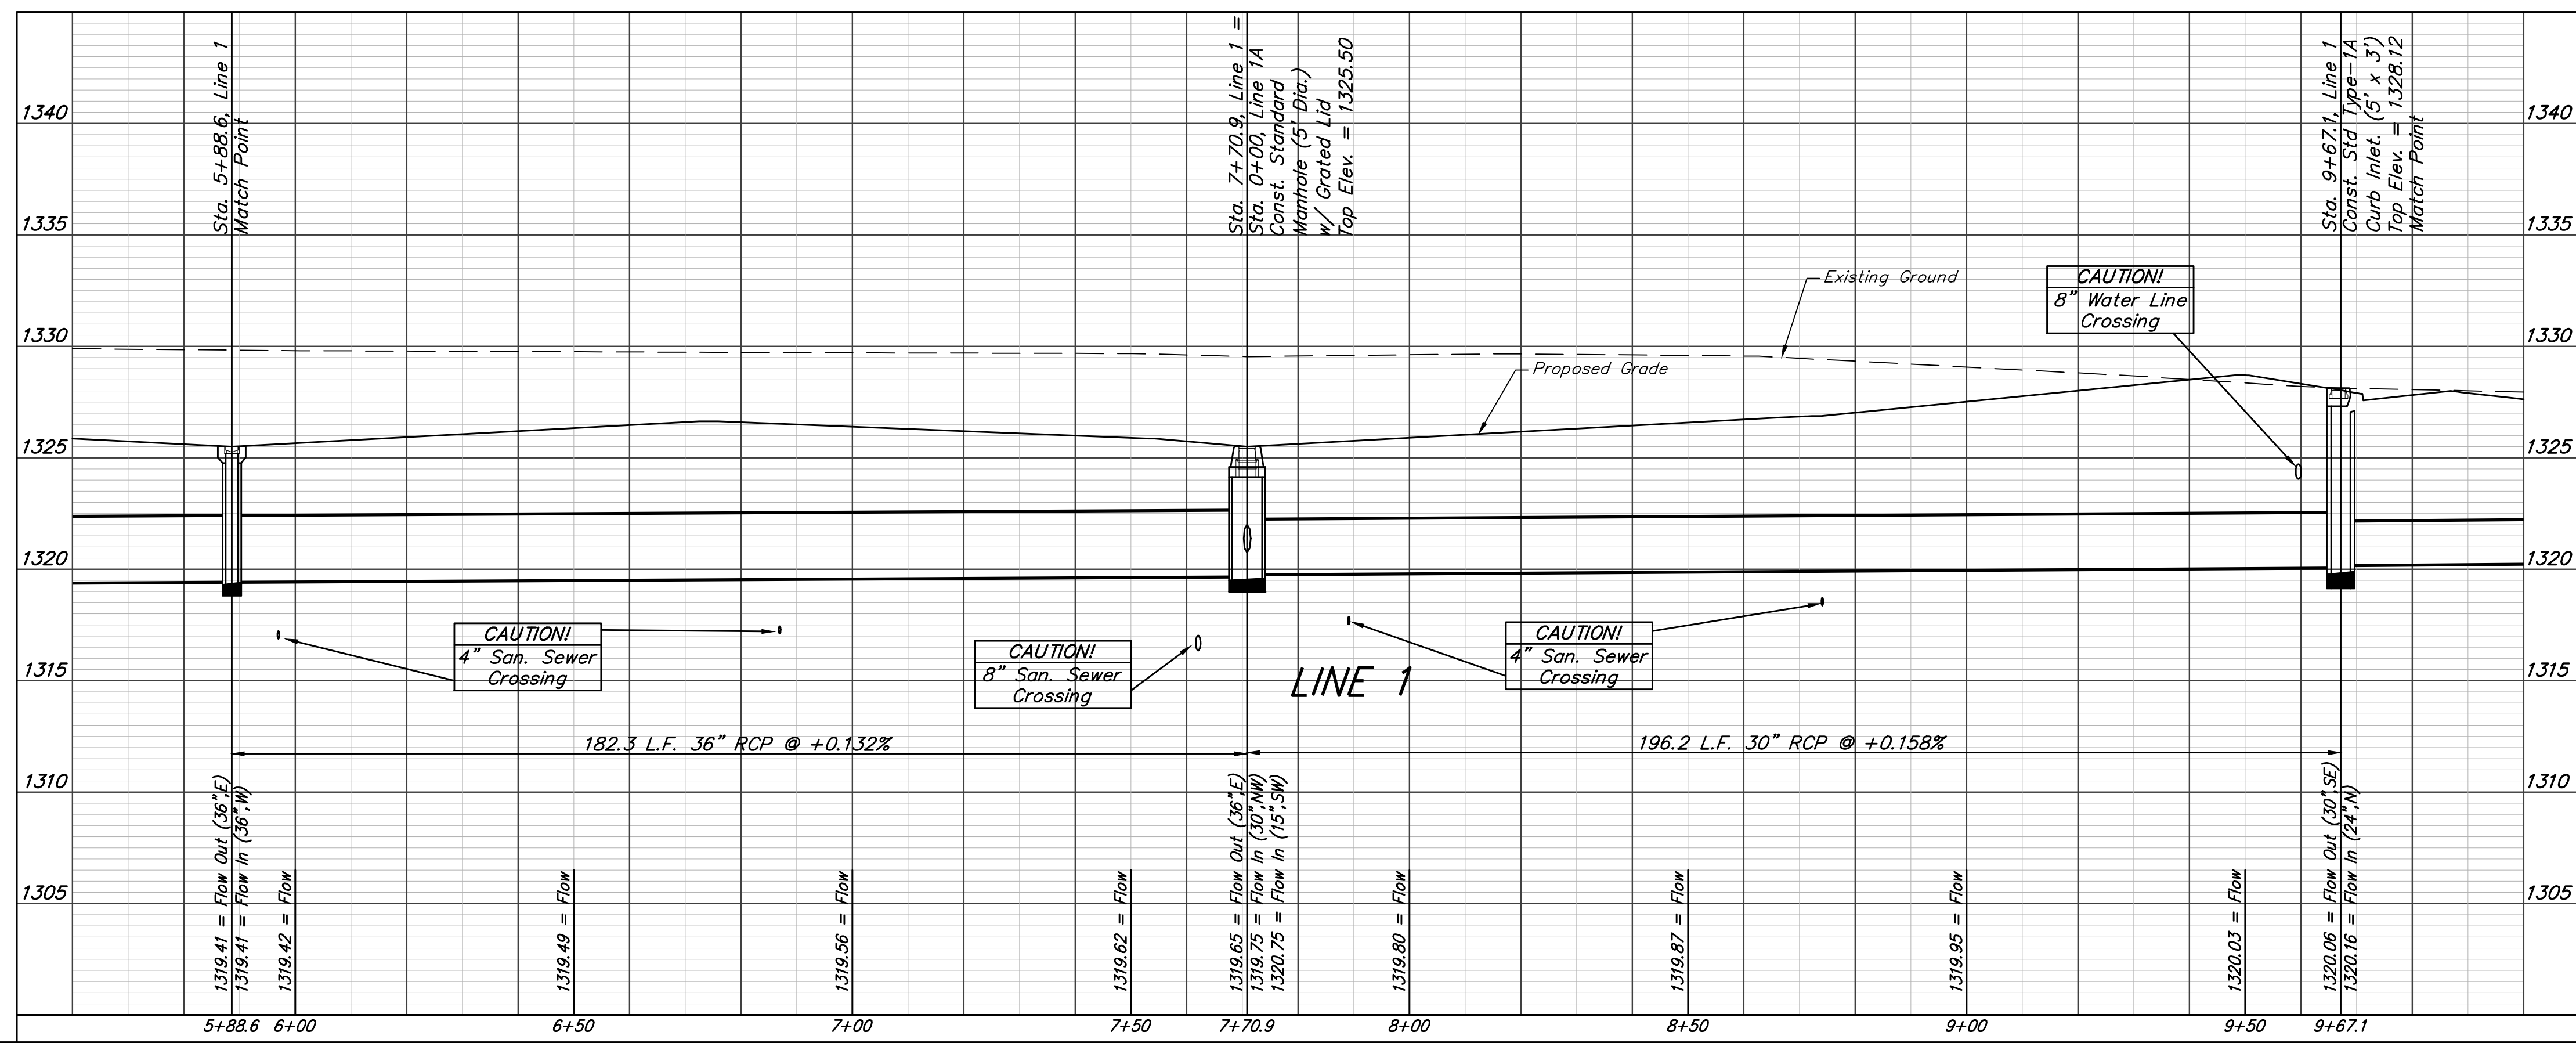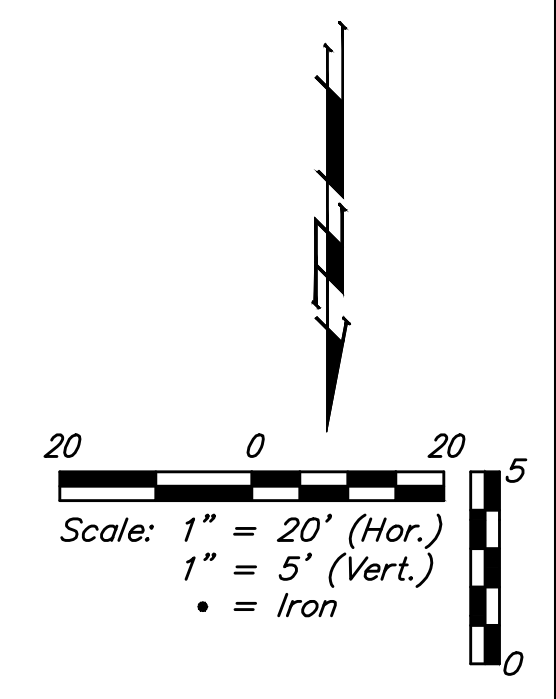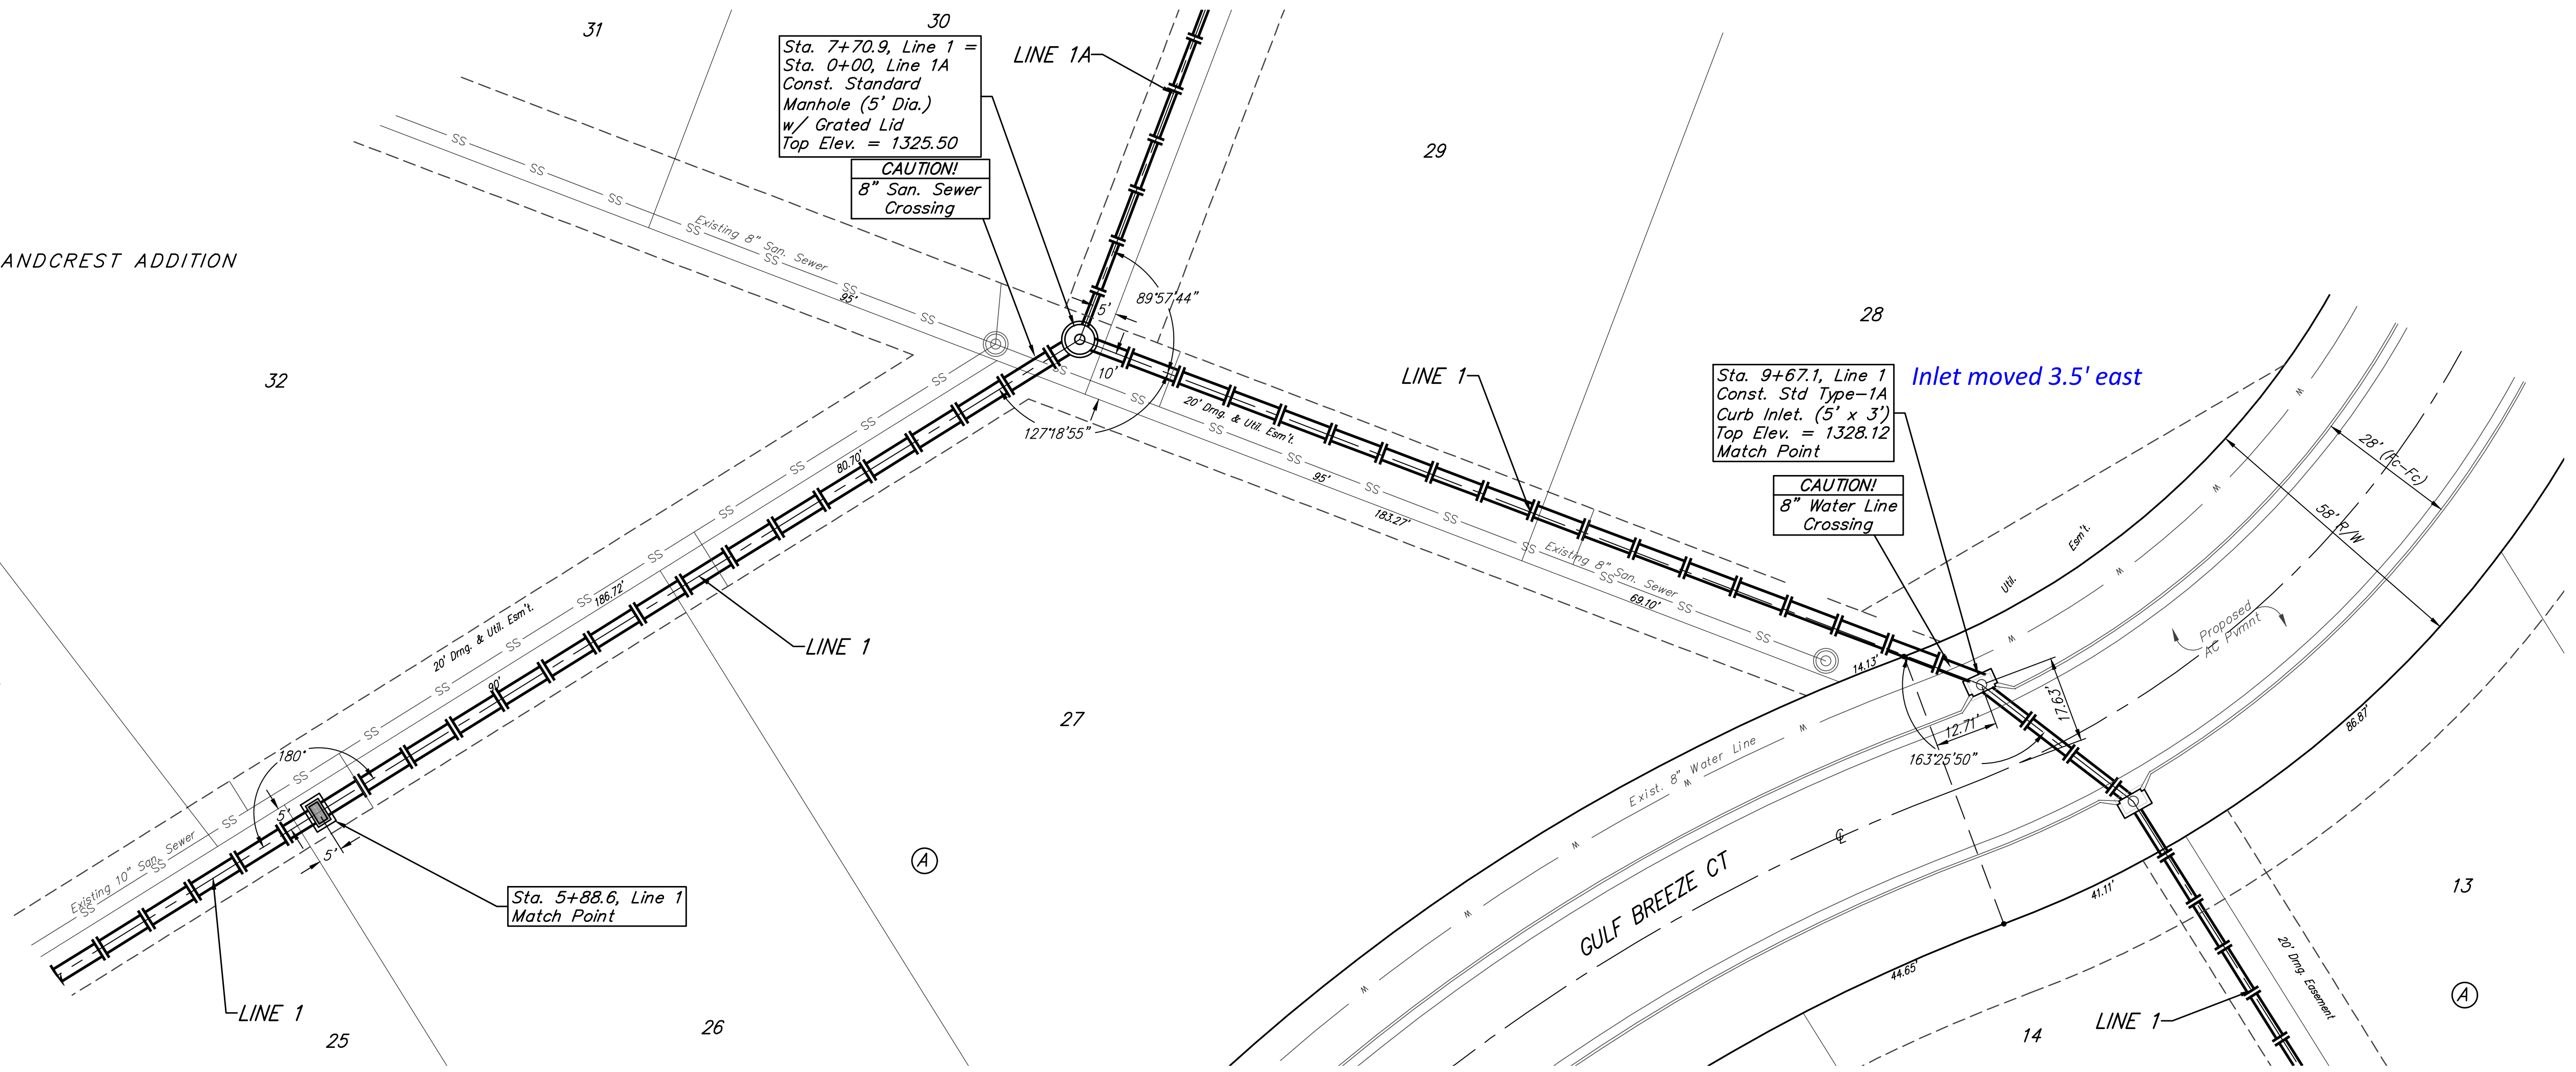

SANDCREST ADDITION



		Sandcrest Addition - Phase I	
		<b>LINE 1</b>	
Storm Water Sewer Improvements		<small>Baughman Company, P.A. 315 Ellis St. Wichita, KS 67211 P 316-262-7271 F 316-262-0149        ENGINEERING   SURVEYING   PLANNING   LANDSCAPE ARCHITECTURE</small>	
PROJECT NUMBER 472-85252	DESIGN AEG	DRAWN JAK	APPROVED DATE 7/19/16
REVISIONS:	SCALE Noted		
			SHEET <b>25 OF 66</b>

E:\Projects\Pearl Beach\_1202\F860\Engineering\Phase 1\Sr\_1510E118 SWS PLANS.dwg