
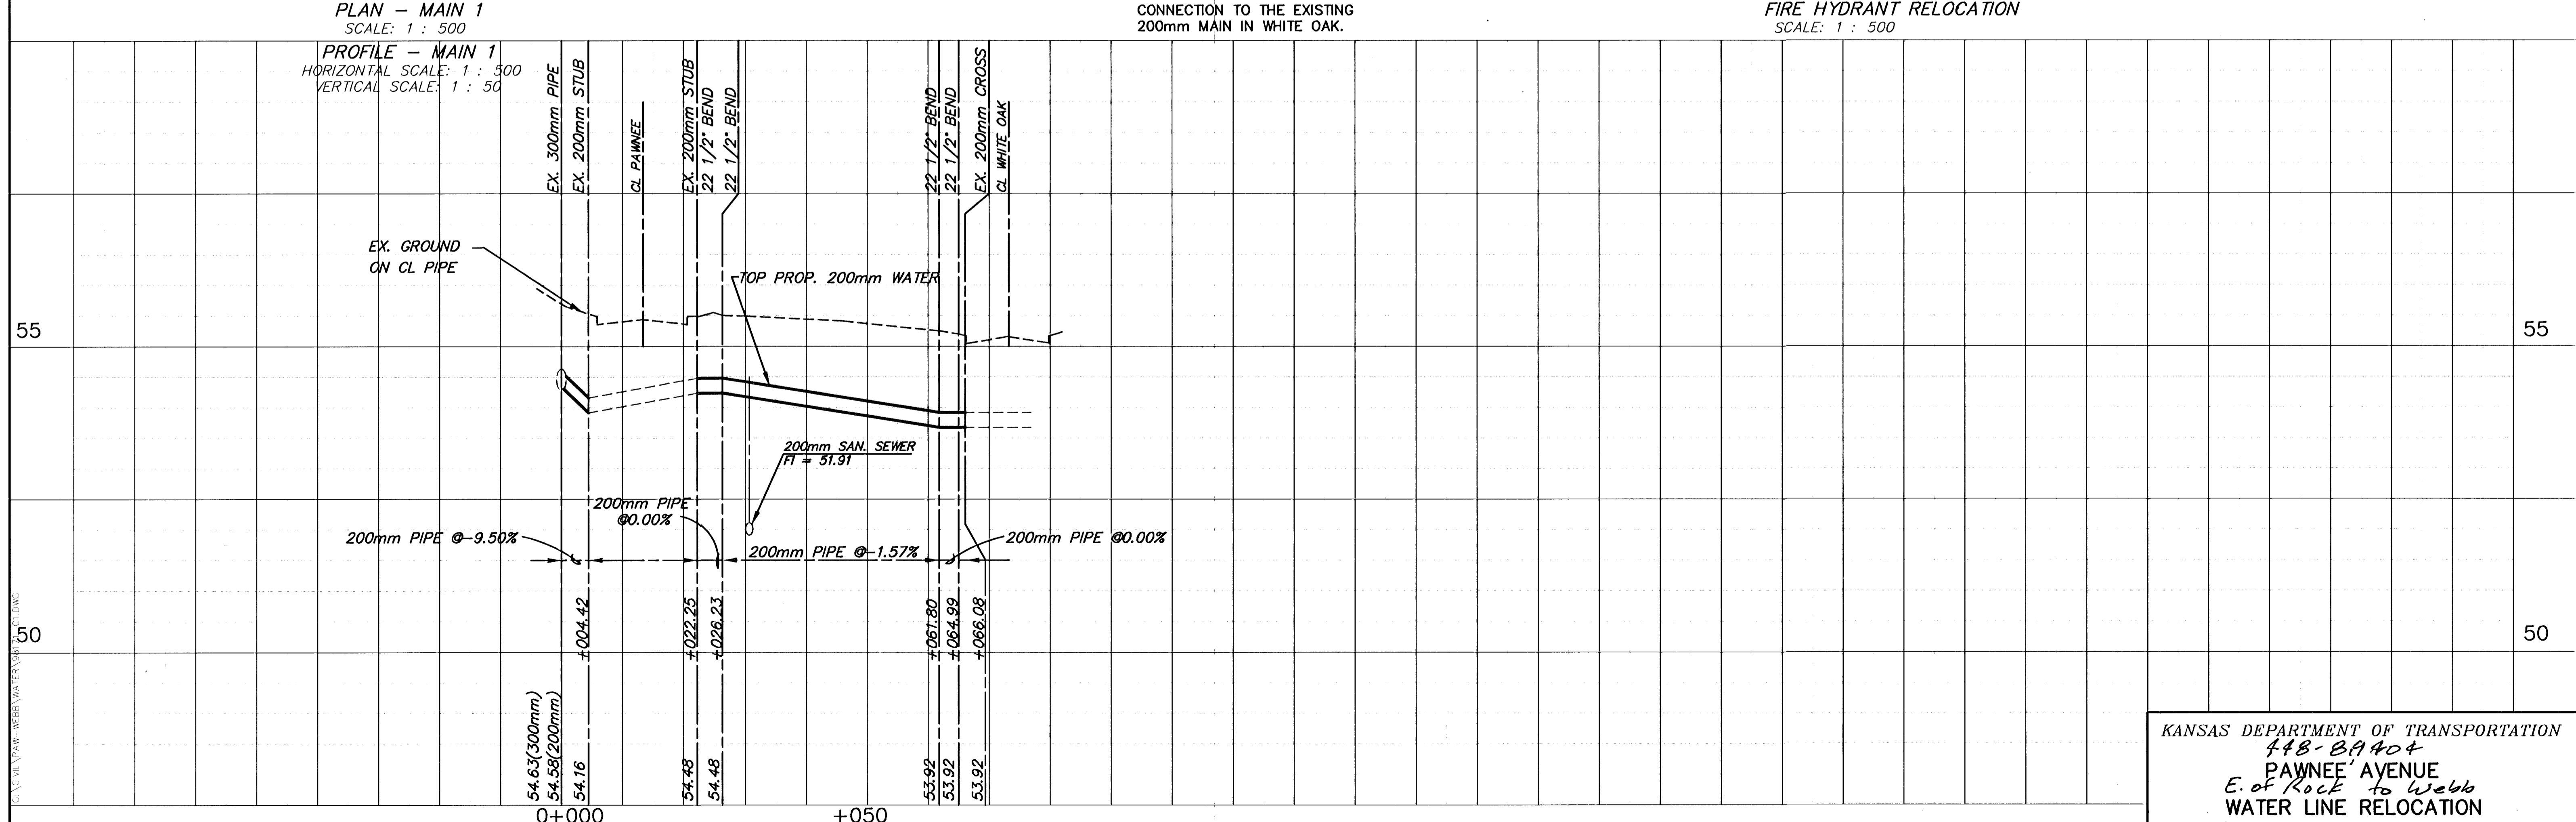


FHWA REG. NO.	STATE	PROJECT NO.	YEAR	SHEET NO.	TOTAL SHEETS
7	KANSAS	STP--N012(901)	1999	40	131

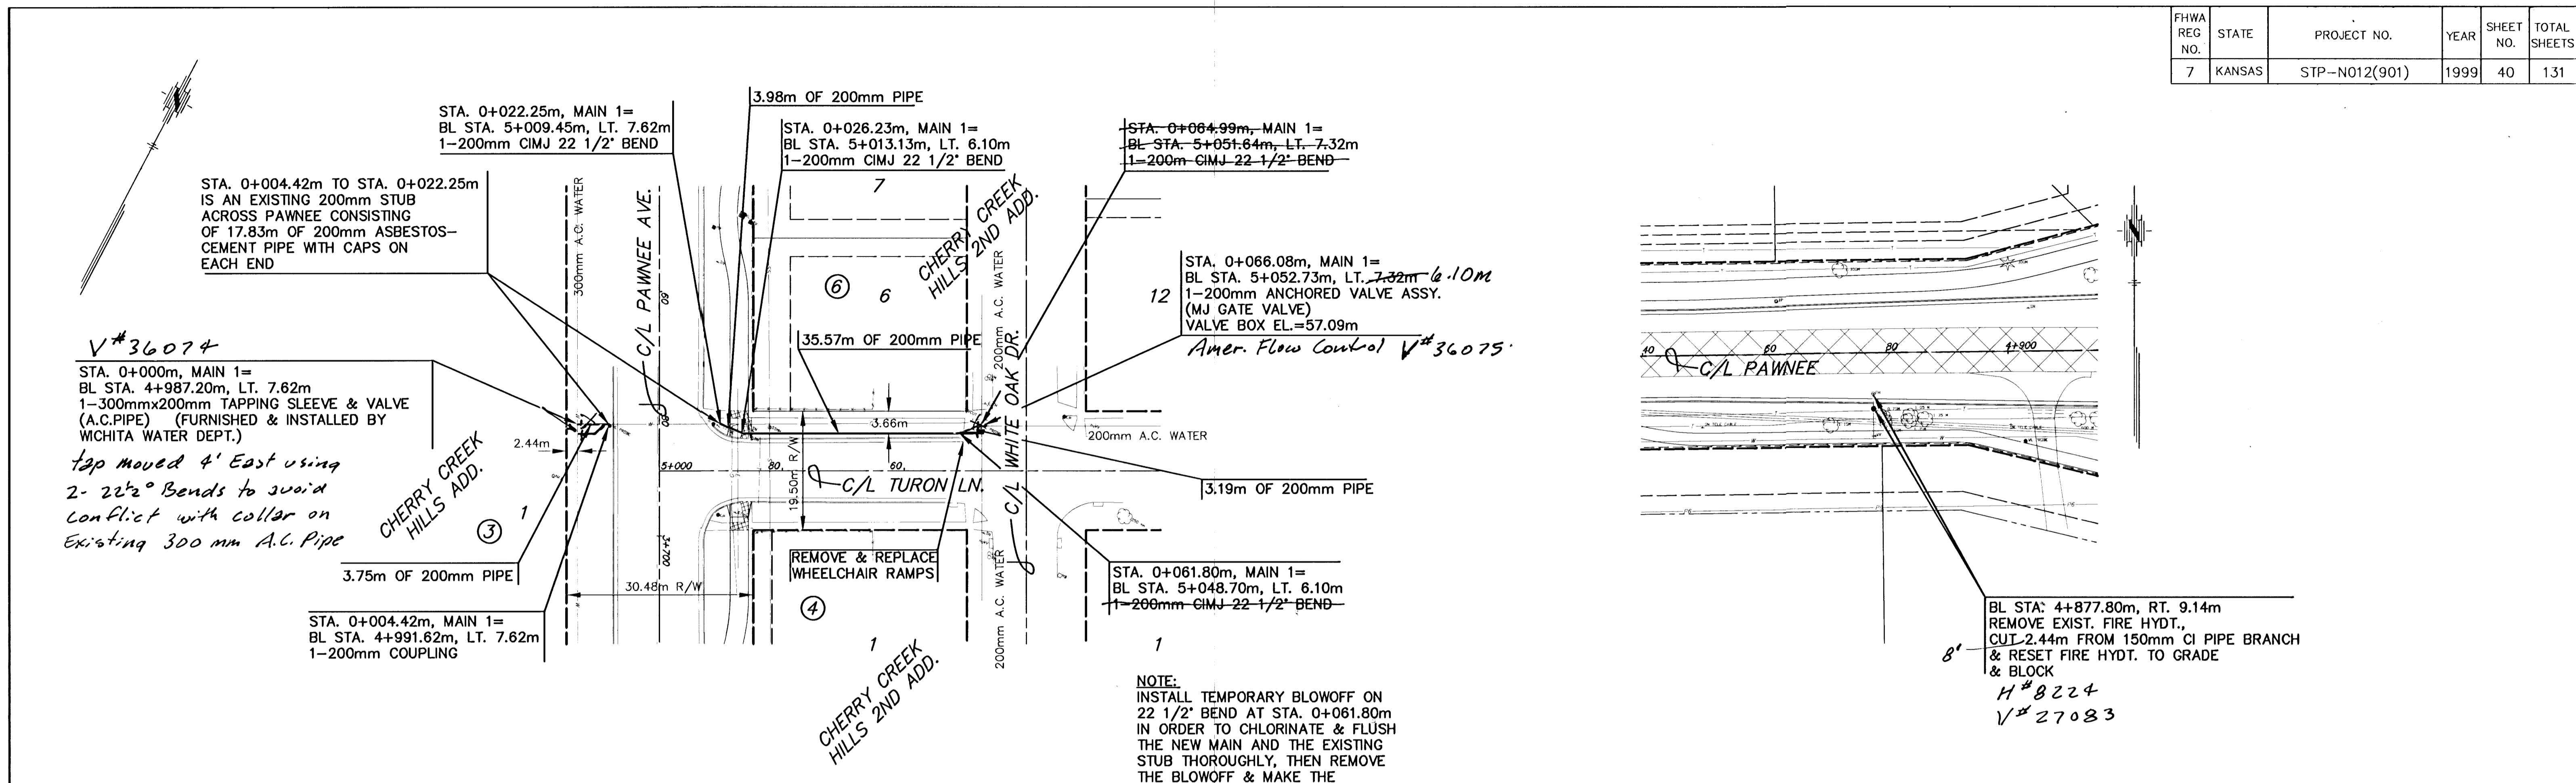

KANSAS DEPARTMENT OF TRANSPORTATION
 48-8940+
 PAWNEE AVENUE
 E. of Rock to Webb
 WATER LINE RELOCATION

G:\CIVIL\PAW-WEBB\WATER\99171-C1.DWG Thu Sep 14 09:47:36 2000